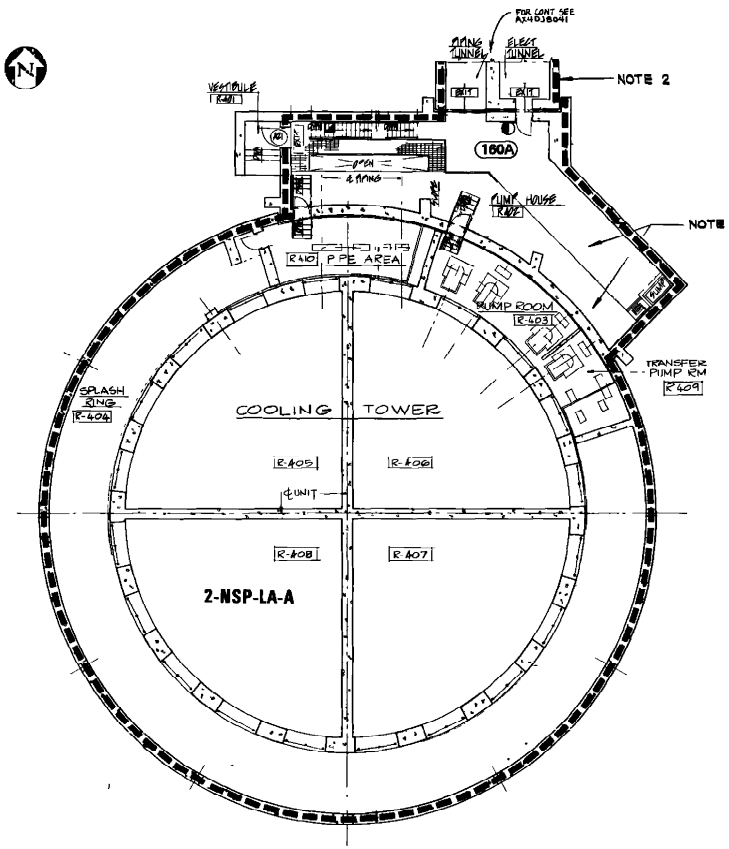

PLAN - GROUND LEVEL - TRAIN "A_2"

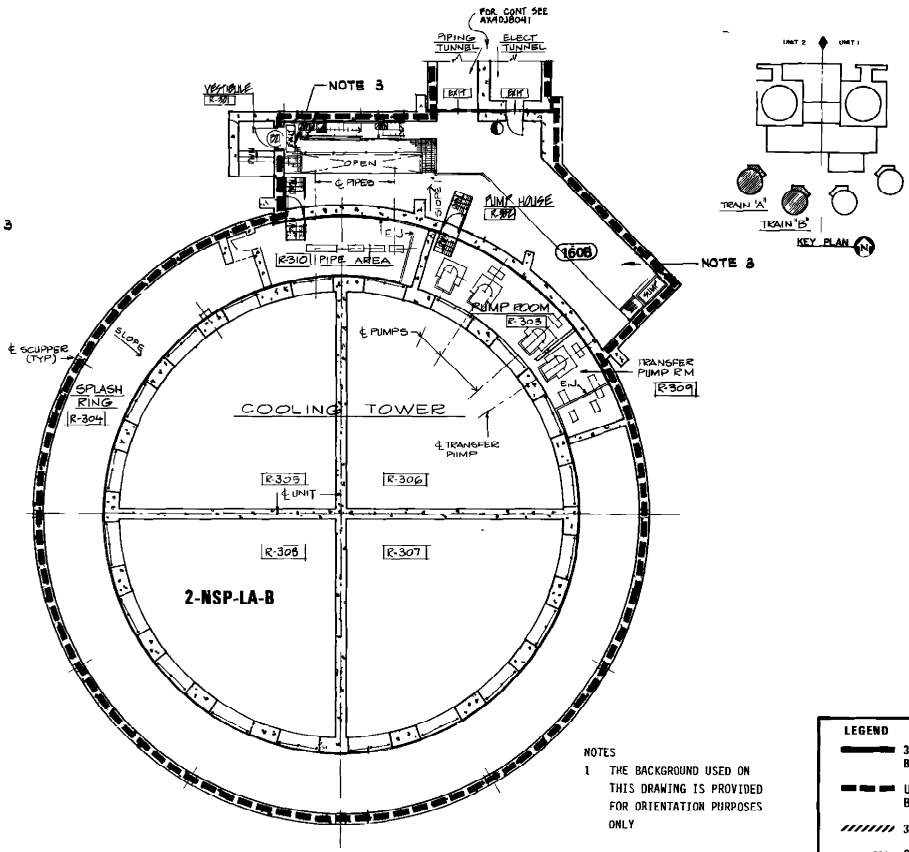

PLAN - GROUND LEVEL - TRAIN "B_2"

NOTES

1 THE BACKGROUND USED ON THIS DRAWING IS PROVIDED FOR ORIENTATION PURPOSES ONLY

2 EXTERIOR AREA BOUNDARY BARRIER SHOWN RATED ONLY TO ASSURE INSTALLATION OF CONDUIT INTERNAL SEALS WHERE BELOW GRADE DUCT BANKS INTERCONNECT FIRE AREAS

3 CONDUITS PENETRATING FLOORS AND INTERCONNECTING FIRE AREAS MUST HAVE INTERNAL SEALS (SEE 2X3DH8E6)

LEGEND

- 3 HR RATED FIRE AREA BOUNDARY
- UNRATED FIRE AREA BOUNDARY
- 3 HR RATED BOUNDARY
- 2 HR RATED BOUNDARY
- PRE ACTION SPRINKLER SYSTEM
- HALON SYSTEM
- FIRE HOSE CABINET
- FIRE HOSE REEL
- PORTABLE EXTINGUISHER (DRY CHEMICAL)
- EXIT — EXIT SIGN LOCATION
- FIRE ALARM PULL BOX
- KNOCK OUT PANEL
- FIRE ZONE BOUNDARY
- XXX — FIRE ZONE DESIGNATOR

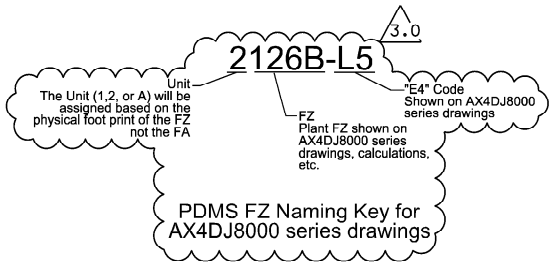

ELECTRICAL CABLE LOCATION CROSS REFERENCE		
FIRE ZONE	UNIT 1 E4 CODE	UNIT 2 E4 CODE
160A	–	W8
160B	–	W9

NO.	VERSIONS	DATE	DR	CHK	APPV
3.0	REVISED PER ABN-V02931, VER. 1.0	5-1-12	JJB	LCF	AAN

SOUTHERN COMPANY SERVICES, INC.
BIRMINGHAM, ALABAMA

GEORGIA POWER COMPANY
ALVIN W. VOGTLE NUCLEAR PLANT

FIRE AREAS NWCW PUMP HOUSE UNIT 2 PLANS & SECTIONS - TRAIN A & B

SCALE: NONE

DRAWING NO. AX4DJ8048

VER. 3.0

JOB NO. 10604

THIS DOCUMENT CONTAINS PROPRIETARY, CONFIDENTIAL, AND/OR TRADE SECRET INFORMATION OF THE SUBSIDIARIES OF THE SOUTHERN COMPANY OR OF THIRD PARTIES. IT IS INTENDED FOR USE ONLY BY EMPLOYEES OF, OR AUTHORIZED CONTRACTORS OF, THE SUBSIDIARIES OF THE SOUTHERN COMPANY. UNAUTHORIZED POSSESSION, USE, DISTRIBUTION, COPYING, DISSEMINATION, OR DISCLOSURE OF ANY PORTION HEREOF IS PROHIBITED.

SIZE C 17X22 CAD NAME A4DJ8048

Vogtle Electrical Generating Plant
Unit No. 1 / 2

Document Number:

AX4DJ8049

Document Title:

FIRE AREAS DRY ACTIVE WASTE PROCESSING & STORAGE BUILDING FLOOR PLANS

VOIDED

Voided Per ABN C090321201M001, Ver. 1.0

Ver. 1.0

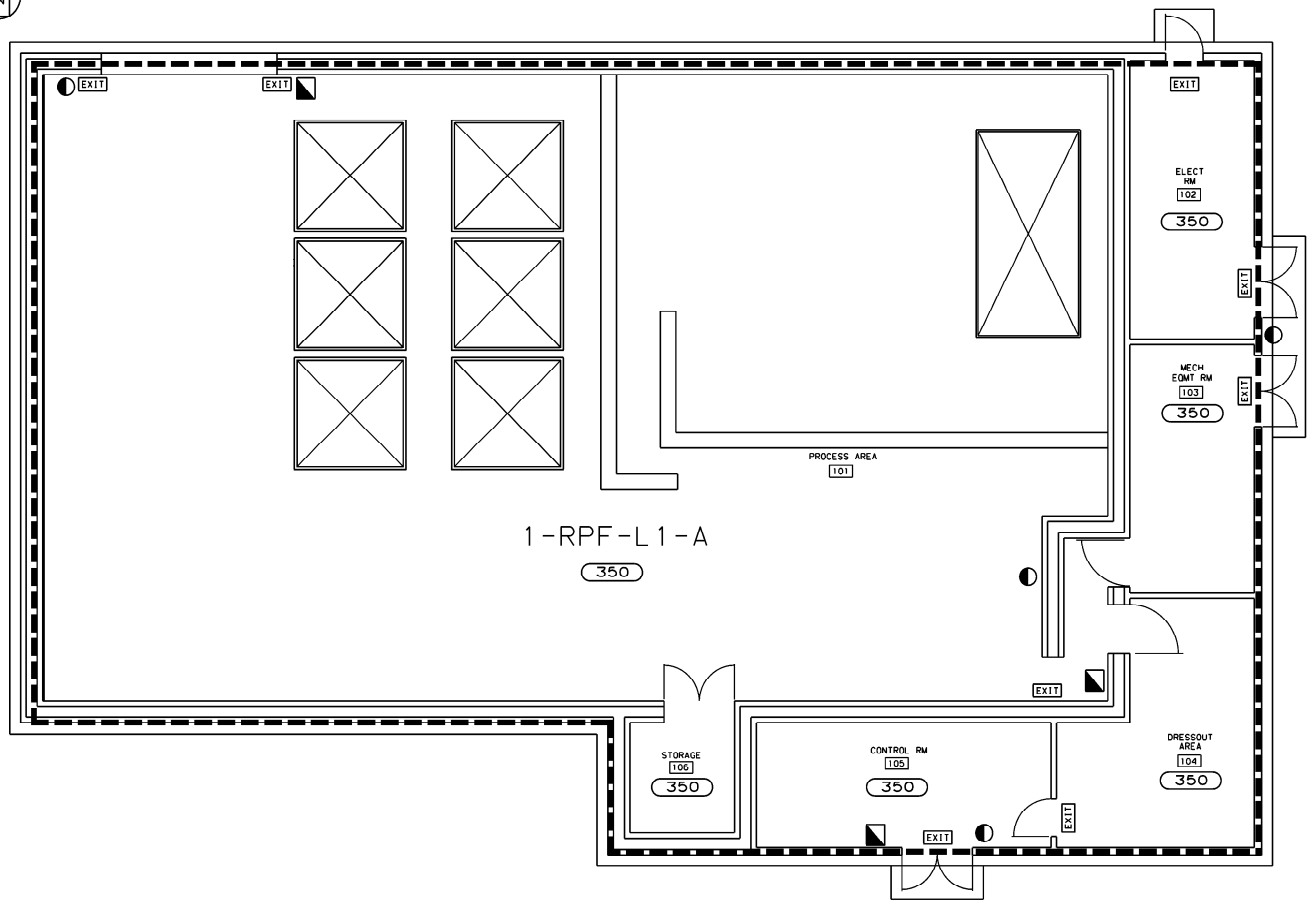

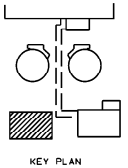

NOTES:

1. THE BACKGROUND USED ON THIS DRAWING IS PROVIDED FOR ORIENTATION PURPOSES ONLY.

LEGEND

- 3 HR FIRE AREA BOUNDARY
- UNRATED FIRE AREA BOUNDARY
- 3 HR RATED BOUNDARY
- 2 HR RATED BOUNDARY
- PREACTION SPRINKLER SYSTEM
- HALON SYSTEM
- FIRE HOSE CABINET
- FIRE HOSE REEL
- PORTABLE EXTINGUISHER (DRY-CHEMICAL)
- EXIT — EXIT SIGN LOCATION
- FIRE ALARM PULLBOX
- KNOCK OUT PANEL
- FIRE ZONE BOUNDARY
- XXX — FIRE ZONE DESIGNATOR

ELECTRICAL CABLE LOCATION CROSS REFERENCE		
FIRE ZONE	UNIT 1 PDMS FA CODE	UNIT 2 PDMS FA CODE
350	RP	———

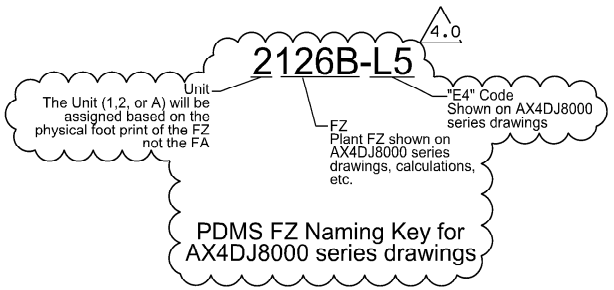

NO.	VERSIONS	DATE	DR	CHK	APPV
4.0	REVISED PER ABN-V02931, VER. 1.0	5-1-12	JJB	LCF	AAN

SOUTHERN COMPANY SERVICES, INC.
BIRMINGHAM, ALABAMA

GEORGIA POWER COMPANY
ALVIN W. VOGTLE NUCLEAR PLANT

FIRE AREAS RADWASTE PROCESSING FACILITY FLOOR PLAN EL. 217'-6"

SCALE: NONE	DRAWING NO.	VER.
JOB NO. 10604	AX4DJ8050	4.0

THIS DOCUMENT CONTAINS PROPRIETARY, CONFIDENTIAL, AND/OR TRADE SECRET INFORMATION OF THE SUBSIDIARIES OF THE SOUTHERN COMPANY OR OF THIRD PARTIES. IT IS INTENDED FOR USE ONLY BY EMPLOYEES OF, OR AUTHORIZED CONTRACTORS OF, THE SUBSIDIARIES OF THE SOUTHERN COMPANY. UNAUTHORIZED POSSESSION, USE, DISTRIBUTION, COPYING, DISSEMINATION, OR DISCLOSURE OF ANY PORTION HEREOF IS PROHIBITED.

SIZE C 17X22 CAD NAME: AX4DJ8050.DGN

This drawing and the design it covers are the property of BECHTEL. They are merely loaned and on the borrower's express agreement that they will not be reproduced, copied, loaned, exhibited, or used except in the limited way and private use permitted by any written consent given by the lender to the borrower.

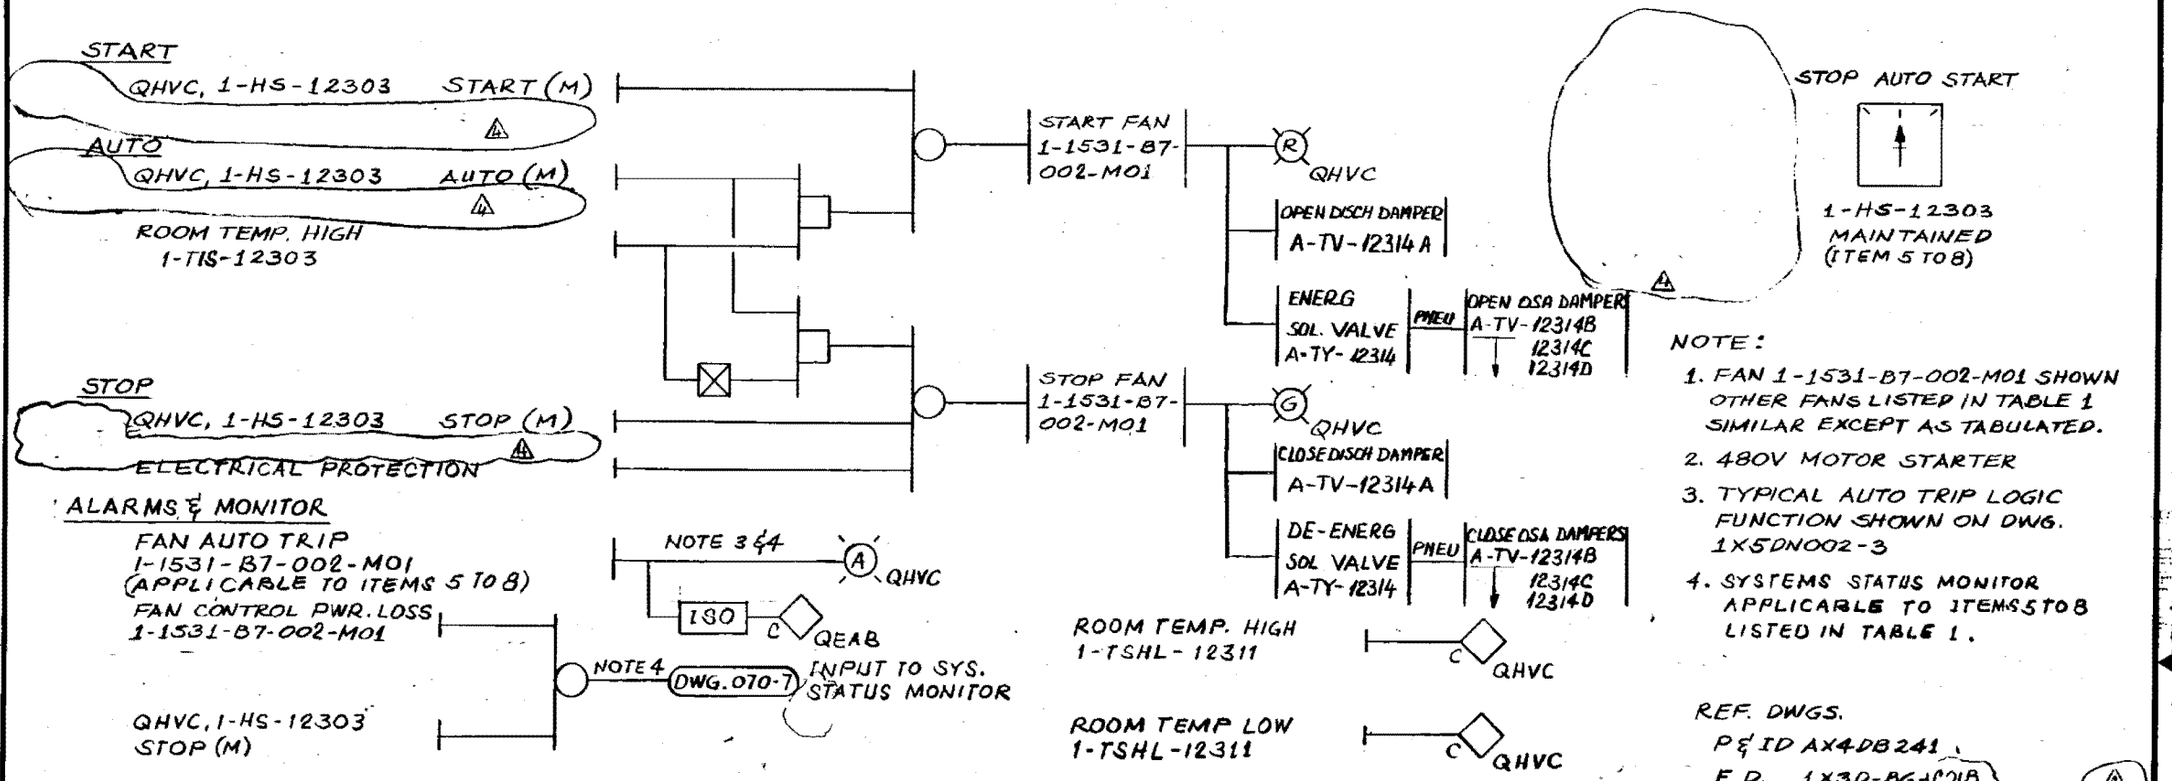

NOTE:

1. FAN 1-1531-B7-002-M01 SHOWN OTHER FANS LISTED IN TABLE 1 SIMILAR EXCEPT AS TABULATED.
2. 480V MOTOR STARTER
3. TYPICAL AUTO TRIP LOGIC FUNCTION SHOWN ON DWG. 1X5DN002-3
4. SYSTEMS STATUS MONITOR APPLICABLE TO ITEMS 5 TO 8 LISTED IN TABLE 1.

REF. DWGS.
P&ID AX4DB241
E.D. 1X3D-BG-C01B, C02J, AX3D-BG-C01R, C01Y
2X3D-BG-C01B & C02J

TABLE 1

ITEM	TRAIN	LOCATION	FAN	CNTL. SW.	TEMP. S.W	TEMP SW/SOL VLV	DAMPER
1	—	FILT. RM. TRAIN A	—	—	—	1-TSHL-12311	
2	—	B	—	—	—	1- -12308	
3	—	A	—	—	—	2- -12311	
4	—	B	—	—	—	2- -12308	
5	A	CHILLER RM. TR. A	1-1531-B7-002-M01	1-HS-12303	1-TIS-12303	1- -12304	
6	B	B	1- -004	1- -12300	1- -12300	1- -12301	
7	A	A	2- -002	2- -12303	2- -12303	2- -12304	
8	B	B	2- -004	2- -12300	2- -12300	2- -12301	
9	—	HVAC RM.	A- -005	A -12314	A-TS -12314	(SOL VLV) A-TY-12314	A-TV 12314A A-TV 12314B
10	—		A- -006	A -12316	A- -12316	(SOL VLV) A-TY-12316	12316A 12316B

NUCLEAR SAFETY RELATED

ROOM EXHAUST FAN "Q"

NO.	REVISIONS	DATE	DR	CHK.	SUPV.	EGL	EGS	CHF. E.	P.E.	Q.A.E.
5	ADDED DAMPERS A-TV-12314 A, B, C & D; A-TV-12316 A, B, C & D	9/2/90	AV	FAL			PCK			
4	ADDED LOUVERS AND HAND SWITCH LOCATION	3/12/91	FAL	AAT	X		PCK	X		X
3	CHANGED HS-12314 & 12316 AS PANEL MOUNTED PER P&ID REV 2	6-25-84	MCV	W.J.M			PCK			
2	ISSUED FOR CONSTRUCTION	3/7/84	NBD	FAL	MKK					

ENG. MGR. DATE

BECHTEL
LOS ANGELES

GEORGIA POWER COMPANY
ALVIN W. VOGTLE NUCLEAR PLANT

CONTROL LOGIC DIAGRAM
CONTROL BUILDING
EQUIPMENT ROOM LEVEL 3 & 4
HVAC SYSTEM

SCALE: NONE	DRAWING NO.	REV.
JOB NO. 9510	AX5DN008-1	4

P&ID REV. 2

SIZE B 11 x 17

SCANNED DATE 12-19-91

TABLE 1

TRAIN	EQUIPMENT NO.	REFERENCE LOGIC DIAG.
UNIT 1 A	1-HV-12114	AX5DN032-1
	CRI-A	AX5DN020-4
UNIT 1 B	1-HV-12115	AX5DN032-1
	CRI-B	AX5DN020-4
UNIT 2 A	2-HV-12114	AX5DN032-1
	CRI-A	AX5DN020-4
UNIT 2 B	2-HV-12115	AX5DN032-1
	CRI-B	AX5DN020-4

5

NOTE:
1. LOGIC DIAGRAM SHOWN ON DWG AX5DN020-8

5

REF. DWGS
P&ID AX4DB206-1, 2 & 3

5

NUCLEAR SAFETY RELATED

TOXIC GAS SAFETY ACTUATION "Q"

SOUTHERN COMPANY SERVICES, INC.
BIRMINGHAM, ALABAMA

GEORGIA POWER COMPANY
ALVIN W. VOGTLE NUCLEAR PLANT

CONTROL LOGIC DIAGRAM BOP SAFETY ACTUATION SYSTEM

NO.	REVISIONS	DATE	DR	CHK	APPV	DTL
5	INCORPORATED PER DCP 89-V1N0297	10-14-96	ELC	GLB	WFP	X
0	ISSUED FOR CONSTRUCTION	SEE MICROFILM FOR SIGNATURES				

SCALE: NONE

JOB NO. 10604

DRAWING NO. AX5DN020-10

REV 5

THIS DOCUMENT CONTAINS PROPRIETARY, CONFIDENTIAL, AND/OR TRADE SECRET INFORMATION OF THE SUBSIDIARIES OF THE SOUTHERN COMPANY OR OF THIRD PARTIES. IT IS INTENDED FOR USE ONLY BY EMPLOYEES OF, OR AUTHORIZED CONTRACTORS OF, THE SUBSIDIARIES OF THE SOUTHERN COMPANY. UNAUTHORIZED POSSESSION, USE, DISTRIBUTION, COPYING, DISSEMINATION, OR DISCLOSURE OF ANY PORTION HEREOF IS PROHIBITED.

CAD NAME A5N02010 SIZE B 11x17

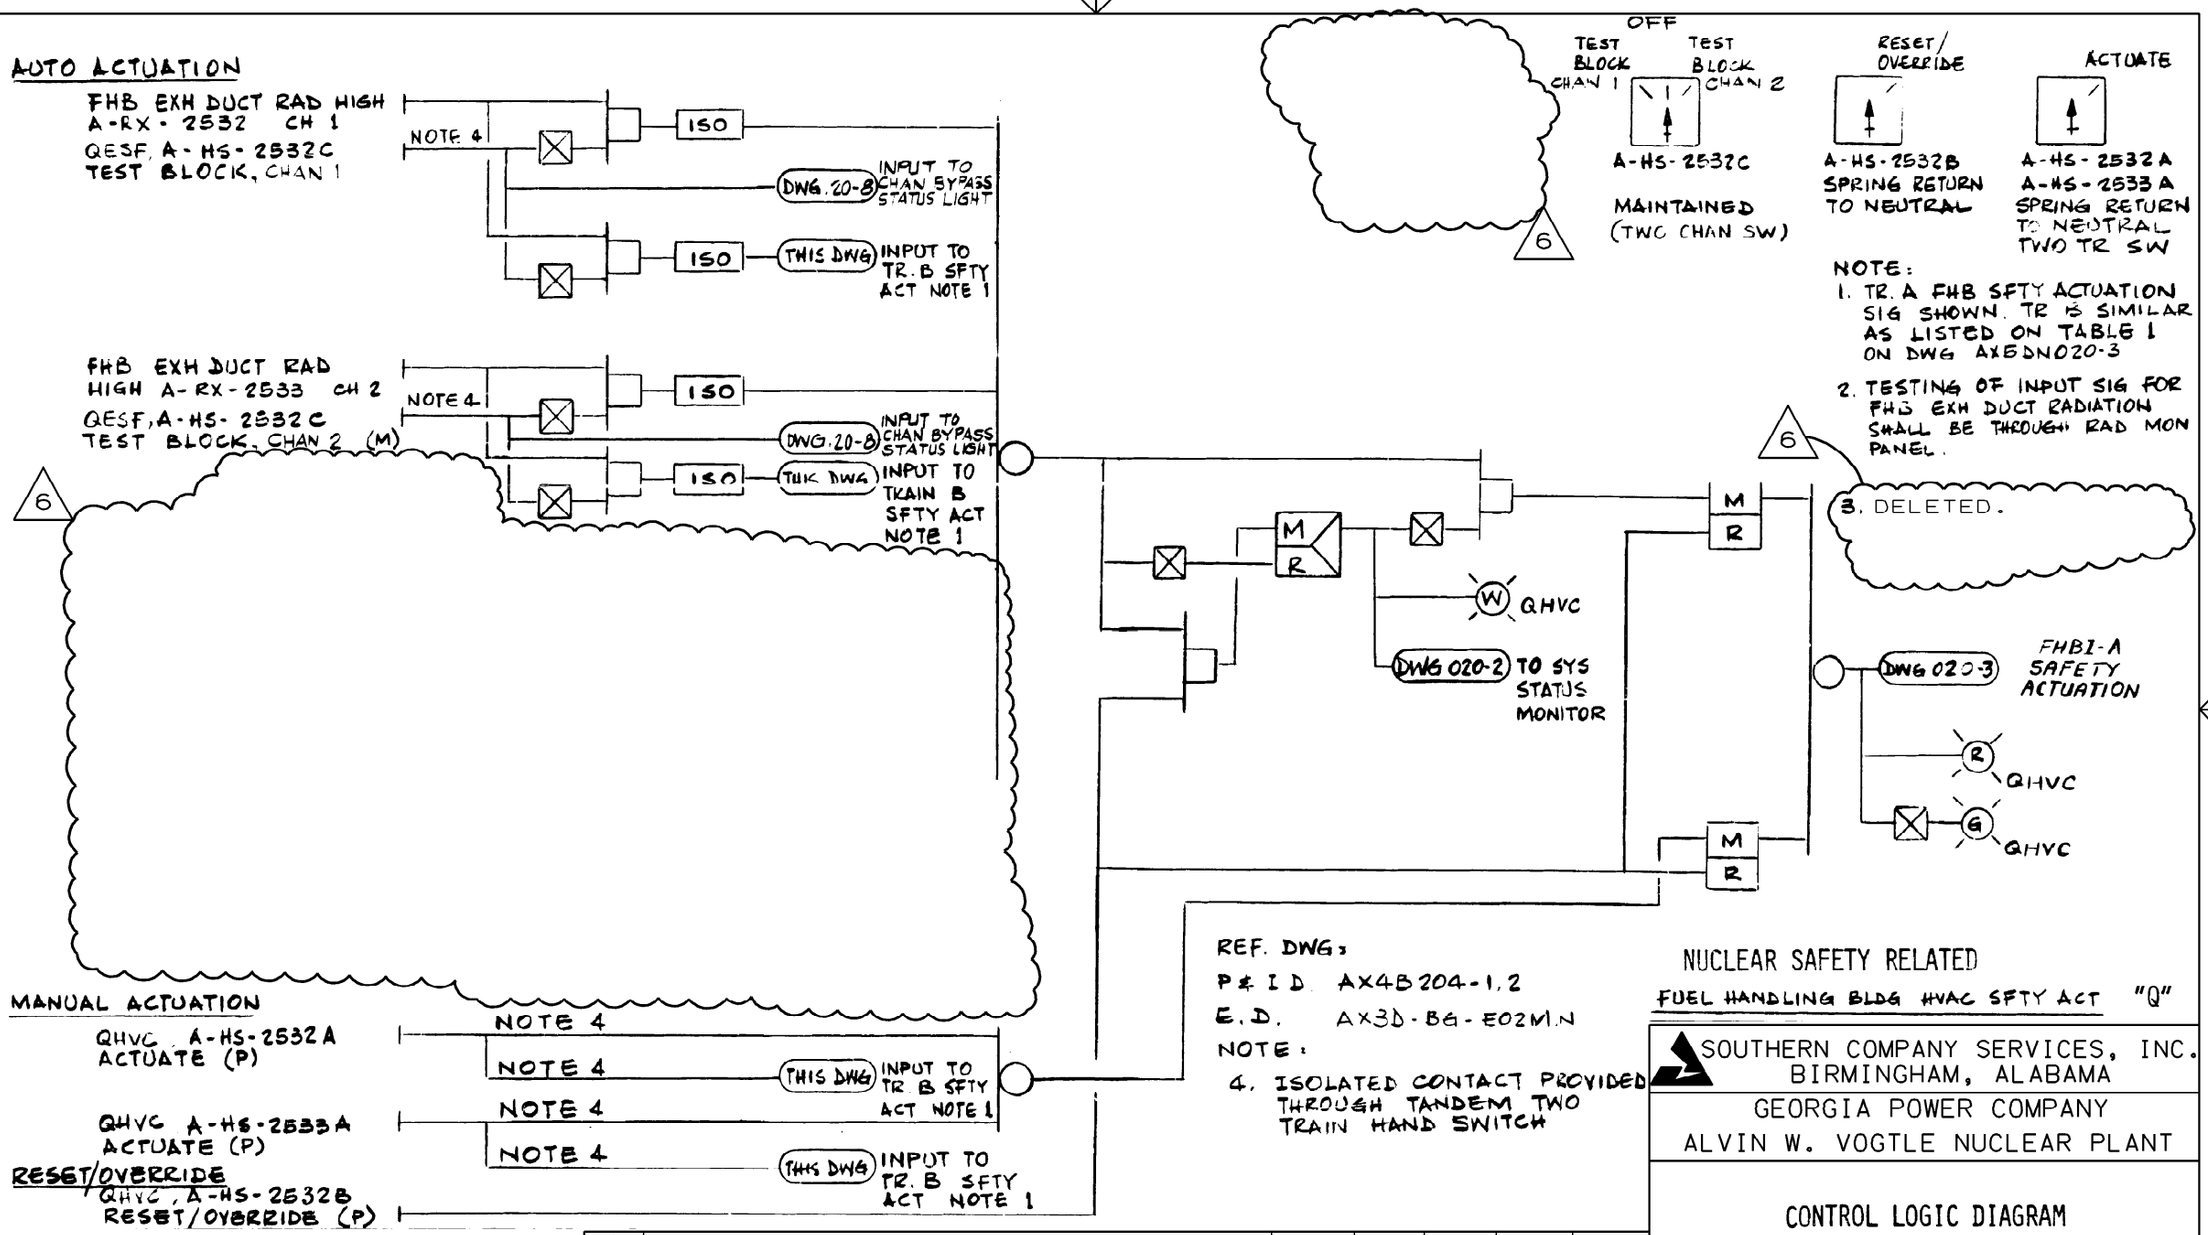

SOUTHERN COMPANY SERVICES, INC.
BIRMINGHAM, ALABAMA

GEORGIA POWER COMPANY
ALVIN W. VOGTLE NUCLEAR PLANT

CONTROL LOGIC DIAGRAM BOP SAFETY ACTUATION SYSTEM

NO.	REVISIONS	DATE	DR	CHK	APPV	DTL
△						
△						
6	INCORPORATED PER DCP 96-VAN0039	05-15-00	CD	SM	MWD	
0	ISSUED FOR CONSTRUCTION	SEE MICROFILM FOR SIGNATURES				

SCALE: NONE	DRAWING NO.	REV
JOB NO. 10604	AX5DN020-1	6

THIS DOCUMENT CONTAINS PROPRIETARY, CONFIDENTIAL, AND/OR TRADE SECRET INFORMATION OF THE SUBSIDIARIES OF THE SOUTHERN COMPANY OR OF THIRD PARTIES. IT IS INTENDED FOR USE ONLY BY EMPLOYEES OF, OR AUTHORIZED CONTRACTORS OF, THE SUBSIDIARIES OF THE SOUTHERN COMPANY. UNAUTHORIZED POSSESSION, USE, DISTRIBUTION, COPYING, DISSEMINATION, OR DISCLOSURE OF ANY PORTION HEREOF IS PROHIBITED.

SIZE B 11x17

ALARM & MONITOR

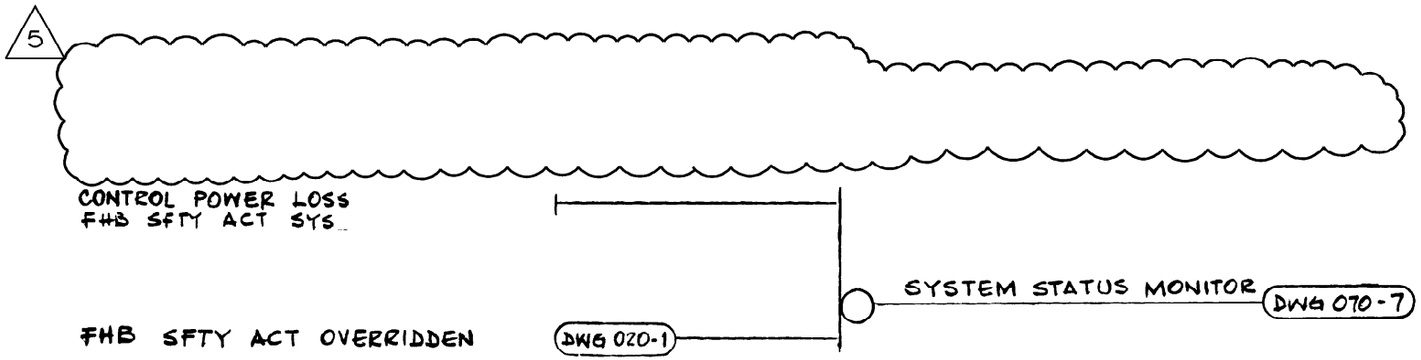

NOTE:

1. SYSTEM STATUS MONITOR & ALARM TRAIN A SHOWN. TRAIN B SIMILAR AS TABULATED ON DWG AX5DN020-3

REF. DWG.

P & I D AX4DB204-1, 2

E. D. AX3D-BG-E02M, N

NUCLEAR SAFETY RELATED

FUEL HANDLING BLDG. HVAC SFTY ACT "Q"

SOUTHERN COMPANY SERVICES, INC.
BIRMINGHAM, ALABAMA

GEORGIA POWER COMPANY
ALVIN W. VOGTLE NUCLEAR PLANT

CONTROL LOGIC DIAGRAM
BOP SAFETY ACTUATION SYSTEM

NO.	REVISIONS	DATE	DR	CHK	APPV	DTL
△						
△						
5	INCORPORATED PER DCP 96-VAN0039	05-16-00	CD	SM	MWD	X
0	ISSUED FOR CONSTRUCTION	SEE MICROFILM FOR SIGNATURES				

SCALE: NONE

DRAWING NO. AX5DN020-2

REV 5

JOB NO. 10604

THIS DOCUMENT CONTAINS PROPRIETARY, CONFIDENTIAL, AND/OR TRADE SECRET INFORMATION OF THE SUBSIDIARIES OF THE SOUTHERN COMPANY OR OF THIRD PARTIES. IT IS INTENDED FOR USE ONLY BY EMPLOYEES OF, OR AUTHORIZED CONTRACTORS OF, THE SUBSIDIARIES OF THE SOUTHERN COMPANY. UNAUTHORIZED POSSESSION, USE, DISTRIBUTION, COPYING, DISSEMINATION, OR DISCLOSURE OF ANY PORTION HEREOF IS PROHIBITED.

SIZE B 11x17

TRAIN	EQUIPMENT NO.	REFERENCE LOGIC DIAG.	(QHVC) MANUAL ACT SW	(QHVC) RESET OVERRIDE SW	(QESF) TEST SW	RADIATION SFTY ACT.
A	A-1542-N7-001-M01	AX5DN027-1	A-HS-2532A	A-HS-2532B	A-HS-2532C	A-RX-2532
	A-HY-2529	AX5DN029-1				
	2535					
	12481					
	12479					
B	A-1542-N7-002-M01	AX5DN027-1	A-HS-2533A	A-HS-2533B	3	A-RX-2533
	A-HY-2528	AX5DN029-1				
	2534					
	12482					
	12480					

3

NOTE:

1 LOGIC DIAGRAM SHOWN ON DWG AX5DN02C-1 AND AX5DN020-2

REF. DWGS:

P & ID AX4DB204-1 & 2

E.D AX3D-B6-E02M,N

NUCLEAR SAFETY RELATED

FUEL HANDLING BLDG HVAC SFTY ACT "Q"

SOUTHERN COMPANY SERVICES, INC.
BIRMINGHAM, ALABAMA

GEORGIA POWER COMPANY
ALVIN W. VOGTLE NUCLEAR PLANT

CONTROL LOGIC DIAGRAM
BOP SAFETY ACTUATION SYSTEM

NO.	REVISIONS	DATE	DR	CHK	APPV	DTL
△						
△						
3	INCORPORATED PER DCP 96-VAN0039	05-16-00	CD	SM	MWD	X
0	ISSUED FOR CONSTRUCTION	SEE MICROFILM FOR SIGNATURES				

SCALE: NONE | DRAWING NO. AX5DN020-3 | REV 3

JOB NO. 10604

THIS DOCUMENT CONTAINS PROPRIETARY, CONFIDENTIAL, AND/OR TRADE SECRET INFORMATION OF THE SUBSIDIARIES OF THE SOUTHERN COMPANY OR OF THIRD PARTIES. IT IS INTENDED FOR USE ONLY BY EMPLOYEES OF, OR AUTHORIZED CONTRACTORS OF, THE SUBSIDIARIES OF THE SOUTHERN COMPANY. UNAUTHORIZED POSSESSION, USE, DISTRIBUTION, COPYING, DISSEMINATION, OR DISCLOSURE OF ANY PORTION HEREOF IS PROHIBITED.

SIZE B 11x17

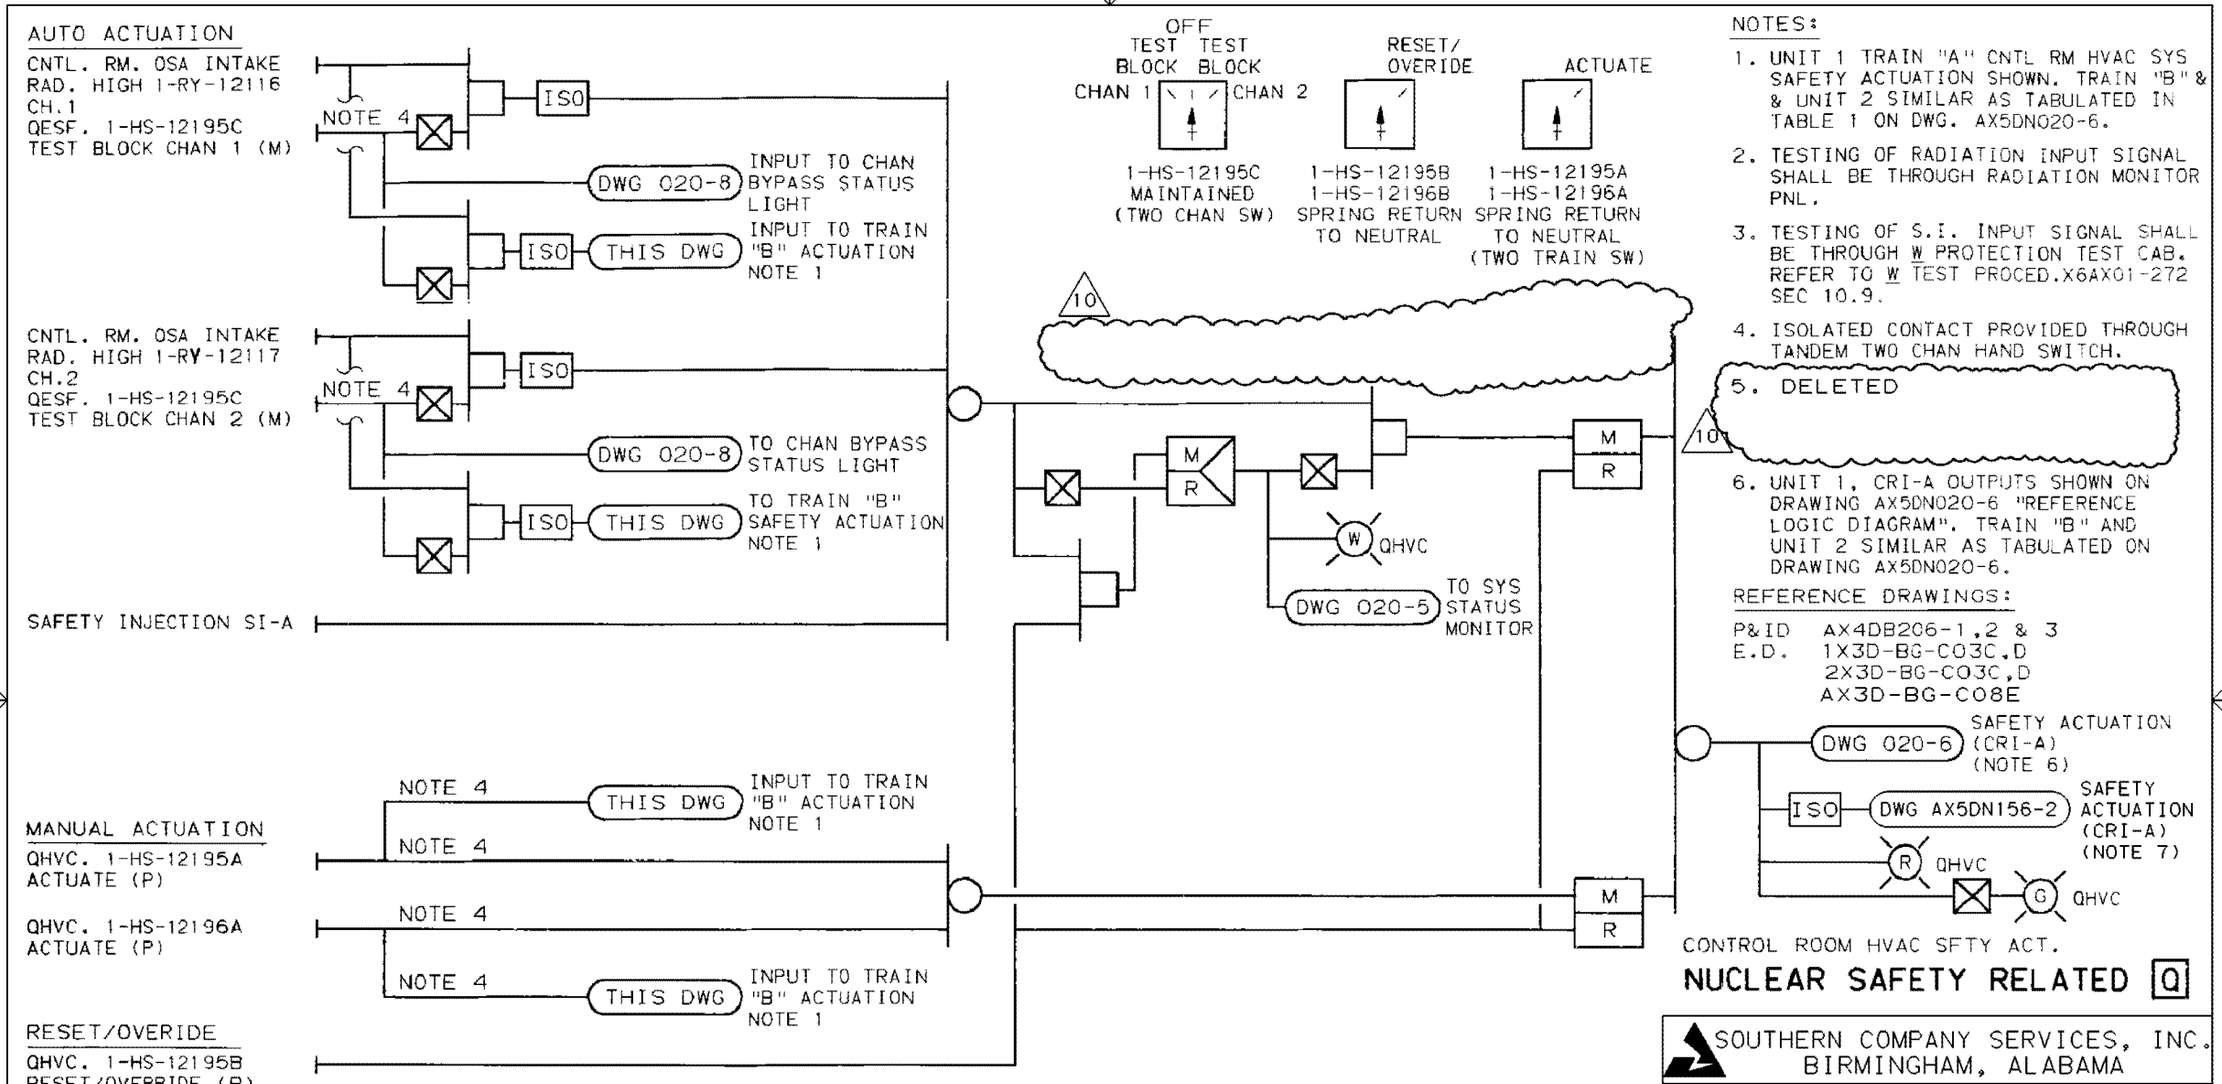

NOTES:

1. UNIT 1 TRAIN "A" CNTL RM HVAC SYS SAFETY ACTUATION SHOWN. TRAIN "B" & & UNIT 2 SIMILAR AS TABULATED IN TABLE 1 ON DWG. AX5DN020-6.
2. TESTING OF RADIATION INPUT SIGNAL SHALL BE THROUGH RADIATION MONITOR PNL.
3. TESTING OF S.I. INPUT SIGNAL SHALL BE THROUGH W PROTECTION TEST CAB. REFER TO W TEST PROCED.X6AX01-272 SEC 10.9.
4. ISOLATED CONTACT PROVIDED THROUGH TANDEM TWO CHAN HAND SWITCH.
5. DELETED
6. UNIT 1, CRI-A OUTPUTS SHOWN ON DRAWING AX5DN020-6 "REFERENCE LOGIC DIAGRAM". TRAIN "B" AND UNIT 2 SIMILAR AS TABULATED ON DRAWING AX5DN020-6.

REFERENCE DRAWINGS:

P&ID AX4DB206-1,2 & 3
E.D. 1X3D-BG-C03C,D
2X3D-BG-C03C,D
AX3D-BG-C08E

NOTES: (CONT'D)

7. UNIT 1 TRAIN A TSC HVAC SYS SAFETY ACTUATON SHOWN. TRAIN B & UNIT 2 SIMILAR.

NO.	REVISIONS	DATE	DR	CHK	APPV	DTL
10	INCORP. PER DCP 89-V1N0297.	10-14-96	GD	GLB	WFP	X
0	ISSUED FOR CONSTRUCTION	SEE MICROFILM FOR SIGNATURES				

SOUTHERN COMPANY SERVICES, INC.
BIRMINGHAM, ALABAMA

GEORGIA POWER COMPANY
ALVIN W. VOGTLE NUCLEAR PLANT

CONTROL LOGIC DIAGRAM BOP SAFETY ACTUATION SYSTEM

SCALE: NONE

JOB NO. 10604

DRAWING NO. AX5DN020-4

REV 10

THIS DOCUMENT CONTAINS PROPRIETARY, CONFIDENTIAL, AND/OR TRADE SECRET INFORMATION OF THE SUBSIDIARIES OF THE SOUTHERN COMPANY OR OF THIRD PARTIES. IT IS INTENDED FOR USE ONLY BY EMPLOYEES OF, OR AUTHORIZED CONTRACTORS OF, THE SUBSIDIARIES OF THE SOUTHERN COMPANY. UNAUTHORIZED POSSESSION, USE, DISTRIBUTION, COPYING, DISSEMINATION, OR DISCLOSURE OF ANY PORTION HEREOF IS PROHIBITED.

CAD NAME A5DN0204 SIZE B 11x17

14.5X

ALARMS AND MONITOR

CONTROL POWER LOSS CNTL RM SFTY ACTUATION SYSTEM

2

CONTRO. ROOM SFTY ACT OVERRIDEN — DWG 020-4

SYSTEM STATUS MONITOR — DWG 070-7

NOTE:
1 SYSTEM STATUS MONITOR TRAIN A SHOWN TRAIN B SIMILAR AS TABULATED ON DWG AX5DN020-6

REF DWGS
P & I D AX4DE206-1 2 & 3
E, D 1XBE-BG-C020 D
2XBE-BG-C020 D

NUCLEAR SAFETY RELATED

CONTROL ROOM HVAC SFTY ACT "Q"

NO.	REVISIONS	DATE	DR	CHK.	SUPV.	EGL	EGS	CHF. E.	P. E.	Q.A.E.	ENG. MGR.
2	INCORPORATED DCN #1	10-31-86	ZSD								DATE
1	REVISED AS INDICATED	2/12/80	FL	FAL							
0	ISSUED FOR CONSTRUCTION	5/3/79		FAL							

BECHTEL
LOS ANGELES

GEORGIA POWER COMPANY
ALVIN W. VOGTLE NUCLEAR PLANT

CONTROL LOGIC DIAGRAM
BOP SAFETY ACTUATION SYSTEM

SCALE: NONE	DRAWING NO.	REV.
JOB NO. 9510	AX5DN020-5	2

SIZE B 11 x 17

BM 9510

This drawing and the design it covers are the property of BECHTEL. They are merely loaned and on the borrower's express agreement that they will not be reproduced, copied, loaned, exhibited, or used except in the limited way and private use permitted by any written consent given by the lender to the borrower.

I CERTIFY THAT THE IMAGE CONTAINED ON THIS FRAME WAS MADE IN THE NORMAL AND REGULAR COURSE OF BUSINESS, ON THE DATE STATED BELOW AND THAT IT IS AN ACCURATE REPRODUCTION OF THE DOCUMENT SUBMITTED TO MICROGRAPHICS.
DATE 10-31-86 CAMERA OPERATOR SECTION SUPERVISOR

PERMITTED TO MICROGRAPHICS
SECTION SUPERVISOR
CAMERA OPERATOR
DATE:

THIS DRAWING AND THE DESIGN IT COVERS ARE THE PROPERTY OF SCS. THEY ARE MERELY LOANED AND ON THE BORROWER'S EXPRESS AGREEMENT THAT THEY WILL NOT BE REPRODUCED, COPIED, LOANED, EXHIBITED, OR USED EXCEPT IN THE LIMITED WAY AND PRIVATE USE PERMITTED BY ANY WRITTEN CONSENT GIVEN BY THE LENDER TO THE BORROWER.

TRAIN	EQUIPMENT NO.	REFERENCE LOGIC DIAGRAM	(QHVC) MANUAL ACT. SW	(QHVC) REST OVERRIDE SW	(QESF) TEST BLOCK SW	RAD. SFTY ACT	SFTY INJECTION
UNIT 1 A	1-1531-N7-001-MO1	AX5DN031-1	1-HS-12195A	1-HS-12195B	1-HS-12195C	1-RX-12116	UNIT 1 SI-A
	A-HY-12162A	AX5DN037-1					
	CONTROL ROOM DIFFERENTIAL PRESSURE ALARM FOR 1-PDIS-12160	AX5DN032-2					
	1-1592-P7-001-MO1	1X5DN060-1					
	1-1592-C7-001-000	1X5DN060-2					
	1-HV-12146 AND 2-HV-12146	AX5DN032-3					
UNIT 1 B	1-1531-N7-002-MO1	AX5DN031-1	1-HS-12196A	1-HS-12196B		1-RX-12117	UNIT 1 SI-B
	A-HY-12163A	AX5DN037-1					
	CONTROL ROOM DIFFERENTIAL PRESSURE ALARM FOR 1-PDIS-12160	AX5DN032-2					
	1-1592-P7-002-MO1	1X5DN060-1					
	1-1592-C7-002-000	1X5DN060-2					
	1-HV-12147 AND 2-HV-12147	AX5DN032-3					
UNIT 2 A	2-1531-N7-001-MO1	AX5DN031-1	2-HS-12195A	2-HS-12195B	2-HS-12195C	2-RX-12116	UNIT 2 SI-A
	A-HY-12162B	AX5DN037-1					
	CONTROL ROOM DIFFERENTIAL PRESSURE ALARM FOR 2-PDIS-12160	AX5DN032-2					
	2-1592-P7-001-MO1	2X5DN060-1					
	2-1592-C7-001-000	2X5DN060-2					
	2-HV-12146 AND 1-HV-12146	AX5DN032-3					
UNIT 2 B	2-1531-N7-002-MO1	AX5DN031-1	2-HS-12196A	2-HS-12196B		2-RX-12117	UNIT 2 SI-B
	A-HY-12163B	AX5DN037-1					
	CONTROL ROOM DIFFERENTIAL PRESSURE ALARM FOR 2-PDIS-12160	AX5DN032-2					
	2-1592-P7-002-MO1	2X5DN060-1					
	2-1592-C7-002-000	2X5DN060-2					
	2-HV-12147 AND 1-HV-12147	AX5DN032-3					

NOTE:

1. REFER TO LOGIC DIAGRAM AX5DN020-4 & AX5DN020-5

REF. DWGS.

P&ID AX4DB206-1,2 & 3

E.D. 1X3D-BG-C03C, D
2X3D-BG-C03C, D

CONTROL ROOM HVAC SFTY ACT

NUCLEAR SAFETY RELATED Q

NO.	REVISIONS	DATE	DR	CHK	SUPV	EGL	EGS	CHF.E	P.E.	Q.A.E.
3	INCORPORATED ABN-03534	10-14-91	JMS	KEW	JBG	FJ	X	X	X	X
1	REVISIONS	DATE	DR	CHK	RE	DM	DM	DM	PDM	X
0	ISSUED FOR CONSTRUCTION	5-31-79		SEE	MICRO	FILM	FOR	SIGNATURES		

ENG MGR

DATE

SOUTHERN COMPANY SERVICES, INC.
BIRMINGHAM, ALABAMA

GEORGIA POWER COMPANY
ALVIN W. VOGTLE NUCLEAR PLANT

CONTROL LOGIC DIAGRAM BOP SAFETY ACTUATION SYSTEM

SCALE: NONE	DRAWING NO.	REV
JOB NO. 10604	AX5DN020-6	3

SIZE B 11x17

This drawing and the design it covers are the property of BECHTEL. They are merely loaned and on the borrower's express agreement that they will not be reproduced, copied, loaned, exhibited, or used except in the limited way and private use permitted by any written consent given by the lender to the borrower.

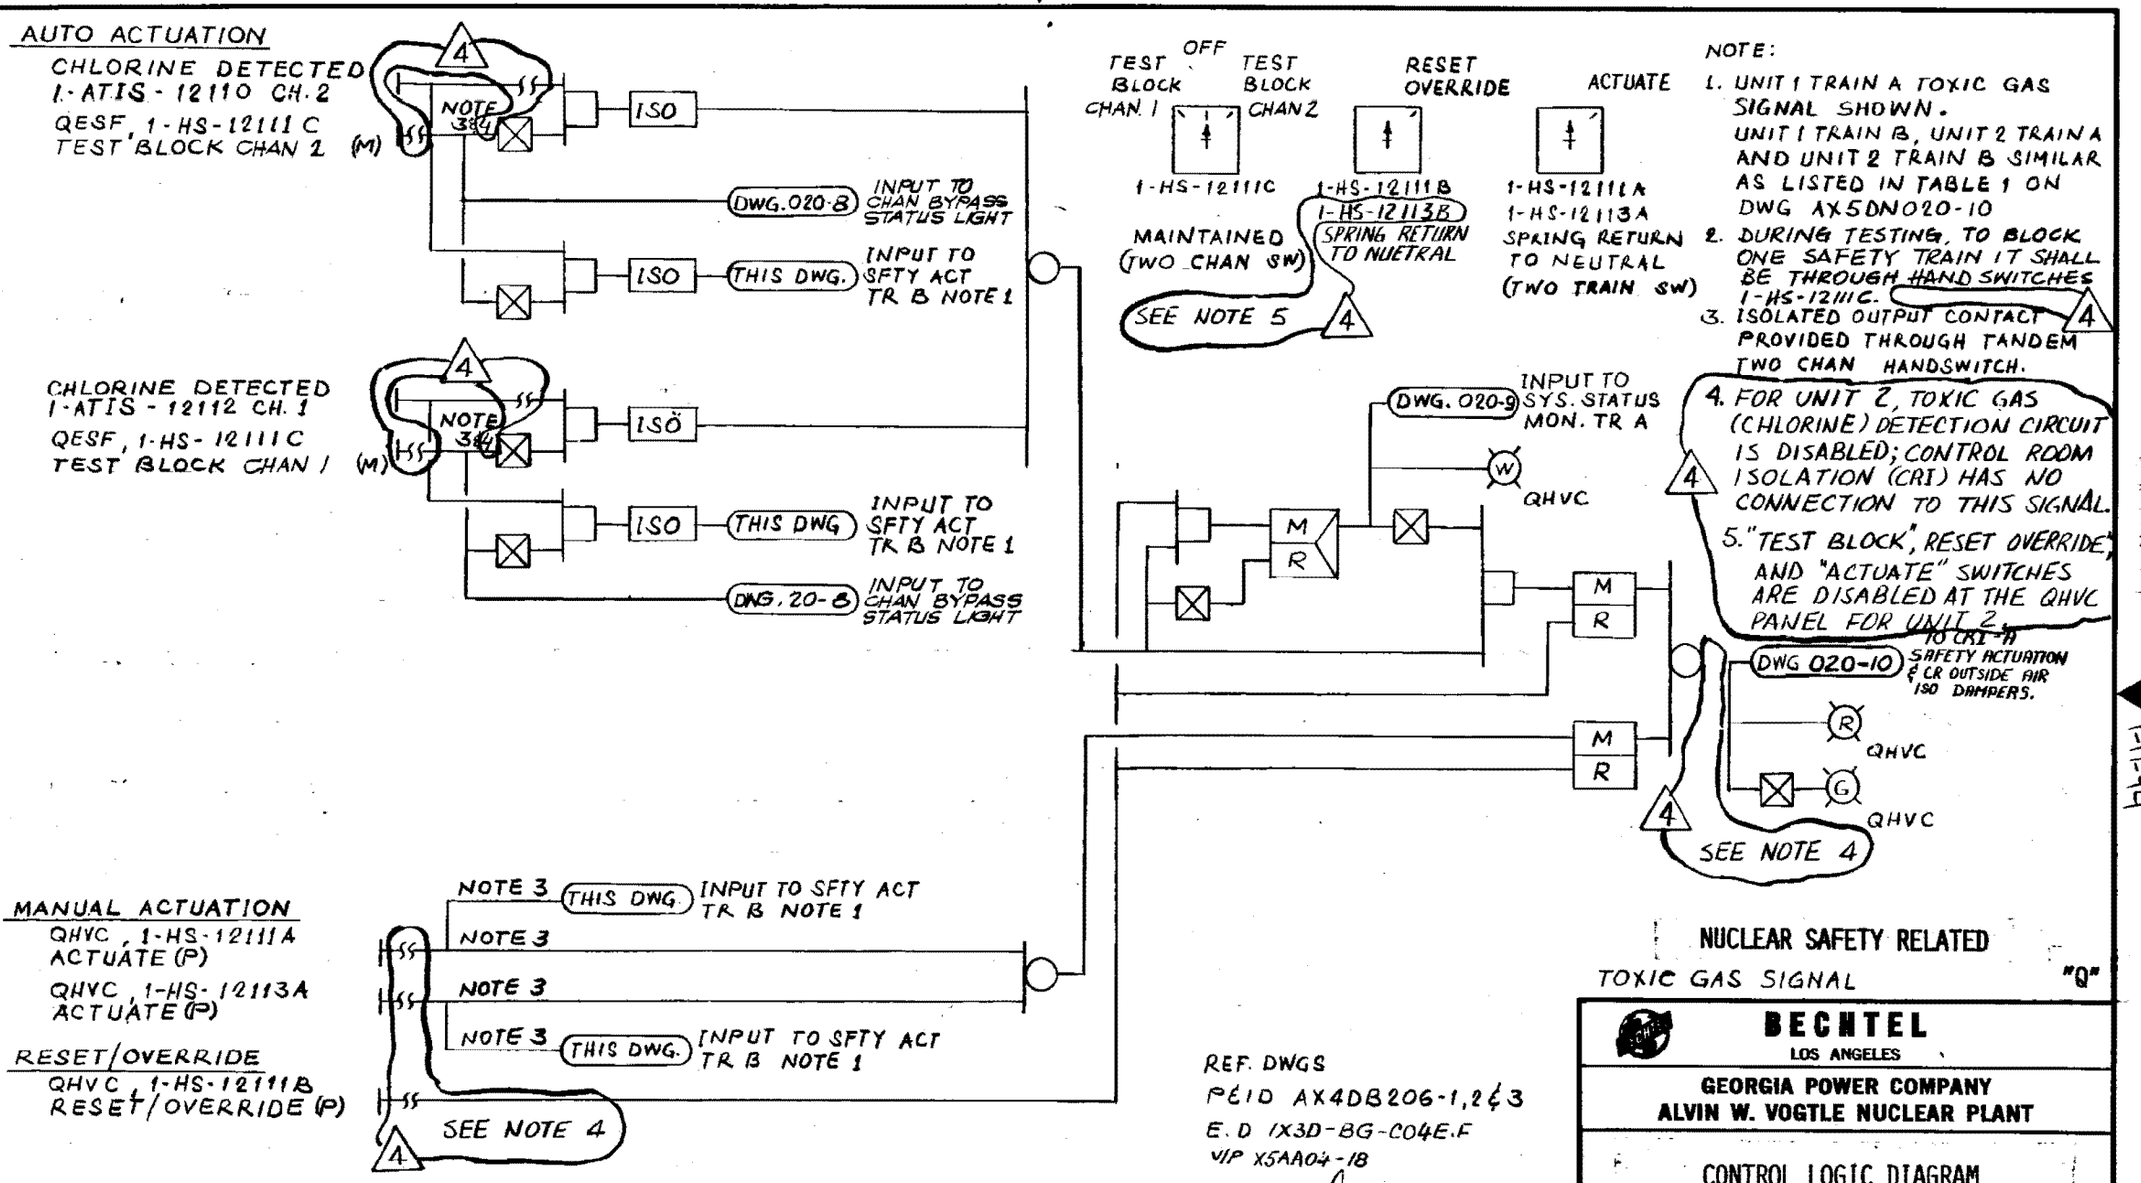

NUCLEAR SAFETY RELATED

TOXIC GAS SIGNAL "Q"

REF. DWGS
P&ID AX4DB206-1,2 & 3
E.D 1X3D-BG-C04E.F
VIP X5AA04-18

NO.	REVISIONS	DATE	DR	CHK.	SUPV.	EGL	EGS	CHF. E.	P. E.	Q.A.E.
3	INCORPORATED DCN #1 & 2 AND CORRECTED SIGNAL DESCRIPTION	12-9-88	ZEO	ALV						
2	DELETED H2S INPUT PER LETTER SB4846	2-3-84	ALV	FAL		PCL				
1	INCORPORATED DCN #3 (IDCN #35, B20012M)	2-1-89	RSK			RDD				
0	ISSUED FOR CONSTRUCTION	3-14-89	HL	FAL	X	KCB				X

ENG. MGR. X DATE

BECHTEL
LOS ANGELES

GEORGIA POWER COMPANY
ALVIN W. VOGTLE NUCLEAR PLANT

CONTROL LOGIC DIAGRAM
BOP SAFETY ACTUATION SYSTEM

SCALE: NONE	DRAWING NO.	REV.
JOB NO. 9510	AX5DN020-7	4

BM 9510 P&ID 206-1 REV. 6 206-2 REV. 6 P&ID 206-3 REV. 5

SCANNED UNTIL OCT 24 1991

SIZE B 11 x 17

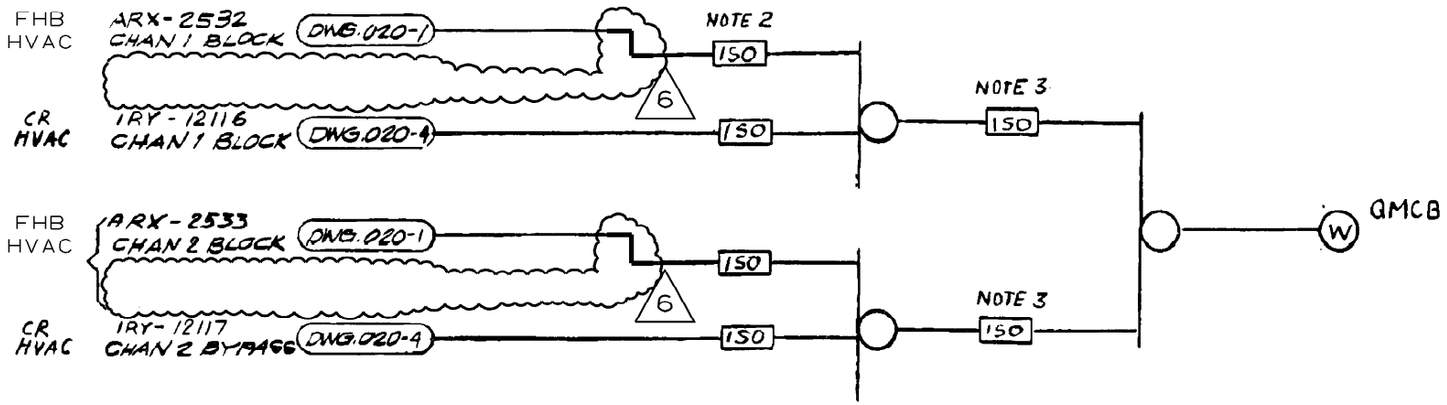

NOTE:

1. LOGIC CONTINUATION SHOWN ON DWG AX5DN020-7 AND AX5DN020-9. OTHER NOTES REFER TO DWG AX5DN020-7
2. CHANEL TO TRAIN ISOLATION DEVICE.
3. TRAIN TO NON-TRAIN ISOLATION DEVICE.

REF. DWGS.
P&ID AX4DB206-1, 2 & 3

NUCLEAR SAFETY RELATED

BOP ESF CHANNEL BYPASS INDICATION "Q"

NO.	REVISIONS	DATE	DR	CHK	APPV	DTL
△						
△						
6	INCORPORATED PER DCP 96-VAN0039	05-16-00	CD	SM	MWD	X
0	ISSUED FOR CONSTRUCTION	SEE MICROFILM FOR SIGNATURES				

SOUTHERN COMPANY SERVICES, INC.
BIRMINGHAM, ALABAMA

GEORGIA POWER COMPANY
ALVIN W. VOGTLE NUCLEAR PLANT

CONTROL LOGIC DIAGRAM BOP SAFETY ACTUATION SYSTEM

SCALE: NONE	DRAWING NO.	REV
JOB NO. 10604	AX5DN020-8	6

THIS DOCUMENT CONTAINS PROPRIETARY, CONFIDENTIAL, AND/OR TRADE SECRET INFORMATION OF THE SUBSIDIARIES OF THE SOUTHERN COMPANY OR OF THIRD PARTIES. IT IS INTENDED FOR USE ONLY BY EMPLOYEES OF, OR AUTHORIZED CONTRACTORS OF, THE SUBSIDIARIES OF THE SOUTHERN COMPANY. UNAUTHORIZED POSSESSION, USE, DISTRIBUTION, COPYING, DISSEMINATION, OR DISCLOSURE OF ANY PORTION HEREOF IS PROHIBITED.

SIZE B 11x17

This drawing and the design it covers are the property of BECHTEL. They are produced, copied, loaned, exhibited, or used except in the limited way and private use permitted by any written consent given by the lender to the borrower.

MONITOR & ALARM

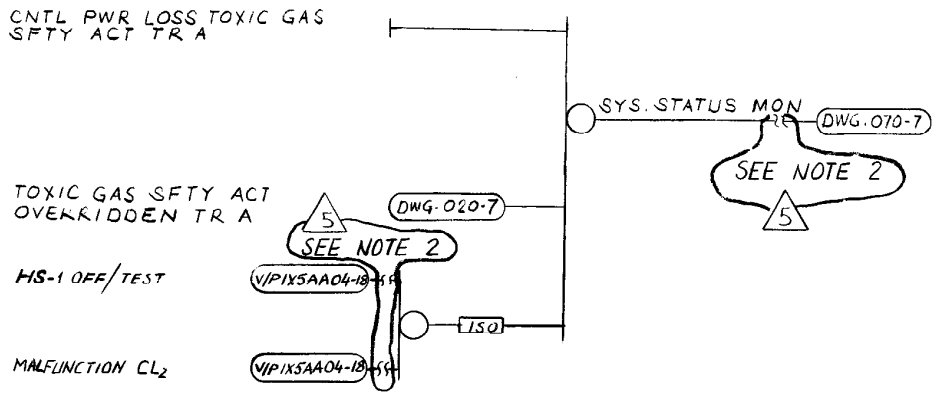

NOTE:

1. SYSTEM STATUS MONITOR UNIT 1 TRAIN A SHOWN. UNIT 1 TRAIN B, UNIT 2 TRAIN A AND UNIT 2 TRAIN B SIMILAR AS TABULATED IN TABLE 1 ON DWG AX5DN020-10.

5 2. FOR UNIT 2, TOXIC GAS (CHLORINE) DETECTION CIRCUIT IS DISABLED.

REF. DWGS
P&ID AX4DB206-1, 2 & 3
E.D. 1X3D-BG-E04E, F
2X3D-BG-E04E, F

NUCLEAR SAFETY RELATED

TOXIC GAS SAFETY ACTUATION "Q"

NO.	REVISIONS	DATE	DR	CHK.	SUPV.	EGL	EGS	CHF. E.	P. E.	Q. A. E.	ENG. MGR.
6	DELETED H_2S INPUT PER LETTER SB4846	2-3-89	ALV	FAL	X	PC'd		X		X	
5	INCORPORATE DCN #2 (IDCN #37, B20012M)	2-1-89	RSK	RJT	X	RJT		X		X	X
4	INCORPORATED DCN #1	10-30-86	ZED		X				WHX	X	DATE
3	ISSUED FOR CONSTRUCTION	3-14-86	HL	FAL	X					X	

BECHTEL
LOS ANGELES

GEORGIA POWER COMPANY
ALVIN W. VOGTLE NUCLEAR PLANT

CONTROL LOGIC DIAGRAM
BOP SAFETY ACTUATION SYSTEM

SCALE: NONE	DRAWING NO.	REV.
JOB NO. 9510	AX5DN020-9	5

SIZE B 11 x 17

BM 9510 P&ID 206-1 REV. P&ID 206-3 REV 206-2 REV

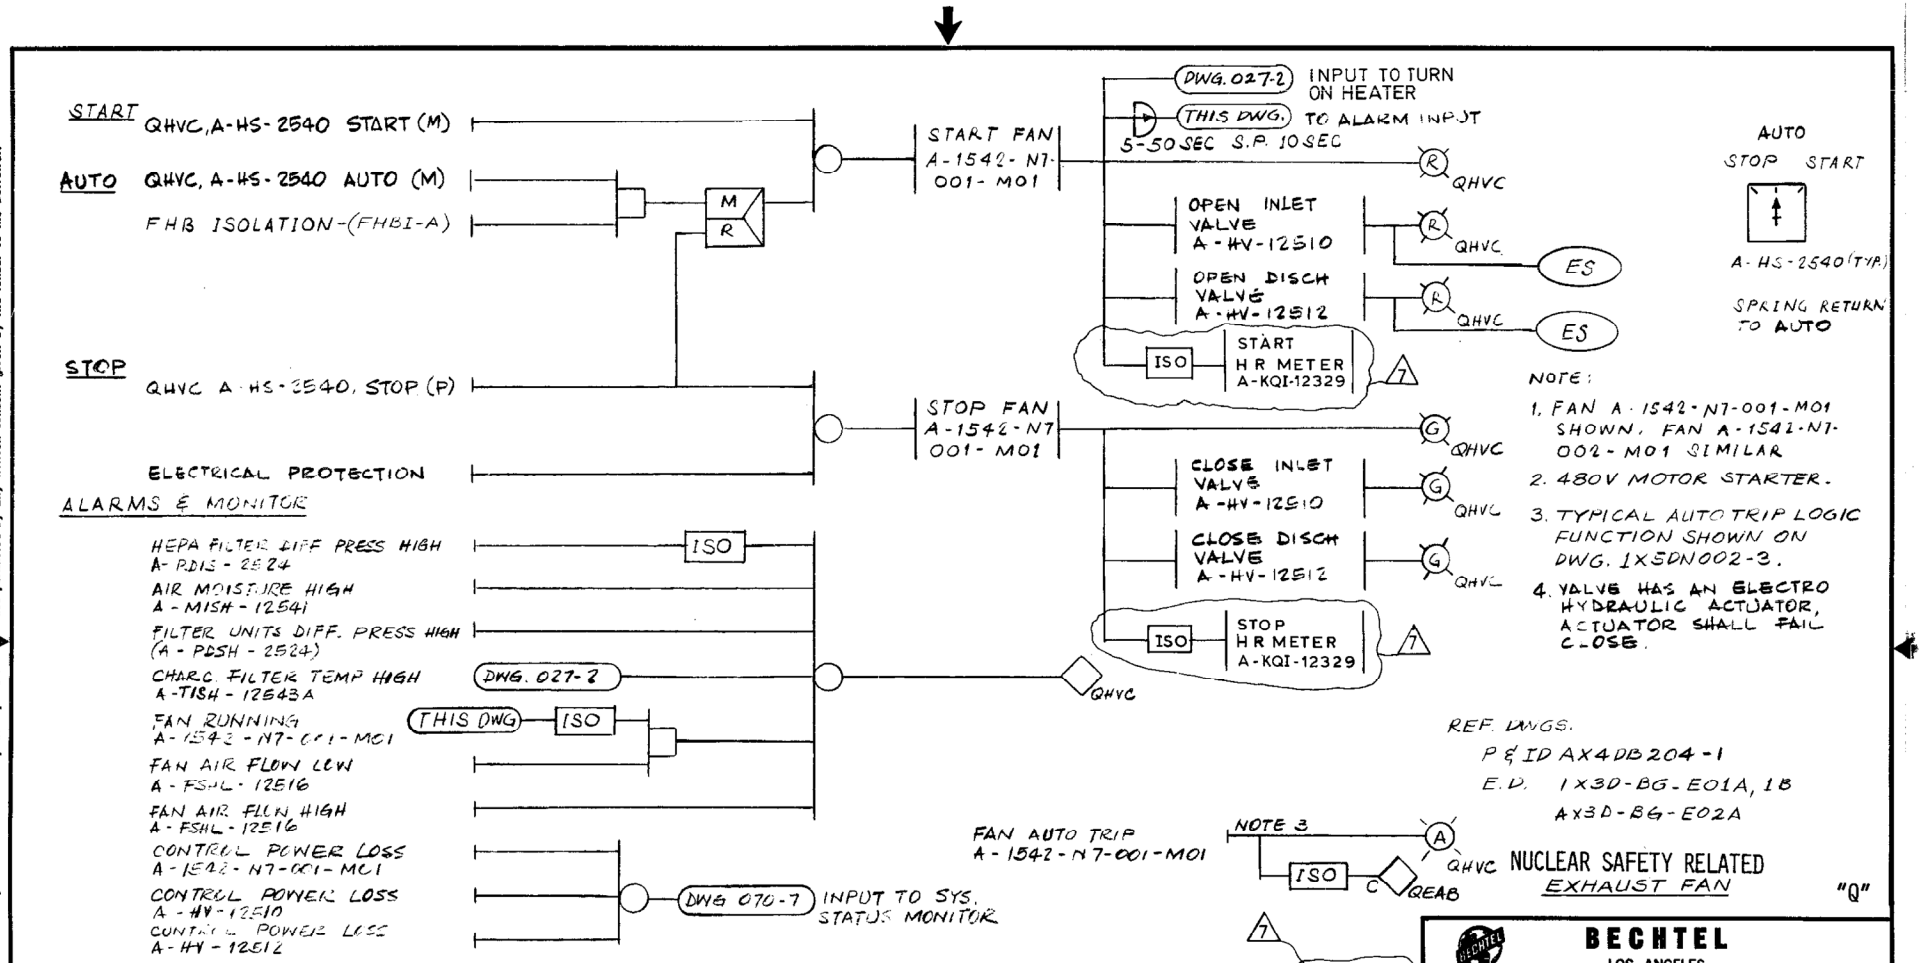

ΔP SW	TRAIN	EQUIPT. TAG NO:	SWITCH	SAFETY SIG	VALVE	VALVE	FLOW SW	ΔP SW	MOIST SW	H R METER
A-PDSH-2524	UNIT 1-A	A-1542-N7-001-M01	A-HS-2540	FHBI-A	A-HV-12510	A-HV-12512	A-FSHL-12516	A-PDIS-2524	A-MISH-12541	A-KQI-12329
A-PDSH-2525	↓ 1-B	A-1542-N7-002-M01	A-HS-2541	FHBI-B	A-HV-12511	A-HV-12513	A-FSHL-12517	A-PDIS-2525	A-MISH-12542	A-KQI-12330

NO.	REVISIONS	DATE	DR	CHK.	SUPV.	EGS	CHF. E.	P.E.	Q.A.E.
6	CORRECTED EQUIP. NO.	3/28/85	ZEP	ALV					
5	INCORP. ABN-00022	11/29	W.V.G.						
6	ISSUED FOR CONSTRUCTION	4-27-79	HL	FAL	MKK				

ENG. MGR. / DATE

BECHTEL
LOS ANGELES

GEORGIA POWER COMPANY
ALVIN W. VOGTLE NUCLEAR PLANT

CONTROL LOGIC DIAGRAM
FUEL HANDLING BUILDING
EMERGENCY HVAC SYSTEM

SCALE: NONE	DRAWING NO.	REV.
JOB NO. 9510	AX5DN027-1	7

P&ID 204-1 REV. 7

SIZE B 11 x 17

use permitted by any written consent given by the lender to the borrower.
limited way and private

This drawing and the design it covers are the property of BECHTEL. They are merely loaned and on the borrower's express agreement that they will not be reproduced, copied, loaned, exhibited, or used except in the limited way and private use permitted by any written consent given by the lender to the borrower.

START

QHVC, A-HS-12522 START (M)

START FAN A-1541-A7-003-M01

R QHVC

THIS DWG INPUT TO HEATER

STOP

QHVC, A-HS-12522, STOP (M)

ELECTRICAL PROTECTION

STOP FAN A-1541-A7-003-M01

G QHVC

STOP START

A-HS-12522
A-HS-12523
MAINTAINED

NOTE:

1. FAN A-1541-A7-003-M01 SHOWN, OTHER FAN SIMILAR AS LISTED IN TABLE 1
2. HEATER A-1541-H7-005-000 SHOWN, OTHER HEATER LISTED IN TABLE 2 SIMILAR
3. 480 V MOTOR STARTER
4. HEATER SHALL TURN ON PROVIDED BUILT-IN PERMISSIVES ARE SATISFIED AS SHOWN

REF. DWGS.

P&ID AX4DB204-1
E.D. AX3D-BG-E016, 01H, 01K

ON

FAN RUNNING A-1541-A7-003-M01

THIS DWG

BUILT-IN THERMAL CUTOUT

BUILT-IN AIR FLOW SW LOW A-FS-12484

ELECTRICAL PROTECTION

OFF

ENABLE TO TURN ON HEATER A-1541-H7-005-000 THRU A-TIC-12518A

TURN OFF HEATER A-1541-H7-005-000

TABLE 1

AREA	EQUIP. TAG NO.	SWITCH	
FUEL POOL	A-1541-A7-003-M01	A-HS-12522	
FHB CORRIDOR	A-1541-A7-004-M01	A-HS-12523	

TABLE 2

FLOW SW	HEATER	FAN RUNNING	TEMP CNTL
A-FS-12484	A-1541-H7-005-000	A-1541-A7-003-M01	A-TIC-12518A
A-FS-12485	A-1541-H7-006-000	A-1541-A7-004-M01	A-TIC-12519A

NO.	REVISIONS	DATE	DR	CHK.	SUPV.	EGL	EGS	CHF. E.	P.E.	Q.A.E.	
2	MOVED FAN A-1541-A7-005 TO AX5DN028-2 & REV. AS SHOWN	3/6/85	ZEP	ALV							ENG. MGR.
1	ADDED SW TAG NUMBER	1-17-85	ALV								
A	CORRECTED EQUIPMENT TAG NO.	6-13-83	ARS	FAL		PEK					DATE
0	ISSUED FOR CONSTRUCTION	4-27-79		FAL	MKK						

BECHTEL
LOS ANGELES

GEORGIA POWER COMPANY
ALVIN W. VOGTLE NUCLEAR PLANT

CONTROL LOGIC DIAGRAM
FUEL HANDLING BUILDING
AIR CIRCULATOR FANS

SCALE: NONE	DRAWING NO.	REV.
JOB NO. 9510	AX5DN028-1	6

P&ID 204-1 REV. 3

SIZE B 11 x 17

SCANNED DATE 11-19-91

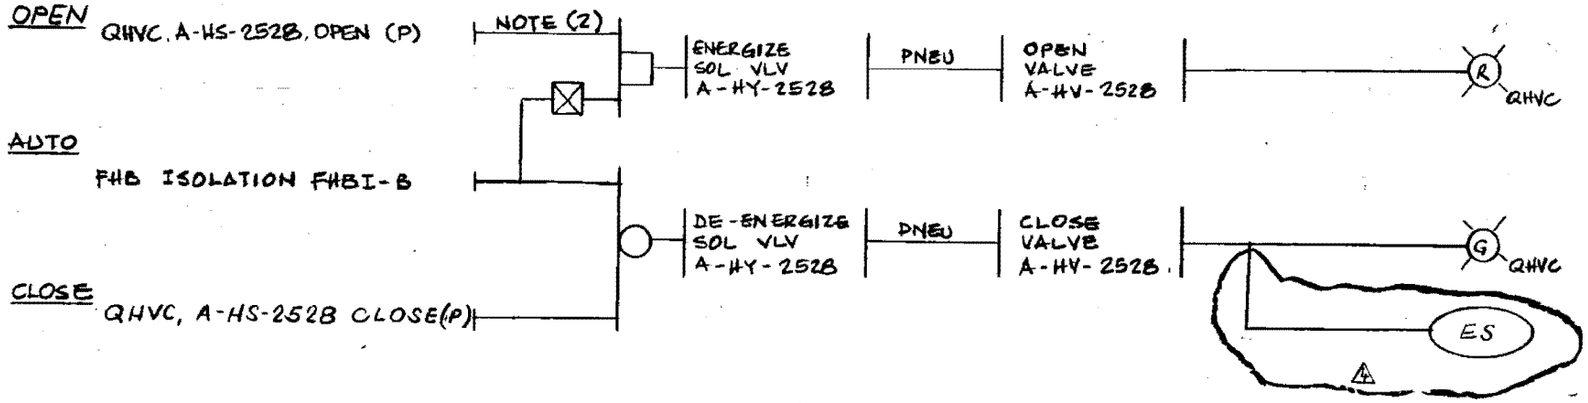

TABLE 1

TRAIN	VALVE	SOL VLV	HAND SW	SAFETY SIG
UNIT 1 B	A-HV-2528	A-HY-2528	A-HS-2528	FHBI-B
A	29	29	29	A
B	34	34	34	B
A	35	35	35	A

NOTE:

1. VALVE A-HV-2528 SHOWN, OTHER VALVES SIMILAR AS LISTED IN TABLE 1.
2. TO OPEN VALVE CONTROL SWITCH SHALL BE HELD ON OPEN POSITION UNTIL DAMPER IS FULLY OPEN TO ALLOW THE CIRCUIT TO SEAL-IN THROUGH VALVE POSITION SWITCH.

REF. DWGS. P&ID AX4DB204-1
E.D. AX3D-BG-E02H; E02G
4

NUCLEAR SAFETY RELATED

"Q"

NO.	REVISIONS	DATE	DR	CHK.	SUPV.	EGL	EGS	CHF. E.	P.E.	Q.A.E.
3	REVISED TO MOVE DAMPERS TO AX5DN029-3	5-11-84	ALV				PCL			
2	REVISED REF. DWGS.	12-8-83	AT	FAL			PCL			
1	ADDED COMPUTER INPUT, INCORP DCN1	12-5-84	JAG	ALV						
0	ISSUED FOR CONSTRUCTION	4-27-79	HL	FAL	MKK					

ENG. MGR. DATE

BECHTEL
LOS ANGELES

GEORGIA POWER COMPANY
ALVIN W. VOGTLE NUCLEAR PLANT

CONTROL LOGIC DIAGRAM
FUEL HANDLING BUILDING
HVAC ISOLATION VALVES

SCALE: NONE	DRAWING NO.	REV.
JOB NO. 9510	AX5DN029-1	4

SIZE B 11 x 17

P&ID 204-1 REV 6
-2 REV. 5

This drawing and the design it covers are the property of BECHTEL. They are merely loaned and as the borrower's express agreement that they will not be reproduced, copied, loaned, exhibited, or used except in the limited way and private use permitted by any written consent given by the loaner to the borrower.

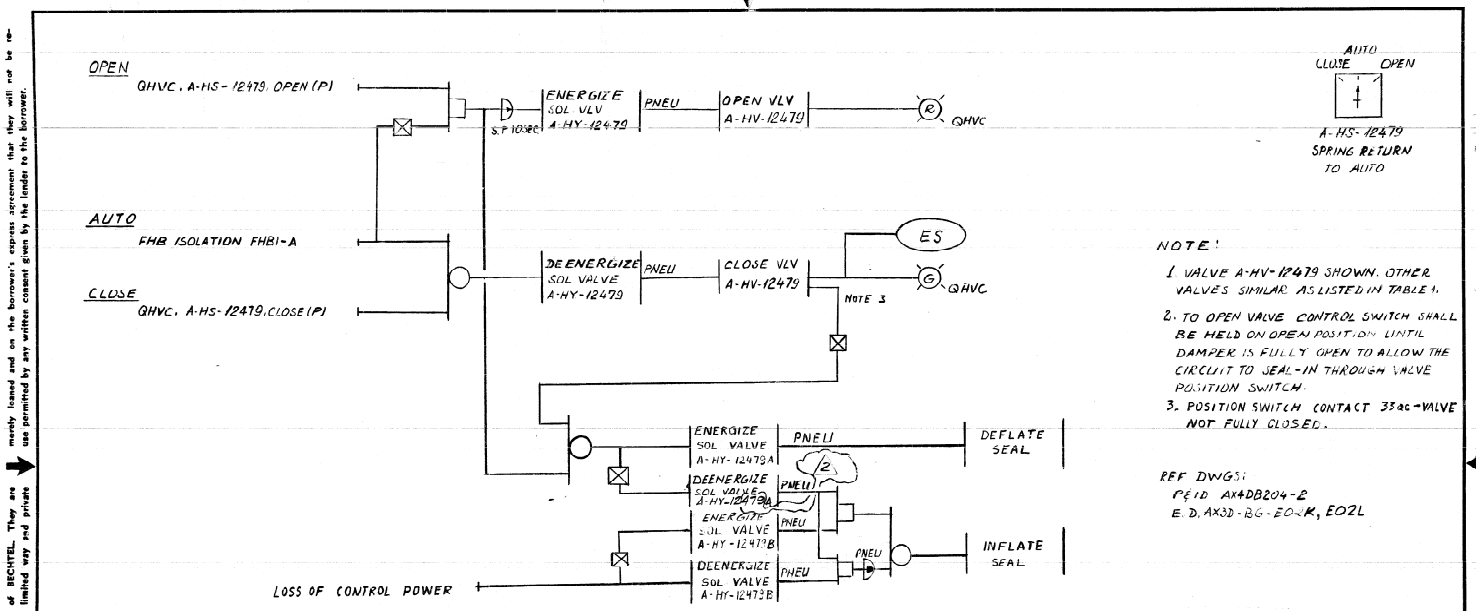

NOTE:

1. VALVE A-HV-12479 SHOWN. OTHER VALVES SIMILAR AS LISTED IN TABLE 1.
2. TO OPEN VALVE CONTROL SWITCH SHALL BE HELD ON OPEN POSITION UNTIL DAMPER IS FULLY OPEN TO ALLOW THE CIRCUIT TO SEAL-IN THROUGH VALVE POSITION SWITCH.
3. POSITION SWITCH CONTACT 33ac→VALVE NOT FULLY CLOSED.

REF DWGS:
P&ID AX4DB204-2
E.D. AX3D-BG-E02K, E02L

TABLE 1

TRAIN	VALVE	SOL VALVE	HAND SW.	SAFETY SIG	SEAL CNTL	DMPR. PROT
TRAIN A	A-HV-12479	A-HY-12479	A-HS-12479	FHBI-A	A-HY-12479A	A-HY-12479B
B	12480	12480	-12480	-B	12480A	12480B
A	12481	12481	-12481	-A	12481A	12481B
B	12482	12482	-12482	-B	12482A	12482B

NUCLEAR SAFETY RELATED "Q"

NO.	REVISIONS	DATE	DR	CHK.	SUPV.	EGL	EGS	CHF. E.	P. E.	Q. A. E.
3	CORRECTED TAG NO.	3/28/85	ZEP	ALV						
2	ADDED COMPUTER INPUT, INCORP DCN1	12-5-84	JAG	ALV						
1	ISSUED FOR CONSTRUCTION	5-15-84	ALV							

ENG. MGR. / DATE

BECHTEL
LOS ANGELES

GEORGIA POWER COMPANY
ALVIN W. VOGTLE NUCLEAR PLANT

CONTROL LOGIC DIAGRAM
FUEL HANDLING BUILDING
HVAC ISOLATION VALVES

SCALE: NONE	DRAWING NO.	REV.
JOB NO. 9510	AX5DN029-3	2

SIZE B 11 x 17

BM 9510 P&ID REV 5

This drawing and the design it covers are the property of BECHTEL. They are merely loaned and on the borrower's express agreement that they will not be reproduced, copied, loaned, exhibited or used except in the limited way and private use permitted by any written consent given by the lender to the borrower.

I CERTIFY THAT THE IMAGE CONTAINED ON THIS FRAME WAS MADE IN THE NORMAL AND REGULAR COURSE OF BUSINESS, ON THE DATE STATED BELOW AND THAT IT IS AN ACCURATE REPRODUCTION OF THE DOCUMENT SUBMITTED TO MICROGRAPHICS.
3-28-85 D. Collins D. K. Ellison
DATE CAMERA OPERATOR SECTION SUPERVISOR

I CERTIFY THAT THE IMAGE CONTAINED ON THIS FRAME WAS MADE IN THE NORMAL AND REGULAR COURSE OF BUSINESS, ON THE DATE STATED BELOW AND THAT IT IS AN ACCURATE REPRODUCTION OF THE DOCUMENT SUBMITTED TO MICROGRAPHICS.
3-28-85 D. Collins D. K. Ellison
DATE CAMERA OPERATOR SECTION SUPERVISOR

THIS DOCUMENT CONTAINS PROPRIETARY, CONFIDENTIAL AND/OR TRADE SECRET INFORMATION OF THE SOUTHERN COMPANY OR OF THE SUBSIDIARIES OF THE SOUTHERN COMPANY. IT IS INTENDED FOR USE ONLY BY EMPLOYEES OF, OR AUTHORIZED CONTRACTORS OF, THE SOUTHERN COMPANY. UNAUTHORIZED POSSESSION, USE, DISTRIBUTION, COPYING, DISSEMINATION, OR DISCLOSURE OF ANY PORTION HEREOF IS PROHIBITED.

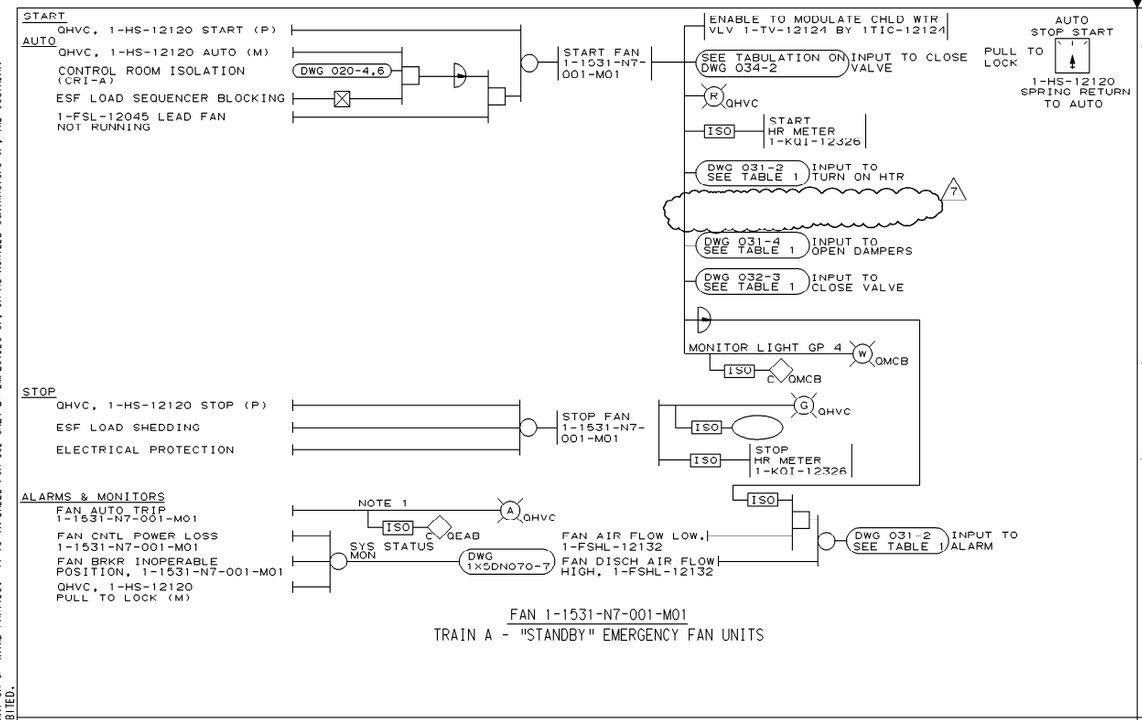

FAN 1-1531-N7-001-M01
TRAIN A - "STANDBY" EMERGENCY FAN UNITS

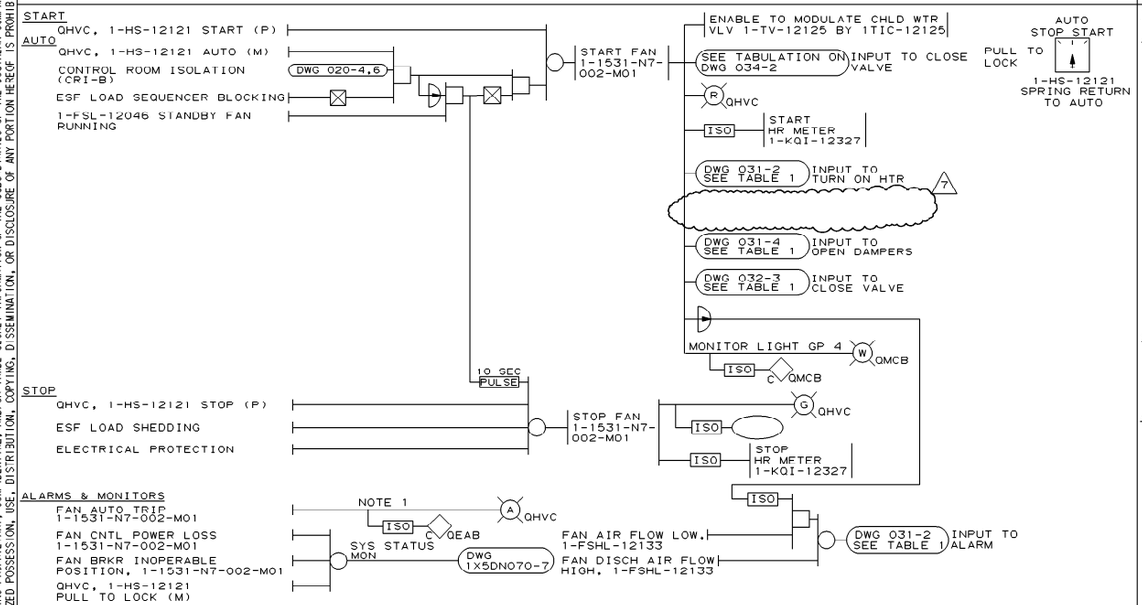

FAN 1-1531-N7-002-M01
TRAIN B - "LEAD" EMERGENCY FAN UNITS

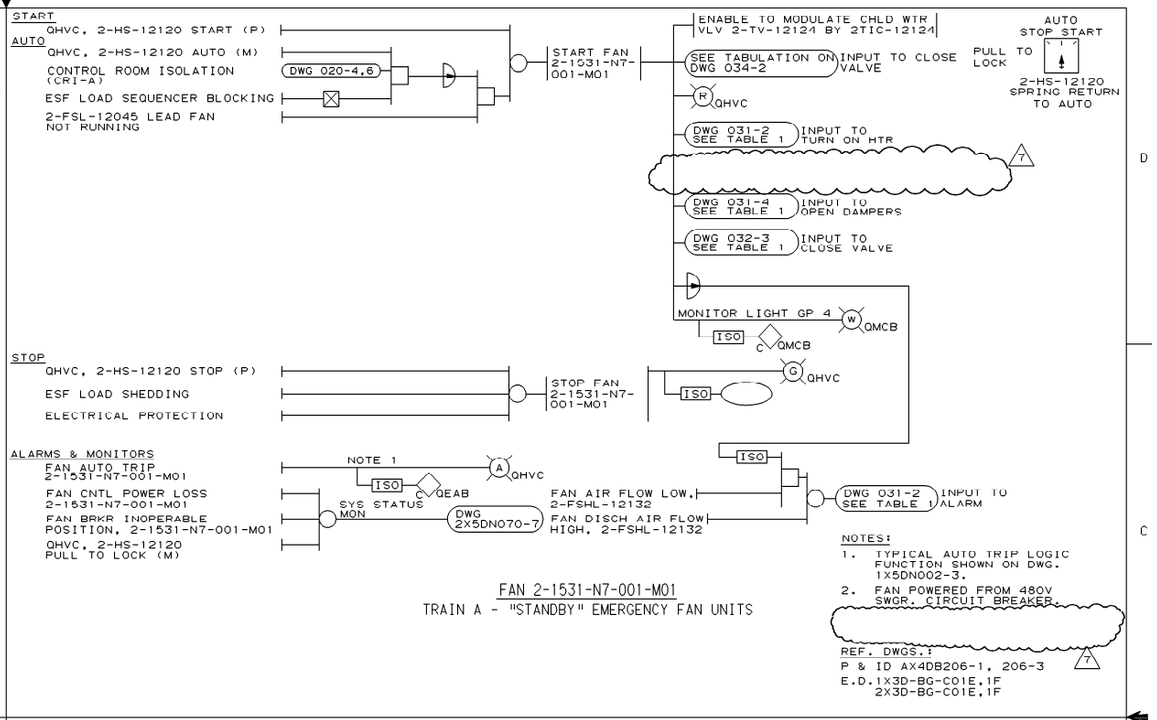

FAN 2-1531-N7-001-M01
TRAIN A - "STANDBY" EMERGENCY FAN UNITS

NOTES:
1. TYPICAL AUTO TRIP LOGIC FUNCTION SHOWN ON DWG. 1X5DN002-3.
2. FAN POWERED FROM 480V SWGR. CIRCUIT BREAKER.

REF. DWGS.:
P & ID AX4DB206-1, 206-3
E.D.1X3D-BG-C01E,1F
2X3D-BG-C01E,1F

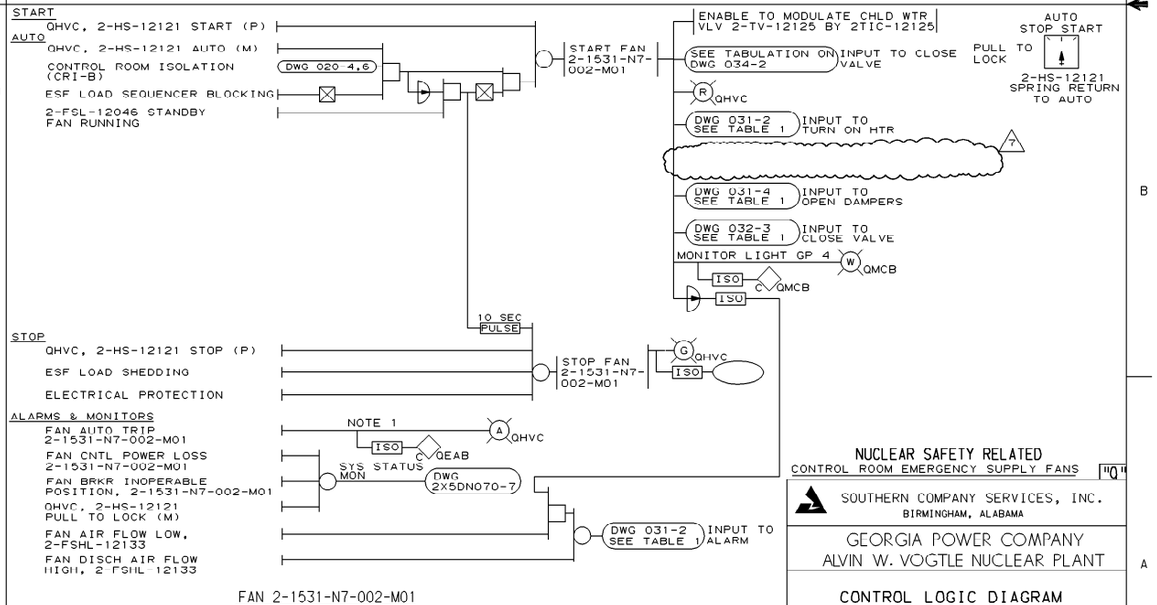

FAN 2-1531-N7-002-M01
TRAIN B - "LEAD" EMERGENCY FAN UNITS

NUCLEAR SAFETY RELATED
CONTROL ROOM EMERGENCY SUPPLY FANS "Q"

SOUTHERN COMPANY SERVICES, INC.
BIRMINGHAM, ALABAMA

GEORGIA POWER COMPANY
ALVIN W. VOGTLE NUCLEAR PLANT

CONTROL LOGIC DIAGRAM
CONTROL BUILDING CONTROL ROOM
HVAC EMERGENCY SYSTEM

NO.	REVISIONS	DATE	DR	CHK	APPV	DTL
1	INCORP. PER DCP 89-V1N0297.	10-14-96	CD	GLB	WFP	
0	ISSUED FOR CONSTRUCTION	SEE MICROFILM FOR SIGNATURES				

SCALE: NONE
JOB NO. 10604
DRAWING NO. AX5DN031-1
REV. 7
SIZE D 22X34
CAD NAME A5DN031

This drawing and the design it covers are the property of BECHTEL. They are produced, copied, loaned, exhibited, or used except in the limited way and private use permitted by any written consent given by the lender to the borrower. merely loaned and on the borrower's express agreement that they will not be re-

ALARMS

- FAN AIR FLOW HIGH-LOW — DWG 031-1
- CHARCOAL FILTER TEMP HIGH 1-TSH-12134
- CHARCOAL FILTER INLET MOISTURE HIGH 1-MISH-12169
- FAN FILTER UNIT DIFF. PRESS. HIGH (1-PDSH-12136)
- HEPA FILTER DIFF. PRESS. HIGH (1-PDIS-12136) — ISO

→ QHVC

CHARCOAL FILTER TEMP HIGH HIGH, 1-TSH-12134 → QHVC

CLOSE OPEN

1-HS-12193 MAINTAINED

TABLE 1

FILTER UNIT	TEMP. SW.	DIFF. PRESS. SW.		MOISTURE SW.
1-1531-N7-001-000	1-TSH-12134	1-PDIS-12136	1-PDSH-12136	1-MISH-12169
1-1531-N7-002-000	↓ 12135	↓ 12137	↓ 12137	↓ 12170
2-1531-N7-001-000	2-TSH-12134	2-PDIS-12136	2-PDSH-12136	2-MISH-12169
2-1531-N7-002-000	↓ 12135	↓ 12137	↓ 12137	↓ 12170

HEATER CONTROL

ON

- BUILT-IN THERMAL CUT OUT
- FAN RUNNING 1-1531-N7-001-M01 — DWG 031-1
- ELECTRICAL PROTECTION

→ ENABLE TO TURN ON HEATER 1-1531-N7-001-H01 THROUGH 1-MC-12160 → (R) TABLE 2

→ TURN OFF HEATER 1-1531-N7-001-H01

TABLE 4

SOL. VLV	TEMP SW
1-TV-12134	1-TSH-12134
↓ 5	↓ 5

7

OFF

- HEATER FEEDER BRKR OFF 1-1531-N7-001-H01 — 150

FIRE PROTECTION

OPEN

- CHARCOAL FILTER TEMP HIGH HIGH 1-TSH-12134 → ENERGIZE SOL, OPEN VALVE 1-TV-12134 → (R) QHVC

CLOSE

- DE-ENERGIZE SOL, CLOSE VALVE 1-TV-12134 → (G) QHVC

TABLE 4

OPEN

- QHVC, 1-HS-12193, OPEN (M) → ENERG. SOL VLV 1-HY-12193 → PNEU → OPEN VALVE 1-HV-12193 → (R) QHVC

CLOSE

- QHVC, 1-HS-12193, CLOSE (M) → DE-ENERG SOL VLV 1-HY-12193 → PNEU → CLOSE VALVE 1-HV-12193 → (G) QHVC

TABLE 3

NOTE:

1. TYPICAL ALARMS & FIRE PROTECTION SHOWN, OTHERS SIMILAR AS LISTED IN TABLE 1, 3 & 4.
2. TYPICAL HEATER CONTROL SHOWN, OTHER HEATERS LISTED IN TABLE 2 SIMILAR.
3. HEATER WILL TURN ON PROVIDED BUILT-IN PERMISSIVES ARE SATISFIED AS SHOWN.
4. SOLENOID VALVES LISTED IN TABLE 4 ARE PART OF A VENDOR PACKAGE WITH TEMP. SWITCH.

REF. DWGS.
P&ID AX4DB 206-1 & 206-3
E.D. 12X30-BG-C05R, T, Z
~~12X30-BH-F02A~~

TABLE 2

HEATER	FAN RUNNING	TEMP CNTL	MOISTURE CNTL
1-1531-N7-001-H01	1-1531-N7-001-M01	1-TIC-12124	1-MC-12160
↓ 002	↓ 002	↓ 5	↓ 70
2-1531-N7-001-H01	2-1531-N7-001-M01	2-TIC-12124	2-MC-12160
↓ 002	↓ 002	↓ 5	↓ 70

TABLE 3

VALVE	SOL VLV	HAND SW.
1-HV-12193	1-HY-12193	1-HS-12193
↓ 4	↓ 12194	↓ 12194
2-HV-12193	2-HY 12193	2-HS-12193
↓ 4	↓ 12194	↓ 12194

NUCLEAR SAFETY RELATED

DUCT HEATER AND ALARMS "Q"

BECHTEL
LOS ANGELES

GEORGIA POWER COMPANY
ALVIN W. VOGTLE NUCLEAR PLANT

CONTROL LOGIC DIAGRAM
CONTROL BUILDING CONTROL ROOM HVAC EMERGENCY SYSTEM

SCALE: NONE | DRAWING NO. AX5DN031-2 | REV. 7

JOB NO. 9510

NO.	REVISIONS	DATE	DR	CHK.	SUPV.	EGL	EGS	CHF. E.	P. E.	Q.A.E.
6	DELETED FLOW SW. PER VIP AX4AT07-402-C	8/6/87	ALV	ACG	X			X		X
5	ADDED LIGHT PER DCN #27, P&I AX4DB206-3	8-29-85	ZAP	ALV	X			X		X
4	INC. DCN #1	2-1-89	RK		X			X		X
0	ISSUED FOR CONSTRUCTION (SIGNATURES AS SHOWN ON MICROFILM)	1-30-79			X			X		X

ENG. MGR. | DATE

BM 9510 P&ID 206-1 REV -3 REV.

SIZE B 11 x 17

SCANNED DATE: 11-19-91

KM

This drawing and the design it covers are the property of BECHTEL. They are merely loaned and on the borrower's express agreement that they will not be reproduced, copied, loaned, exhibited, or used except in the limited way and private use permitted by any written consent given by the lender to the borrower.

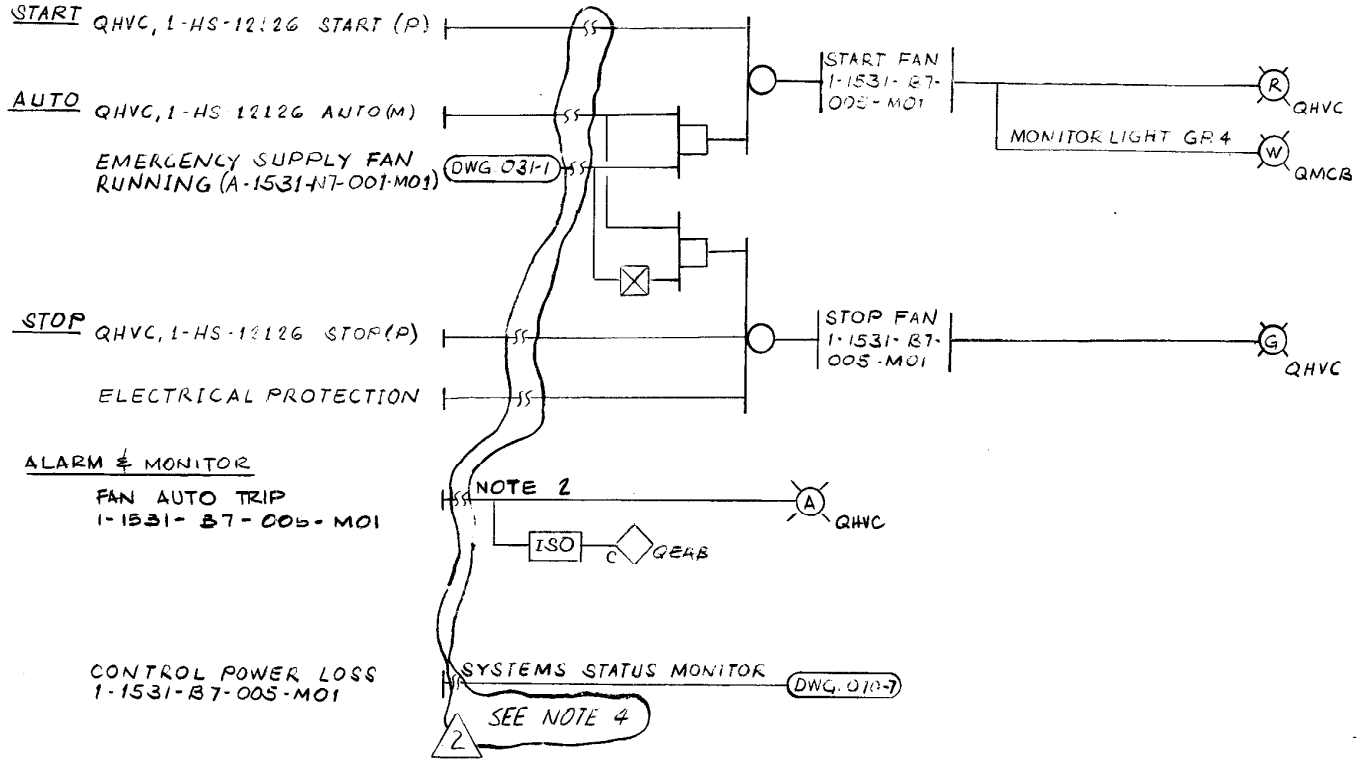

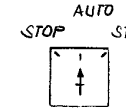

1-HS-12126 (TYP.)
SPRING RETURN TO AUTO

NOTE:

1. EMERGENCY RETURN FAN 1-1531-B7-005-M01 SHOWN OTHER FANS LISTED IN TABLE 1 SIMILAR.
2. TYPICAL AUTO TRIP LOGIC FUNCTION SHOWN ON DWG 1X5DN002-B
3. 480V MOTOR STARTER
4. (2) FOR UNIT 2, CONTROL ROOM EMERGENCY RETURN FANS AND CONTROL SWITCHES 2HS-12126 & 2HS-12127 ARE DISABLED AND THE ALARM IS DISCONNECTED.

REF DWGS: E.D. 1X5D-BG-C02Y, Z
2X5D-BG-C02Y, Z
P&ID AX4DB206-1 & 206-3

TABLE 1

TRAIN	RETURN FAN	CNTL SW.	SUPPLY FAN
A	1-1531-B7-005-M01	1-HS-12126	1-1531-N7-001-M01
B	1-1531-B7-006-M01	1-HS-12127	1-1531-N7-002-M01
A	2-1531-B7-005-M01	2-HS-12126	2-1531-N7-001-M01
B	2-1531-B7-006-M01	2-HS-12127	2-1531-N7-002-M01

NUCLEAR SAFETY RELATED "Q"

CONTROL ROOM EMERGENCY RETURN FAN

NO.	REVISIONS	DATE	DR	CHK.	SUPV.	EGL	EGS	CHF. E.	P. E.	Q.A.E.
3	INC. DCN #1 (IDCN #3 B20016M)	2-1-89	RSK	RSH		ITOO				
1	REVISED AS INDICATED	3/13/80	HL	FAL						
0	ISSUED FOR CONSTRUCTION	1-30-79	HL	FAL	MKK					

ENG. MGR. DATE

BECHTEL
LOS ANGELES

GEORGIA POWER COMPANY
ALVIN W. VOGTLE NUCLEAR PLANT

CONTROL LOGIC DIAGRAM
CONTROL BUILDING CONTROL ROOM HVAC EMERGENCY SYSTEM

SCALE: NONE	DRAWING NO.	REV.
JOB NO. 9510	AX5DN031-3	2

SIZE B 11 x 17

BM 9510

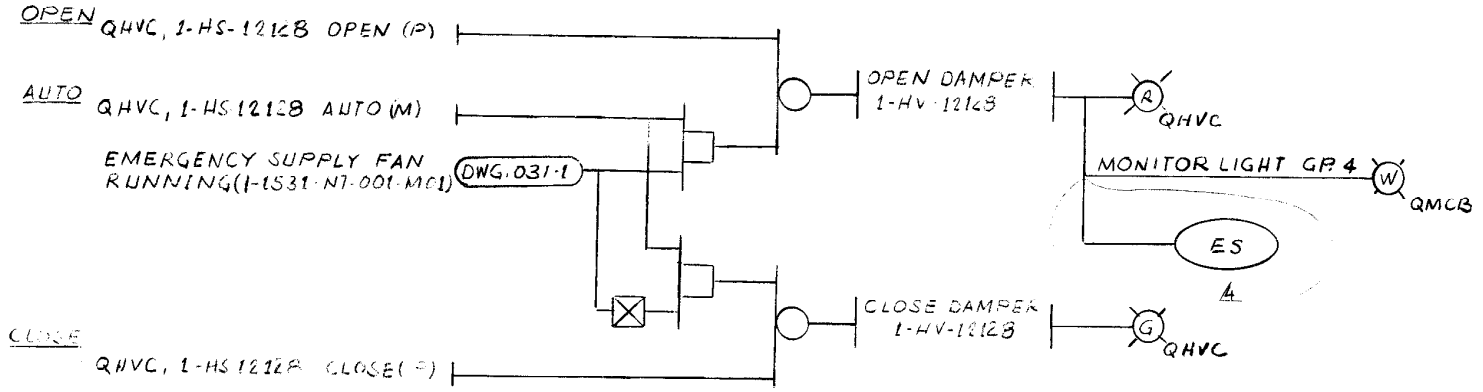

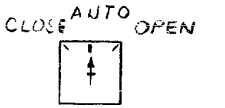

NOTE:

1. DAMPER 1-HV-12128 SHOWN. OTHER DAMPERS LISTED IN TABLE 1 ARE SIMILAR.

MONITOR

DAMPER CNTL PWR LOSS 1-HV-12128

SYSTEMS STATUS MONITOR DWG 070-7

TABLE 1

TRAIN	SERVICE	DAMPER	CNTL SW	FAN RUNNING
UNIT 1-A	EMERG. SUPPLY FAN OUTLET	1-HV-12128	1-HS-12128	1-1531-N7-001-M01
UNIT 1-B	↓	1-HV-12129	1-HS-12129	1-1531-N7-002-M01
UNIT 2-A	↓	2-HV-12128	2-HS-12128	2-1531-N7-001-M01
UNIT 2-B	↓	2-HV-12129	2-HS-12129	2-1531-N7-002-M01
UNIT 1-A	EMERG. RETURN FAN INLET	1-HV-12130	1-HS-12130	1-1531-N7-001-M01
UNIT 1-B	↓	1-HV-12131	1-HS-12131	1-1531-N7-002-M01
UNIT 2-A	↓	2-HV-12130	2-HS-12130	2-1531-N7-001-M01
UNIT 2-B	↓	2-HV-12131	2-HS-12131	2-1531-N7-002-M01

REF. DWGS.

P&ID AX0R206-1 & 206-3

E.D. 1X3D-BG-C01 Z

2X3D-BG-C01 Z

NUCLEAR SAFETY RELATED "Q"

CONTROL ROOM EMERG FAN ISOL DAMPER

BECHTEL
LOS ANGELES

GEORGIA POWER COMPANY
ALVIN W. VOGTLE NUCLEAR PLANT

CONTROL LOGIC DIAGRAM

CONTROL BUILDING CONTROL ROOM HVAC EMERGENCY SYSTEM

NO.	REVISIONS	DATE	DR	CHK.	SUPV.	EGL	EGS	CHF. E.	P. E.	Q.A.E.
3	REVISED TO MOVE DAMPER TO AX5DN031-5	5-11-84	ALV							
2	REVISED REF. DWGS.	12-8-81	AV	FAL						
1	ADDED COMPUTER INPUT PER P&ID	6-25-84	ALV							
0	ISSUED FOR CONSTRUCTION	2-1-79	HL	FAL	MKK				MR	

ENG. MGR. | DATE

SCALE: NONE	DRAWING NO.	REV.
JOB NO. 9510	AX5DN031-4	4

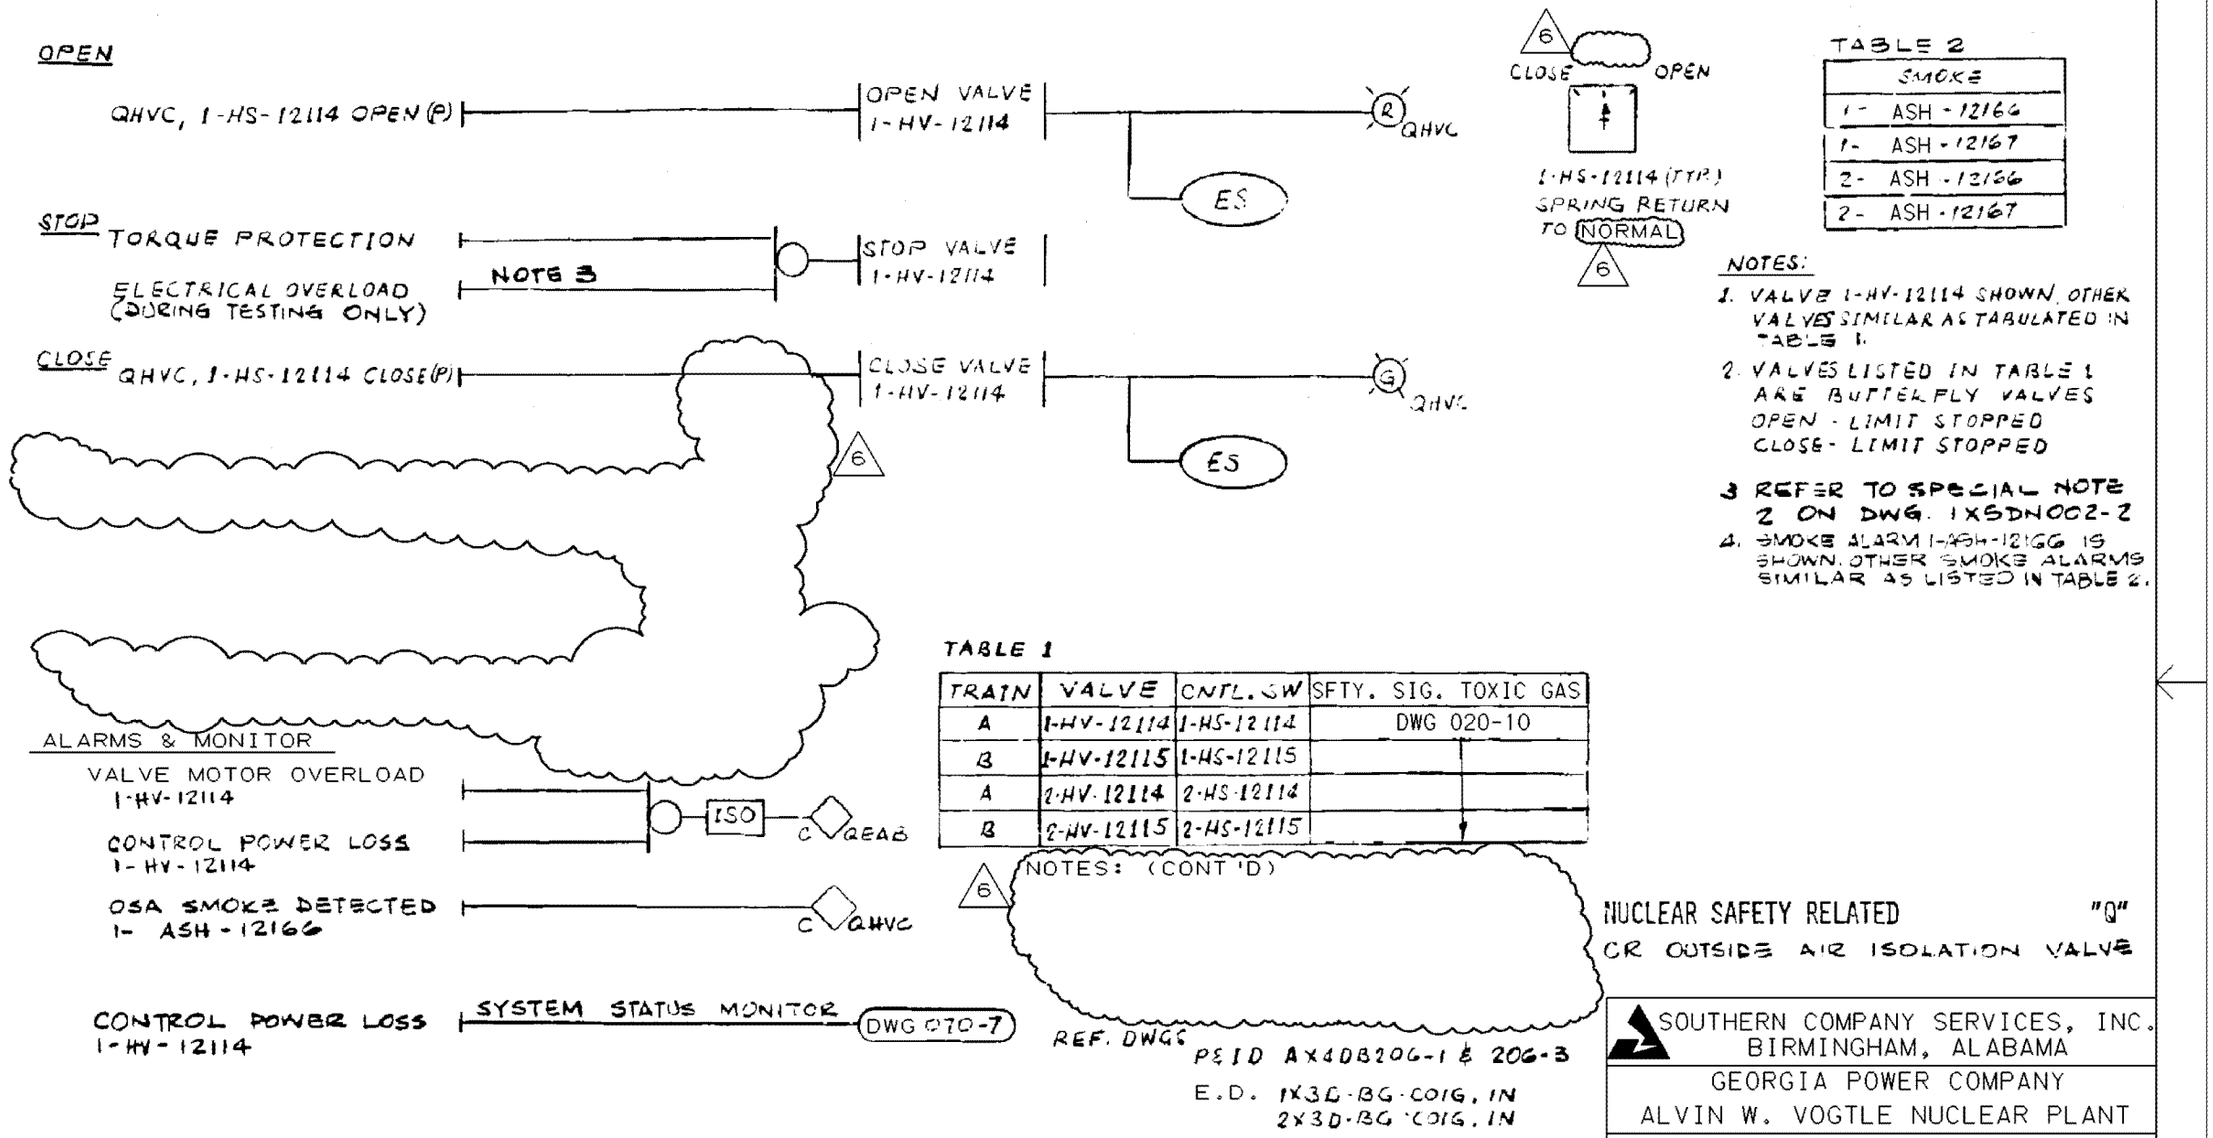

TABLE 2

SMOKE
1- ASH-12166
1- ASH-12167
2- ASH-12166
2- ASH-12167

NOTES:

1. VALVE 1-HV-12114 SHOWN, OTHER VALVES SIMILAR AS TABULATED IN TABLE 1.
2. VALVES LISTED IN TABLE 1 ARE BUTTERFLY VALVES
   OPEN - LIMIT STOPPED
   CLOSE - LIMIT STOPPED
3. REFER TO SPECIAL NOTE 2 ON DWG. 1X5DN002-2
4. SMOKE ALARM 1-ASH-12166 IS SHOWN. OTHER SMOKE ALARMS SIMILAR AS LISTED IN TABLE 2.

TABLE 1

TRAIN	VALVE	CNTL. SW	SFTY. SIG. TOXIC GAS
A	1-HV-12114	1-HS-12114	DWG 020-10
B	1-HV-12115	1-HS-12115	
A	2-HV-12114	2-HS-12114	
B	2-HV-12115	2-HS-12115	

6 NOTES: (CONT'D)

NUCLEAR SAFETY RELATED "Q"
CR OUTSIDE AIR ISOLATION VALVE

REF. DWGS P&ID AX4DB20G-1 & 20G-3
E.D. 1X3D-BG-COIG, IN
2X3D-BG-COIG, IN

SOUTHERN COMPANY SERVICES, INC.
BIRMINGHAM, ALABAMA

GEORGIA POWER COMPANY
ALVIN W. VOGTLE NUCLEAR PLANT

CONTROL LOGIC DIAGRAM CONTROL BUILDING CONTROL ROOM ISOLATION

NO.	REVISIONS	DATE	DR	CHK	APPV	DTL
6	INCORP. PER DCP 89-V1N0297	10-14-96	GS	GLB	WFP	X
0	ISSUED FOR CONSTRUCTION	SEE MICROFILM FOR SIGNATURES				

SCALE: NONE
JOB NO. 10604
DRAWING NO. AX5DN032-1
REV 6

THIS DOCUMENT CONTAINS PROPRIETARY, CONFIDENTIAL, AND/OR TRADE SECRET INFORMATION OF THE SUBSIDIARIES OF THE SOUTHERN COMPANY OR OF THIRD PARTIES. IT IS INTENDED FOR USE ONLY BY EMPLOYEES OF, OR AUTHORIZED CONTRACTORS OF, THE SUBSIDIARIES OF THE SOUTHERN COMPANY. UNAUTHORIZED POSSESSION, USE, DISTRIBUTION, COPYING, DISSEMINATION, OR DISCLOSURE OF ANY PORTION HEREOF IS PROHIBITED.

CAD NAME A5DN0321 SIZE B 11x17

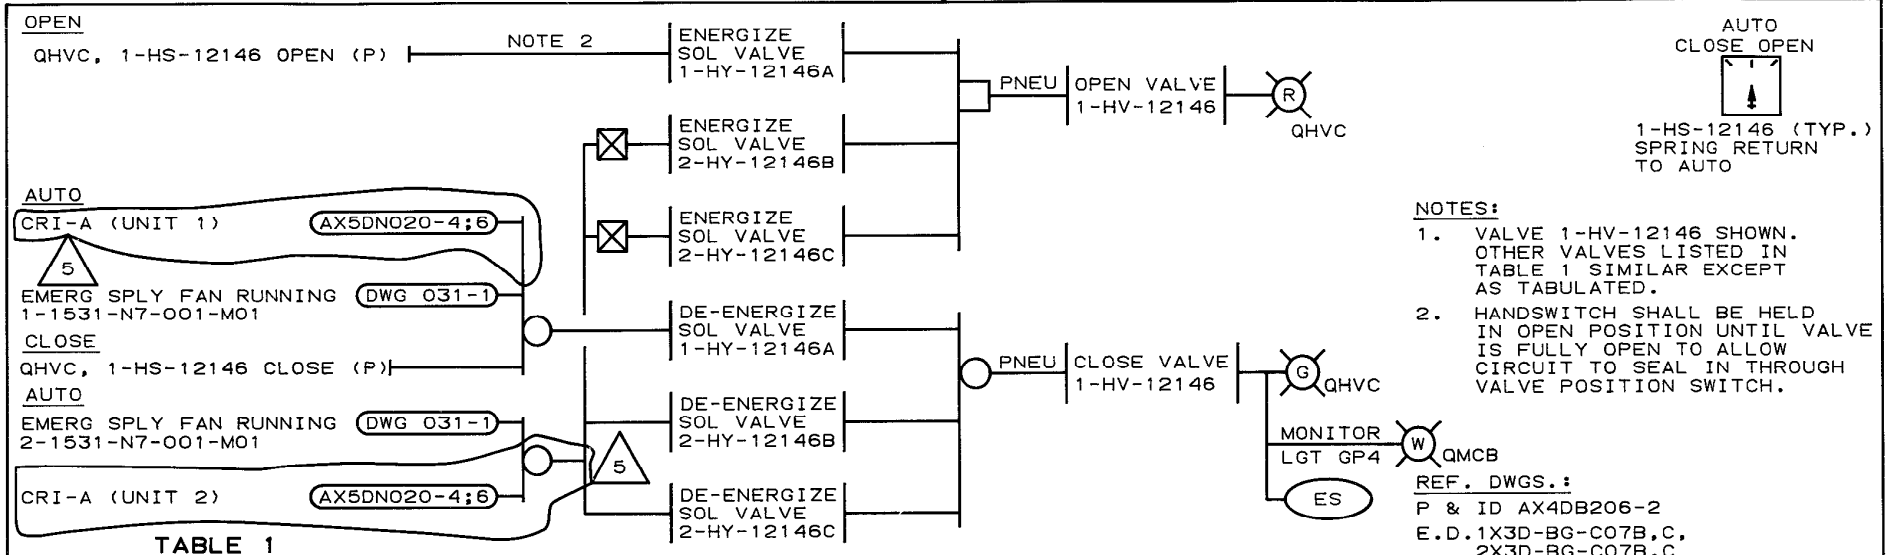

NOTES:

1. VALVE 1-HV-12146 SHOWN. OTHER VALVES LISTED IN TABLE 1 SIMILAR EXCEPT AS TABULATED.
2. HANDSWITCH SHALL BE HELD IN OPEN POSITION UNTIL VALVE IS FULLY OPEN TO ALLOW CIRCUIT TO SEAL IN THROUGH VALVE POSITION SWITCH.

REF. DWGS.:

P & ID AX4DB206-2

E.D.1X3D-BG-C07B,C, 2X3D-BG-C07B,C

TABLE 1

SOL. VLV.	TRAIN	SERVICE	VALVE	SOL. VLV.	CNTL. SW.	FAN NO.	SOL. VLV.	FAN NO.
2-HY-12146C	A	NORMAL SUPPLY	1-HV-12146	1-HY-12146A	1-HS-12146	1-1531-N7-001-M01	2-HY-12146B	2-1531-N7-001-M01
2-HY-12147C	B	FAN OUTLET ISO	1-HV-12147	1-HY-12147A	1-HS-12147	1-1531-N7-002-M01	2-HY-12147B	2-1531-N7-002-M01
1-HY-12146C	A	NORMAL SUPPLY	2-HV-12146	2-HY-12146A	2-HS-12146	2-1531-N7-001-M01	1-HY-12146B	1-1531-N7-001-M01
1-HY-12147C	B	FAN OUTLET ISO	2-HV-12147	2-HY-12147A	2-HS-12147	2-1531-N7-002-M01	1-HY-12147B	1-1531-N7-002-M01
2-HY-12148C	B	NORMAL EXHAUST	1-HV-12148	1-HY-12148A	1-HS-12148	1-1531-N7-002-M01	2-HY-12148B	2-1531-N7-002-M01
2-HY-12149C	A	FAN INLET ISO	1-HV-12149	1-HY-12149A	1-HS-12149	1-1531-N7-001-M01	2-HY-12149B	2-1531-N7-001-M01
1-HY-12148C	B	NORMAL EXHAUST	2-HV-12148	2-HY-12148A	2-HS-12148	2-1531-N7-002-M01	1-HY-12148B	1-1531-N7-002-M01
1-HY-12149C	A	FAN INLET ISO	2-HV-12149	2-HY-12149A	2-HS-12149	2-1531-N7-001-M01	1-HY-12149B	1-1531-N7-001-M01

THIS DRAWING AND THE DESIGN IT COVERS ARE THE PROPERTY OF SCS. THEY ARE LOANED AND ON THAT BORROWER'S BUSINESS AGREEMENT THAT NEITHER AND PRIVATE USE PERMITTED BY ANY WRITTEN CONSENT GIVEN BY THE LENDER TO THE BORROWER. REPRODUCED, COPIED, LOANED, EXHIBITED, OR USED EXCEPT IN THE LIMITED WAY AND

5	INCORP. ABN 03536 (VOIDS DCN #1) & 88-V1N079A007.	2-15-89	CIB	LTM	JBG	LMP					ENG MGR
	REVISIONS	DATE	DR	CHK	RE	DM	DM	DM	PDM		
4	ADDED COMPUTER INPUT. DELETED REF. DWGS.	6/25/84	SEE MICROFILM FOR SIGNATURES								DATE
0	ISSUED FOR CONSTRUCTION	1/4/79	SEE MICROFILM FOR SIGNATURES								
	REVISIONS	DATE	DR	CHK	SUPV	EGL	EGS	CHF E	PE	QAE	

NUCLEAR SAFETY RELATED

CONTROL ROOM NORMAL FAN ISOLATION VALVES

"Q"

SOUTHERN COMPANY SERVICES, INC.
BIRMINGHAM, ALABAMA

GEORGIA POWER COMPANY
ALVIN W. VOGTLE NUCLEAR PLANT

CONTROL LOGIC DIAGRAM CONTROL BUILDING CONTROL ROOM ISOLATION

SCALE: NONE	DRAWING NO.	REV
JOB NO. 10604	AX5DN032-3	5

SIZE B 11x17

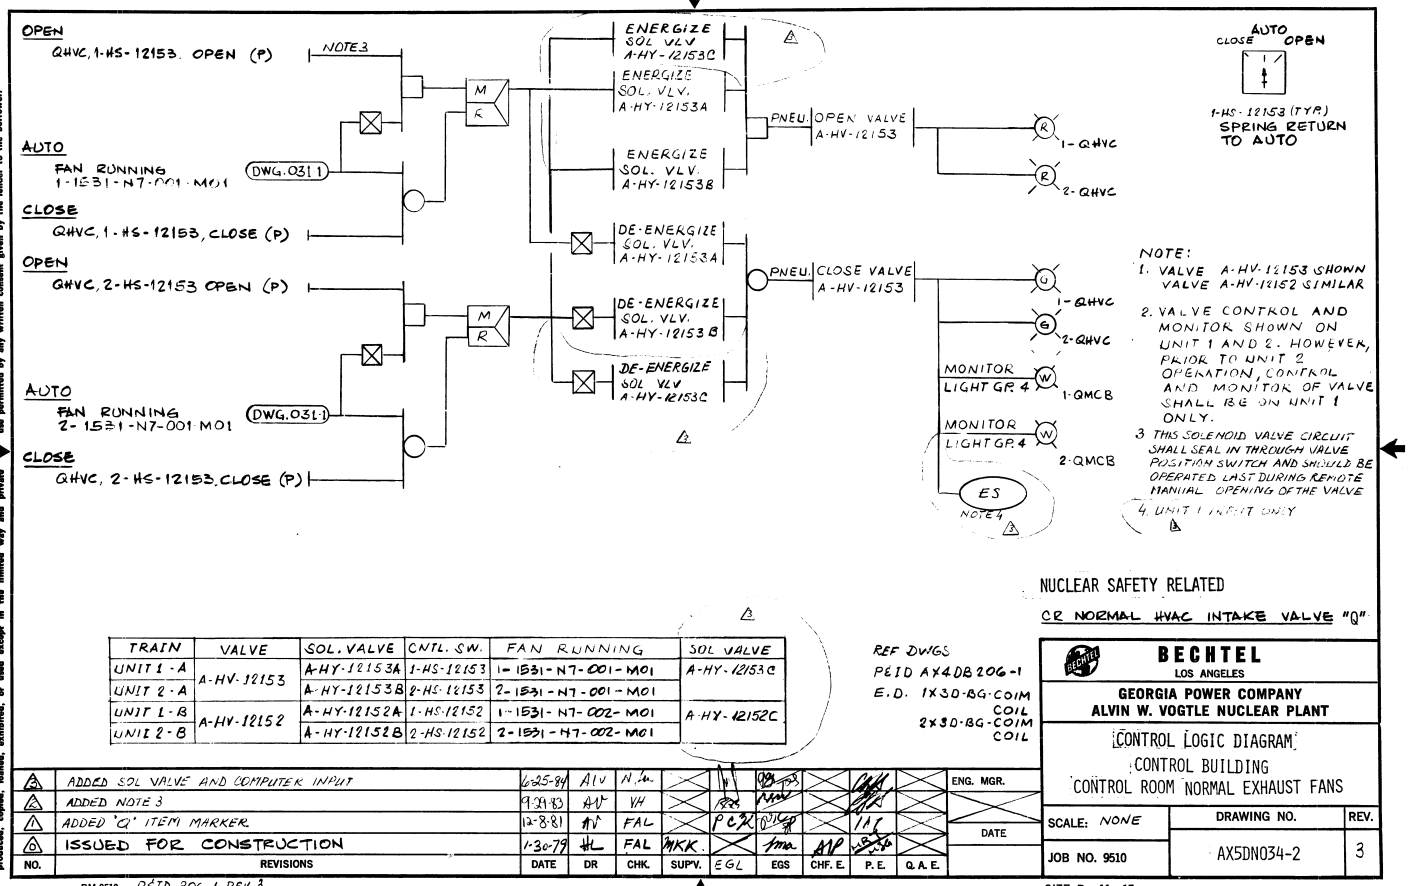

NUCLEAR SAFETY RELATED

CR NORMAL HVAC INTAKE VALVE "Q"

TRAIN	VALVE	SOL. VALVE	CNTL. SW.	FAN RUNNING	SOL VALVE
UNIT 1-A	A-HV-12153	A-HY-12153A	1-HS-12153	1-1531-N7-001-M01	A-HY-12153C
UNIT 2-A		A-HY-12153B	2-HS-12153	2-1531-N7-001-M01	
UNIT 1-B	A-HV-12152	A-HY-12152A	1-HS-12152	1-1531-N7-002-M01	A-HY-12152C
UNIT 2-B		A-HY-12152B	2-HS-12152	2-1531-N7-002-M01	

REF DWGS
P&ID AX4DB206-1
E.D. 1X30-BG-COIM COIL
2X30-BG-COIM COIL

NO.	REVISIONS	DATE	DR	CHK.	SUPV.	EGL	EGS	CHF. E.	P. E.	Q. A. E.
3	ADDED SOL VALVE AND COMPUTER INPUT	6-25-84	AIV	N.L.						
2	ADDED NOTE 3	9-29-83	AV	VH						
1	ADDED 'Q' ITEM MARKER.	12-8-81	AV	FAL		PCK				
0	ISSUED FOR CONSTRUCTION	1-30-79	HL	FAL	MKK					

ENG. MGR. / DATE

BECHTEL
LOS ANGELES

GEORGIA POWER COMPANY
ALVIN W. VOGTLE NUCLEAR PLANT

CONTROL LOGIC DIAGRAM
CONTROL BUILDING
CONTROL ROOM NORMAL EXHAUST FANS

SCALE: NONE	DRAWING NO.	REV.
JOB NO. 9510	AX5DN034-2	3

SIZE B 11 x 17

BM 9510 P&ID 206-1 REV. 3

This drawing and the design it covers are the property of BECHTEL. They are merely loaned and on the borrower's express agreement that they will not be reproduced, copied, loaned, exhibited, or used except in the limited way and private use permitted by any written consent given by the lender to the borrower.

I CERTIFY THAT THE IMAGE CONTAINED ON THIS FRAME WAS MADE IN THE NORMAL AND REGULAR COURSE OF BUSINESS, ON THE DATE STATED BELOW AND THAT IT IS AN ACCURATE REPRODUCTION OF THE DOCUMENT SUBMITTED TO MICROGRAPHICS.
DATE: 6-26-1 CAMERA OPERATOR SECTION SUPERVISOR

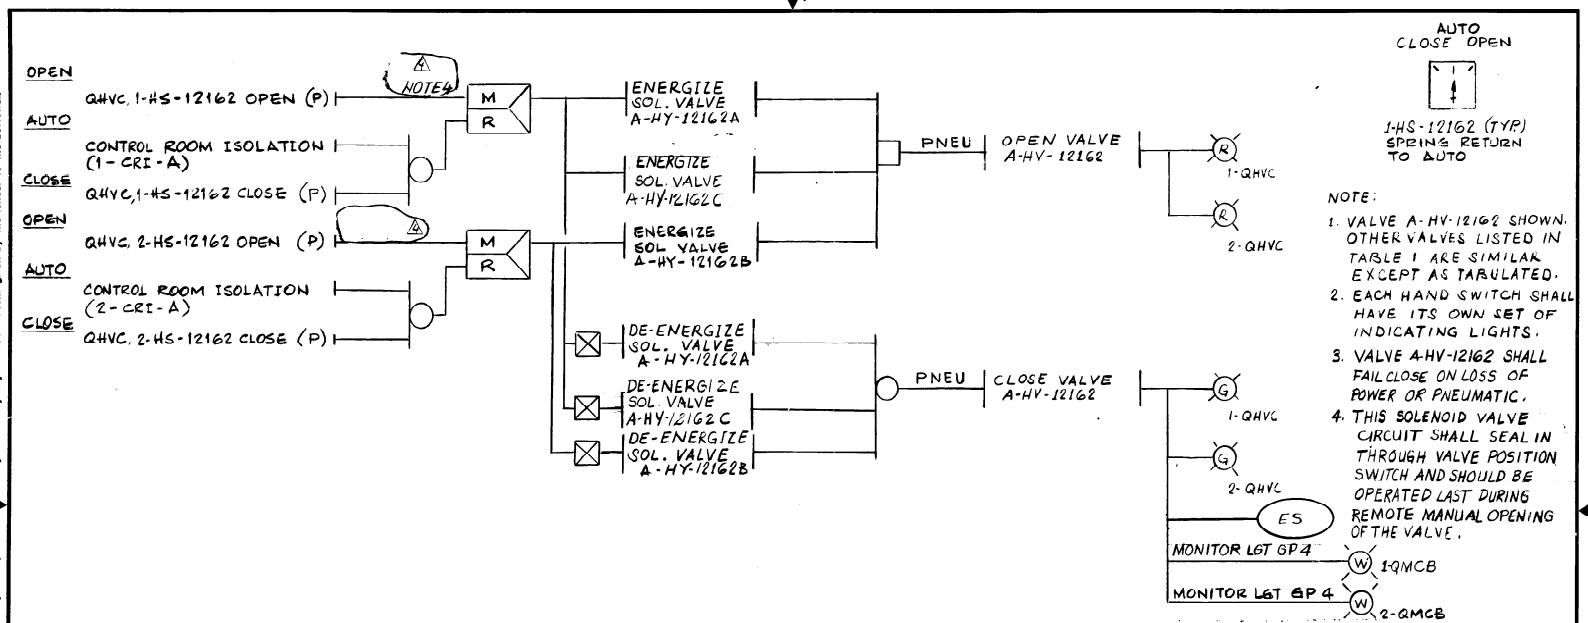

TABLE 1

TRAIN	VALVE	SOL. VLV.	CNTL. SW.	SAFETY SIG.	SOL. VLV
UNIT-1-A	A-HV-12162	A-HY-12162A	1-HS-12162	1-CRI-A	A-HY-12162C
UNIT-2-A		A-HY-12162B	2-HS-12162	2-CRI-A	—
UNIT-1-B	A-HV-12163	A-HY-12163A	1-HS-12163	1-CRI-B	A-HY-12163C (3)
UNIT-2-B		A-HY-12163B	2-HS-12163	2-CRI-B	—

REF. DWGS.
P&ID AX4DR 206-2
E.D. 1X3D-BG-C012 COIR
2X3D-BG-C012 COIR

NO.	REVISIONS	DATE	DR	CHK.	SUPV.	EGL	EGS	CHF. E.	P.E.	Q.A.E.	
3	ADDED COMP INPUT PER P&ID REV	7-18-84	ALV	WJM							ENG. MGR.
2	ADDED ANOTHER SOL. VLV. TO MEET VALVE CLOSURE TIME, PER P&ID	6-13-83	ARS	FAL							
1	REVISED AS INDICATED	1-7-85	ALV	WJM							DATE
0	ISSUED FOR CONSTRUCTION	1-4-79	HL	FAL	MKK	EGL	EGS	CHF. E.	P.E.	Q.A.E.	

P&ID - REV. 4

BECHTEL
LOS ANGELES
GEORGIA POWER COMPANY
ALVIN W. VOGTLE NUCLEAR PLANT
CONTROL LOGIC DIAGRAM
CONTROL BUILDING CONTROL ROOM
KITCHEN EXHAUST FAN INLET DAMPERS

SCALE: NONE	DRAWING NO.	REV.
JOB NO. 9510	AX5DN037-1	4

SIZE B 11 x 17

This drawing and the design it covers are the property of BECHTEL. They are not to be reproduced, copied, loaned, exhibited, or used except in the limited way and private use permitted by any written consent given by the lender to the borrower.

I CERTIFY THAT THE IMAGE CONTAINED ON THIS FRAME WAS MADE IN THE NORMAL AND REGULAR COURSE OF BUSINESS, ON THE DATE STATED BELOW AND THAT IT IS AN ACCURATE REPRODUCTION OF THE DOCUMENT SUBMITTED TO MICROGRAPHICS.
1-7-85 D. Collins D. L. Hesson
DATE: CAMERA OPERATOR SECTION SUPERVISOR

14.5X

I CERTIFY THAT THE IMAGE CONTAINED ON THIS FRAME WAS MADE IN THE NORMAL AND REGULAR COURSE OF BUSINESS, ON THE DATE STATED BELOW AND THAT IT IS AN ACCURATE REPRODUCTION OF THE DOCUMENT SUBMITTED TO MICROGRAPHICS.
1-7-85 D. Collins D. L. Hesson
DATE: CAMERA OPERATOR SECTION SUPERVISOR

This drawing and the design it covers are the property of BECHTEL. They are merely loaned and on the borrower's express agreement that they will not be reproduced, copied, loaned, exhibited, or used except in the limited way and private use permitted by any written consent given by the lender to the borrower.

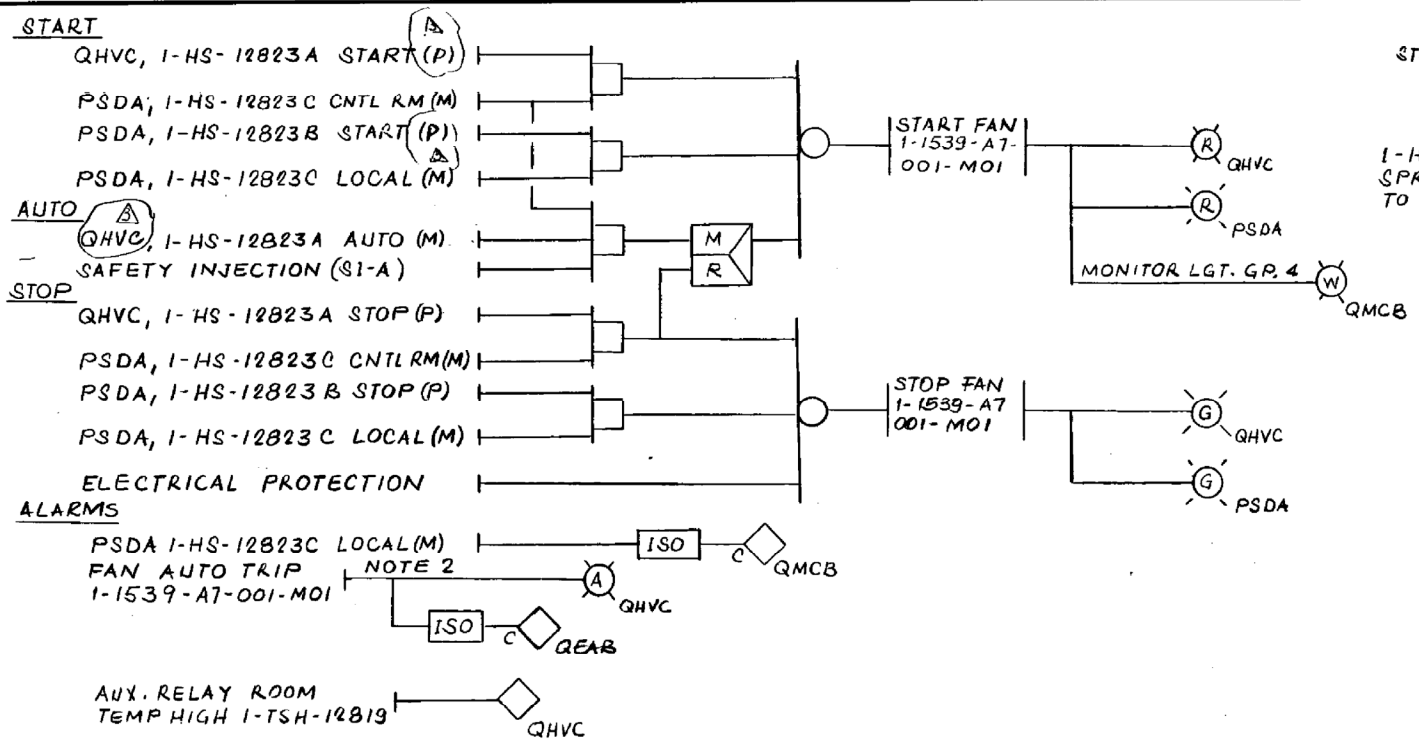

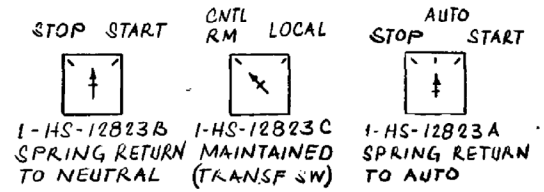

NOTE:

1. FAN 1-1539-A7-001-M01 SHOWN. OTHER FANS LISTED IN TABLE I SIMILAR AS TABULATED.
2. TYPICAL AUTO TRIP LOGIC FUNCTION SHOWN ON DWG. 1X5DN002-3
3. 480V MOTOR STARTER

REF. DWGS.
P&ID AX4DB216, 225
E.D. 1X3D-BG-C07M,N
2X3D-BG-C07M,N

TABLE 1

TRAIN	FAN NO.	HAND SW.	SFTY SIG	TEMP. SW
A	1-1539-A7-001-M01	1-HS-12823A, B & C	S1-A	1-TSH-12819
A	2- -001	2 12823	-A	2 12819
B	1- -002	1 12918	-B	1 12916
B	2- -002	2 12918	-B	2 12916

NUCLEAR SAFETY RELATED "Q"

AUXILIARY RELAY ROOM FAN

BECHTEL
LOS ANGELES

GEORGIA POWER COMPANY
ALVIN W. VOGTLE NUCLEAR PLANT

CONTROL LOGIC DIAGRAM
CONTROL BUILDING
CABLE SPREADING ROOM HVAC

NO.	REVISIONS	DATE	DR	CHK.	SUPV.	EGL	EGS	CHF. E.	P. E.	Q. A. E.	ENG. MGR.
3	CORRECTED SWITCH LOCATION	6-25-84	AHV								
2	REVISED AS INDICATED (COLD SHUTDOWN REQMT)	3/12/81	FAL								DATE
1	REVISED AS INDICATED	2/13/80	HL	FAL							
0	ISSUED FOR CONSTRUCTION	3/7/79	NED	FAL	MKK.						

SCALE: NONE | DRAWING NO. AX5DN056-2 | REV. 3
JOB NO. 9510

BM 9510

SIZE B 11 x 17

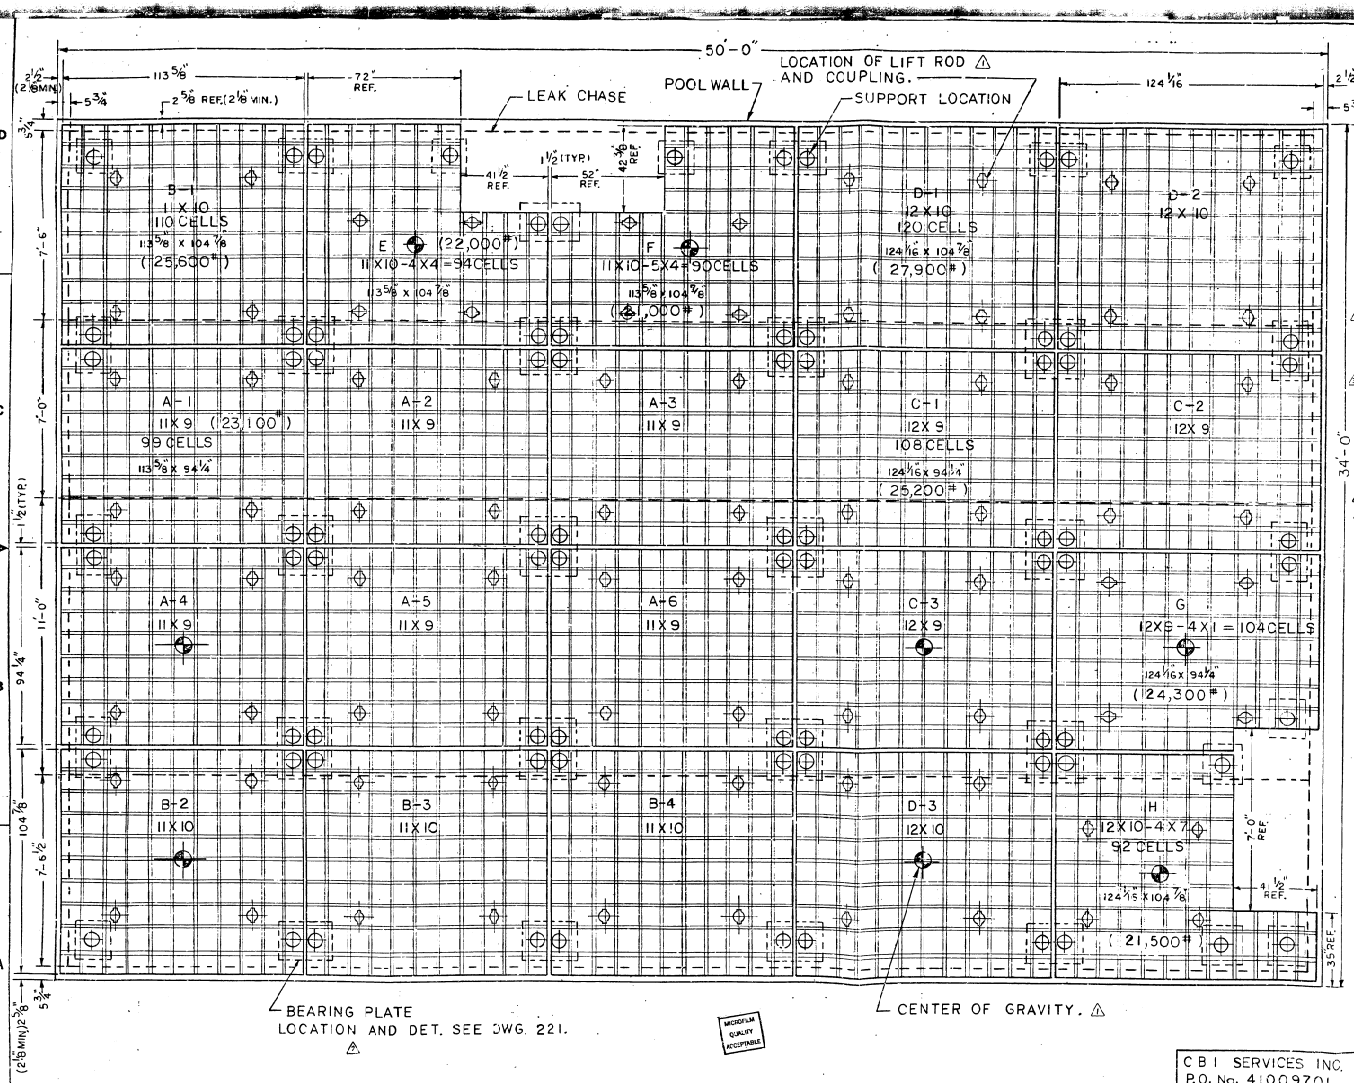

PITCH:
10.58" (N-S DIRECTION)
10.40" (E-W DIRECTION)

TOTAL 20 RACKS 2,098 CELLS.

NOTES:
⚠ 1) DWG. SHOWN IS MAX. DIMENSION OF RACK BASE PLATE SIZE.
2) MINIMUM PERIPHERY TO POOL WALL GAP IS 2 1/8".
⚠ 3) RACK BOUNDARY BOX'S WALL DIMENSION (MAX.) IS BASE PLATE SIZE MINUS 1/4".
4) SOME LIFT BOSSES LOCATED AT ⚠ THE EDGE OF RACK SHALL BE ⚠ TRIMMED FLUSH TO THE EDGE OF BASE PLATE.
⚠ 5) 1 1/2 MIN. GAP BETWEEN RACKS AT ⚠ THE BOUNDARY LEAD-IN TOP ⚠ STRIPS (AS SHOWN).

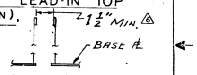

DATE	REV. NO.	DESCRIPTION	PREPARED	CHECKED	ENG	QA
3-1-89	6	REVD NOTE NO.5	T.C. 3-1-89			
1-4-89	5	REVD NOTE 5 TO ALLOW FOR 2" INCREMENTS	T.C. 1-4-89			
4-4-88	4	ADDED NOTE 5	T.CHAN 4-4-88	H.C 4/4-88		
1-11-88	3	REVD MISC. WEIGHT ETC.	T.CHAN 1-11-88	H.C 1/11-88		
12-11-87	2	RELOCATED SOME & ADDED MORE OPENINGS	T.CHAN 12-11-87	H.C 12/11/87		
12-1-87	1	ADDED ELEVS. LOCATIONS C.G. ETC.	T.CHAN 12-1-87	H.C. 12-1-87		
11-16-87	0	ISSUE FOR APPROVAL	T.CHAN 11-13-87	H.C.		

HOLTEC INTERNATIONAL
MOUNT LAUREL, N. J. 08054

EQUIPMENT DESIGN
ANALYSIS
CONSULTING

DESCRIPTION:
POOL LAYOUT
SPENT FUEL RACKS VOGTLE WEST POOL

CLIENT:
GEORGIA POWER Co.
C B I SERVICES INC.

COMPANION DRAWINGS: 201 ~ 210
221.

C B I SERVICES INC.
P.O. No. 41009701

PROJECT No. 70810
P.O. No. E-53598
DRAWING No. 201
REV. 6

VOGTLE ELECTRIC GENERATING PLANT
JOB NO. 9010
EQUIPMENT TAG NO.
STARTUP DESIGNATION NO.
ACTIVITY NO.
SYSTEM NO.
CATEGORY NO.
RETROFITTING REQUIRED ☐ YES ☐ NO

DISTRIBUTION TO: FOR REVIEW	INFO
• MECHANICAL	
• HVAC	
• EQUIPMENT	
• PROCESS	
• CONTROL SYSTEMS	
• ELECTRICAL	
WIRING	
CONDUIT	
• HAZARDS	
• CIVIL/STRUCTURAL	
• NUCLEAR	
• STRESS/PLANT DESIGN	
CODES AND STANDARDS	
• ARCHITECTURAL	
• STARTUP	
• CONSTRUCTION	
• NOT RECD BY ENGRG	
• CLIENT	
• EQUIP. QUALIFICATION	
• M & O'S	
• WESTINGHOUSE	

IDENTIFYING TITLE OF THIS DOCUMENT:

Receipt Log No. HXA-NOA-1C-8

IMPORTANT:
Permission to proceed does not constitute acceptance or approval of design details, calculations, analyses, test methods or materials developed or selected by the supplier and does not relieve supplier from full compliance with contractual obligations.

DATE RECEIVED 3-14-8 | QUALITY A1/2

DOCUMENT STATUS
☐ NO EXCEPTIONS TAKEN
☐ AS NOTED AND RESUBMIT WITH CORRECTIONS. RESUBMIT TO INCORPORATE CORRECTIONS INDICATED
SCHEDULE AND RESUBMIT NUMBER OF COPIES REQUIRED
☐ REVISE AND RESUBMIT
☐ REJECTED - SEE REMARKS
NOT APPROVED
CONFORMATION ONLY
DISTRIBUTION REQ'D Orig.
WITHDRAWN — NOT ACCEPTED FOR EXECUTION. WORK MAY PROCEED

DATE 3-14-8 | BY

MICROFILM QUALITY ACCEPTABLE

VEGP 3 & 4 EPC
CONTRACTOR
CONTROLLED AREA
EXCLUDES:
* CEMETERY
* LANDFILL
* WELL MU2A

- (A) UNIT 1 PLANT VENT
- (B) UNIT 2 PLANT VENT
- (C) UNIT 1 AIR EJECTOR AND STEAM EXHAUSTER VENT
- (D) UNIT 2 AIR EJECTOR AND STEAM EXHAUSTER VENT
- (F) LIQUID RADWASTE DISCHARGE

MALLARD POND

SAVANNAH RIVER

WILSON 230KV LINE

FUTURE 230 KV

GOSHEN WHITE AUGUSTA NEWSPRINT 230 KV

S.C.E.G. 230 KV

FUTURE 230KV

FUTURE 230KV

WILSON 230KV

AUTO BANK #2 CONNECTION

AUTO BANK #1 CONNECTION

PLANT PROTECTED AREA

OWNER CONTROLLED AREA

UNIT 2 HYPER BOLIC COOLING TOWER

UNIT 1 HYPERBOLIC COOLING TOWER

DERAILER

DERAILER

N 87+91.16

N 86+87.24

E 115+00

UNITS 1 AND 2

NEW UNITS 3 AND 4

N. 76+00

N. 110+00

N. 100+00

N. 90+00

N. 80+00

N. 70+00

E. 60+00

E. 70+00

E. 80+00

E. 90+00

E. 100+00

E. 110+00

E. 120+00

VISITOR'S CENTER AREA

OLD RIVER ROAD

CM-2

GRAPHIC SCALE
200 0 200 400
FEET

INDEX NO DESCRIPTION

1	CONTAINMENT BUILDING
1A	EQUIPMENT BUILDING
2	TURBINE BUILDING
3	CONTROL BUILDING
3A	FUEL HANDLING BUILDING
4	AUXILIARY BUILDING
5	NUCLEAR SERVICE COOLING WATER TOWER
6	CIRCULATING WATER INTAKE STRUCTURE
7	CHEMICAL STORAGE AREA PAD
8	WATER TREATMENT BULDING
9	FIRE PROTECTION FACILITIES
10	LUBE OIL STORAGE TANKS
11	CONDENSATE STORAGE TANK
12	AUXILIARY FEEDWATER PUMP HOUSE
13	SERVICE BUILDING
14	AUXILIARY TRANSFORMER PADS
15	MAIN TRANSFORMER PADS
16	DIESEL FUEL STORAGE TANK & PUMP HOUSE
17	REACTOR MAKEUP WATER STORAGE TANK
18	REFUELING WATER STORAGE TANK
19	SNUBBER TEST AND MSIV/MPIV CLEANING FACILITY
20	NITROGEN GAS STORAGE AREA OXYGEN GAS STORAGE AREA
20A	HYDROGEN GAS STORAGE AREA
21	PERMANENT EMPLOYEE PARKING AREA
22	PRODUCTION WAREHOUSE
23	RIVER INTAKE STRUCTURE
24	BARGE UNLOADING FACILITY
25	BOAT RAMP
26	RIVER MAKEUP WATER PIPING
27	WASTE WATER EFFLUENT
28	RIVER INTAKE STRUCTURE CHLORINE STORAGE SWITCHGEAR AREA
29	WASTE WATER RETENTION BASIN
30	PLANT ENTRY AND SECURITY BUILDING
31	PLANT MAKUP WELL
32	ADMINISTRATION BUILDING
33	DIESEL GENERATOR BUILDING
34	CIRCULATING WATER PIPING
35	NSCW STANDBY MAKEUP WELL
36	CIRCULATING WATER CANALS
37	SECURITY FENCING AND GATES
38	SEWAGE TREATMENT PLANT
39	CONSTRUCTION SILT AND DEBRIS SETTLING BASINS
40	ROADS A - MAIN ACCESS ROAD TO THE PLANT B - SERVICE ROAD C - PLANT ROADS (WITHIN PLANT FENCES)
41	RAILROADS
42	PERMANENT POTABLE WATER CLORINATION FACILITY
43	MAKE-UP WELL WATER STORAGE TANK
44	MAKE-UP DEMIN. WASTE NEUTRALIZER SUMPS
45	DEMIN WATER STORAGE TANK
46	MAINTENANCE BUILDING
47	START UP FLUSH PONDS
48	TRANSFER BUILDING ("RETIRED IN PLACE")
49	RADWASTE BUILDING ("RETIRED IN PLACE")
50	H.V. SWITCHYARD SWITCH HOUSE
51	LOW VOLTAGE SWITCHYARD OIL COLLECTION SUMP
52	HIGH VOLTAGE SWITCHYARD OIL COLLECTION SUMP
53	CHEMICAL AND ELECTRICAL EQUIPMENT BUILDING
54	BLOWDOWN SUMP
55	DECHLORINATION BUILDING
56	AMMONIA STORAGE TANK
57	HYDRAZINE STORAGE TANK
58	L.V. SWITCHYARD FIRE PROTECTION VALVE HOUSE
59	H.V. SWITCHYARD FIRE PROTECTION VALVE HOUSE
60	FIELD SUPPORT BUILDING
61	NSCW CHEMICAL CONTROL BLDG
62	HELICOPTER PAD
63	WAREHOUSE RECEIVING BLDG
64	
65	HVSY FIRE PROTECTION VH #3
66	HVSY FIRE PROTECTION VH #4
67	FLAGPOLE
68	HIGH VOLTAGE SWITCHYARD FENCE
69	HEALTH PHYSICS BLDG
70	
71	CONTROL MONUMENT
72	
73	ELECTRIC STEAM BOILER BLDG.
74	MAINTENANCE STORAGE FACILITY
75.	ALTERNATE PLANT ENTRY AND SECURITY BUILDING.
76.	OUTAGE MAINTENANCE SHOP
77.	FLUSHING WATER STORAGE TANK
78.	
79.	
80.	
81.	
82.	
83.	
84.	
85.	
86.	
87.	
88.	
89.	VEHICLE FUELING FACILITY
90.	
91.	
92.	
93.	
94.	
95.	
96.	
97.	ASBESTOS DISPOSAL
98.	OUTAGE MAINTENANCE BUILDING
99.	STORAGE BUILDING
100.	STORAGE BUILDING (3.0)
105.	CASK TRANSFER FACILITY (CTF)
106.	ISFSI SMALL PAD

THIS DOCUMENT CONTAINS PROPRIETARY, CONFIDENTIAL, AND/OR TRADE SECRET INFORMATION OF THE SUBSIDIARIES OF THE SOUTHERN COMPANY OR OF THIRD PARTIES. IT IS INTENDED FOR USE ONLY BY EMPLOYEES OF, OR AUTHORIZED CONTRACTORS OF, THE SUBSIDIARIES OF THE SOUTHERN COMPANY. UNAUTHORIZED POSSESSION, USE, DISTRIBUTION, COPYING, DISSEMINATION, OR DISCLOSURE OF ANY PORTION HEREOF IS PROHIBITED.

NO.	VERSIONS	DATE	DR	CHK	APPV
3.0	REVISED PER ABN C100867501C007, VER. 1.0	11/12/13	JLO	ELC	JMR

SOUTHERN COMPANY SERVICES, INC.
BIRMINGHAM, ALABAMA

GEORGIA POWER COMPANY
ALVIN W. VOGTLE NUCLEAR PLANT

SITE EFFLUENT RELEASE POINTS

SCALE: 1"=200'-0" | JOB NO. 10604 | DRAWING NO. AX6DD311 | VER. 3.0

SIZE E 34X44

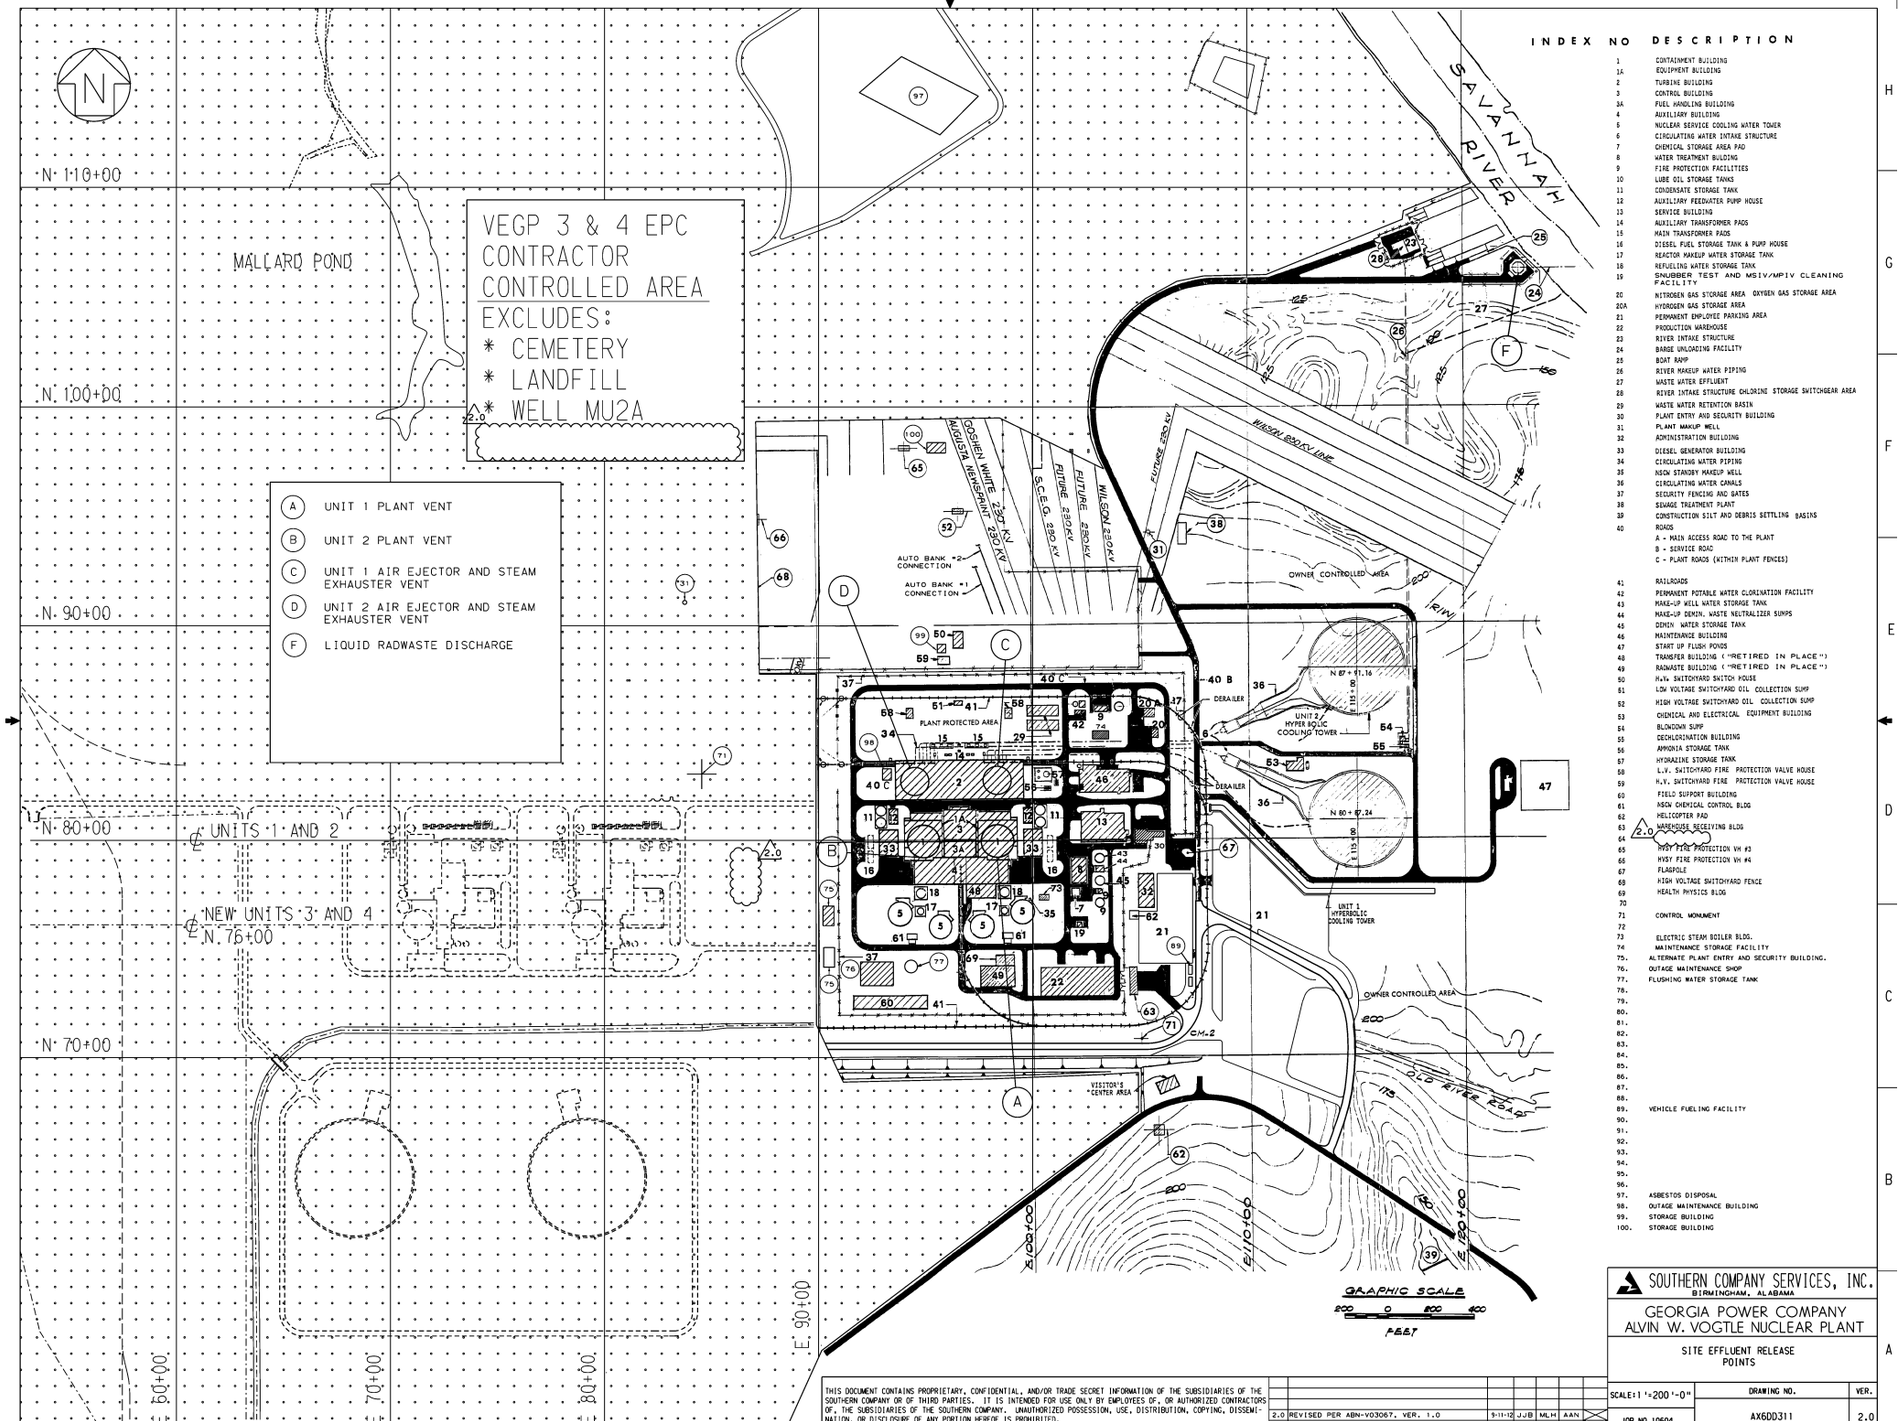

INDEX NO DESCRIPTION

1	CONTAINMENT BUILDING
1A	EQUIPMENT BUILDING
2	TURBINE BUILDING
3	CONTROL BUILDING
3A	FUEL HANDLING BUILDING
4	AUXILIARY BUILDING
5	NUCLEAR SERVICE COOLING WATER TOWER
6	CIRCULATING WATER INTAKE STRUCTURE
7	CHEMICAL STORAGE AREA PAD
8	WATER TREATMENT BUILDING
9	FIRE PROTECTION FACILITIES
10	LUBE OIL STORAGE TANKS
11	CONDENSATE STORAGE TANK
12	AUXILIARY FEEDWATER PUMP HOUSE
13	SERVICE BUILDING
14	AUXILIARY TRANSFORMER PADS
15	MAIN TRANSFORMER PADS
16	DIESEL FUEL STORAGE TANK & PUMP HOUSE
17	REACTOR MAKEUP WATER STORAGE TANK
18	REFUELING WATER STORAGE TANK
19	SNUBBER TEST AND MSIV/MPIV CLEANING FACILITY
20	NITROGEN GAS STORAGE AREA OXYGEN GAS STORAGE AREA
20A	HYDROGEN GAS STORAGE AREA
21	PERMANENT EMPLOYEE PARKING AREA
22	PRODUCTION WAREHOUSE
23	RIVER INTAKE STRUCTURE
24	BARGE UNLOADING FACILITY
25	BOAT RAMP
26	RIVER MAKEUP WATER PIPING
27	WASTE WATER EFFLUENT
28	RIVER INTAKE STRUCTURE CHLORINE STORAGE SWITCHGEAR AREA
29	WASTE WATER RETENTION BASIN
30	PLANT ENTRY AND SECURITY BUILDING
31	PLANT MAKUP WELL
32	ADMINISTRATION BUILDING
33	DIESEL GENERATOR BUILDING
34	CIRCULATING WATER PIPING
35	NSCW STANDBY MAKEUP WELL
36	CIRCULATING WATER CANALS
37	SECURITY FENCING AND GATES
38	SEWAGE TREATMENT PLANT
39	CONSTRUCTION SILT AND DEBRIS SETTLING BASINS
40	ROADS A - MAIN ACCESS ROAD TO THE PLANT B - SERVICE ROAD C - PLANT ROADS (WITHIN PLANT FENCES)
41	RAILROADS
42	PERMANENT POTABLE WATER CHLORINATION FACILITY
43	MAKE-UP WELL WATER STORAGE TANK
44	MAKE-UP DEMIN. WASTE NEUTRALIZER SUMPS
45	DEMIN WATER STORAGE TANK
46	MAINTENANCE BUILDING
47	START UP FLUSH MANIFOLD
48	TRANSFER BUILDING (*RETIRED IN PLACE*)
49	RADWASTE BUILDING (*RETIRED IN PLACE*)
50	H.V. SWITCHYARD SWITCH HOUSE
51	LOW VOLTAGE SWITCHYARD OIL COLLECTION SUMP
52	HIGH VOLTAGE SWITCHYARD OIL COLLECTION SUMP
53	CHEMICAL AND ELECTRICAL EQUIPMENT BUILDING
54	BLOWDOWN SUMP
55	DECHLORINATION BUILDING
56	AMMONIA STORAGE TANK
57	HYDRAZINE STORAGE TANK
58	L.V. SWITCHYARD FIRE PROTECTION VALVE HOUSE
59	H.V. SWITCHYARD FIRE PROTECTION VALVE HOUSE
60	FIELD SUPPORT BUILDING
61	NSCW CHEMICAL CONTROL BLDG
62	HELICOPTER PAD
63	WAREHOUSE RECEIVING BLDG
64	
65	HYDY FIRE PROTECTION VH #3
66	HYDY FIRE PROTECTION VH #4
67	FLAGPOLE
68	HIGH VOLTAGE SWITCHYARD FENCE
69	HEALTH PHYSICS BLDG
70	
71	CONTROL MONUMENT
72	
73	ELECTRIC STEAM BOILER BLDG.
74	MAINTENANCE STORAGE FACILITY
75.	ALTERNATE PLANT ENTRY AND SECURITY BUILDING.
76.	OUTAGE MAINTENANCE SHOP
77.	FLUSHING WATER STORAGE TANK
78.	
79.	
80.	
81.	
82.	
83.	
84.	
85.	
86.	
87.	
88.	
89.	VEHICLE FUELING FACILITY
90.	
91.	
92.	
93.	
94.	
95.	
96.	
97.	ASBESTOS DISPOSAL
98.	OUTAGE MAINTENANCE BUILDING
99.	STORAGE BUILDING
100.	STORAGE BUILDING

THIS DOCUMENT CONTAINS PROPRIETARY, CONFIDENTIAL, AND/OR TRADE SECRET INFORMATION OF THE SUBSIDIARIES OF THE SOUTHERN COMPANY OR OF THIRD PARTIES. IT IS INTENDED FOR USE ONLY BY EMPLOYEES OF, OR AUTHORIZED CONTRACTORS OF, THE SUBSIDIARIES OF THE SOUTHERN COMPANY. UNAUTHORIZED POSSESSION, USE, DISTRIBUTION, COPYING, DISSEMINATION, OR DISCLOSURE OF ANY PORTION HEREOF IS PROHIBITED.

NO.	VERSIONS	DATE	DR	CHK	APPV
2.0	REVISED PER ABN-V03067, VER. 1.0	9-11-12	JJB	MLH	AAN

SOUTHERN COMPANY SERVICES, INC.
BIRMINGHAM, ALABAMA

GEORGIA POWER COMPANY
ALVIN W. VOGTLE NUCLEAR PLANT

SITE EFFLUENT RELEASE POINTS

SCALE: 1"=200'-0" | JOB NO. 10604 | DRAWING NO. AX6DD311 | VER. 2.0

SIZE E 34X44

CAD NAME AX6DD311

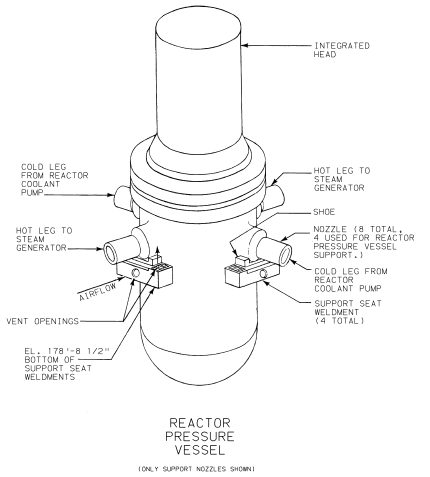

REACTOR PRESSURE VESSEL

(ONLY SUPPORT NOZZLES SHOWN)

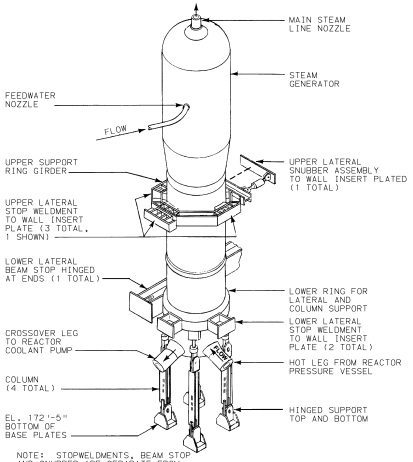

STEAM GENERATOR

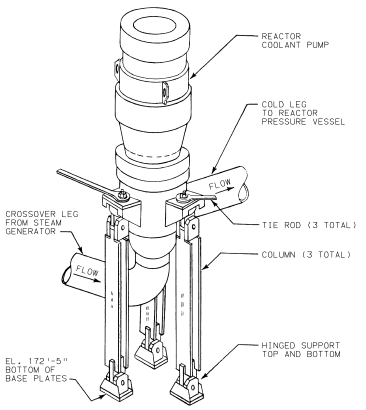

REACTOR COOLANT PUMP

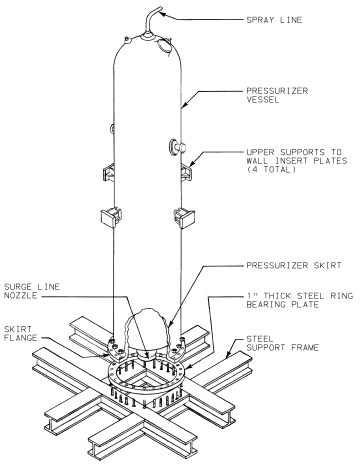

PRESSURIZER

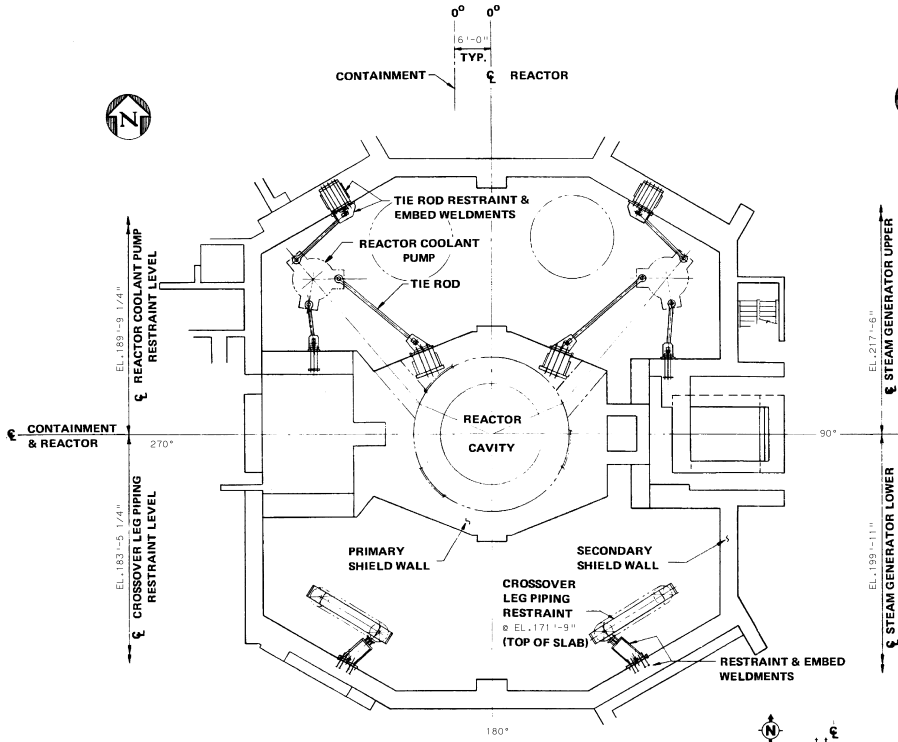

PLAN

REACTOR COOLANT PUMPS AND CROSS OVER LEG PIPING AREA

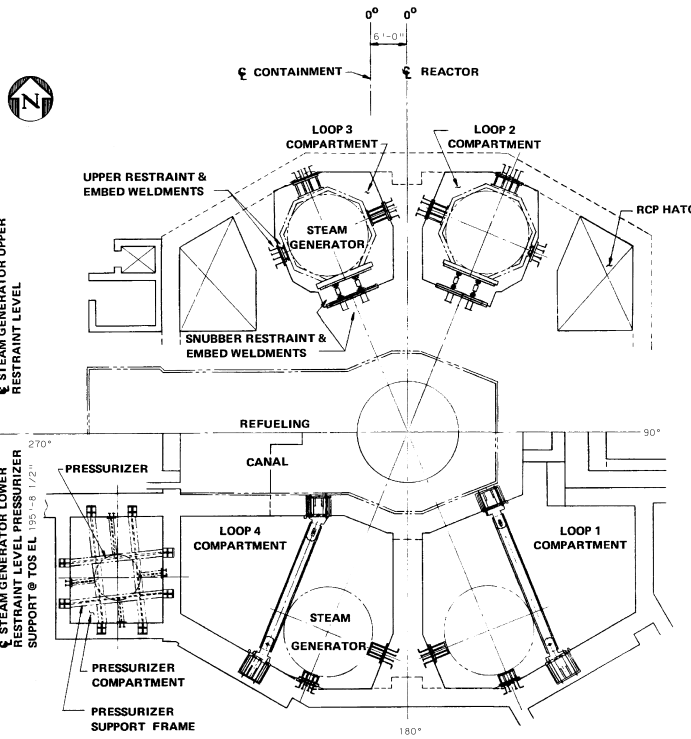

PLAN

STEAM GENERATOR AND PRESSURIZER AREA

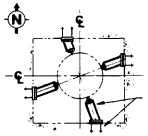

PLAN

℄ PRESSURIZER AREA @ EL 221'-7-7/8"

COMPARTMENTS

LOOP 1 OPPOSITE HAND TO LOOP 2
LOOP 4 OPPOSITE HAND TO LOOP 3

THIS DOCUMENT CONTAINS PROPRIETARY, CONFIDENTIAL, AND/OR TRADE SECRET INFORMATION OF THE SUBSIDIARIES OF THE SOUTHERN COMPANY OR OF THIRD PARTIES. IT IS INTENDED FOR USE ONLY BY EMPLOYEES OF, OR AUTHORIZED CONTRACTORS OF, THE SUBSIDIARIES OF THE SOUTHERN COMPANY. UNAUTHORIZED POSSESSION, USE, DISTRIBUTION, COPYING, DISSEMINATION, OR DISCLOSURE OF ANY PORTION HEREOF IS PROHIBITED.

NO.	REVISIONS	DATE	DR	CHK	APPV	DTL
4	ISSUED PER REA 96-VAA054	7-28-98	MKA	RBH	CBH	WFP

SOUTHERN COMPANY SERVICES, INC.
BIRMINGHAM, ALABAMA

GEORGIA POWER COMPANY
ALVIN W. VOGTLE NUCLEAR PLANT

REACTOR COOLANT SYSTEM
COMPONENT SUPPORTS AND ARRANGEMENT
(UNIT 1)

SCALE: 1/8"=1'-0" | DRAWING NO. AX6DD312 | REV. 0

JOB NO. 10604

SIZE E 34X44

CAD NAME AX6DD312

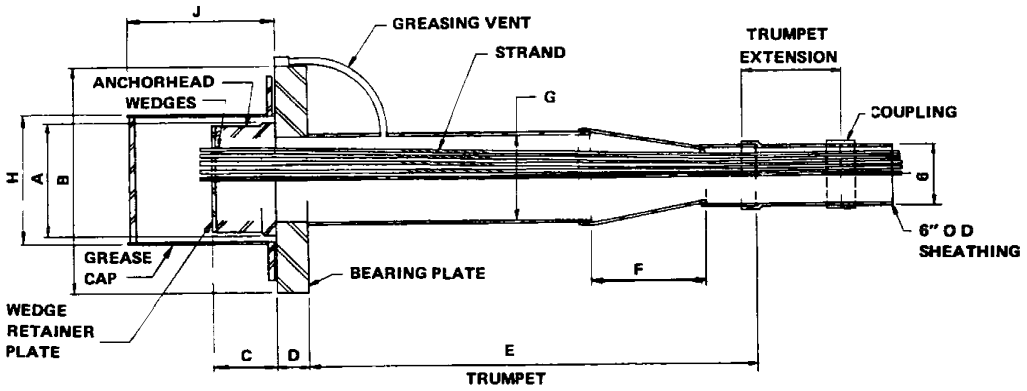

PERMANENT ANCHORAGE ASSEMBLY (UNIT 2) 2.0

TYPE		A	B	C	D	E	F	G	H	J
55 STRAND (VSL)	PERMANENT	12 1/2"	24" SQ.	6"	3 1/2"	45 1/2"	8"	9"	14"	20 ½"

APPROX. STRAND AREA = 0.153 SQ. IN. 2.0

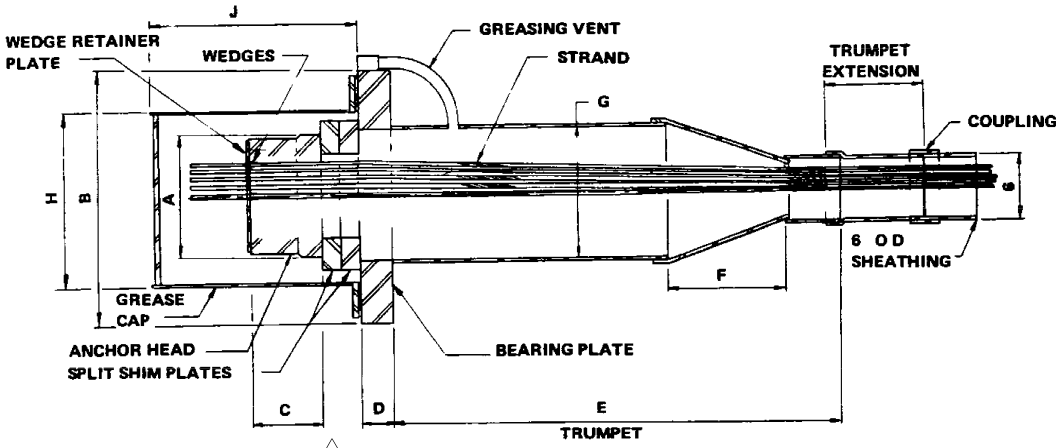

2.0

PERMANENT AND DETENSIONABLE ANCHORAGE ASSEMBLIES (UNIT 1) 2.0

2.0

TYPE	A	B	C	D	E	F	G	H	J	
PERMANENT	12 1/2"	24" SQ.	6"	3 1/2"	45 1/2"	11 1/2"	13"	18"	21 ¾"	
DETENSIONABLE	12 1/2"	24" SQ.	6"	3 1/2"	45 1/2"	11 1/2"	13"	18"	Horizontal	33 3/8"
									Vertical	44 7/8"

THIS DOCUMENT CONTAINS PROPRIETARY, CONFIDENTIAL, AND/OR TRADE SECRET INFORMATION OF THE SUBSIDIARIES OF THE SOUTHERN COMPANY OR OF THIRD PARTIES. IT IS INTENDED FOR USE ONLY BY EMPLOYEES OF, OR AUTHORIZED CONTRACTORS OF, THE SUBSIDIARIES OF THE SOUTHERN COMPANY. UNAUTHORIZED POSSESSION, USE, DISTRIBUTION, COPYING, DISSEMINATION, OR DISCLOSURE OF ANY PORTION HEREOF IS PROHIBITED.

VER.	VERSIONS	DATE	DR	CHK	APPV	DTL
2.0	REVISED PER ABN 80776, VERSION 1.0	6-28-05	ADC	LRP	ASK	

SOUTHERN COMPANY SERVICES, INC.
BIRMINGHAM, ALABAMA

GEORGIA POWER COMPANY
ALVIN W. VOGTLE NUCLEAR PLANT

2.0 ANCHORAGE ASSEMBLY (UNIT 1(& 2 SHOWN)) 2.0

SCALE:

JOB NO.10604

DRAWING NO. AX6DD313

VER. 2.0

SIZE E 34X44

CAD NAME AX6DD313

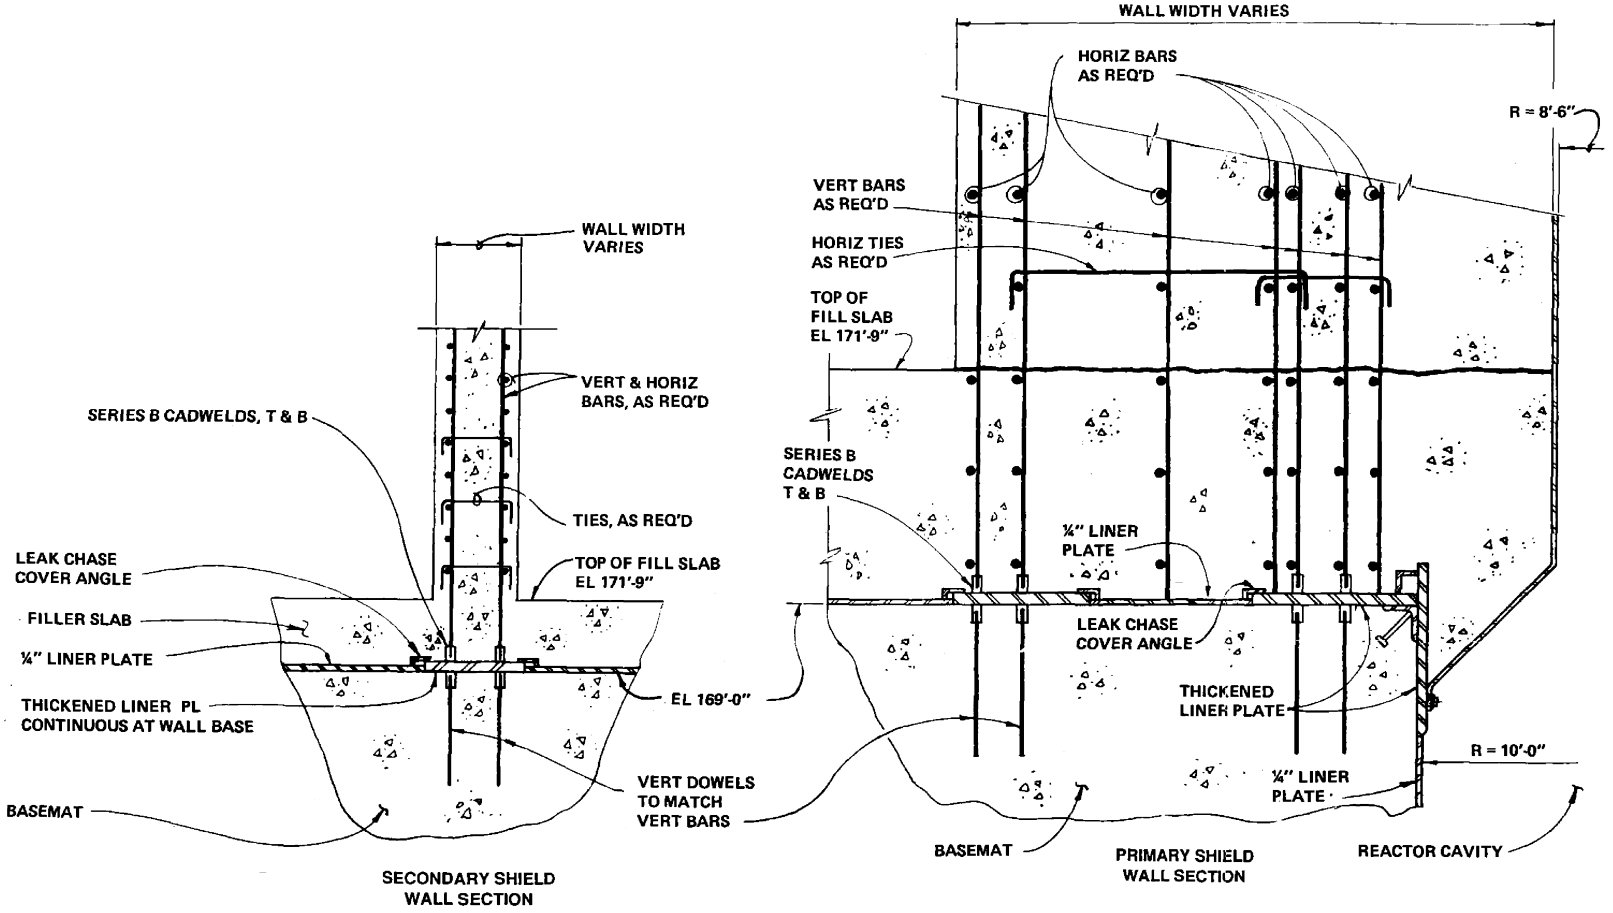

THIS DOCUMENT CONTAINS PROPRIETARY, CONFIDENTIAL, AND/OR TRADE SECRET INFORMATION OF THE SUBSIDIARIES OF THE SOUTHERN COMPANY OR OF THIRD PARTIES. IT IS INTENDED FOR USE ONLY BY EMPLOYEES OF, OR AUTHORIZED CONTRACTORS OF, THE SUBSIDIARIES OF THE SOUTHERN COMPANY. UNAUTHORIZED POSSESSION, USE, DISTRIBUTION, COPYING, DISSEMINATION, OR DISCLOSURE OF ANY PORTION HEREOF IS PROHIBITED.

NO.	REVISIONS	DATE	DR	CHK	APPV	DTL
3	ISSUED PER REA 96-VAA054	7-28-98	MKA	RBH	CBH	WFP

SOUTHERN COMPANY SERVICES, INC.
BIRMINGHAM, ALABAMA

GEORGIA POWER COMPANY
ALVIN W. VOGTLE NUCLEAR PLANT

PRIMARY AND SECONDARY SHIELD WALL ANCHORAGE TO BASEMAT

SCALE:	DRAWING NO.	REV.
JOB NO.10604	AX6DD314	0

SIZE E 34X44

CAD NAME AX6DD314

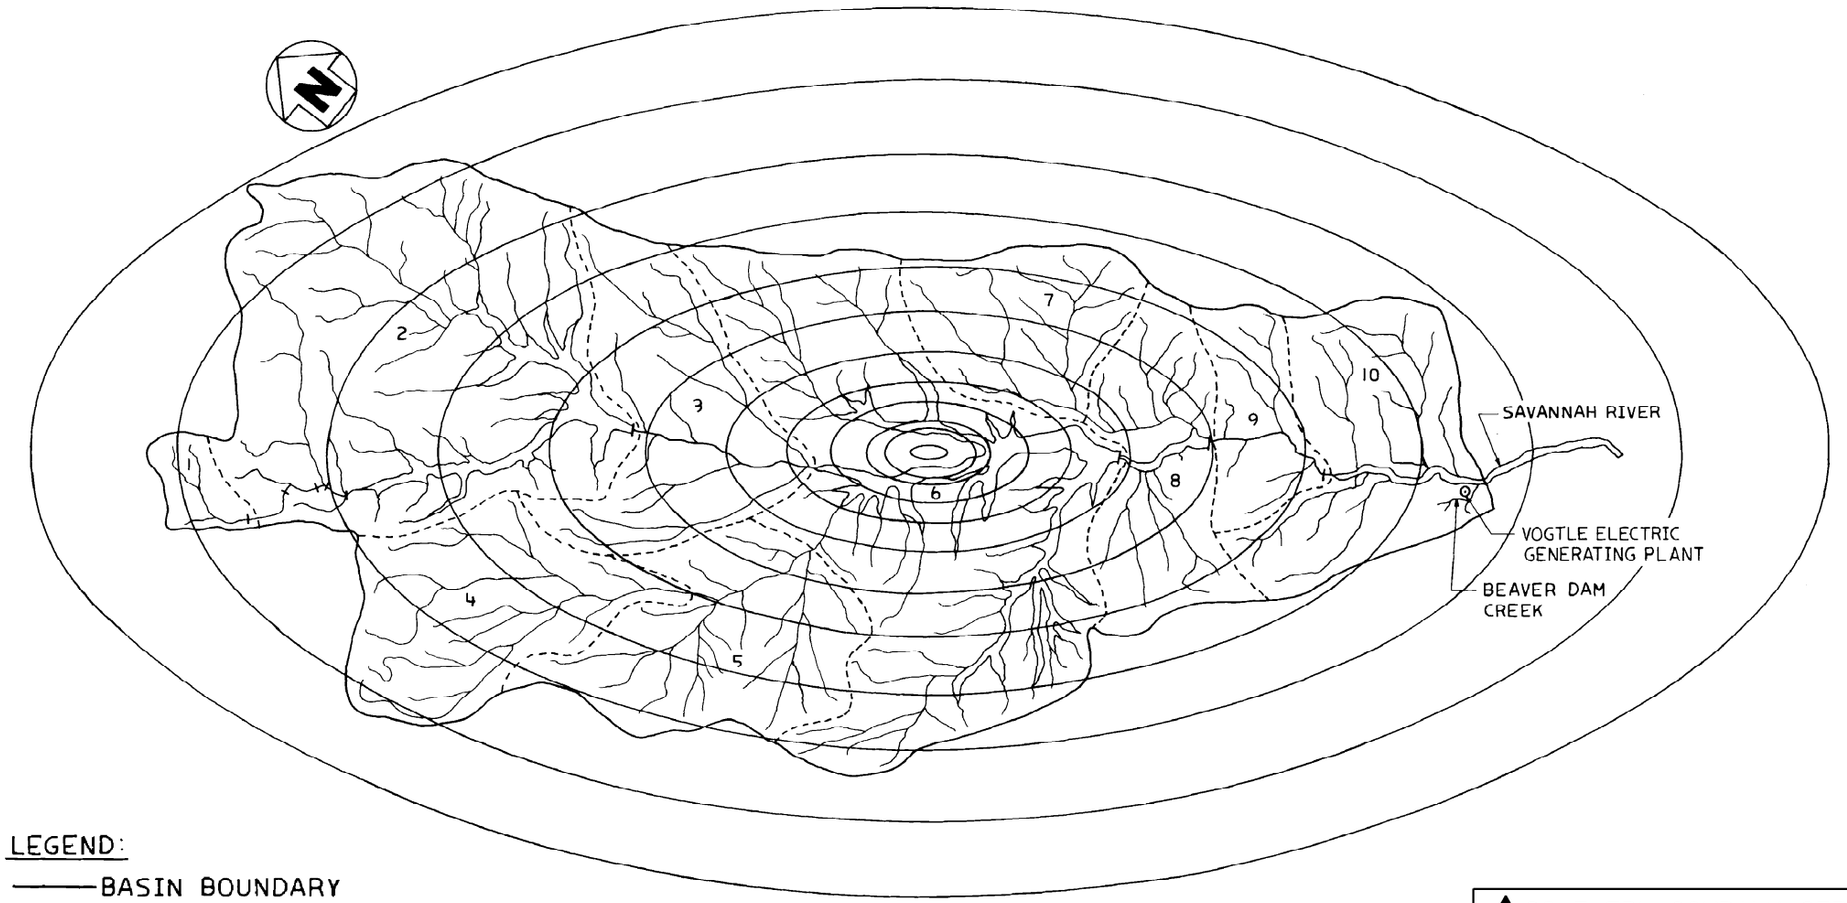

LEGEND:

———BASIN BOUNDARY
-----SUBBASIN BOUNDARY

NOTE:

FOR ISOHYET DEPTHS (in.), SEE UFSAR TABLE 2.4.3-4. THE ISOHYET MAJOR TO MINOR AXIS RATIO IS 2 TO 1.

SAVANNAH RIVER BASIN

10 5 0 10 20 30 40

(SCALE (miles)

SOUTHERN COMPANY SERVICES, INC.
BIRMINGHAM, ALABAMA

GEORGIA POWER COMPANY
ALVIN W. VOGTLE NUCLEAR PLANT

PMP ISOHYETS POSITION 1, HYDROMET 51 SAVANNAH RIVER BASIN ABOVE SITE

NO.	REVISIONS	DATE	DR	CHK	APPV	DTL
△						
0	ISSUED PER REA 96-VAA054	9-30-98	GS	RBH	CBH	WFP

SCALE: NONE

JOB NO. 10604

DRAWING NO. AX6DD315

REV 0

THIS DOCUMENT CONTAINS PROPRIETARY, CONFIDENTIAL, AND/OR TRADE SECRET INFORMATION OF THE SUBSIDIARIES OF THE SOUTHERN COMPANY OR OF THIRD PARTIES. IT IS INTENDED FOR USE ONLY BY EMPLOYEES OF, OR AUTHORIZED CONTRACTORS OF, THE SUBSIDIARIES OF THE SOUTHERN COMPANY. UNAUTHORIZED POSSESSION, USE, DISTRIBUTION, COPYING, DISSEMINATION, OR DISCLOSURE OF ANY PORTION HEREOF IS PROHIBITED.

CAD NAME AX6DD315

SIZE B 11x17

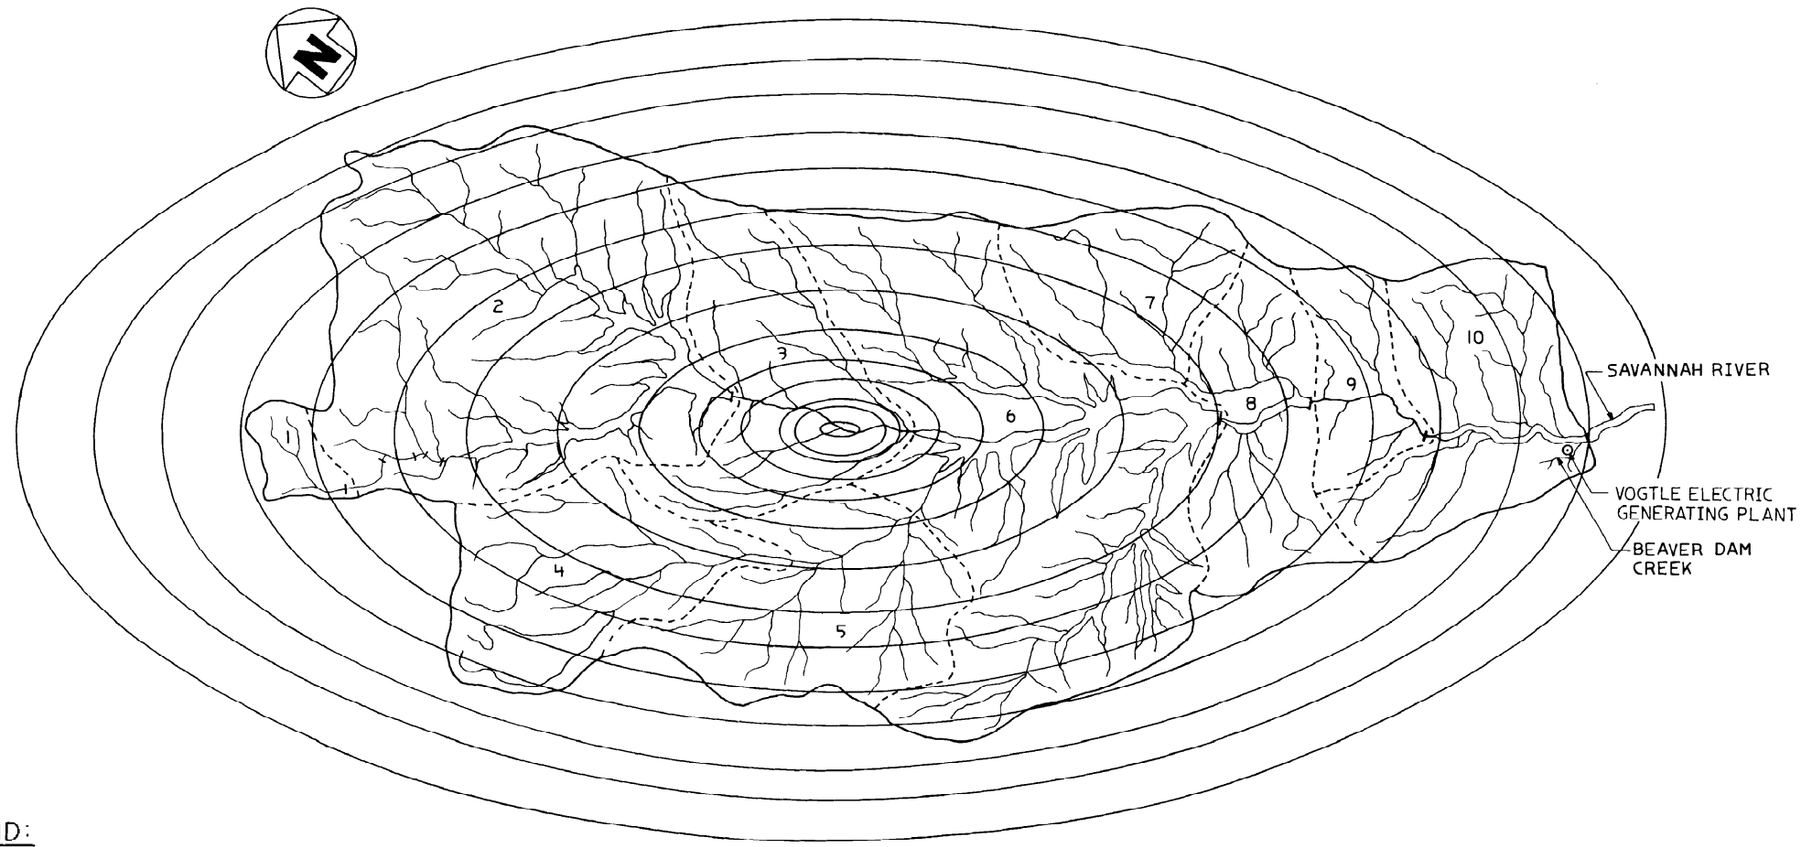

LEGEND:

———BASIN BOUNDARY

-----SUBBASIN BOUNDARY

NOTE:

FOR ISOHYET DEPTHS (in.), SEE UFSAR TABLE 2.4.3-4. THE ISOHYET MAJOR TO MINOR AXIS RATIO IS 2 TO 1.

SAVANNAH RIVER BASIN

10 5 0 10 20 30 40

SCALE (miles)

SOUTHERN COMPANY SERVICES, INC.
BIRMINGHAM, ALABAMA

GEORGIA POWER COMPANY
ALVIN W. VOGTLE NUCLEAR PLANT

PMP ISOHYETS POSITION 2, HYDROMET 51 SAVANNAH RIVER BASIN ABOVE SITE

NO.	REVISIONS	DATE	DR	CHK	APPV	DTL
△						
0	ISSUED PER REA 96-VAA054	9-30-98	GS	RBH	CBH	WFP

SCALE: NONE

DRAWING NO. AX6DD316

REV 0

JOB NO. 10604

THIS DOCUMENT CONTAINS PROPRIETARY, CONFIDENTIAL, AND/OR TRADE SECRET INFORMATION OF THE SUBSIDIARIES OF THE SOUTHERN COMPANY OR OF THIRD PARTIES. IT IS INTENDED FOR USE ONLY BY EMPLOYEES OF, OR AUTHORIZED CONTRACTORS OF, THE SUBSIDIARIES OF THE SOUTHERN COMPANY. UNAUTHORIZED POSSESSION, USE, DISTRIBUTION, COPYING, DISSEMINATION, OR DISCLOSURE OF ANY PORTION HEREOF IS PROHIBITED.

CAD NAME AX6DD316 SIZE B 11x17

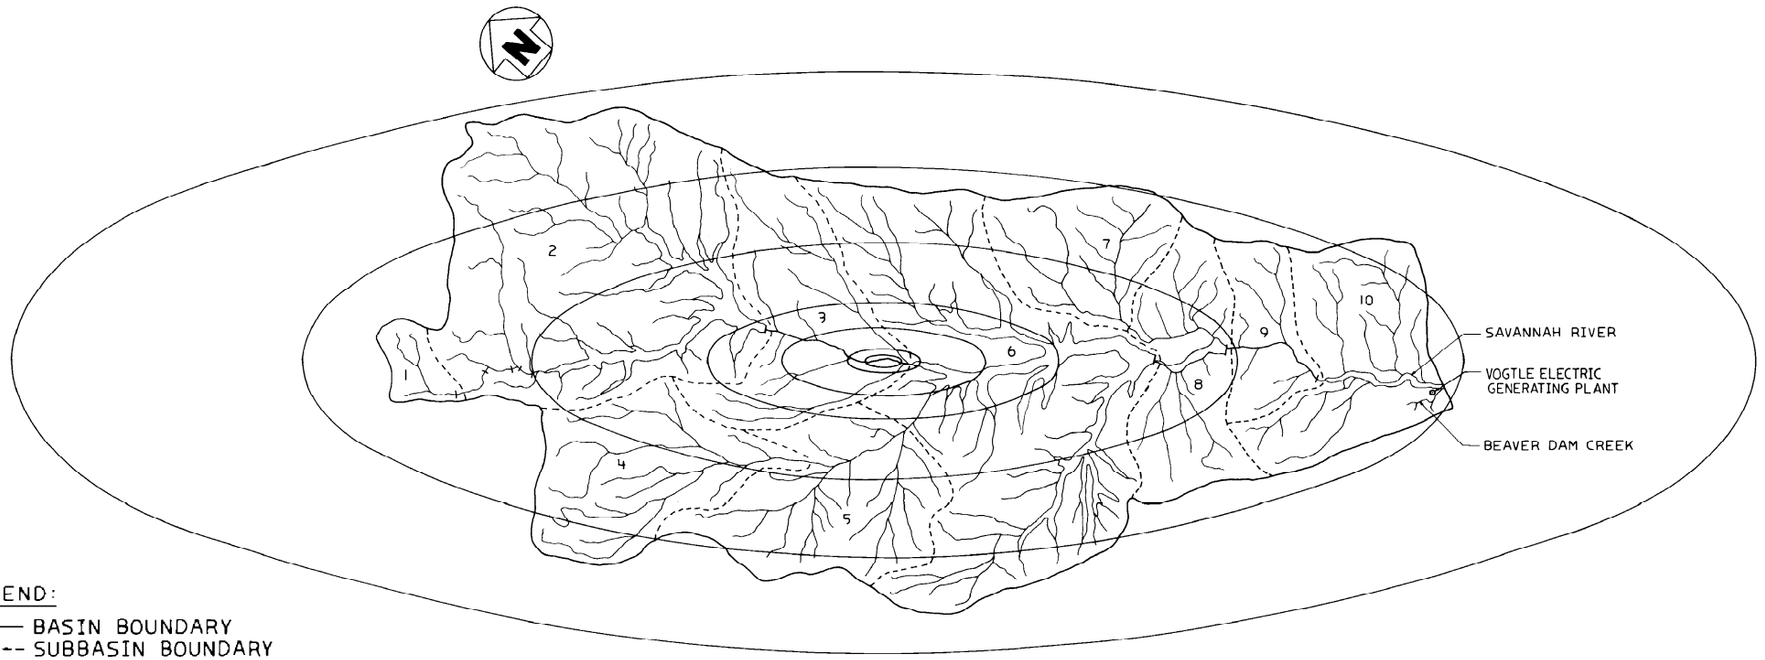

LEGEND:

——— BASIN BOUNDARY
----- SUBBASIN BOUNDARY

NOTE:

FOR ISOHYET DEPTHS (in.), SEE UFSAR TABLE 2.4.3-4. THE ISOHYET MAJOR TO MINOR AXIS RATIO IS 3 TO 1.

SAVANNAH RIVER BASIN

10 5 0 10 20 30 40

SCALE (miles)

SOUTHERN COMPANY SERVICES, INC.
BIRMINGHAM, ALABAMA

GEORGIA POWER COMPANY

ALVIN W. VOGTLE NUCLEAR PLANT

PMP ISOHYETS POSITION 1, HYDROMET 52 SAVANNAH RIVER BASIN ABOVE SITE

NO.	REVISIONS	DATE	DR	CHK	APPV	DTL
△						
0	ISSUED PER REA 96-VAA054	9-30-98	GS	RBH	CBH	WFP

SCALE: NONE

JOB NO. 10604

DRAWING NO. AX6DD317

REV 0

THIS DOCUMENT CONTAINS PROPRIETARY, CONFIDENTIAL, AND/OR TRADE SECRET INFORMATION OF THE SUBSIDIARIES OF THE SOUTHERN COMPANY OR OF THIRD PARTIES. IT IS INTENDED FOR USE ONLY BY EMPLOYEES OF, OR AUTHORIZED CONTRACTORS OF, THE SUBSIDIARIES OF THE SOUTHERN COMPANY. UNAUTHORIZED POSSESSION, USE, DISTRIBUTION, COPYING, DISSEMINATION, OR DISCLOSURE OF ANY PORTION HEREOF IS PROHIBITED.

CAD NAME AX6DD317

SIZE B 11x17

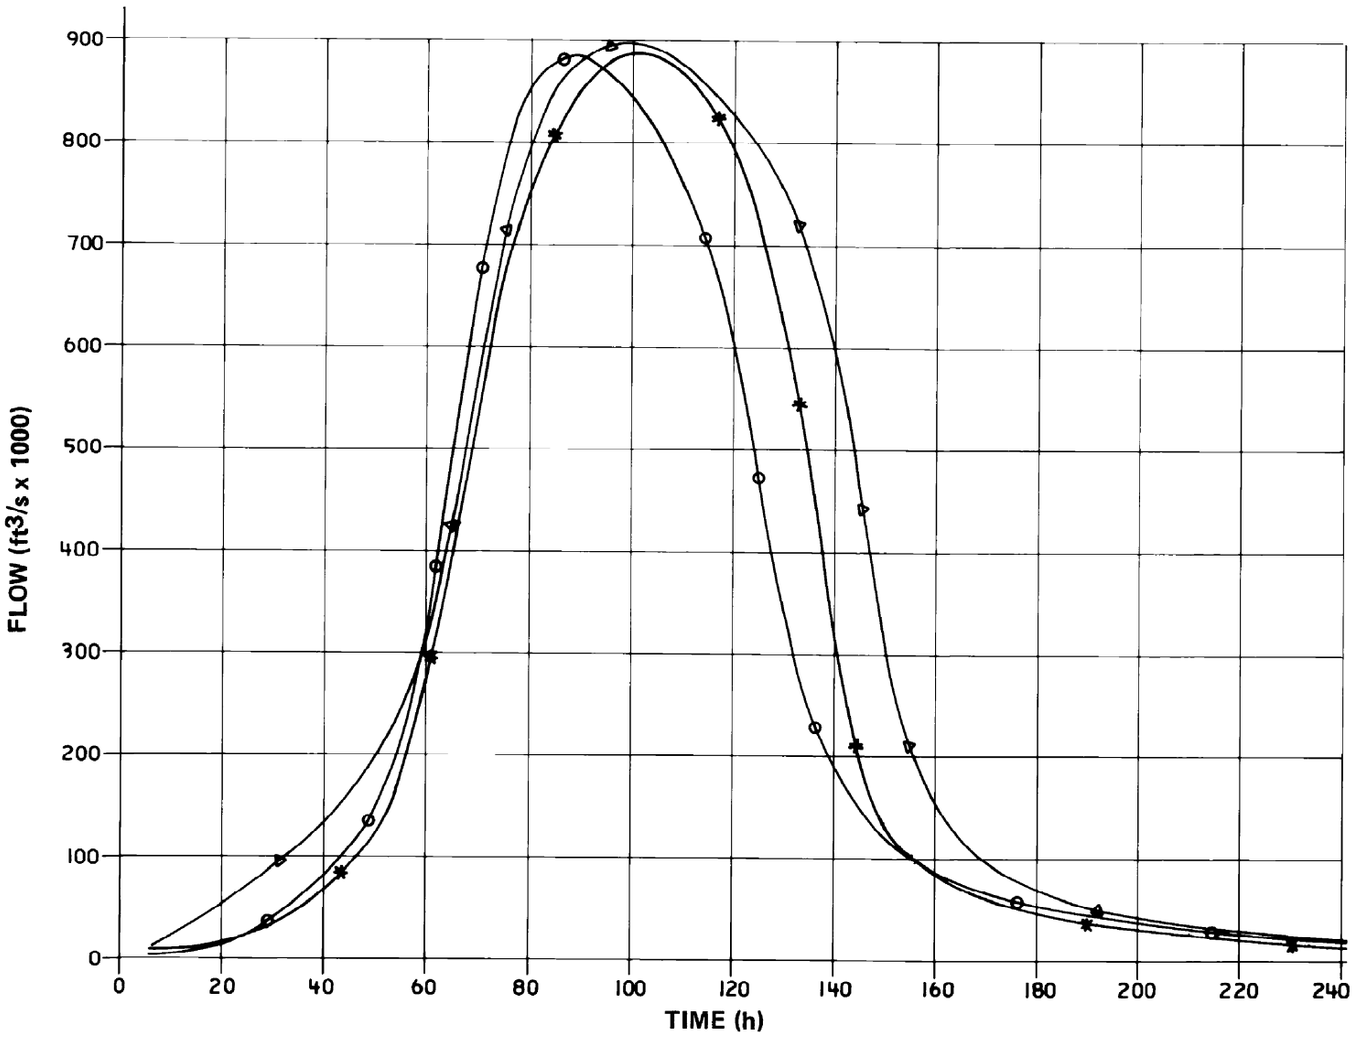

LEGEND:

- HYDROMET 52
- POSITION 1
- POSITION 2

SOUTHERN COMPANY SERVICES, INC.
BIRMINGHAM, ALABAMA

GEORGIA POWER COMPANY
ALVIN W. VOGTLE NUCLEAR PLANT

PROBABLE MAXIMUM FLOOD HYDROGRAPH (VALLEY STORAGE NOT CONSIDERED) AT RIVER MILE 151.1

NO.	REVISIONS	DATE	DR	CHK	APPV	DTL
0	ISSUED PER REA 96-VAA054	9-30-98	GS	RBH	CBH	WFP

SCALE: NONE

JOB NO. 10604

DRAWING NO. AX6DD318

REV 0

THIS DOCUMENT CONTAINS PROPRIETARY, CONFIDENTIAL, AND/OR TRADE SECRET INFORMATION OF THE SUBSIDIARIES OF THE SOUTHERN COMPANY OR OF THIRD PARTIES. IT IS INTENDED FOR USE ONLY BY EMPLOYEES OF, OR AUTHORIZED CONTRACTORS OF, THE SUBSIDIARIES OF THE SOUTHERN COMPANY. UNAUTHORIZED POSSESSION, USE, DISTRIBUTION, COPYING, DISSEMINATION, OR DISCLOSURE OF ANY PORTION HEREOF IS PROHIBITED.

CAD NAME AX6DD318

SIZE B 11x17

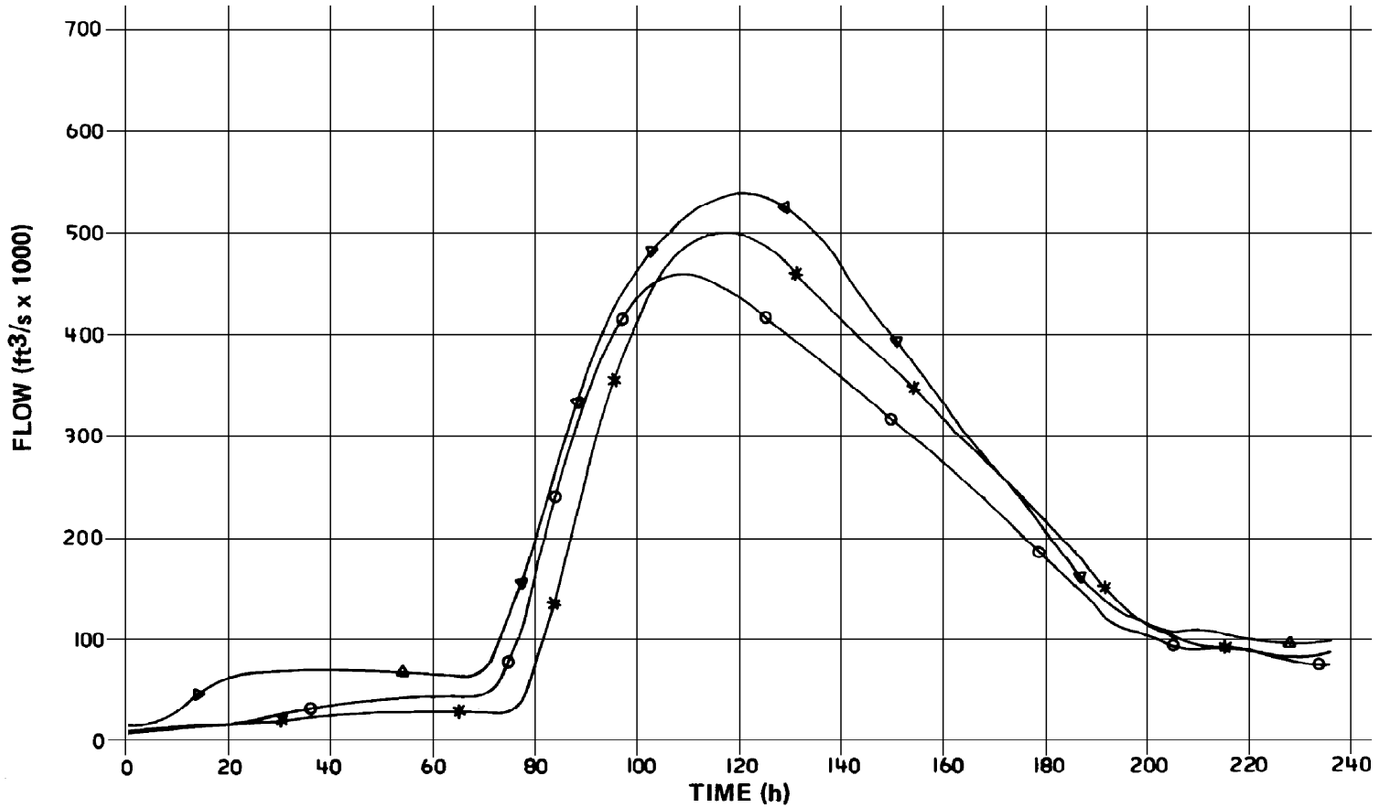

LEGEND:

- HYDROMET 52
- POSITION 1
- POSITION 2

SOUTHERN COMPANY SERVICES, INC.
BIRMINGHAM, ALABAMA

GEORGIA POWER COMPANY
ALVIN W. VOGTLE NUCLEAR PLANT

PROBABLE MAXIMUM FLOOD HYDROGRAPH (VALLEY STORAGE CONSIDERED) AT RIVER MILE 151.1

NO.	REVISIONS	DATE	DR	CHK	APPV	DTL
0	ISSUED PER REA 96-VAA054	9-30-98	GS	RBH	CBH	WFP

SCALE: NONE

JOB NO. 10604

DRAWING NO. AX6DD319

REV 0

THIS DOCUMENT CONTAINS PROPRIETARY, CONFIDENTIAL, AND/OR TRADE SECRET INFORMATION OF THE SUBSIDIARIES OF THE SOUTHERN COMPANY OR OF THIRD PARTIES. IT IS INTENDED FOR USE ONLY BY EMPLOYEES OF, OR AUTHORIZED CONTRACTORS OF, THE SUBSIDIARIES OF THE SOUTHERN COMPANY. UNAUTHORIZED POSSESSION, USE, DISTRIBUTION, COPYING, DISSEMINATION, OR DISCLOSURE OF ANY PORTION HEREOF IS PROHIBITED.

CAD NAME AX6DD319

SIZE B 11x17

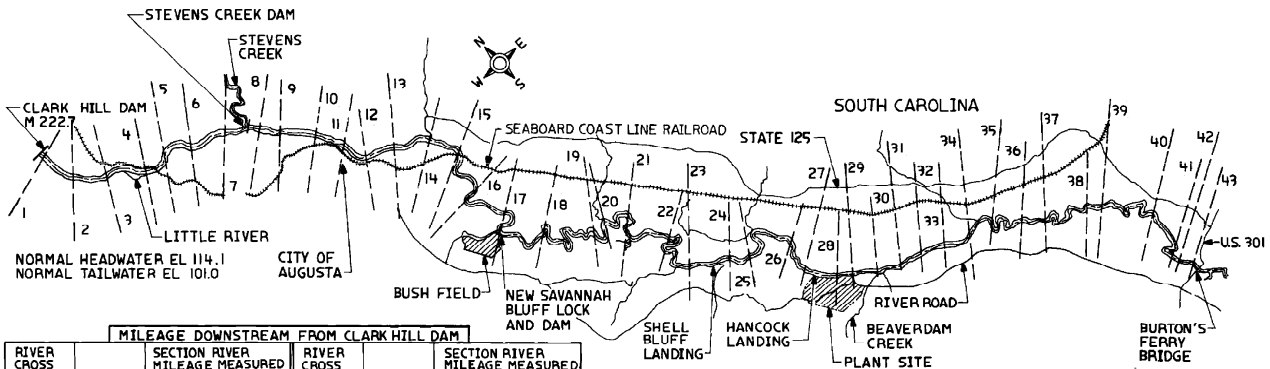

0 1 2 3 4 5 (miles)
GRAPHIC SCALE

NOTE:
APPROXIMATE LOCATION OF RIVER VALLEY CROSS SECTIONS USED IN COMPUTING EFFECT OF DAM FAILURE AT PLANT SITE. UNSTEADY NON-UNIFORM FLOW.

MILEAGE DOWNSTREAM FROM CLARK HILL DAM

RIVER CROSS SECTION NUMBER	RIVER MILEAGE	SECTION RIVER MILEAGE MEASURED FROM CLARK HILL DAM DOWNSTREAM	RIVER CROSS SECTION NUMBER	RIVER MILEAGE	SECTION RIVER MILEAGE MEASURED FROM CLARK HILL DAM DOWNSTREAM
1	222.5	0.0	23	164.8	57.9
2	220.4	2.3	24	162.4	60.3
3	218.4	4.3	25	161.1	61.6
4	216.0	6.7	26	157.0	65.7
5	214.3	8.4	27	154.8	67.9
6	212.4	10.3	28	152.0	70.7
7	210.3	12.4	29	151.1	71.6
8	208.3	14.4	30	149.6	73.1
9	207.1	15.6	31	148.3	74.4
10	205.2	17.5	32	146.0	76.7
11	203.5	19.2	33	144.6	78.1
12	202.0	20.7	34	143.0	79.7
13	200.3	22.4	35	141.1	81.6
14	198.1	24.6	36	137.9	84.8
15	196.2	26.5	37	135.3	87.4
16	193.2	29.5	38	131.2	91.5
17	189.8	32.9	39	129.6	93.1
18	183.9	38.8	40	126.3	96.4
19	178.2	44.5	41	123.8	98.9
20	176.7	46.0	42	120.5	102.2
21	173.8	48.9	43	119.1	103.6
22	169.3	53.4			

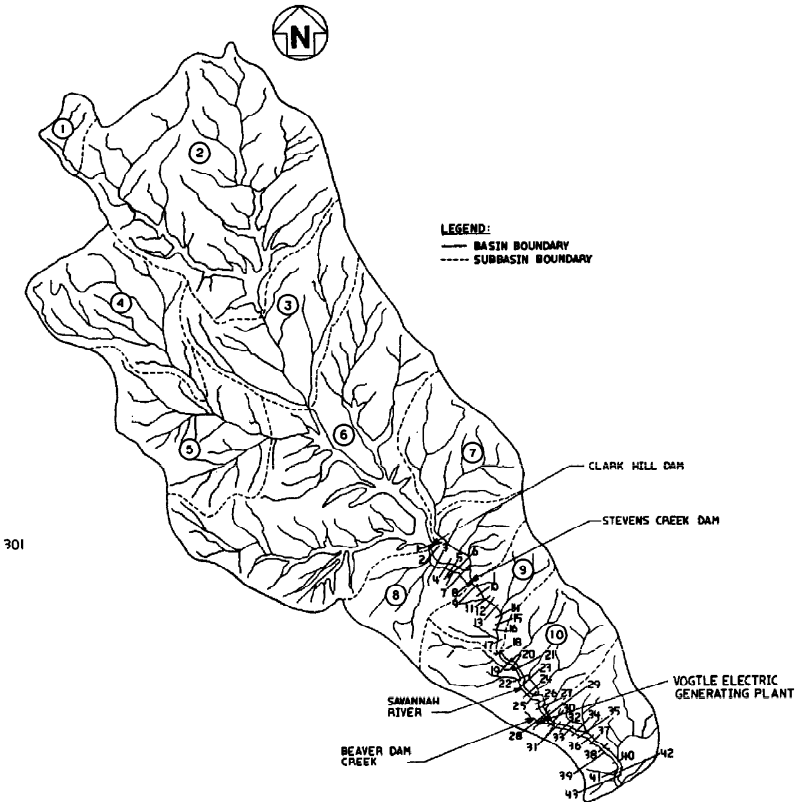

SAVANNAH RIVER BASIN

SCALE:
10 5 0 10 20 30 40 (miles)

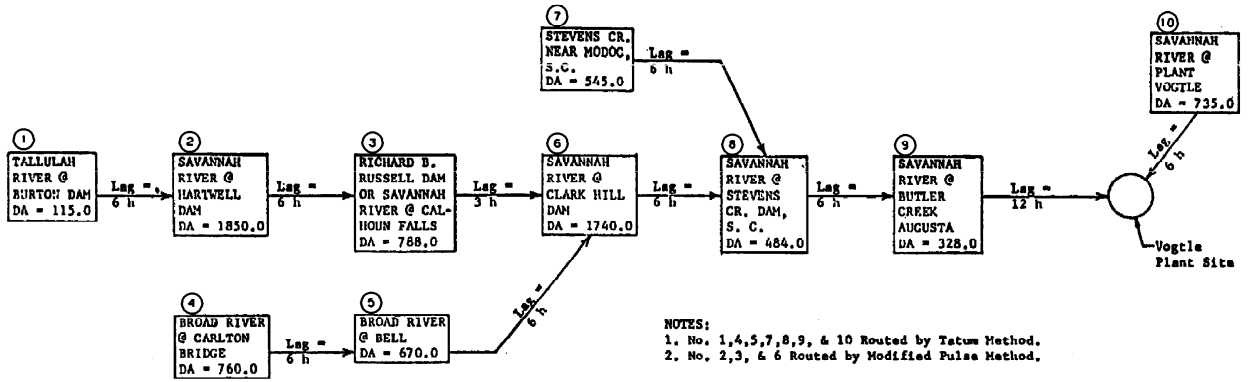

NOTES:
1. No. 1,4,5,7,8,9, & 10 Routed by Tatum Method.
2. No. 2,3, & 6 Routed by Modified Pulse Method.

SOUTHERN COMPANY SERVICES, INC.
BIRMINGHAM, ALABAMA

GEORGIA POWER COMPANY
ALVIN W. VOGTLE NUCLEAR PLANT

IDENTIFICATION & LOCATION OF SAVANNAH RIVER VALLEY CROSS-SECTION AND ROUTING FOR UNSTEADY FLOW ANALYSIS

THIS DOCUMENT CONTAINS PROPRIETARY, CONFIDENTIAL, AND/OR TRADE SECRET INFORMATION OF THE SUBSIDIARIES OF THE SOUTHERN COMPANY OR OF THIRD PARTIES. IT IS INTENDED FOR USE ONLY BY EMPLOYEES OF, OR AUTHORIZED CONTRACTORS OF, THE SUBSIDIARIES OF THE SOUTHERN COMPANY. UNAUTHORIZED POSSESSION, USE, DISTRIBUTION, COPYING, DISSEMINATION, OR DISCLOSURE OF ANY PORTION HEREOF IS PROHIBITED.

NO.	REVISIONS	DATE	DR	CHK	APPV	DTL
3						
2						
1	ISSUED PER REA 98-VAA054	9-30-98	GS	RBH	CBH	WFP

SCALE: NONE
JOB NO. 10004
DRAWING NO. AX6D0320
REV. 0
SIZE E 34X44
CAD NAME AX6D0320

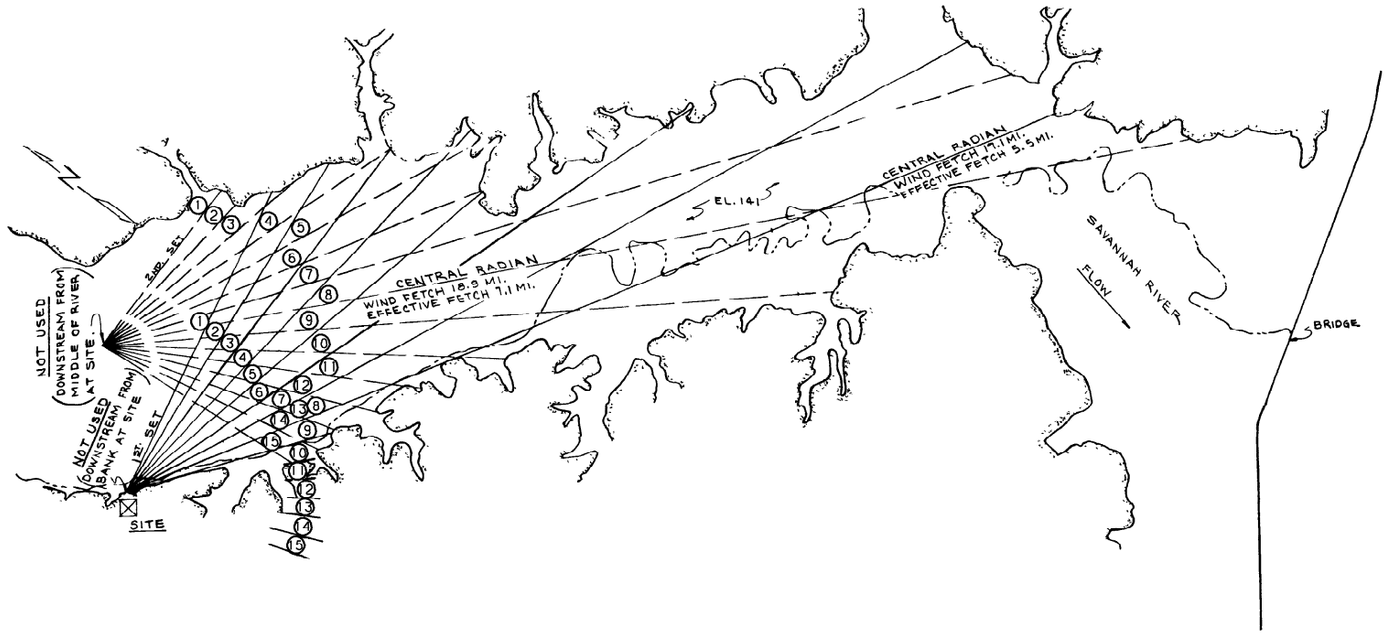

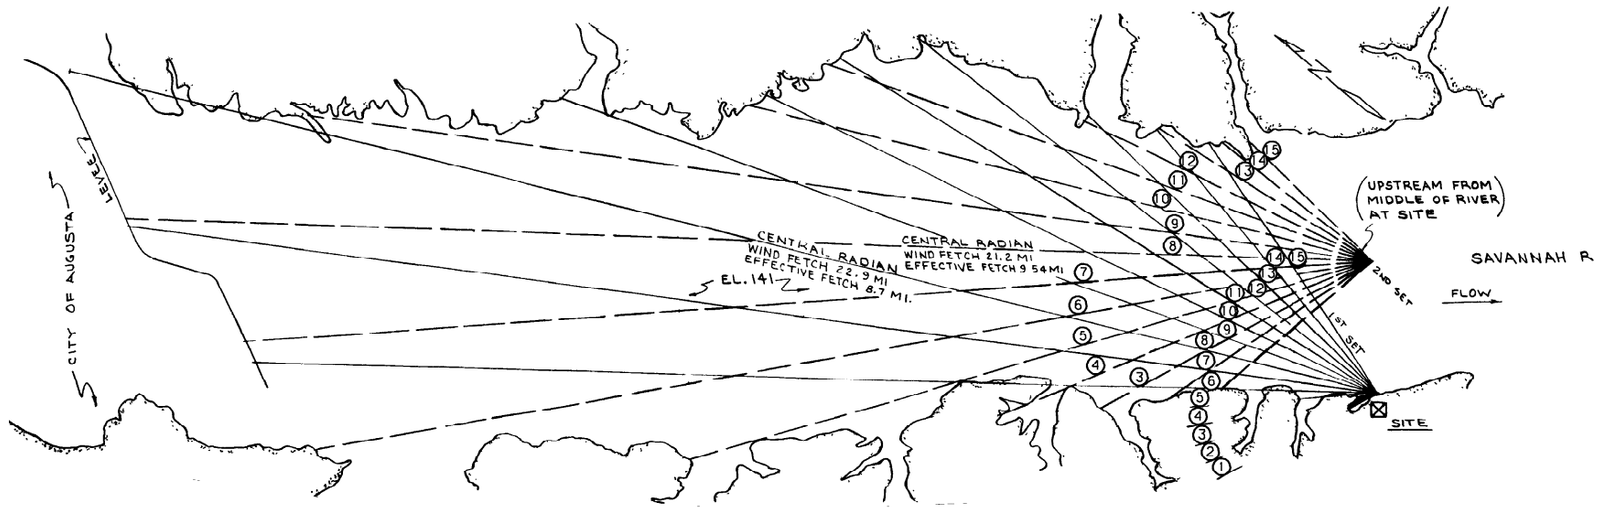

SOUTHERN COMPANY SERVICES, INC.
BIRMINGHAM, ALABAMA

GEORGIA POWER COMPANY
ALVIN W. VOGTLE NUCLEAR PLANT

WAVE STUDY
FETCH DIAGRAMS

NO.	REVISIONS	DATE	DR	CHK	APPV	DTL
△						
0	ISSUED PER REA 96-VAA054	9-30-98	GS	RBH	CBH	WFP

SCALE: NONE

JOB NO. 10604

DRAWING NO.	REV
AX6DD321	0

THIS DOCUMENT CONTAINS PROPRIETARY, CONFIDENTIAL, AND/OR TRADE SECRET INFORMATION OF THE SUBSIDIARIES OF THE SOUTHERN COMPANY OR OF THIRD PARTIES. IT IS INTENDED FOR USE ONLY BY EMPLOYEES OF, OR AUTHORIZED CONTRACTORS OF, THE SUBSIDIARIES OF THE SOUTHERN COMPANY. UNAUTHORIZED POSSESSION, USE, DISTRIBUTION, COPYING, DISSEMINATION, OR DISCLOSURE OF ANY PORTION HEREOF IS PROHIBITED.

CAD NAME AX6DD321 SIZE B 11x17

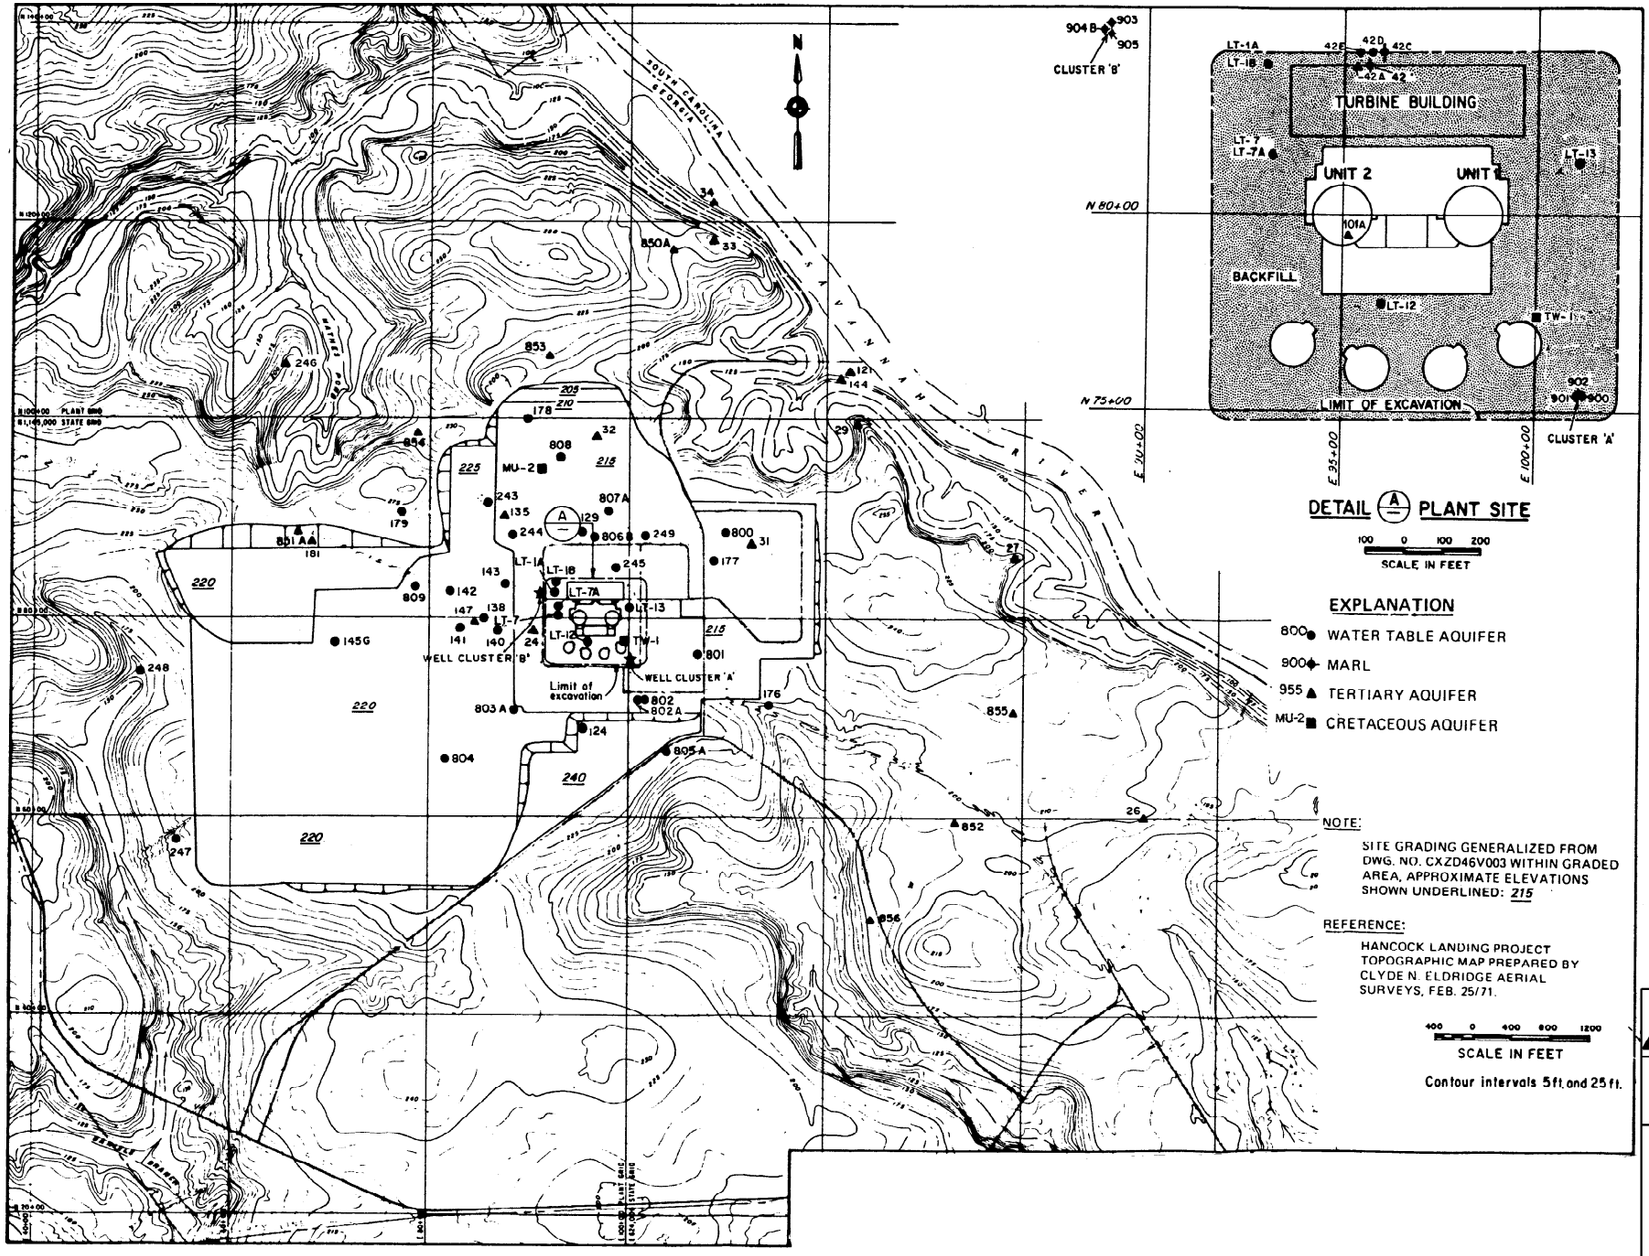

SOUTHERN COMPANY SERVICES, INC.
BIRMINGHAM, ALABAMA

GEORGIA POWER COMPANY
ALVIN W. VOGTLE NUCLEAR PLANT

OBSERVATION WELLS 1971-1985

NO.	REVISIONS	DATE	DR	CHK	APPV	DTL
1						
0	ISSUED PER REA 96-VAA054	9-30-98	GS	RBH	CBH	WFP

SCALE: NONE

JOB NO. 10604

DRAWING NO. AX6DD323

REV 0

THIS DOCUMENT CONTAINS PROPRIETARY, CONFIDENTIAL, AND/OR TRADE SECRET INFORMATION OF THE SUBSIDIARIES OF THE SOUTHERN COMPANY OR OF THIRD PARTIES. IT IS INTENDED FOR USE ONLY BY EMPLOYEES OF, OR AUTHORIZED CONTRACTORS OF, THE SUBSIDIARIES OF THE SOUTHERN COMPANY. UNAUTHORIZED POSSESSION, USE, DISTRIBUTION, COPYING, DISSEMINATION, OR DISCLOSURE OF ANY PORTION HEREOF IS PROHIBITED.

CAD NAME AX6DD323 SIZE B 11x17

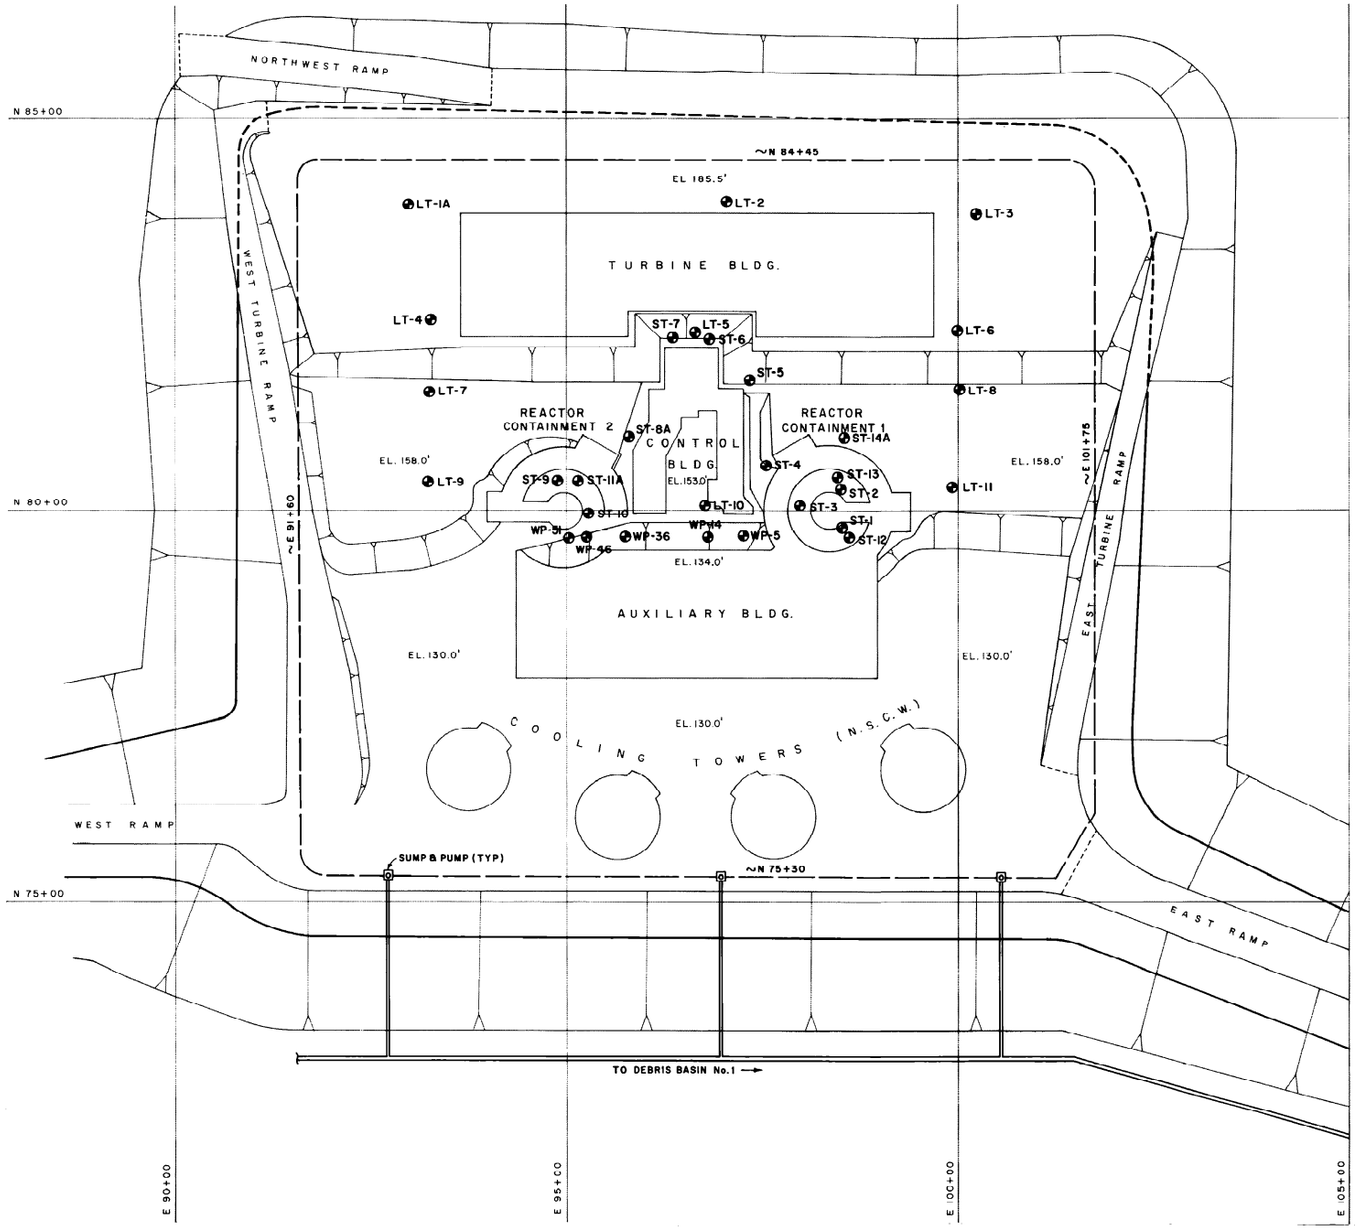

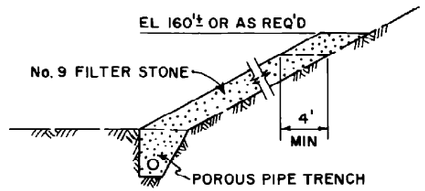

FILTER ZONE DETAIL

N.T.S.

EXPLANATION

- Top of filter blanket – dashed where covered by fill
- Porous pipe trench
- Sump and pump
- LT-2 Long term piezometer (Location approximate)
- ST-1 Short term piezometer (Location approximate)
- WP-5 Observation well (Location approximate)

N

50 0 50 100 150 200

SCALE IN FEET

SOUTHERN COMPANY SERVICES, INC.
BIRMINGHAM, ALABAMA

GEORGIA POWER COMPANY
ALVIN W. VOGTLE NUCLEAR PLANT

CONSTRUCTION DEWATERING PLAN

NO.	REVISIONS	DATE	DR	CHK	APPV	DTL
△						
0	ISSUED PER REA 96-VAA054	9-30-98	GS	RBH	CBH	WFP

SCALE: NONE

JOB NO. 10604

DRAWING NO. AX6DD324

REV 0

THIS DOCUMENT CONTAINS PROPRIETARY, CONFIDENTIAL, AND/OR TRADE SECRET INFORMATION OF THE SUBSIDIARIES OF THE SOUTHERN COMPANY OR OF THIRD PARTIES. IT IS INTENDED FOR USE ONLY BY EMPLOYEES OF, OR AUTHORIZED CONTRACTORS OF, THE SUBSIDIARIES OF THE SOUTHERN COMPANY. UNAUTHORIZED POSSESSION, USE, DISTRIBUTION, COPYING, DISSEMINATION, OR DISCLOSURE OF ANY PORTION HEREOF IS PROHIBITED.

CAD NAME AX6DD324 SIZE B 11x17

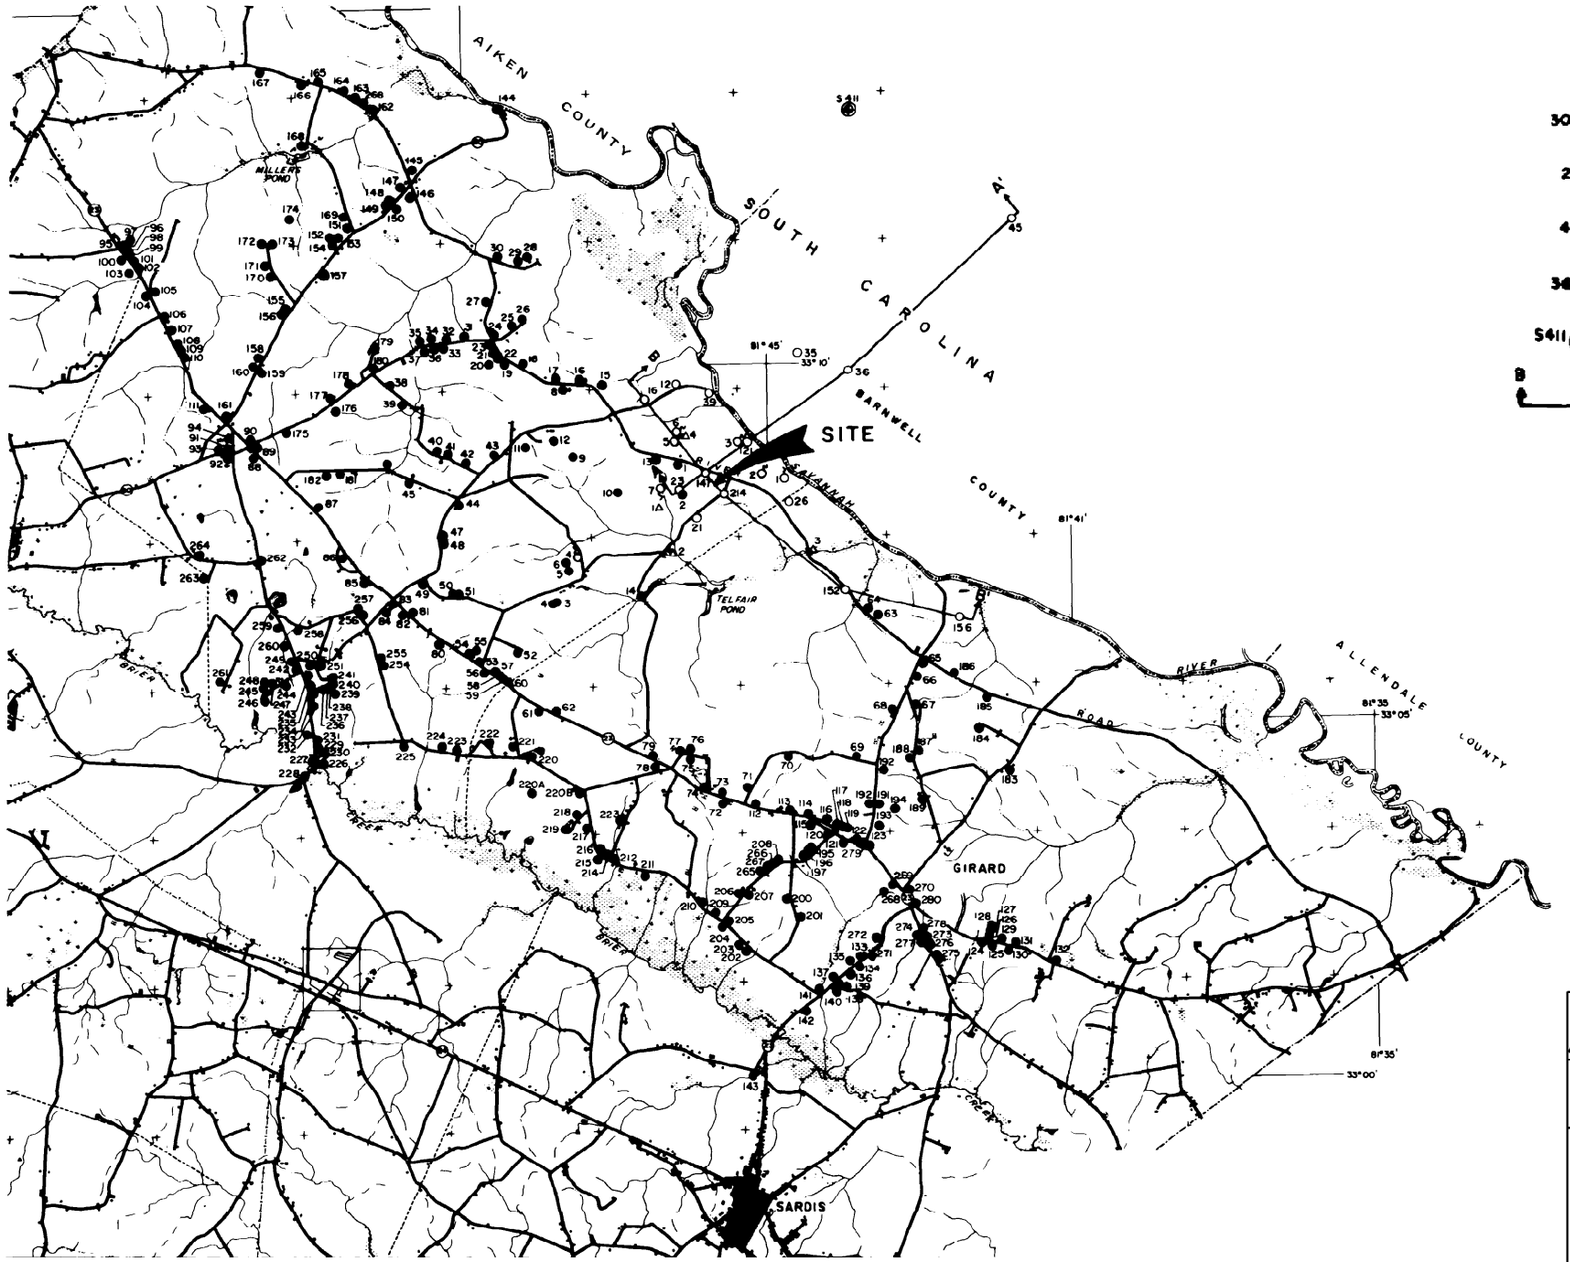

EXPLANATION

- 30● DOMESTIC WATER WELL
- 2○ SAMPLED SPRING
- 4△ SURFACE WATER SAMPLE POINT
- 36○ DRILL HOLES
- S411 U.S.G.S. MONITOR WELL (AEC SRP)
- B B' GEOLOGIC SECTION

SCALE IN MILES 1 0 1 2

SOUTHERN COMPANY SERVICES, INC.
BIRMINGHAM, ALABAMA

GEORGIA POWER COMPANY
ALVIN W. VOGTLE NUCLEAR PLANT

OUTLYING EXPLORATION HOLES, WELLS, AND SPRINGS

NO.	REVISIONS	DATE	DR	CHK	APPV	DTL
△						
0	ISSUED PER REA 96-VAA054	9-30-98	GS	RBH	CBH	WFP

SCALE: NONE | DRAWING NO. AX6DD325 | REV 0

JOB NO. 10604

THIS DOCUMENT CONTAINS PROPRIETARY, CONFIDENTIAL, AND/OR TRADE SECRET INFORMATION OF THE SUBSIDIARIES OF THE SOUTHERN COMPANY OR OF THIRD PARTIES. IT IS INTENDED FOR USE ONLY BY EMPLOYEES OF, OR AUTHORIZED CONTRACTORS OF, THE SUBSIDIARIES OF THE SOUTHERN COMPANY. UNAUTHORIZED POSSESSION, USE, DISTRIBUTION, COPYING, DISSEMINATION, OR DISCLOSURE OF ANY PORTION HEREOF IS PROHIBITED.

CAD NAME AX6DD325 SIZE B 11x17

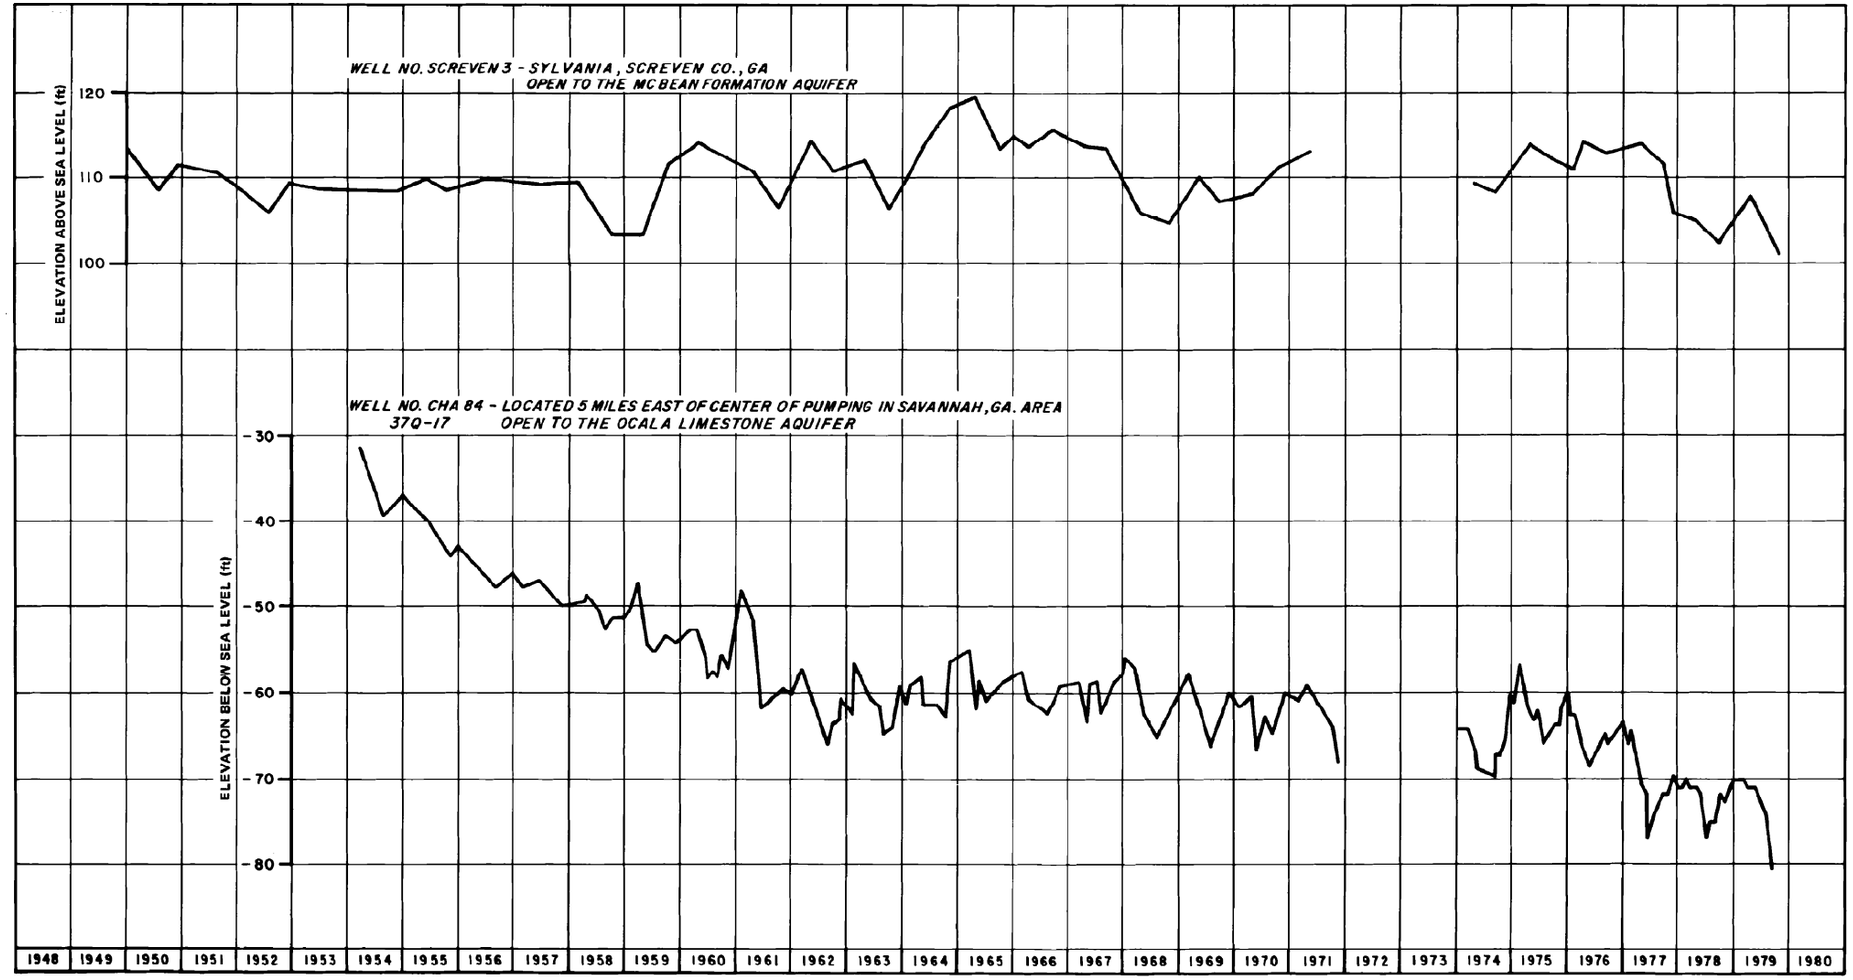

COASTAL PLAIN OF GEORGIA - SOUTH CAROLINA
U.S. GEOLOGICAL SURVEY - A.E.C. SAVANNAH RIVER PROJECT

SOUTHERN COMPANY SERVICES, INC.
BIRMINGHAM, ALABAMA

GEORGIA POWER COMPANY
ALVIN W. VOGTLE NUCLEAR PLANT

HYDROGRAPHS OF WATER WELLS-SCREVEN 3; CHA 84

NO.	REVISIONS	DATE	DR	CHK	APPV	DTL
△						
0	ISSUED PER REA 96-VAA054	9-30-98	GS	RBH	CBH	WFP

SCALE: NONE

JOB NO. 10604

DRAWING NO. AX6DD326

REV 0

THIS DOCUMENT CONTAINS PROPRIETARY, CONFIDENTIAL, AND/OR TRADE SECRET INFORMATION OF THE SUBSIDIARIES OF THE SOUTHERN COMPANY OR OF THIRD PARTIES. IT IS INTENDED FOR USE ONLY BY EMPLOYEES OF, OR AUTHORIZED CONTRACTORS OF, THE SUBSIDIARIES OF THE SOUTHERN COMPANY. UNAUTHORIZED POSSESSION, USE, DISTRIBUTION, COPYING, DISSEMINATION, OR DISCLOSURE OF ANY PORTION HEREOF IS PROHIBITED.

CAD NAME AX6DD326

SIZE B 11x17

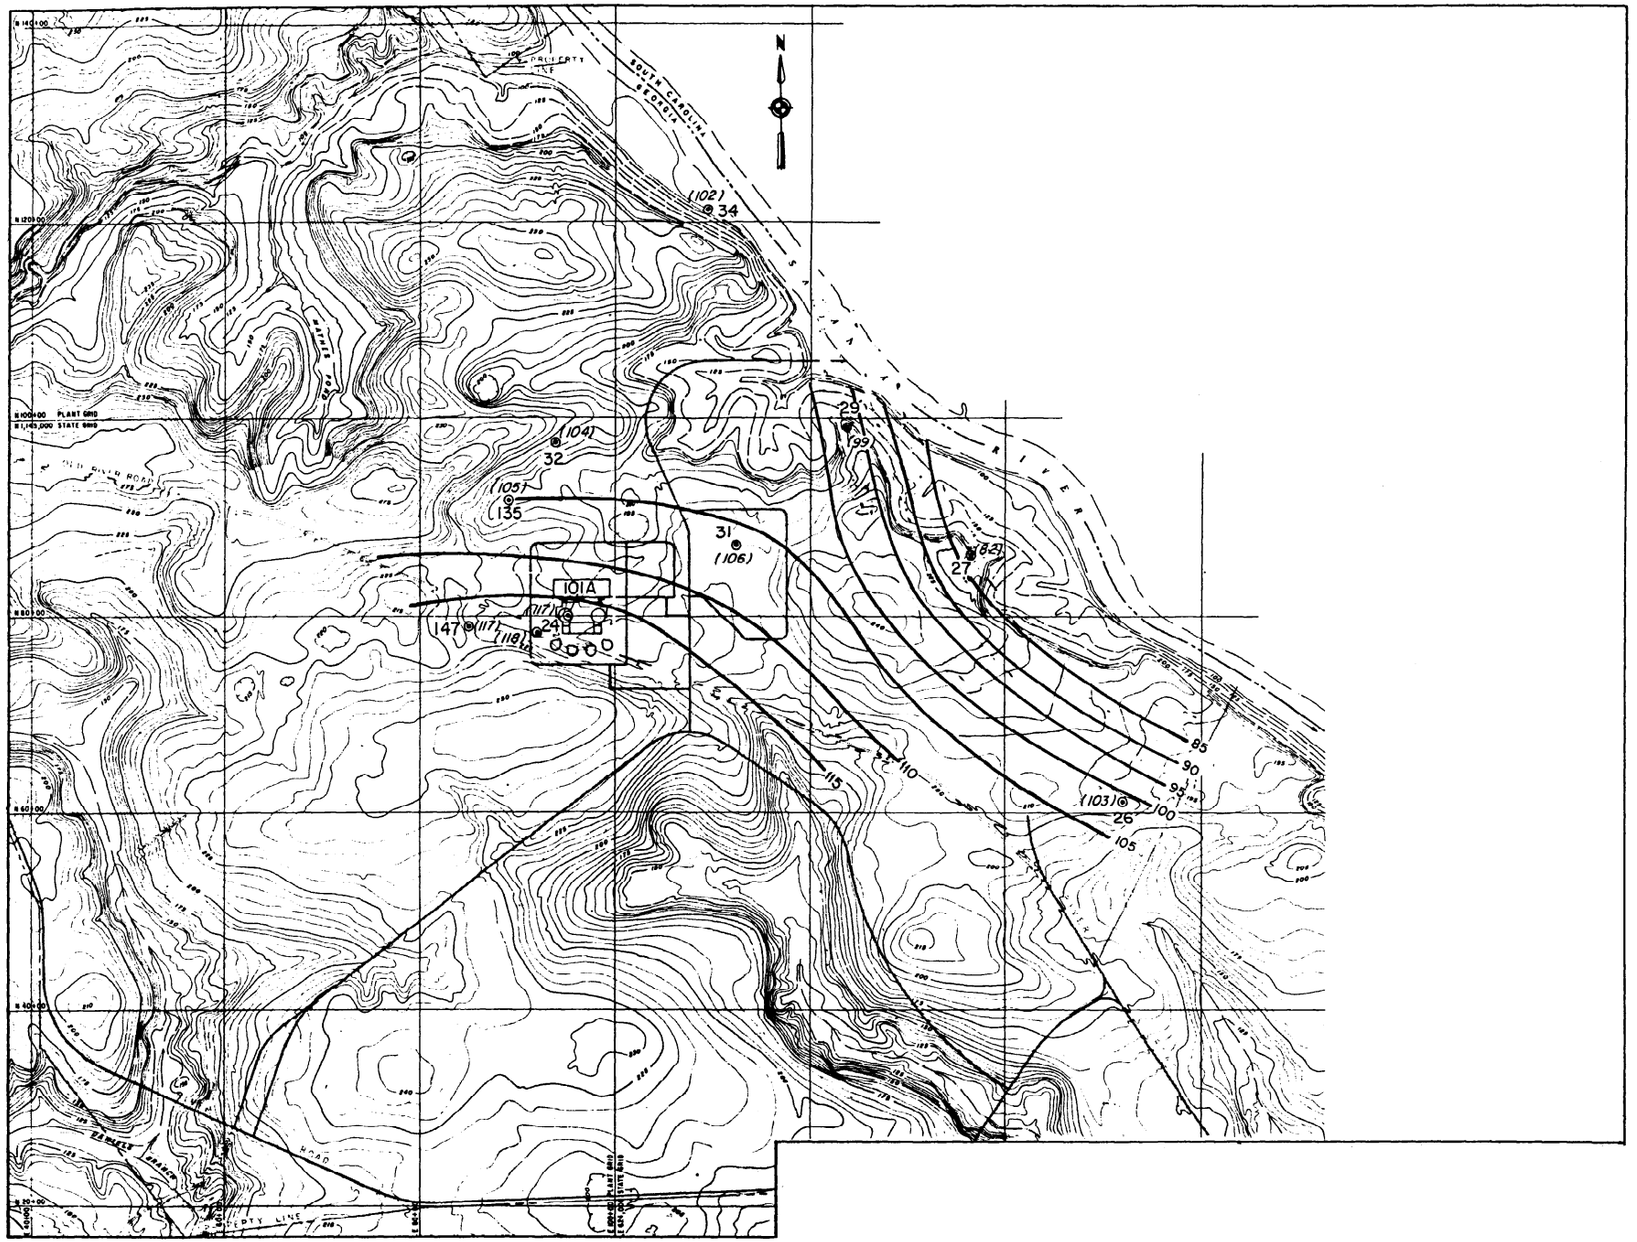

EXPLANATION

31
(106) OBSERVATION WELL
PIEZOMETRIC ELEVATION IN PARENTHESES

100 CONTOUR OF PIEZOMETRIC SURFACE ELEVATION

REFERENCE:

HANCOCK LANDING PROJECT
TOPOGRAPHIC MAP PREPARED BY
CLYDE N. ELDRIDGE AERIAL
SURVEYS, FEB. 25/71.

SOUTHERN COMPANY SERVICES, INC.
BIRMINGHAM, ALABAMA

GEORGIA POWER COMPANY
ALVIN W. VOGTLE NUCLEAR PLANT

PIEZOMETRIC SURFACE OF TERTIARY AQUIFER OCTOBER 1971

NO.	REVISIONS	DATE	DR	CHK	APPV	DTL
△						
0	ISSUED PER REA 96-VAA054	9-30-98	GS	RBH	CBH	WFP

SCALE: NONE | DRAWING NO. AX6DD327 | REV 0

JOB NO. 10604

THIS DOCUMENT CONTAINS PROPRIETARY, CONFIDENTIAL, AND/OR TRADE SECRET INFORMATION OF THE SUBSIDIARIES OF THE SOUTHERN COMPANY OR OF THIRD PARTIES. IT IS INTENDED FOR USE ONLY BY EMPLOYEES OF, OR AUTHORIZED CONTRACTORS OF, THE SUBSIDIARIES OF THE SOUTHERN COMPANY. UNAUTHORIZED POSSESSION, USE, DISTRIBUTION, COPYING, DISSEMINATION, OR DISCLOSURE OF ANY PORTION HEREOF IS PROHIBITED.

CAD NAME AX6DD327 SIZE B 11x17

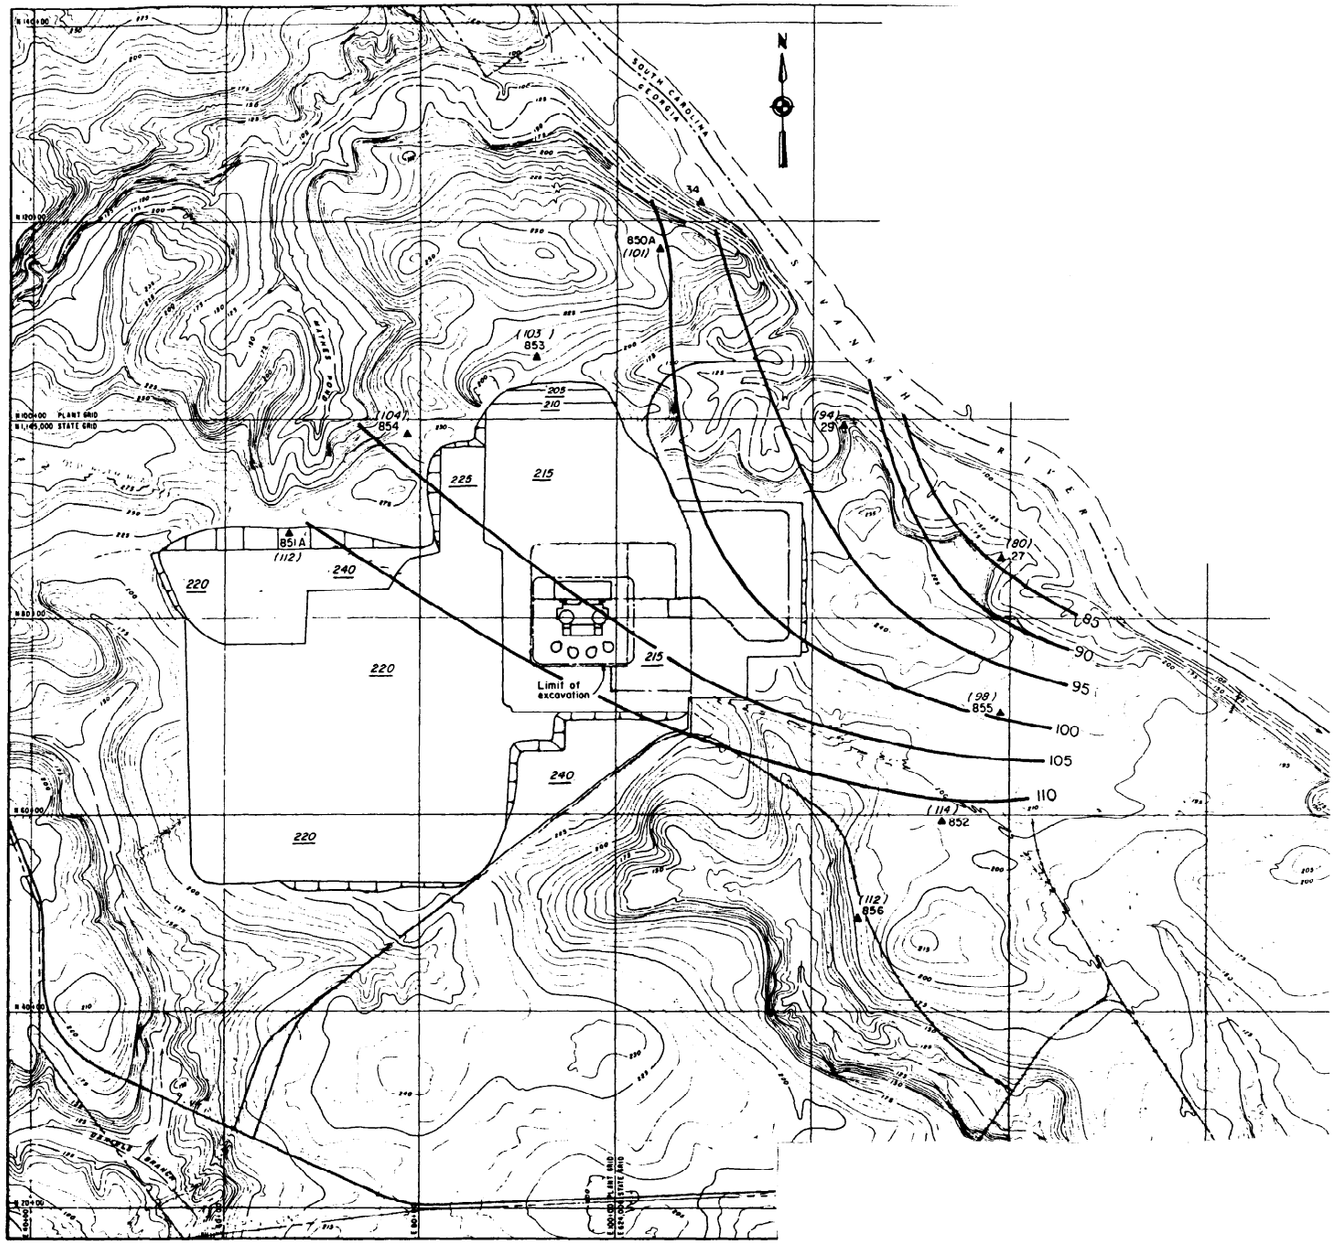

EXPLANATION

▲853 (103) OBSERVATION WELL
PIEZOMETRIC ELEVATION IN PARENTHESES

100 CONTOUR OF PIEZOMETRIC SURFACE ELEVATION

NOTE:

SITE GRADING GENERALIZED FROM DWG. NO. CXZD46V003 WITHIN GRADED AREA, APPROXIMATE ELEVATIONS SHOWN UNDERLINED: 215

REFERENCE:

HANCOCK LANDING PROJECT TOPOGRAPHIC MAP PREPARED BY CLYDE N. ELDRIDGE AERIAL SURVEYS, FEB. 25/71.

400 0 400 800 1200
SCALE IN FEET

Contour intervals 5 ft. and 25 ft.

SOUTHERN COMPANY SERVICES, INC.
BIRMINGHAM, ALABAMA

GEORGIA POWER COMPANY
ALVIN W. VOGTLE NUCLEAR PLANT

PIEZOMETRIC SURFACE OF TERTIARY AQUIFER DECEMBER 1984

NO.	REVISIONS	DATE	DR	CHK	APPV	DTL
1						
0	ISSUED PER REA 96-VAA054	9-30-98	GS	RBH	CBH	WFP

SCALE: NONE | DRAWING NO. AX6DD328 | REV 0

JOB NO. 10604

THIS DOCUMENT CONTAINS PROPRIETARY, CONFIDENTIAL, AND/OR TRADE SECRET INFORMATION OF THE SUBSIDIARIES OF THE SOUTHERN COMPANY OR OF THIRD PARTIES. IT IS INTENDED FOR USE ONLY BY EMPLOYEES OF, OR AUTHORIZED CONTRACTORS OF, THE SUBSIDIARIES OF THE SOUTHERN COMPANY. UNAUTHORIZED POSSESSION, USE, DISTRIBUTION, COPYING, DISSEMINATION, OR DISCLOSURE OF ANY PORTION HEREOF IS PROHIBITED.

CAD NAME AX6DD328 SIZE B 11x17

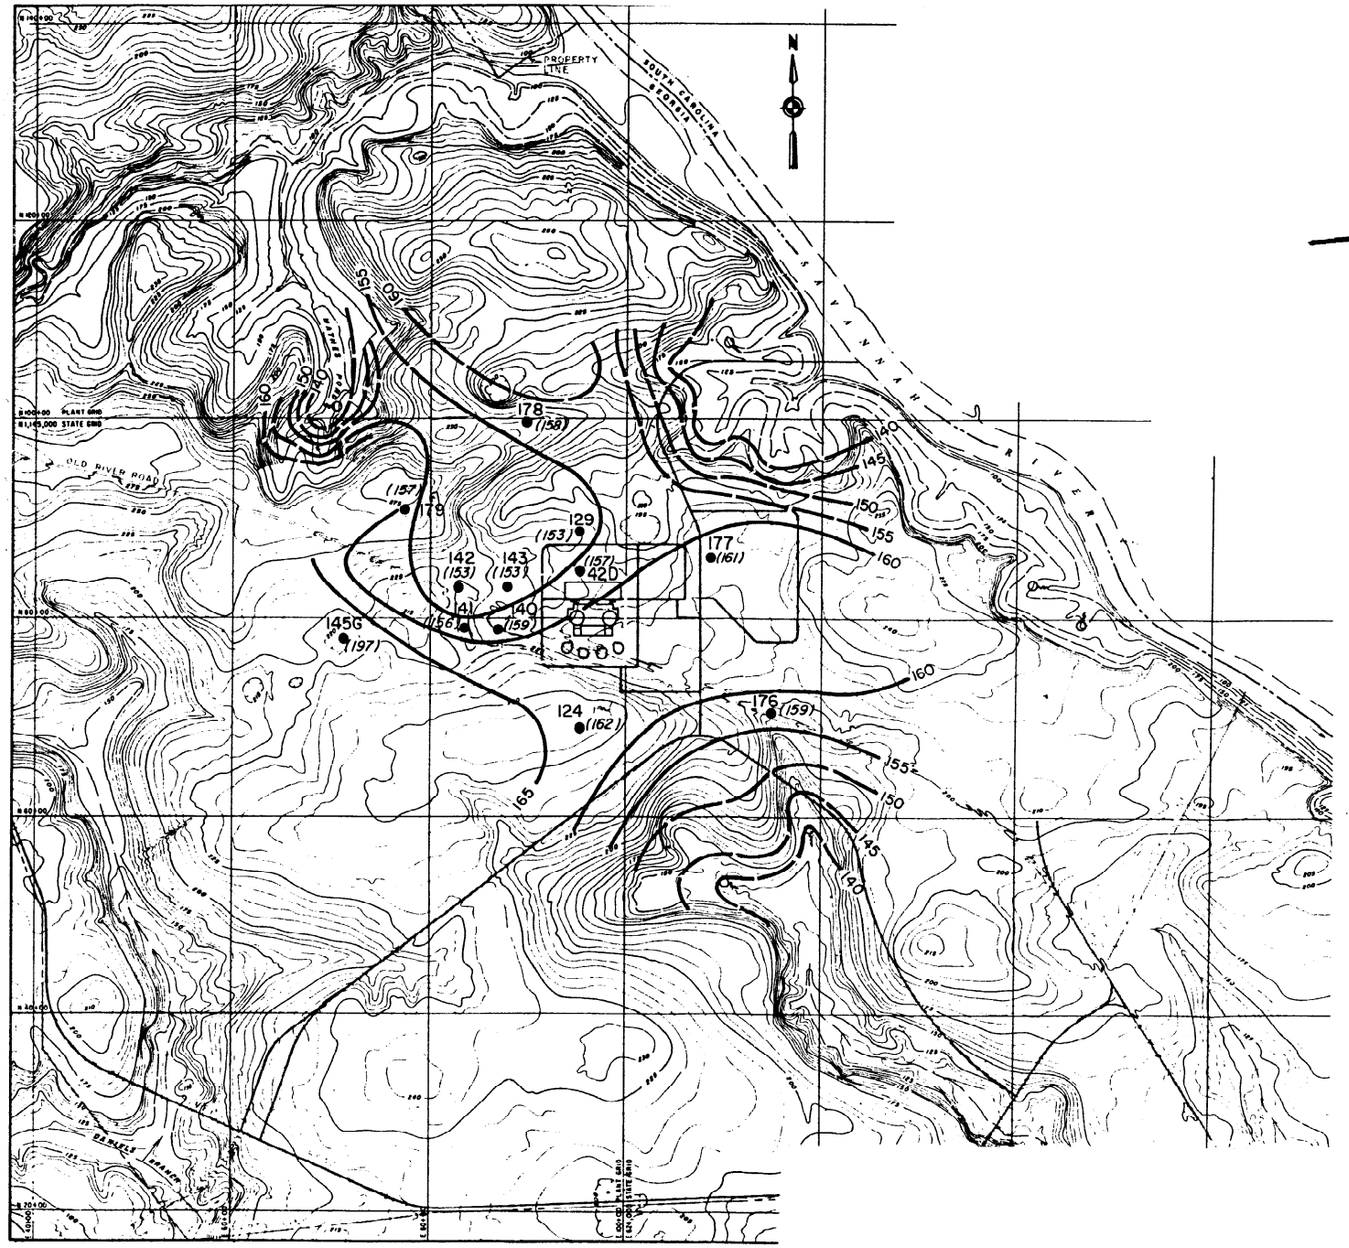

EXPLANATION

177
(161) OBSERVATION WELL
WATER TABLE ELEVATION IN PARENTHESES

SPRING OR SEEP

160 CONTOUR OF WATER TABLE ELEVATION

REFERENCE:

HANCOCK LANDING PROJECT
TOPOGRAPHIC MAP PREPARED BY
CLYDE N. ELDRIDGE AERIAL
SURVEYS, FEB. 25/71.

400 0 400 800 1200
SCALE IN FEET

Contour intervals 5 ft. and 25 ft.

SOUTHERN COMPANY SERVICES, INC.
BIRMINGHAM, ALABAMA

GEORGIA POWER COMPANY
ALVIN W. VOGTLE NUCLEAR PLANT

CONTOURS OF WATER TABLE AQUIFER NOVEMBER 1971

NO.	REVISIONS	DATE	DR	CHK	APPV	DTL
1						
0	ISSUED PER REA 96-VAA054	9-30-98	GS	RBH	CBH	WFP

SCALE: NONE

JOB NO. 10604

DRAWING NO. AX6DD329

REV 0

THIS DOCUMENT CONTAINS PROPRIETARY, CONFIDENTIAL, AND/OR TRADE SECRET INFORMATION OF THE SUBSIDIARIES OF THE SOUTHERN COMPANY OR OF THIRD PARTIES. IT IS INTENDED FOR USE ONLY BY EMPLOYEES OF, OR AUTHORIZED CONTRACTORS OF, THE SUBSIDIARIES OF THE SOUTHERN COMPANY. UNAUTHORIZED POSSESSION, USE, DISTRIBUTION, COPYING, DISSEMINATION, OR DISCLOSURE OF ANY PORTION HEREOF IS PROHIBITED.

CAD NAME AX6DD329 SIZE B 11x17

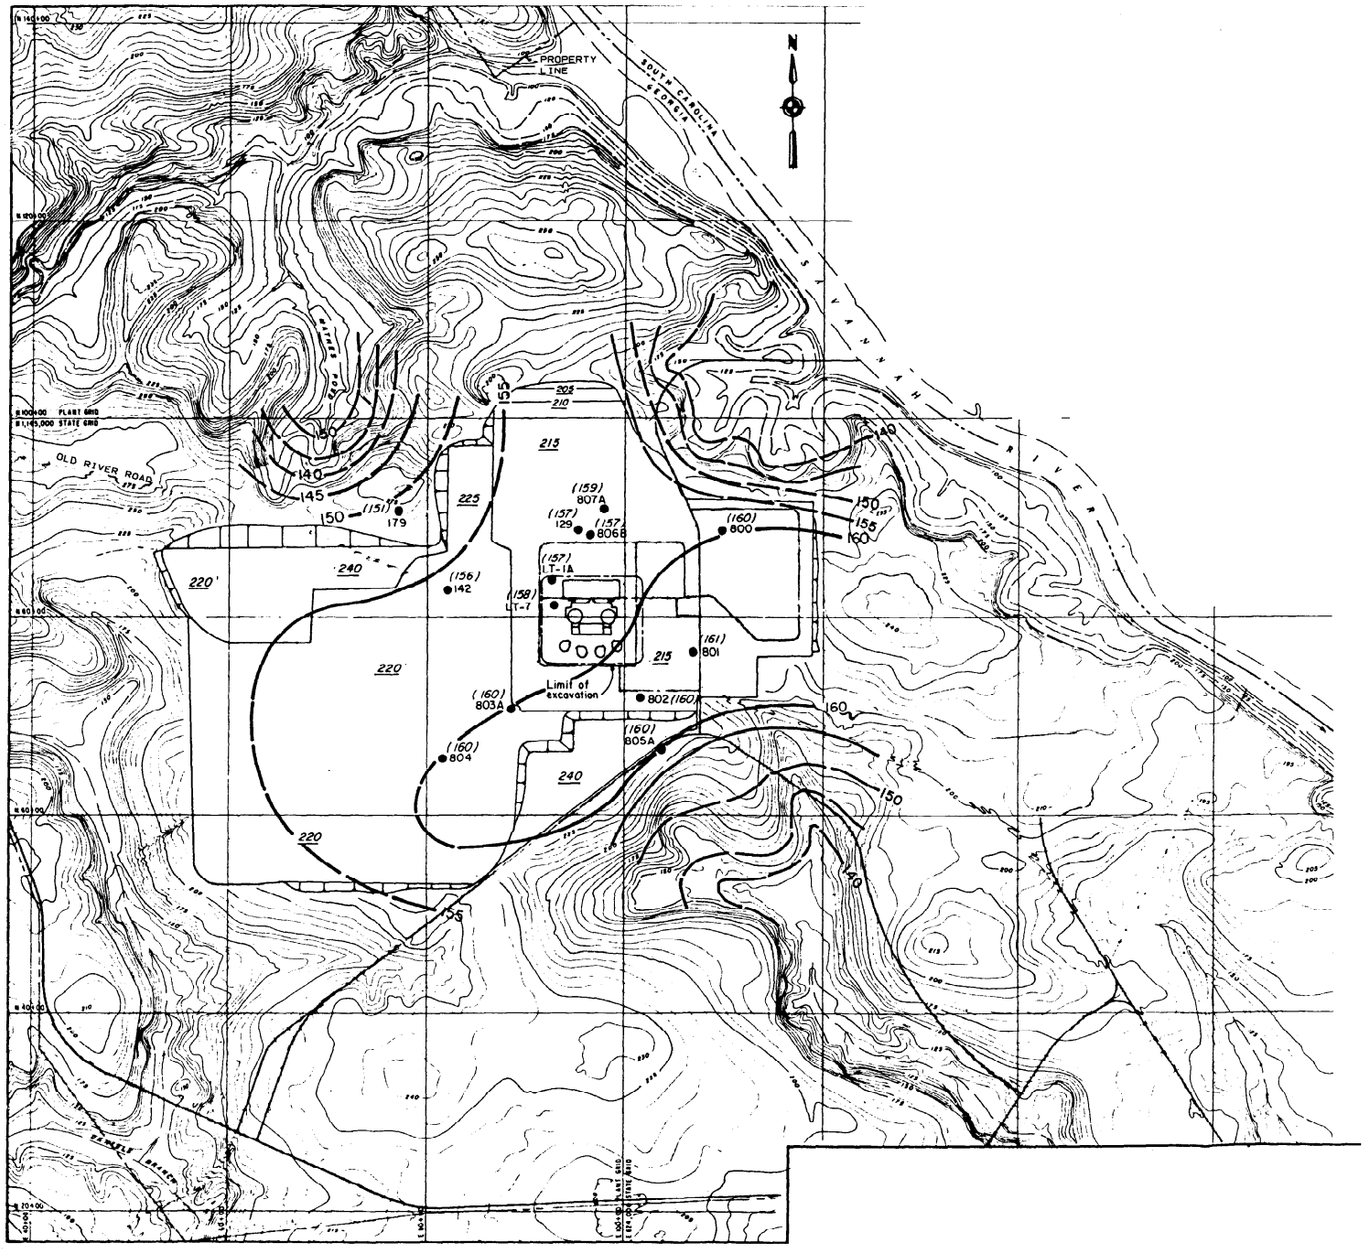

EXPLANATION

800 ● OBSERVATION WELL
(160) WATER TABLE ELEVATION IN PARENTHESES

160 CONTOUR OF GROUND-WATER ELEVATION

NOTE:

SITE GRADING GENERALIZED FROM DWG. NO. CXZD46V003 WITHIN GRADED AREA, APPROXIMATE ELEVATIONS SHOWN UNDERLINED: 215

REFERENCE:

HANCOCK LANDING PROJECT TOPOGRAPHIC MAP PREPARED BY CLYDE N. ELDRIDGE AERIAL SURVEYS, FEB. 25/71.

400 0 400 800 1200
SCALE IN FEET

Contour intervals 5ft. and 25ft.

SOUTHERN COMPANY SERVICES, INC.
BIRMINGHAM, ALABAMA

GEORGIA POWER COMPANY
ALVIN W. VOGTLE NUCLEAR PLANT

CONTOURS OF WATER TABLE AQUIFER DECEMBER 1984

NO.	REVISIONS	DATE	DR	CHK	APPV	DTL
△						
△0	ISSUED PER REA 96-VAA054	9-30-98	GS	RBH	CBH	WFP

SCALE: NONE | DRAWING NO. AX6DD330 | REV 0

JOB NO. 10604

THIS DOCUMENT CONTAINS PROPRIETARY, CONFIDENTIAL, AND/OR TRADE SECRET INFORMATION OF THE SUBSIDIARIES OF THE SOUTHERN COMPANY OR OF THIRD PARTIES. IT IS INTENDED FOR USE ONLY BY EMPLOYEES OF, OR AUTHORIZED CONTRACTORS OF, THE SUBSIDIARIES OF THE SOUTHERN COMPANY. UNAUTHORIZED POSSESSION, USE, DISTRIBUTION, COPYING, DISSEMINATION, OR DISCLOSURE OF ANY PORTION HEREOF IS PROHIBITED.

CAD NAME AX6DD330 SIZE B 11x17

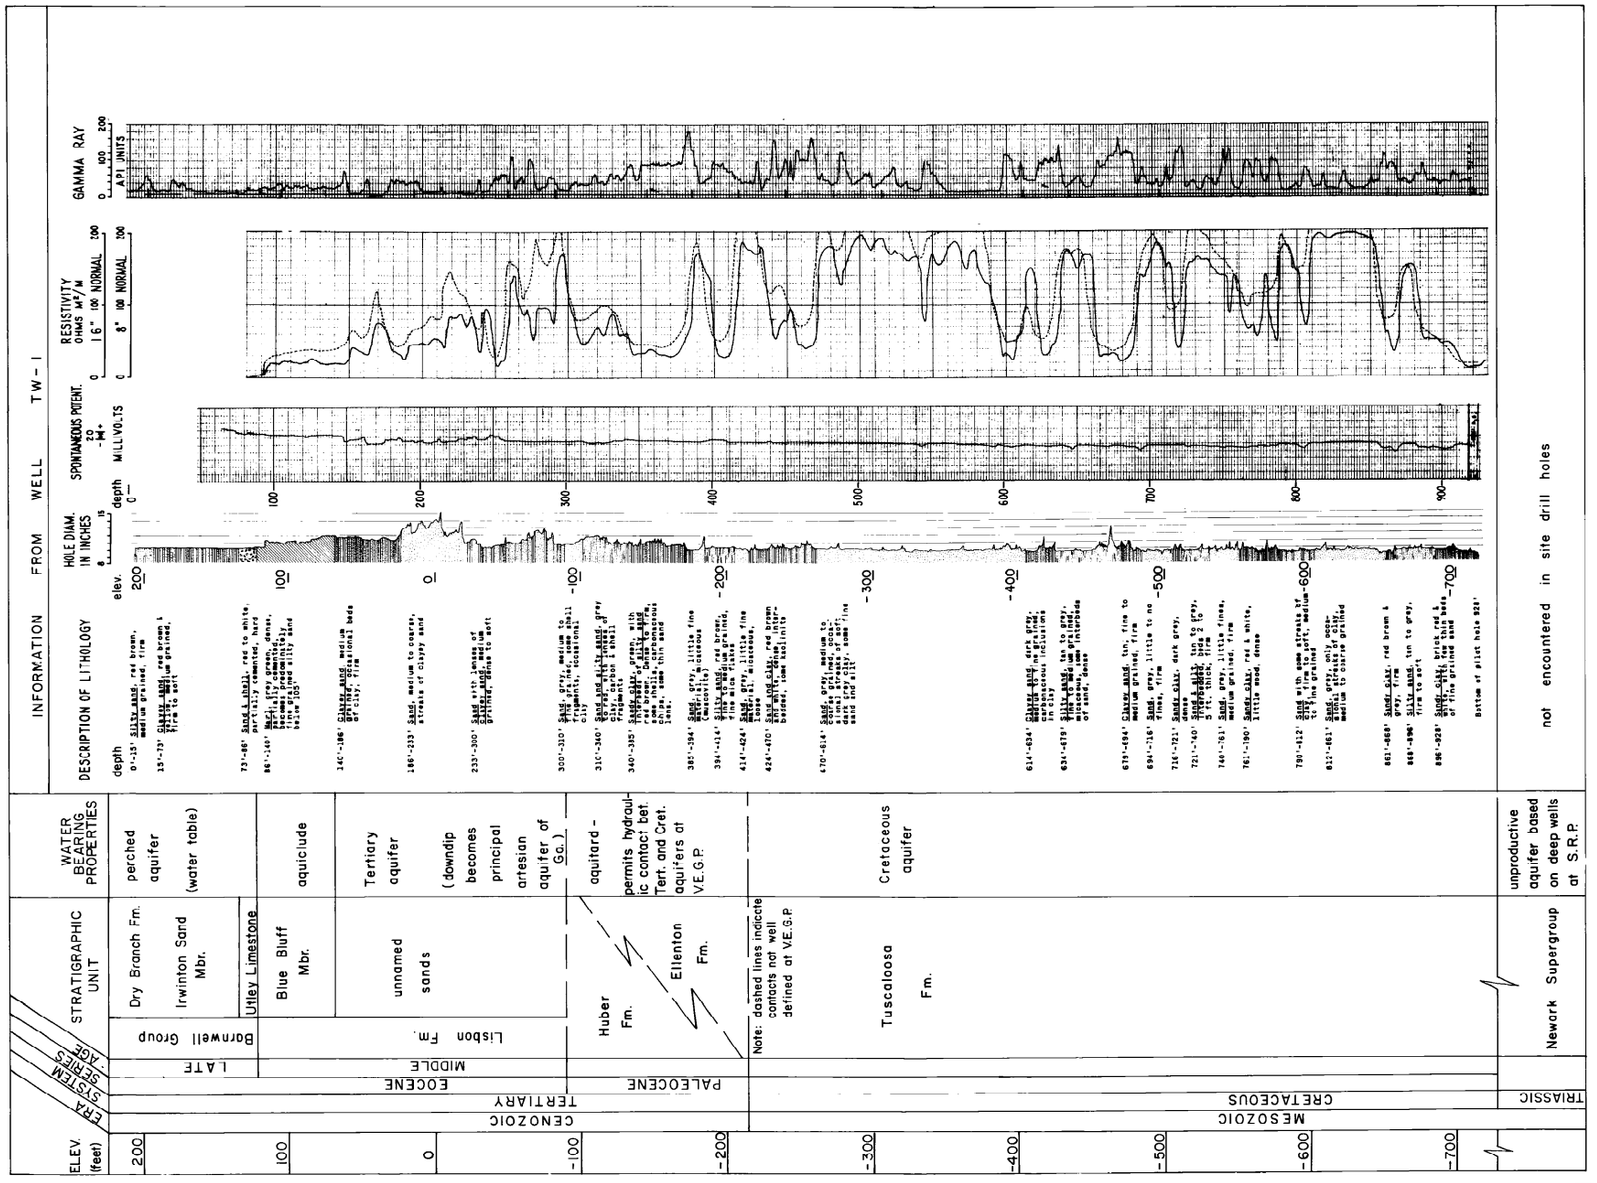

SOUTHERN COMPANY SERVICES, INC.
BIRMINGHAM, ALABAMA

GEORGIA POWER COMPANY
ALVIN W. VOGTLE NUCLEAR PLANT

STRATIGRAPHIC COLUMN SHOWING LITHOLOGY AND HYDROGEOLOGIC UNITS

NO.	REVISIONS	DATE	DR	CHK	APPV	DTL
1						
0	ISSUED PER REA 96-VAA054	9-30-98	GS	RBH	CBH	WFP

SCALE: NONE

DRAWING NO. AX6DD331

REV 0

JOB NO. 10604

THIS DOCUMENT CONTAINS PROPRIETARY, CONFIDENTIAL, AND/OR TRADE SECRET INFORMATION OF THE SUBSIDIARIES OF THE SOUTHERN COMPANY OR OF THIRD PARTIES. IT IS INTENDED FOR USE ONLY BY EMPLOYEES OF, OR AUTHORIZED CONTRACTORS OF, THE SUBSIDIARIES OF THE SOUTHERN COMPANY. UNAUTHORIZED POSSESSION, USE, DISTRIBUTION, COPYING, DISSEMINATION, OR DISCLOSURE OF ANY PORTION HEREOF IS PROHIBITED.

CAD NAME AX6DD331 SIZE B 11x17

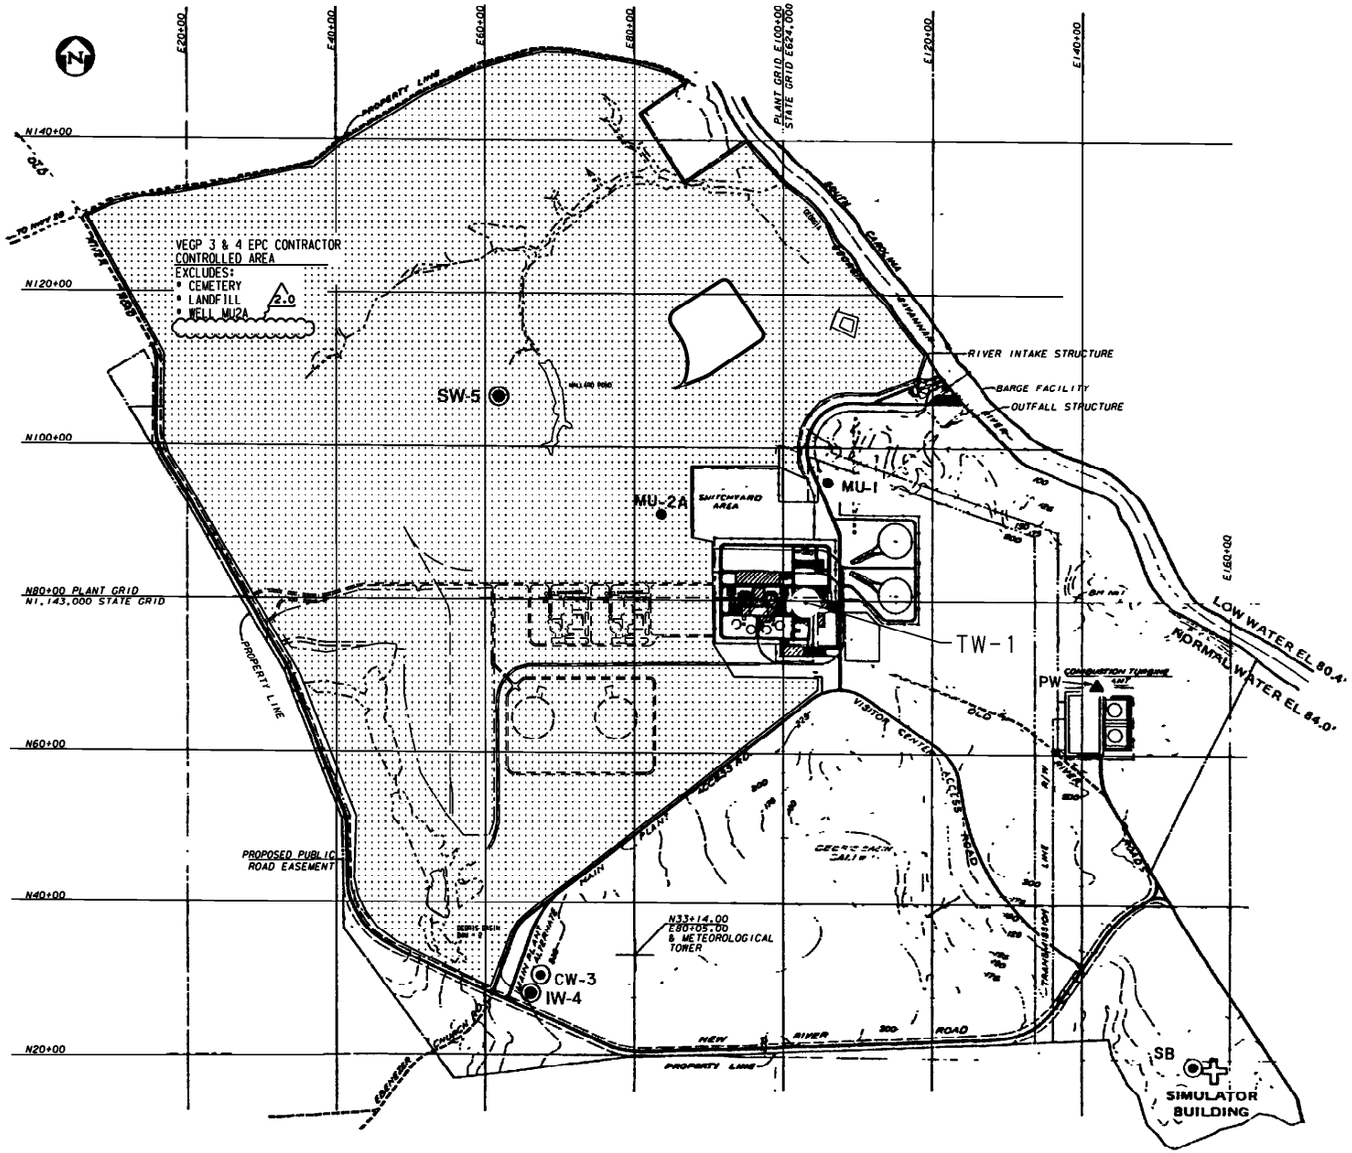

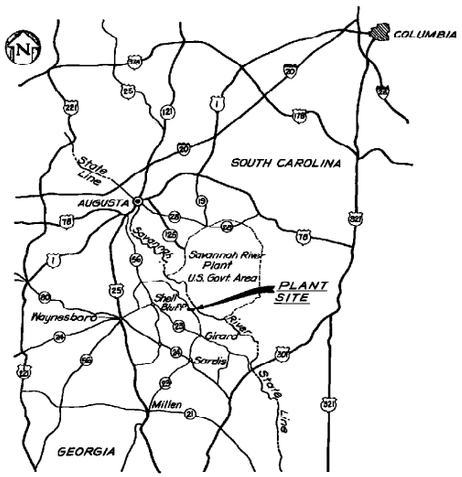

VICINITY MAP
SCALE: 1" = 10 mi.

EXPLANATION

MU-1 ● WELLS IN CRETACEOUS AQUIFER

CW-1 ◉ WELLS IN TERTIARY AQUIFER

PW ▲ WELL IN WATER TABLE AQUIFER

GRAPHIC SCALE
500 0 500 1000 1500 2000
FEET

SOUTHERN COMPANY SERVICES, INC.
BIRMINGHAM, ALABAMA

GEORGIA POWER COMPANY
ALVIN W. VOGTLE NUCLEAR PLANT

WATER SUPPLY WELLS

NO.	VERSIONS	DATE	DR	CHK	APPV	
2.0	REVISED PER ABN-V03067, VER. 1.0	9-11-12	JJB	MLH	AAN	X

SCALE: NONE
JOB NO. 10604
DRAWING NO. AX6DD332
VER 2.0

THIS DOCUMENT CONTAINS PROPRIETARY, CONFIDENTIAL, AND/OR TRADE SECRET INFORMATION OF THE SUBSIDIARIES OF THE SOUTHERN COMPANY OR OF THIRD PARTIES. IT IS INTENDED FOR USE ONLY BY EMPLOYEES OF, OR AUTHORIZED CONTRACTORS OF, THE SUBSIDIARIES OF THE SOUTHERN COMPANY. UNAUTHORIZED POSSESSION, USE, DISTRIBUTION, COPYING, DISSEMINATION, OR DISCLOSURE OF ANY PORTION HEREOF IS PROHIBITED.

CAD NAME AX6DD332 SIZE B 11x17

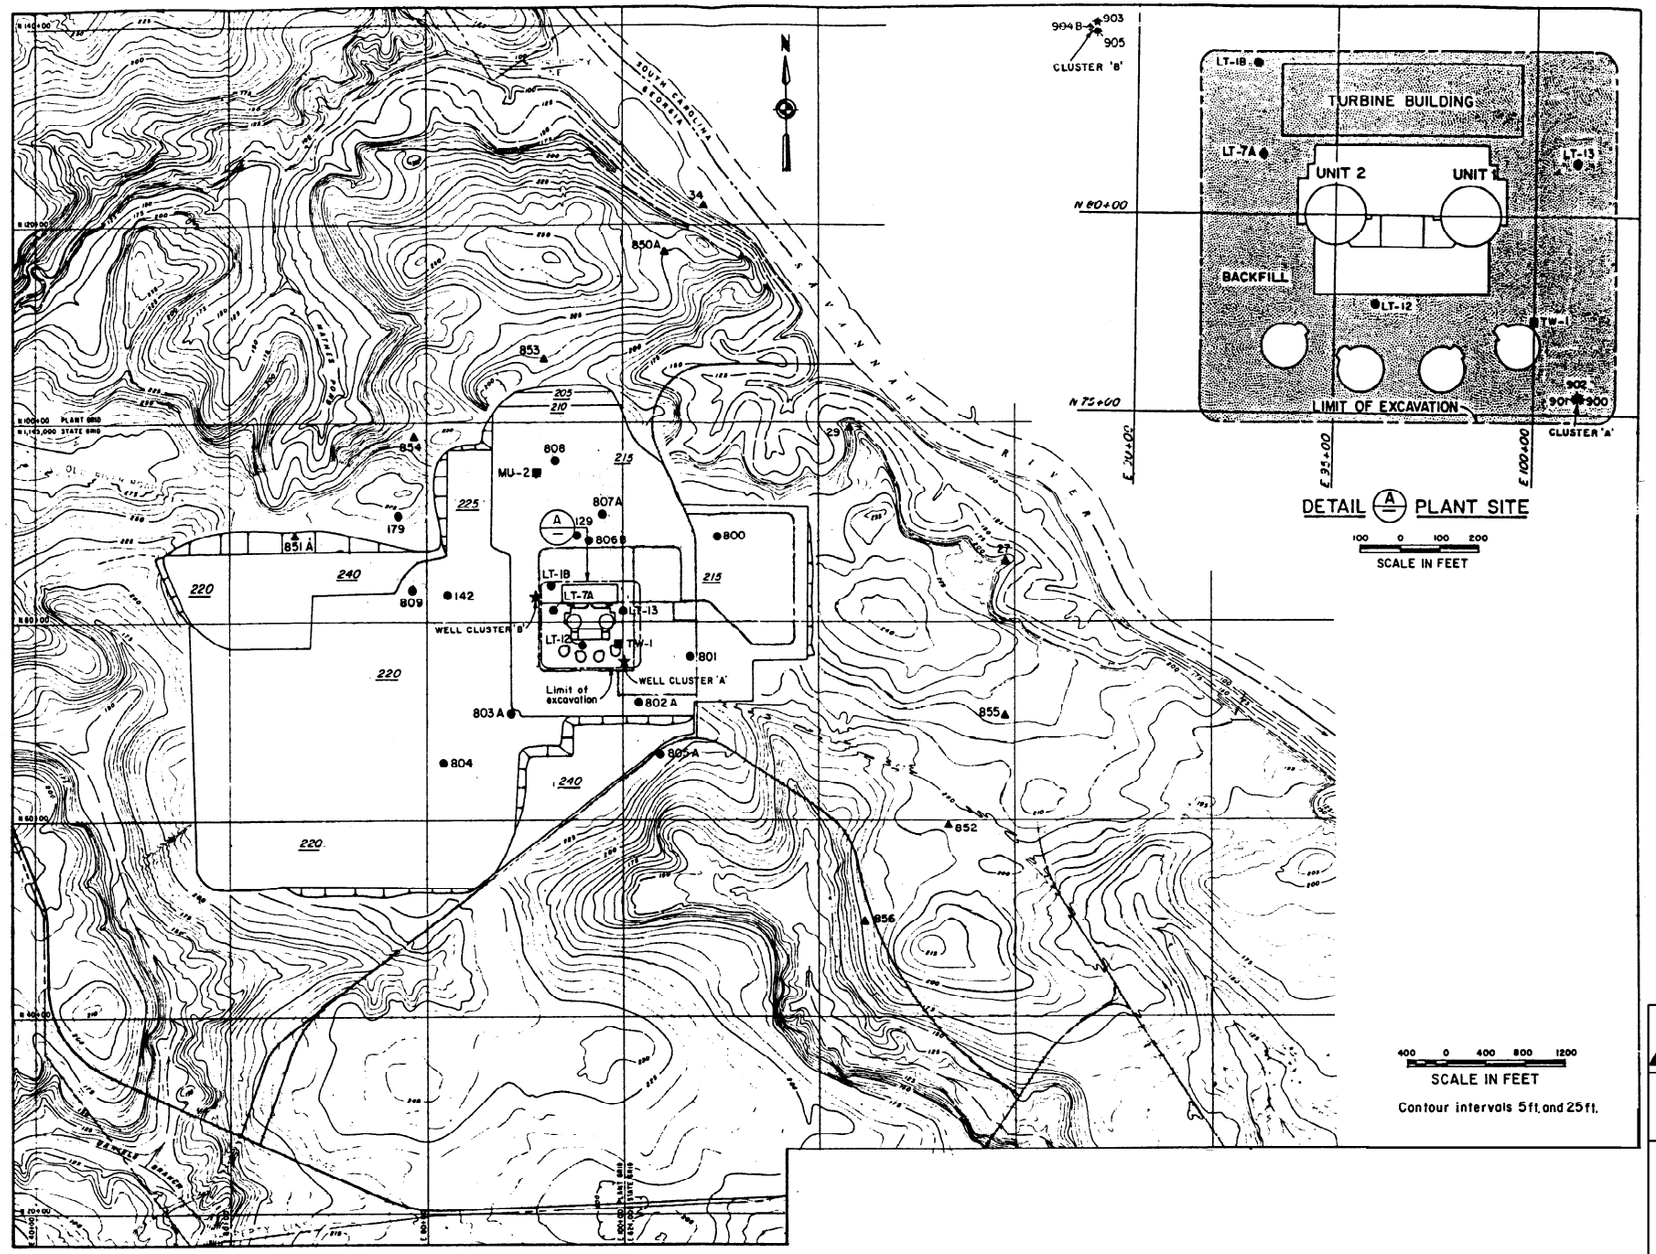

EXPLANATION

- 800● WATER TABLE AQUIFER
- 900✦ MARL
- 855▲ TERTIARY AQUIFER
- MU-2■ CRETACEOUS AQUIFER

NOTES:

THE WELLS SHOWN ARE USED FOR THE GROUND WATER MONITORING PROGRAM INITIATED DURING THE SUMMER OF 1985

SITE GRADING GENERALIZED FROM DWG. NO. CXZD46V003 WITHIN GRADED AREA, APPROXIMATE ELEVATIONS SHOWN UNDERLINED: ***215***

REFERENCE:

HANCOCK LANDING PROJECT TOPOGRAPHIC MAP PREPARED BY CLYDE N. ELDRIDGE AERIAL SURVEYS, FEB. 25/71.

SOUTHERN COMPANY SERVICES, INC.
BIRMINGHAM, ALABAMA

GEORGIA POWER COMPANY
ALVIN W. VOGTLE NUCLEAR PLANT

OBSERVATION WELLS NOVEMBER 1985

NO.	REVISIONS	DATE	DR	CHK	APPV	DTL
0	ISSUED PER REA 96-VAA054	9-30-98	GS	RBH	CBH	WFP

SCALE: NONE | DRAWING NO. AX6DD333 | REV 0

JOB NO. 10604

THIS DOCUMENT CONTAINS PROPRIETARY, CONFIDENTIAL, AND/OR TRADE SECRET INFORMATION OF THE SUBSIDIARIES OF THE SOUTHERN COMPANY OR OF THIRD PARTIES. IT IS INTENDED FOR USE ONLY BY EMPLOYEES OF, OR AUTHORIZED CONTRACTORS OF, THE SUBSIDIARIES OF THE SOUTHERN COMPANY. UNAUTHORIZED POSSESSION, USE, DISTRIBUTION, COPYING, DISSEMINATION, OR DISCLOSURE OF ANY PORTION HEREOF IS PROHIBITED.

CAD NAME AX6DD333 SIZE B 11x17

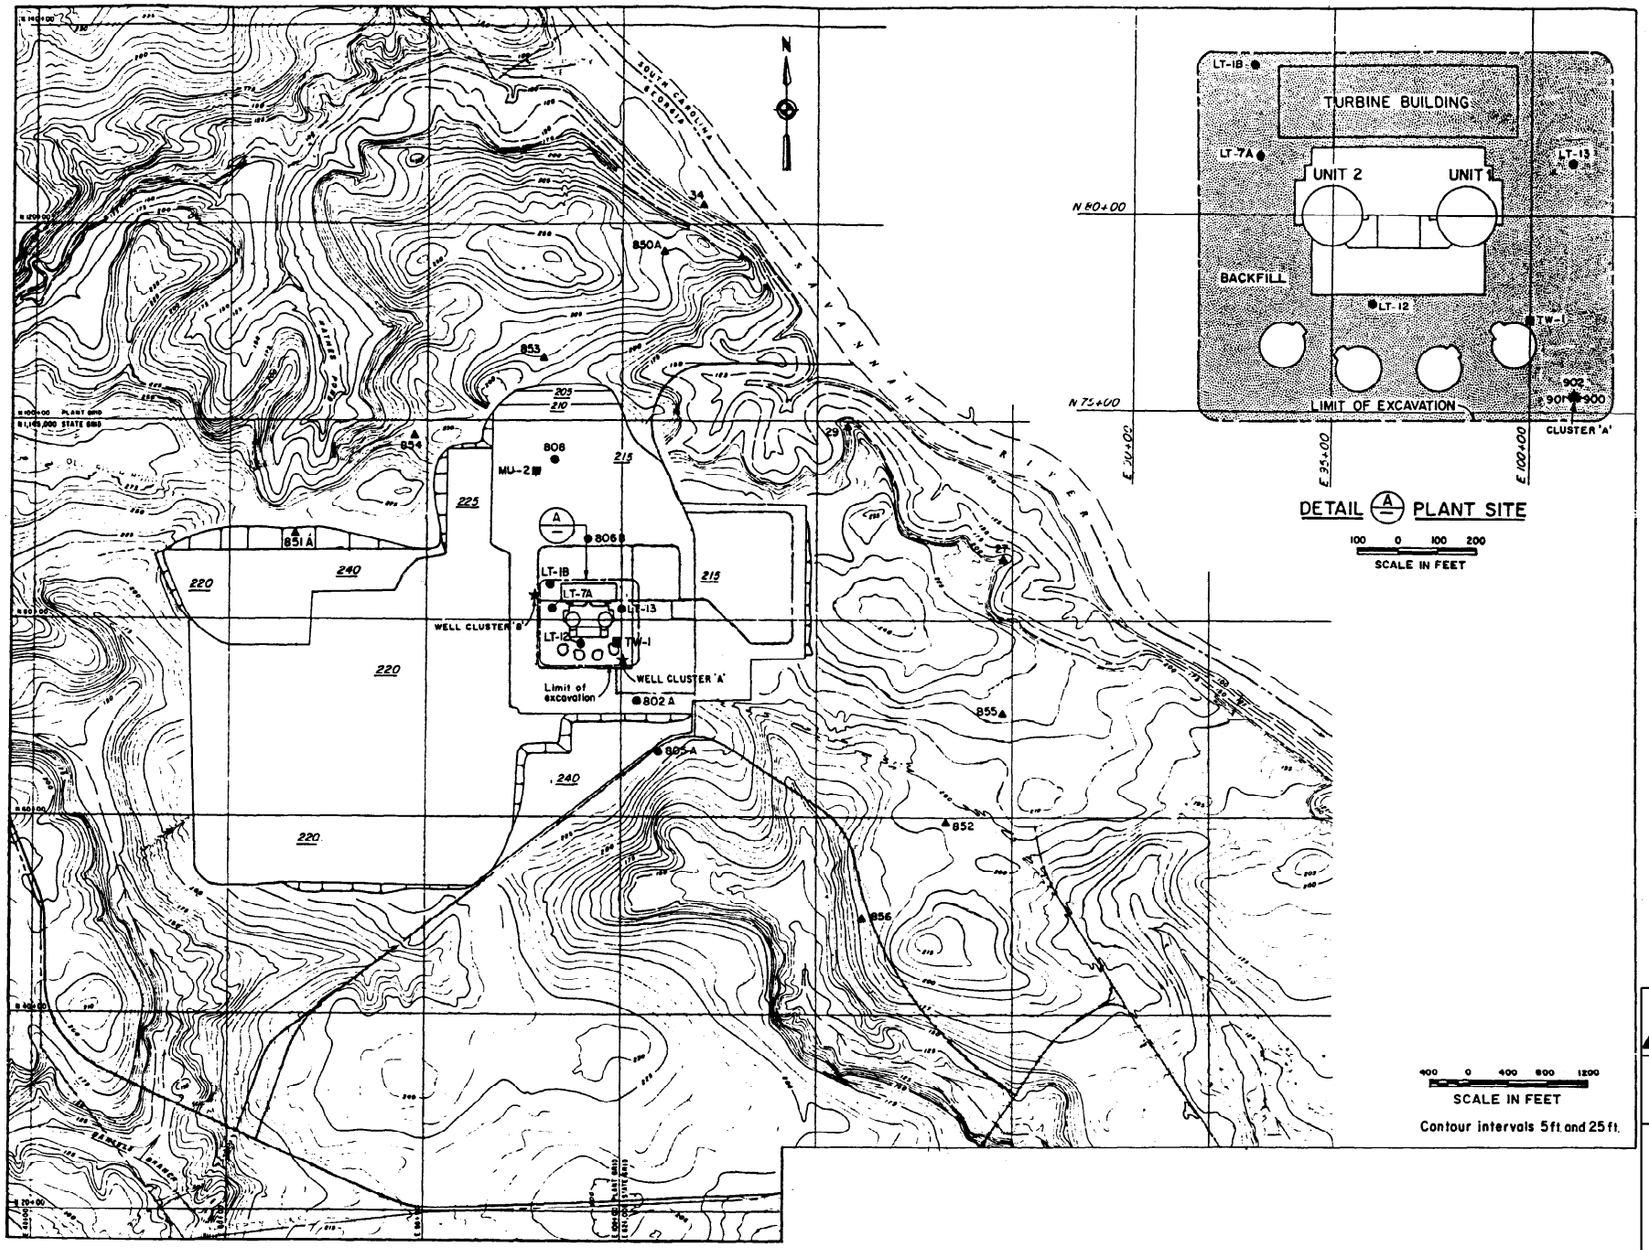

EXPLANATION

- 800● WATER TABLE AQUIFER
- 900◆ MARL
- 855▲ TERTIARY AQUIFER
- MU-2■ CRETACEOUS AQUIFER

NOTES:

THE WELLS SHOWN ARE USED FOR THE GROUND WATER MONITORING PROGRAM INITIATED DURING THE SUMMER OF 1985

SITE GRADING GENERALIZED FROM DWG. NO. CXZD46V003 WITHIN GRADED AREA, APPROXIMATE ELEVATIONS SHOWN UNDERLINED: 215

REFERENCE:

HANCOCK LANDING PROJECT TOPOGRAPHIC MAP PREPARED BY CLYDE N. ELDRIDGE AERIAL SURVEYS, FEB. 25/71.

SOUTHERN COMPANY SERVICES, INC.
BIRMINGHAM, ALABAMA

GEORGIA POWER COMPANY
ALVIN W. VOGTLE NUCLEAR PLANT

OBSERVATION WELLS 1993

NO.	REVISIONS	DATE	DR	CHK	APPV	DTL
0	ISSUED PER REA 96-VAA054	9-30-98	GS	RBH	CBH	WFP

SCALE: NONE

JOB NO. 10604

DRAWING NO. AX6DD334

REV 0

THIS DOCUMENT CONTAINS PROPRIETARY, CONFIDENTIAL, AND/OR TRADE SECRET INFORMATION OF THE SUBSIDIARIES OF THE SOUTHERN COMPANY OR OF THIRD PARTIES. IT IS INTENDED FOR USE ONLY BY EMPLOYEES OF, OR AUTHORIZED CONTRACTORS OF, THE SUBSIDIARIES OF THE SOUTHERN COMPANY. UNAUTHORIZED POSSESSION, USE, DISTRIBUTION, COPYING, DISSEMINATION, OR DISCLOSURE OF ANY PORTION HEREOF IS PROHIBITED.

CAD NAME AX6DD334 SIZE B 11x17

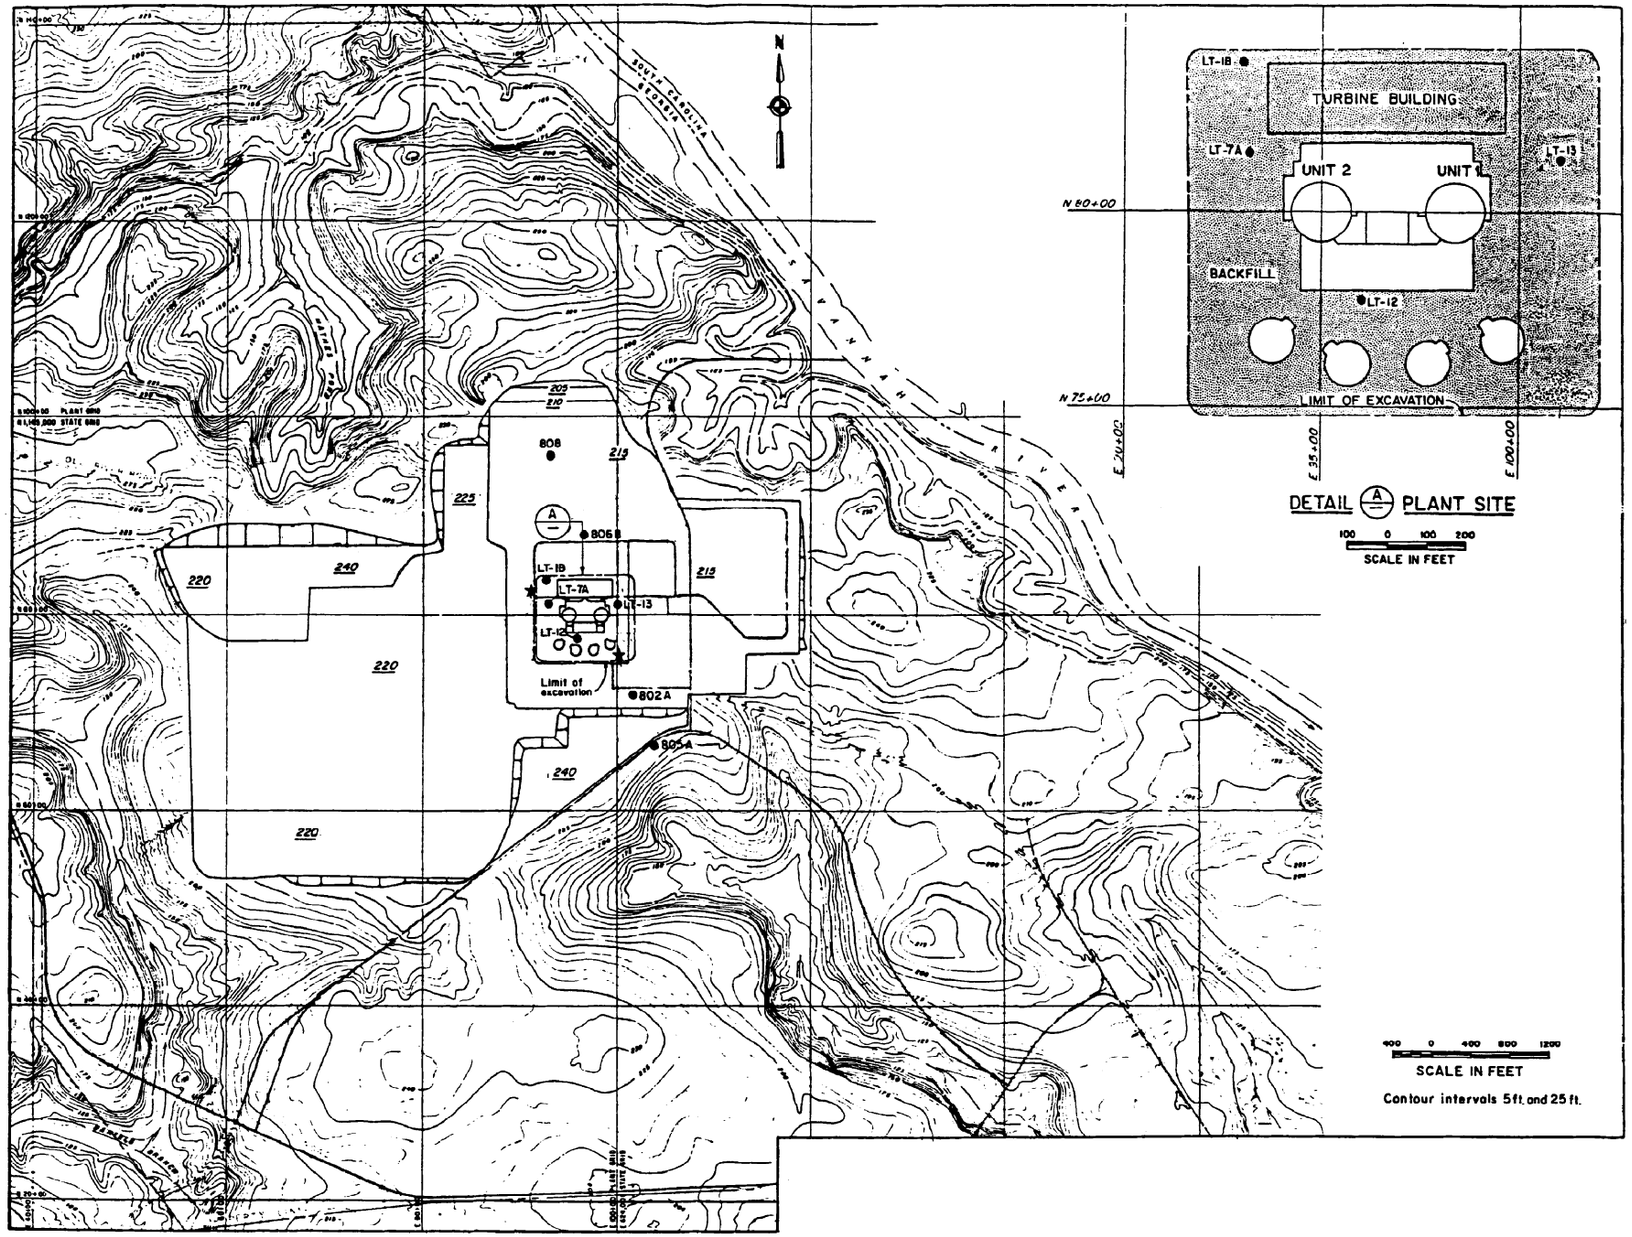

DETAIL (A) PLANT SITE

100 0 100 200
SCALE IN FEET

EXPLANATION

800 • WATER TABLE AQUIFER

NOTES:

THE WELLS SHOWN ARE USED FOR THE GROUND WATER MONITORING PROGRAM INITIATED DURING THE SUMMER OF 1985

SITE GRADING GENERALIZED FROM DWG. NO. CXZD46V003 WITHIN GRADED AREA. APPROXIMATE ELEVATIONS SHOWN UNDERLINED: 215

REFERENCE:

HANCOCK LANDING PROJECT TOPOGRAPHIC MAP PREPARED BY CLYDE N. ELDRIDGE AERIAL SURVEYS, FEB. 25/71.

SOUTHERN COMPANY SERVICES, INC.
BIRMINGHAM, ALABAMA

GEORGIA POWER COMPANY
ALVIN W. VOGTLE NUCLEAR PLANT

OBSERVATION WELLS 1995

NO.	REVISIONS	DATE	DR	CHK	APPV	DTL
0	ISSUED PER REA 96-VAA054	9-30-98	GS	RBH	CBH	WFP

SCALE: NONE

JOB NO. 10604

DRAWING NO. AX6DD335

REV 0

THIS DOCUMENT CONTAINS PROPRIETARY, CONFIDENTIAL, AND/OR TRADE SECRET INFORMATION OF THE SUBSIDIARIES OF THE SOUTHERN COMPANY OR OF THIRD PARTIES. IT IS INTENDED FOR USE ONLY BY EMPLOYEES OF, OR AUTHORIZED CONTRACTORS OF, THE SUBSIDIARIES OF THE SOUTHERN COMPANY. UNAUTHORIZED POSSESSION, USE, DISTRIBUTION, COPYING, DISSEMINATION, OR DISCLOSURE OF ANY PORTION HEREOF IS PROHIBITED.

CAD NAME AX6DD335 SIZE B 11x17

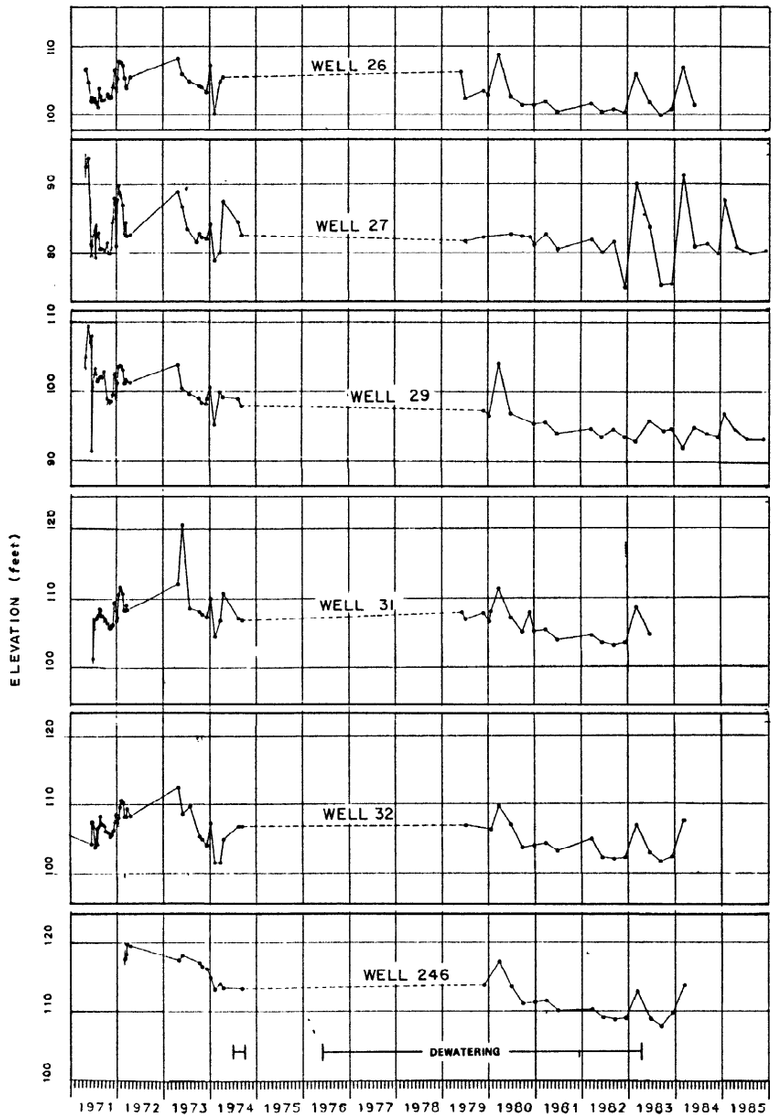

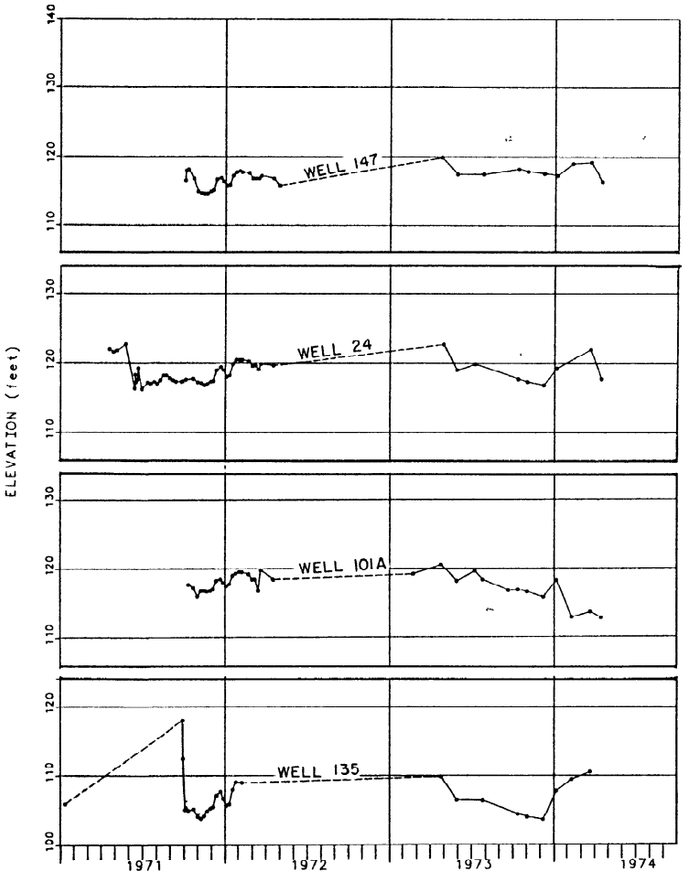

SEE DRAWING AX6DD323 FOR WELL LOCATIONS

TABULATION OF WATER LEVELS WITH NOTES ON MEASUREMENTS AND LEVEL FLUCTUATIONS ARE IN "GROUND WATER SUPPLEMENT", MARCH 1985 (REFERENCE 10).

SOUTHERN COMPANY SERVICES, INC.
BIRMINGHAM, ALABAMA

GEORGIA POWER COMPANY
ALVIN W. VOGTLE NUCLEAR PLANT

WELL HYDROGRAPHS TERTIARY AQUIFER

NO.	REVISIONS	DATE	DR	CHK	APPV	DTL
0	ISSUED PER REA 96-VAA054	9-30-98	GS	RBH	CBH	WFP

SCALE: NONE

JOB NO. 10604

DRAWING NO. AX6DD336

REV 0

THIS DOCUMENT CONTAINS PROPRIETARY, CONFIDENTIAL, AND/OR TRADE SECRET INFORMATION OF THE SUBSIDIARIES OF THE SOUTHERN COMPANY OR OF THIRD PARTIES. IT IS INTENDED FOR USE ONLY BY EMPLOYEES OF, OR AUTHORIZED CONTRACTORS OF, THE SUBSIDIARIES OF THE SOUTHERN COMPANY. UNAUTHORIZED POSSESSION, USE, DISTRIBUTION, COPYING, DISSEMINATION, OR DISCLOSURE OF ANY PORTION HEREOF IS PROHIBITED.

CAD NAME AX6DD336

SIZE B 11x17

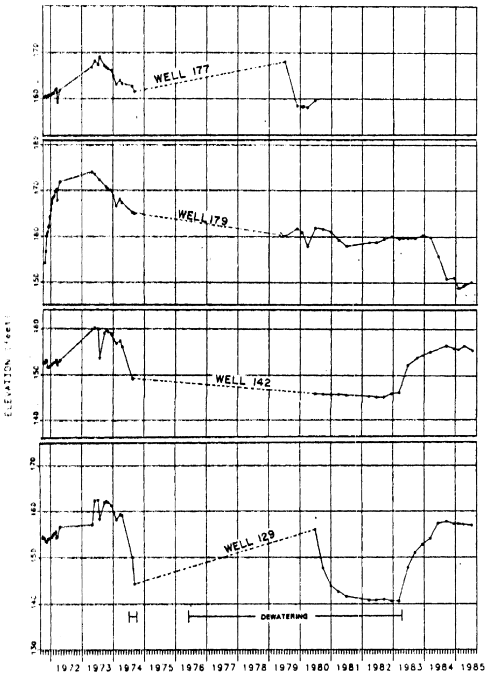

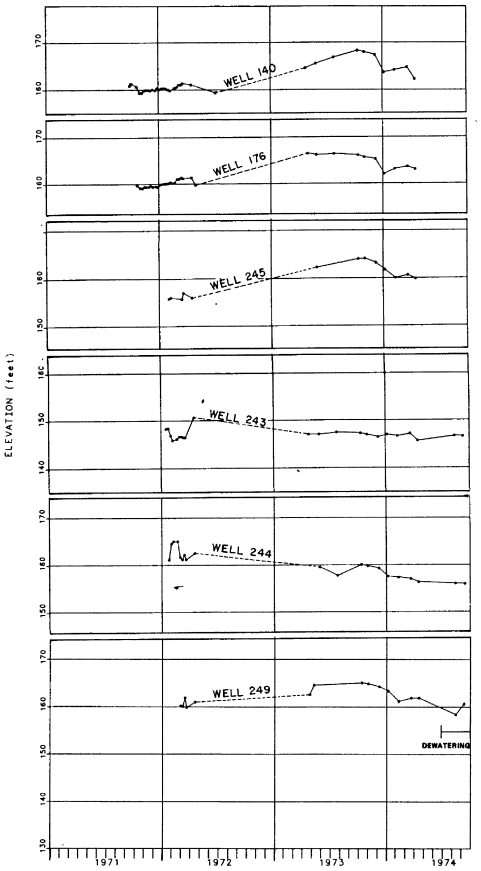

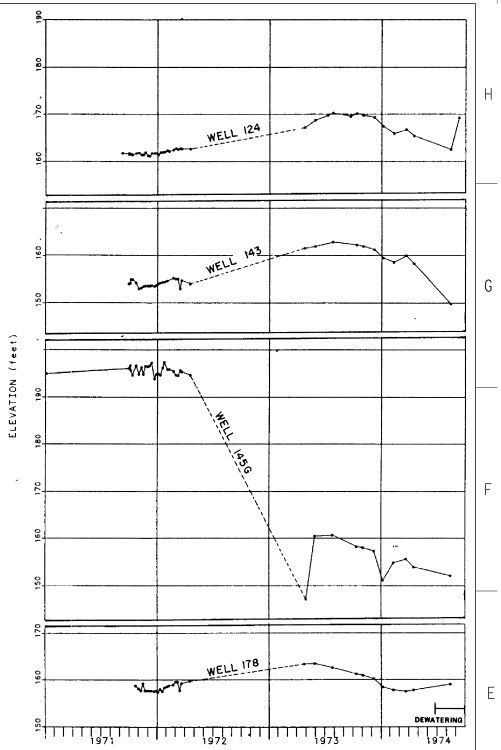

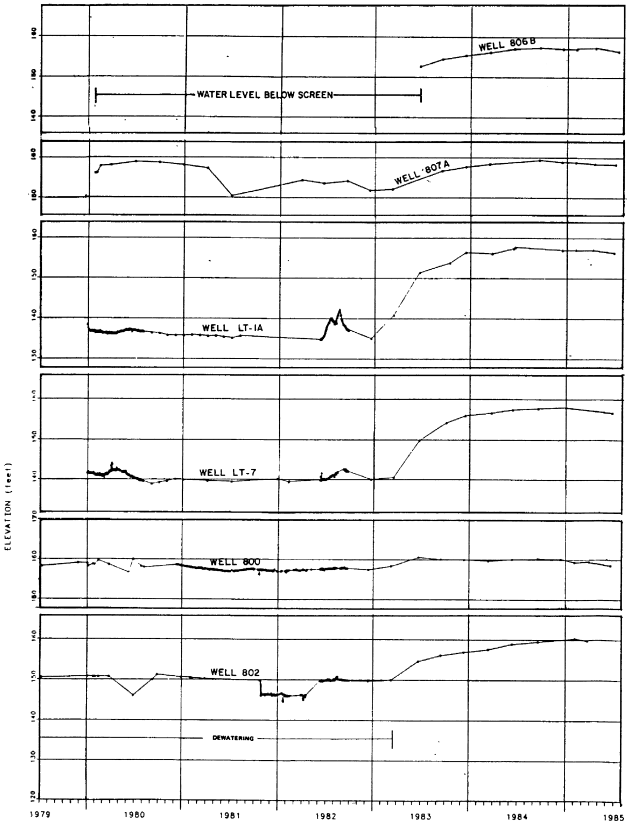

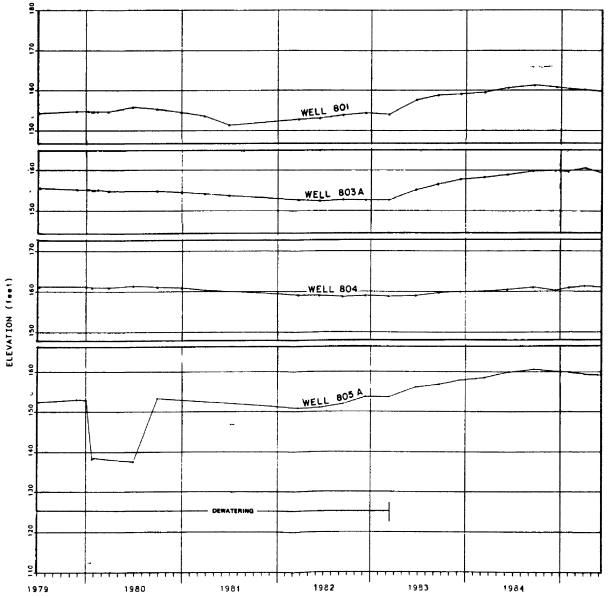

SEE DRAWING AX6DD323 FOR WELL LOCATIONS.

TABULATIONS OF WATER LEVELS WITH NOTES ON MEASUREMENTS AND LEVEL FLUCTUATIONS ARE IN "GROUND WATER SUPPLEMENT", MARCH 1985 (UFSAR SECTION 2.4.12 REFERENCE 10).

SOUTHERN COMPANY SERVICES, INC.
BIRMINGHAM, ALABAMA

GEORGIA POWER COMPANY
ALVIN W. VOGTLE NUCLEAR PLANT

WELL HYDROGRAPHS
WATER TABLE AQUIFER

THIS DOCUMENT CONTAINS PROPRIETARY, CONFIDENTIAL, AND/OR TRADE SECRET INFORMATION OF THE SUBSIDIARIES OF THE SOUTHERN COMPANY OR OF THIRD PARTIES. IT IS INTENDED FOR USE ONLY BY EMPLOYEES OF, OR AUTHORIZED CONTRACTORS OF, THE SUBSIDIARIES OF THE SOUTHERN COMPANY. UNAUTHORIZED POSSESSION, USE, DISTRIBUTION, COPYING, DISSEMINATION, OR DISCLOSURE OF ANY PORTION HEREOF IS PROHIBITED.

NO.	REVISIONS	DATE	DR	CHK	APPV	DTL
4						
3						
2						
1	ISSUED PER REA 96-VAA054	9-30-98	GS	RBH	CBH	WFP

SCALE: NONE
JOB NO.10604
DRAWING NO. AX6DD337
REV. 0
SIZE E 34X44
CAD NAME AX6DD337

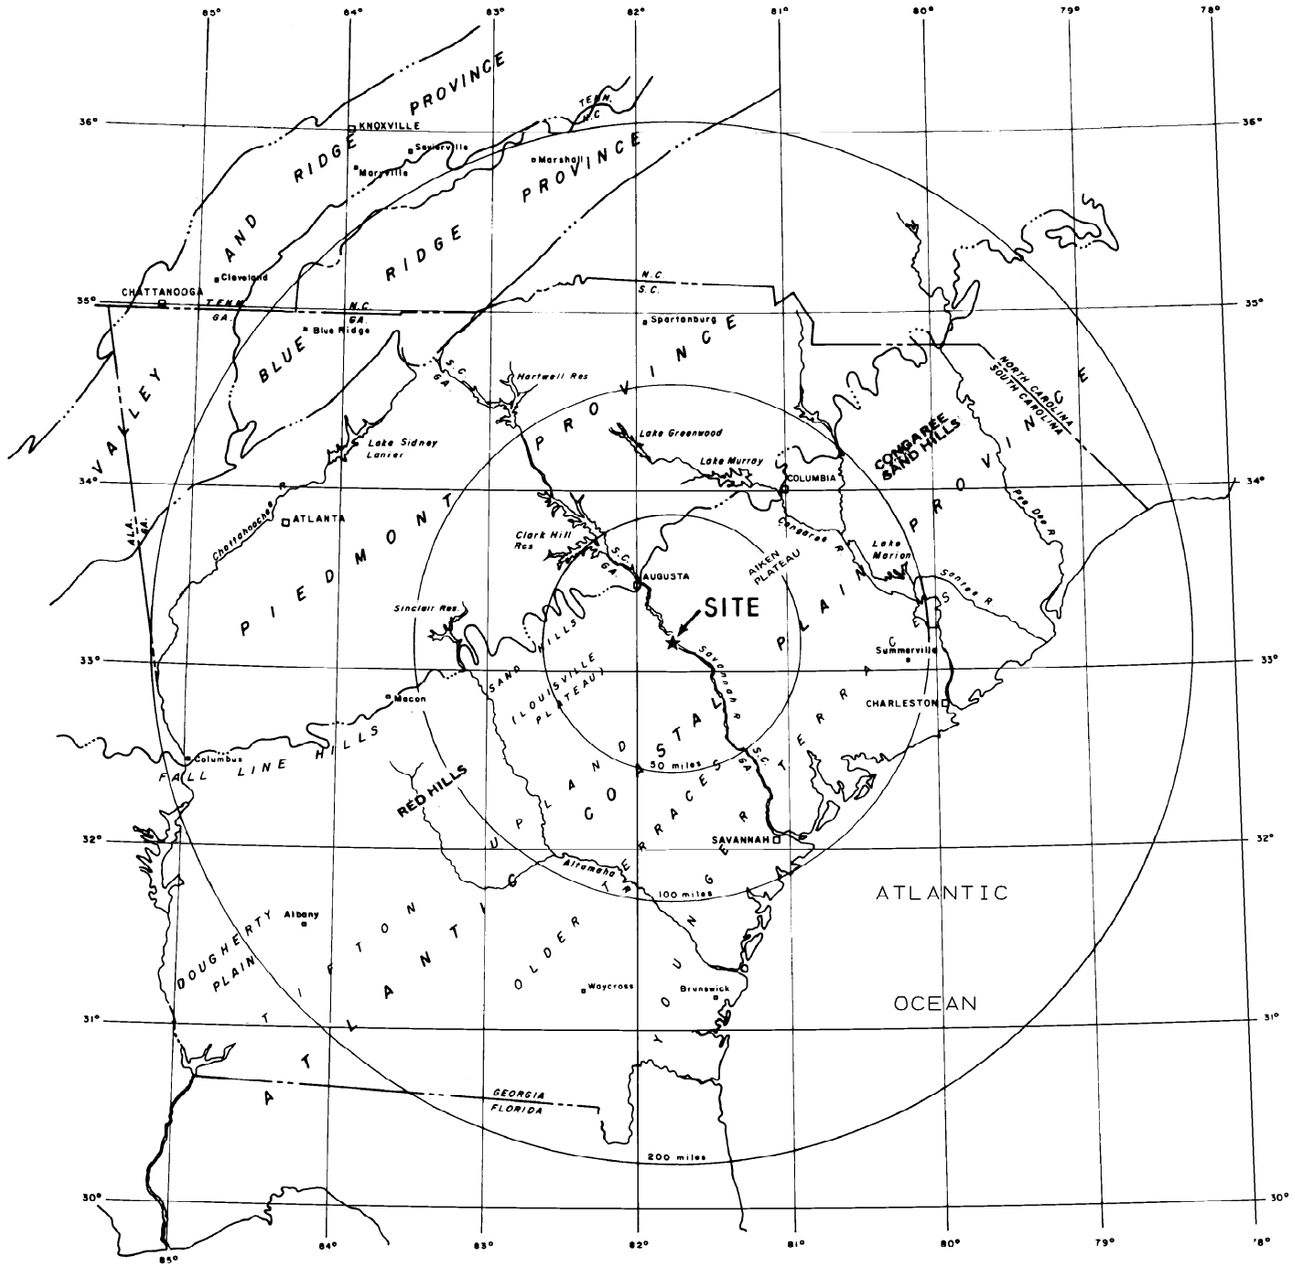

EXPLANATION:

Tectonic Province Boundary

N

10 0 10 20 30 40 50
SCALE IN MILES

REFERENCE

UFSAR SECTION 2.5.1
REFERENCE 1, 58-60

SOUTHERN COMPANY SERVICES, INC.
BIRMINGHAM, ALABAMA

GEORGIA POWER COMPANY
ALVIN W. VOGTLE NUCLEAR PLANT

REGIONAL GENERALIZED PHYSIOGRAPHICAL MAP

NO.	REVISIONS	DATE	DR	CHK	APPV	DTL
△						
0	ISSUED PER REA 96-VAA054	9-30-98	GS	RBH	CBH	WFP

SCALE: NONE

JOB NO. 10604

DRAWING NO. AX6DD338

REV 0

THIS DOCUMENT CONTAINS PROPRIETARY, CONFIDENTIAL, AND/OR TRADE SECRET INFORMATION OF THE SUBSIDIARIES OF THE SOUTHERN COMPANY OR OF THIRD PARTIES. IT IS INTENDED FOR USE ONLY BY EMPLOYEES OF, OR AUTHORIZED CONTRACTORS OF, THE SUBSIDIARIES OF THE SOUTHERN COMPANY. UNAUTHORIZED POSSESSION, USE, DISTRIBUTION, COPYING, DISSEMINATION, OR DISCLOSURE OF ANY PORTION HEREOF IS PROHIBITED.

CAD NAME AX6DD338 SIZE B 11x17

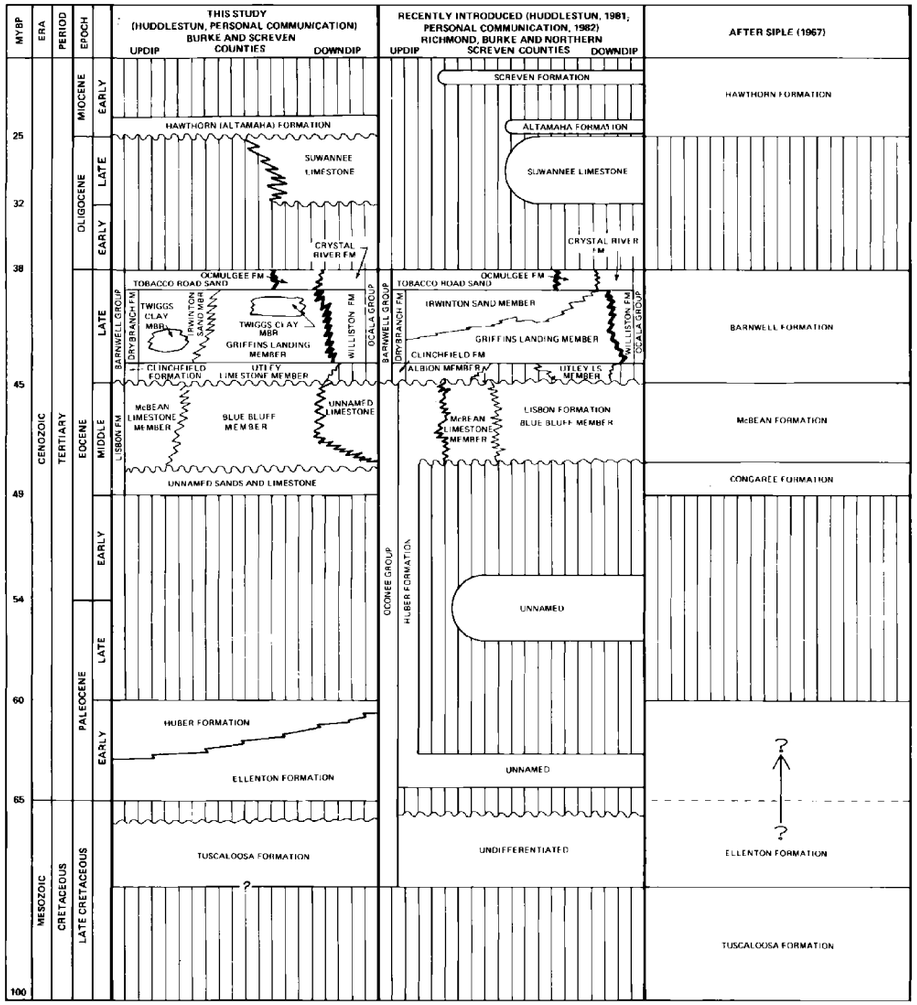

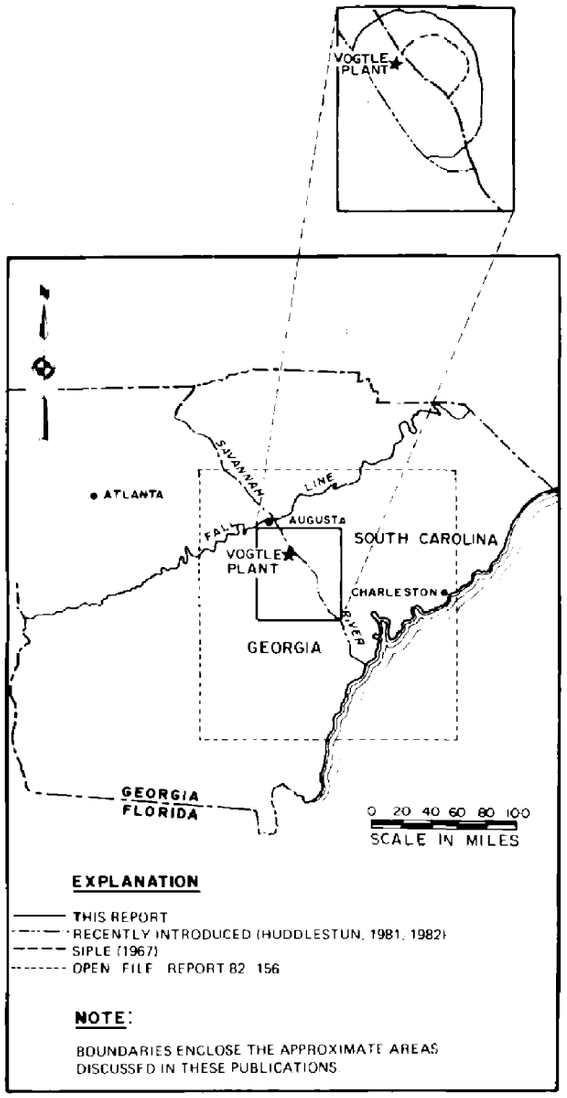

REFERENCES

UFSAR SECTION 2.5.1
REF. 28,34,36,61 AND 62

EXPLANATION

- UNCONFORMITY
- AGE OF FORMATION IN QUESTION AT TIME OF REPORT
- ? ACTUAL AGE OF BOUNDARY IN QUESTION ?
- EROSION OR NON DEPOSITION
- CONTACT BETWEEN MEMBERS
- CONTACT BETWEEN FORMATIONS
- CONTACT BETWEEN GROUPS

SOUTHERN COMPANY SERVICES, INC.
BIRMINGHAM, ALABAMA

GEORGIA POWER COMPANY
ALVIN W. VOGTLE NUCLEAR PLANT

STRATIGRAPHIC CORRELATION CHART

NO.	REVISIONS	DATE	DR	CHK	APPV	DTL
0	ISSUED PER REA 96-VAA054	9-30-98	GS	RBH	CBH	WFP

SCALE: NONE | DRAWING NO. AX6DD339 | REV 0

JOB NO. 10604

THIS DOCUMENT CONTAINS PROPRIETARY, CONFIDENTIAL, AND/OR TRADE SECRET INFORMATION OF THE SUBSIDIARIES OF THE SOUTHERN COMPANY OR OF THIRD PARTIES. IT IS INTENDED FOR USE ONLY BY EMPLOYEES OF, OR AUTHORIZED CONTRACTORS OF, THE SUBSIDIARIES OF THE SOUTHERN COMPANY. UNAUTHORIZED POSSESSION, USE, DISTRIBUTION, COPYING, DISSEMINATION, OR DISCLOSURE OF ANY PORTION HEREOF IS PROHIBITED.

CAD NAME AX6DD339 SIZE B 11x17

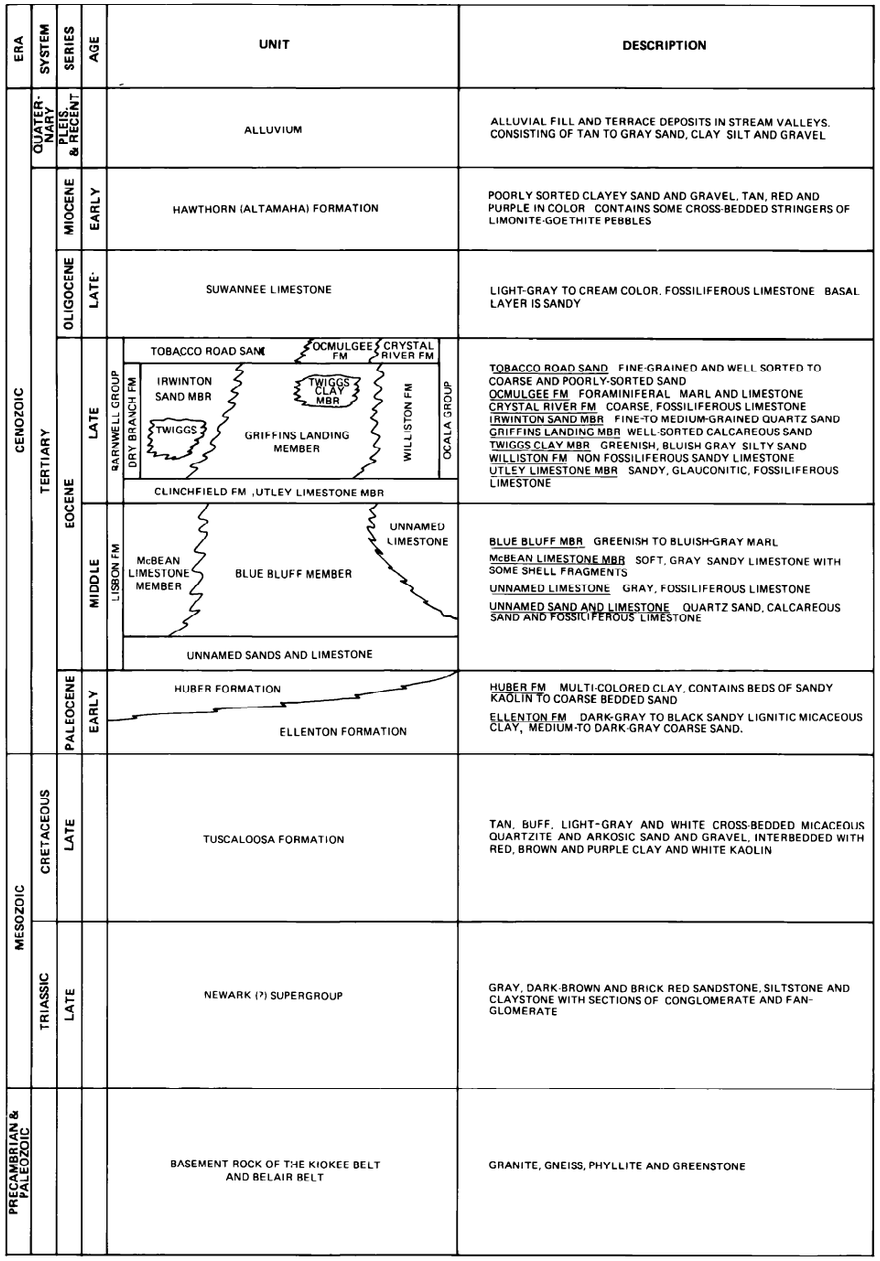

NOTE:

FORMATION AGES ARE GIVEN ON DRAWING AX6DD339 AND IN UFSAR SECTION 2.5.1 TEXT

REFERENCES:

UFSAR SECTION 2.5.1 REF. 6,28,36-39 AND 34

SOUTHERN COMPANY SERVICES, INC.
BIRMINGHAM, ALABAMA

GEORGIA POWER COMPANY
ALVIN W. VOGTLE NUCLEAR PLANT

LITHOLOGIC CHART

NO.	REVISIONS	DATE	DR	CHK	APPV	DTL
0	ISSUED PER REA 96-VAA054	9-30-98	GS	RBH	CBH	WFP

SCALE: NONE | JOB NO. 10604 | DRAWING NO. AX6DD340 | REV 0

THIS DOCUMENT CONTAINS PROPRIETARY, CONFIDENTIAL, AND/OR TRADE SECRET INFORMATION OF THE SUBSIDIARIES OF THE SOUTHERN COMPANY OR OF THIRD PARTIES. IT IS INTENDED FOR USE ONLY BY EMPLOYEES OF, OR AUTHORIZED CONTRACTORS OF, THE SUBSIDIARIES OF THE SOUTHERN COMPANY. UNAUTHORIZED POSSESSION, USE, DISTRIBUTION, COPYING, DISSEMINATION, OR DISCLOSURE OF ANY PORTION HEREOF IS PROHIBITED.

CAD NAME AX6DD340 SIZE B 11x17

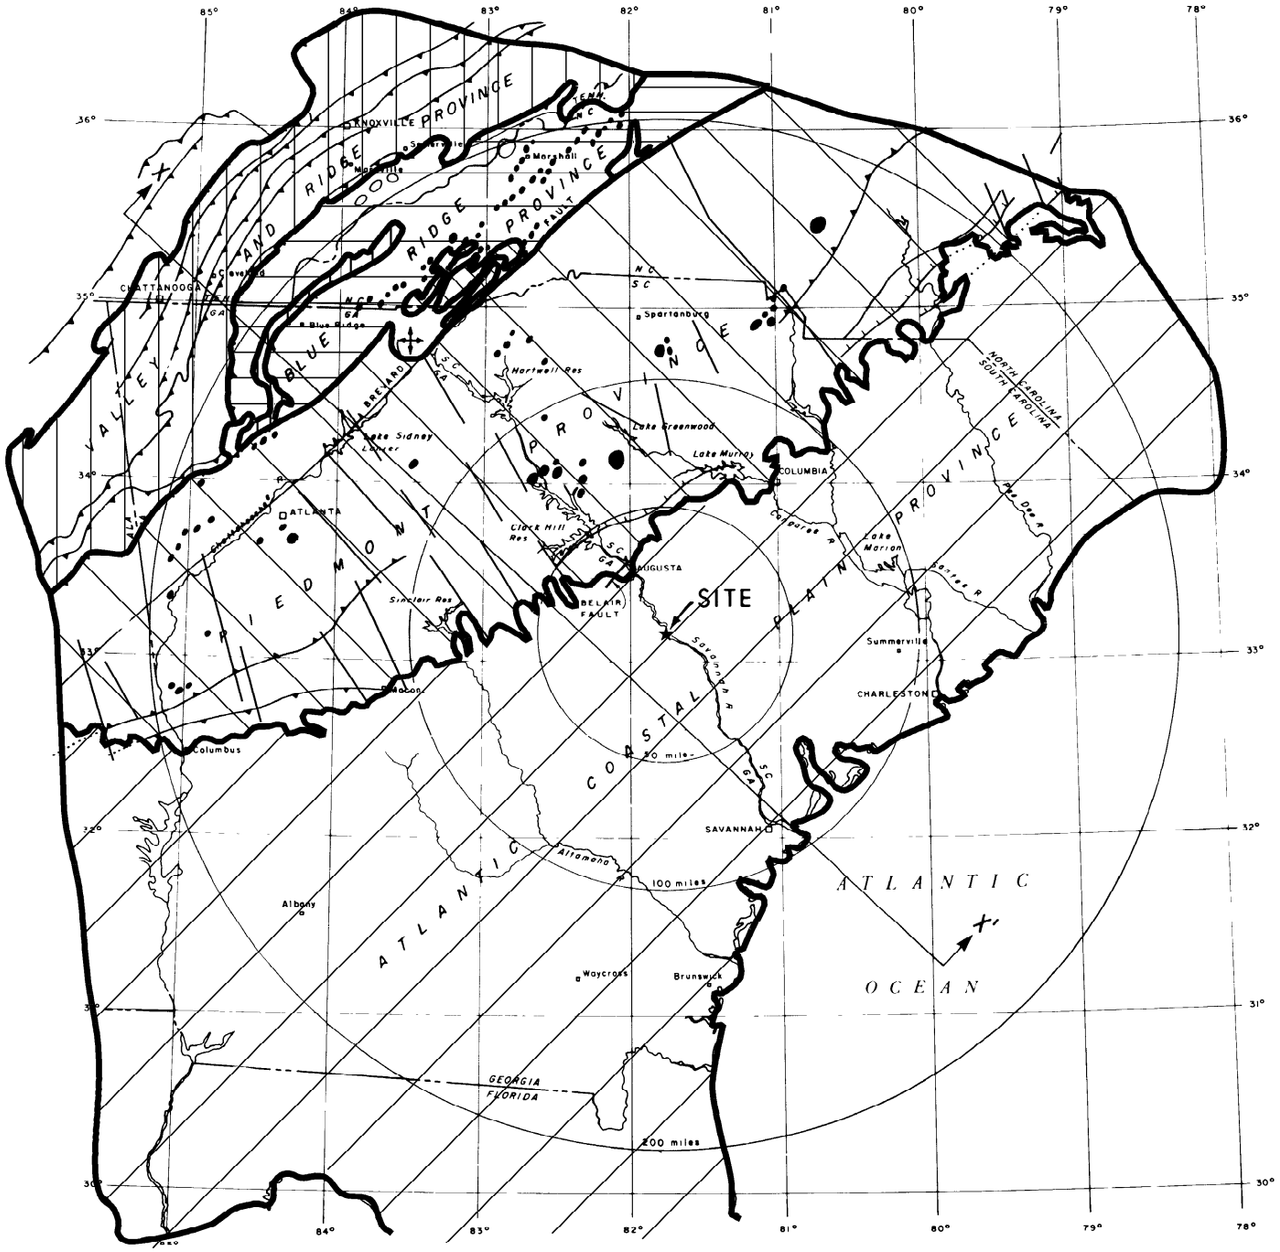

EXPLANATION

- Cross section (X – X')
- Trust fault
- Normal fault (hachures on downthrown side)
- Strike slip fault (dashed where inferred)
- Buried fault
- Dome
- Intrusive diabase dikes
- Ultramafic rocks
- ATLANTIC COASTAL PLAIN PROVINCE — Sedimentary rocks of Mesozoic and Cenozoic ages
- VALLEY AND RIDGE PROVINCE — Chiefly sedimentary rocks of Paleozoic age
- PIEDMONT PROVINCE — Chiefly igneous and metamorphic assemblages of late Precambrian and Paleozoic age includes sedimentary and volcanic rocks of Triassic age
- BLUE RIDGE PROVINCE — Chiefly metamorphic rocks of Precambrian age with some miogeosynclinal deposits of Paleozoic age

REFERENCE

Base map and geology taken from U S G S map compiled by Philip B King, 1977 (59)

N

10 0 10 20 30 40 50
SCALE IN MILES

SOUTHERN COMPANY SERVICES, INC.
BIRMINGHAM, ALABAMA

GEORGIA POWER COMPANY
ALVIN W. VOGTLE NUCLEAR PLANT

REGIONAL GEOLOGIC MAP

NO.	REVISIONS	DATE	DR	CHK	APPV	DTL
0	ISSUED PER REA 96-VAA054	9-30-98	GS	RBH	CBH	WFP

SCALE: NONE | DRAWING NO. AX6DD341 | REV 0

JOB NO. 10604

THIS DOCUMENT CONTAINS PROPRIETARY, CONFIDENTIAL, AND/OR TRADE SECRET INFORMATION OF THE SUBSIDIARIES OF THE SOUTHERN COMPANY OR OF THIRD PARTIES. IT IS INTENDED FOR USE ONLY BY EMPLOYEES OF, OR AUTHORIZED CONTRACTORS OF, THE SUBSIDIARIES OF THE SOUTHERN COMPANY. UNAUTHORIZED POSSESSION, USE, DISTRIBUTION, COPYING, DISSEMINATION, OR DISCLOSURE OF ANY PORTION HEREOF IS PROHIBITED.

CAD NAME AX6DD341 SIZE B 11x17

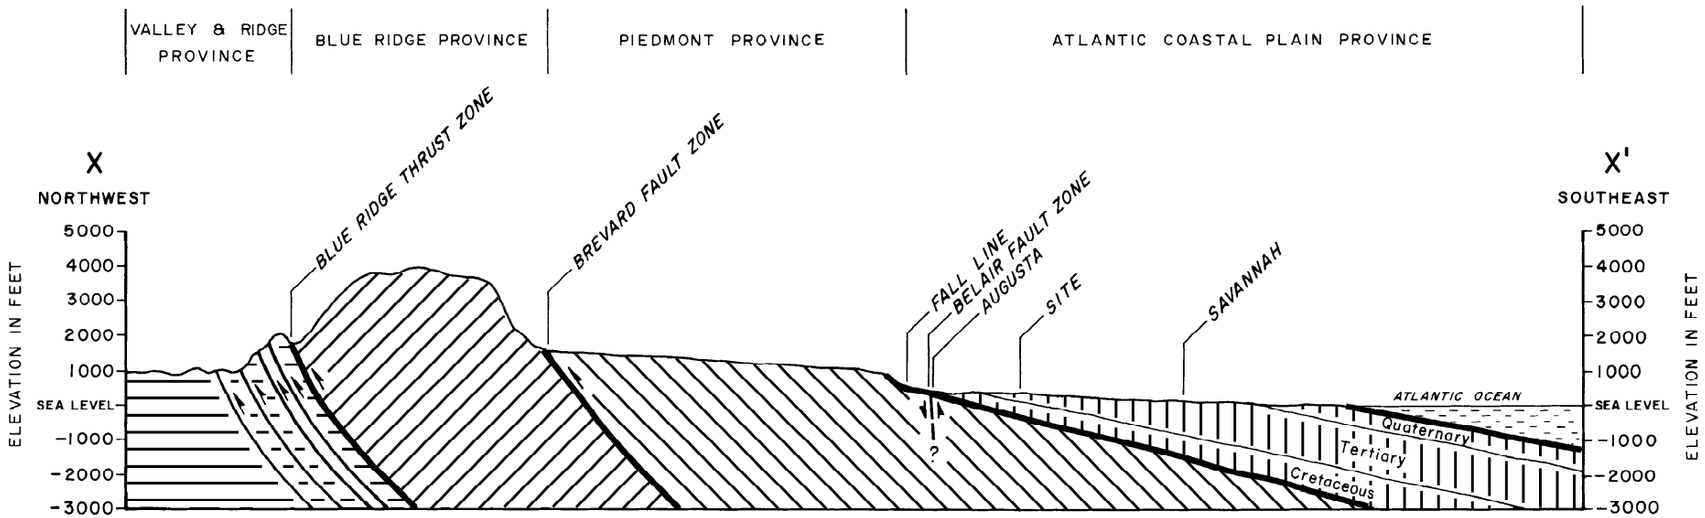

EXPLANATION

ATLANTIC COASTAL PLAIN PROVINCE
Sedimentary rocks of Mesozoic and Cenozoic ages

VALLEY AND RIDGE PROVINCE
Chiefly sedimentary rocks of Paleozoic age

PIEDMONT PROVINCE
Chiefly igneous and metamorphic assemblages of late Precambrian and Paleozoic age; includes sedimentary and volcanic rocks of Triassic age

BLUE RIDGE PROVINCE
Chiefly metamorphic rocks of Precambrian age with some miogeosynclinal deposits of Paleozoic age

NOTE:
For location of geologic section see figure 2.5.1-8

20 0 20 40 60
HORIZONTAL SCALE IN MILES

2000 0 2000 4000 6000
VERTICAL SCALE IN FEET

SOUTHERN COMPANY SERVICES, INC.
BIRMINGHAM, ALABAMA

GEORGIA POWER COMPANY
ALVIN W. VOGTLE NUCLEAR PLANT

GENERALIZED GEOLOGIC SECTION

NO.	REVISIONS	DATE	DR	CHK	APPV	DTL
0	ISSUED PER REA 96-VAA054	9-30-98	GS	RBH	CBH	WFP

SCALE: NONE
JOB NO. 10604
DRAWING NO. AX6DD342
REV 0

THIS DOCUMENT CONTAINS PROPRIETARY, CONFIDENTIAL, AND/OR TRADE SECRET INFORMATION OF THE SUBSIDIARIES OF THE SOUTHERN COMPANY OR OF THIRD PARTIES. IT IS INTENDED FOR USE ONLY BY EMPLOYEES OF, OR AUTHORIZED CONTRACTORS OF, THE SUBSIDIARIES OF THE SOUTHERN COMPANY. UNAUTHORIZED POSSESSION, USE, DISTRIBUTION, COPYING, DISSEMINATION, OR DISCLOSURE OF ANY PORTION HEREOF IS PROHIBITED.

CAD NAME AX6DD342 SIZE B 11x17

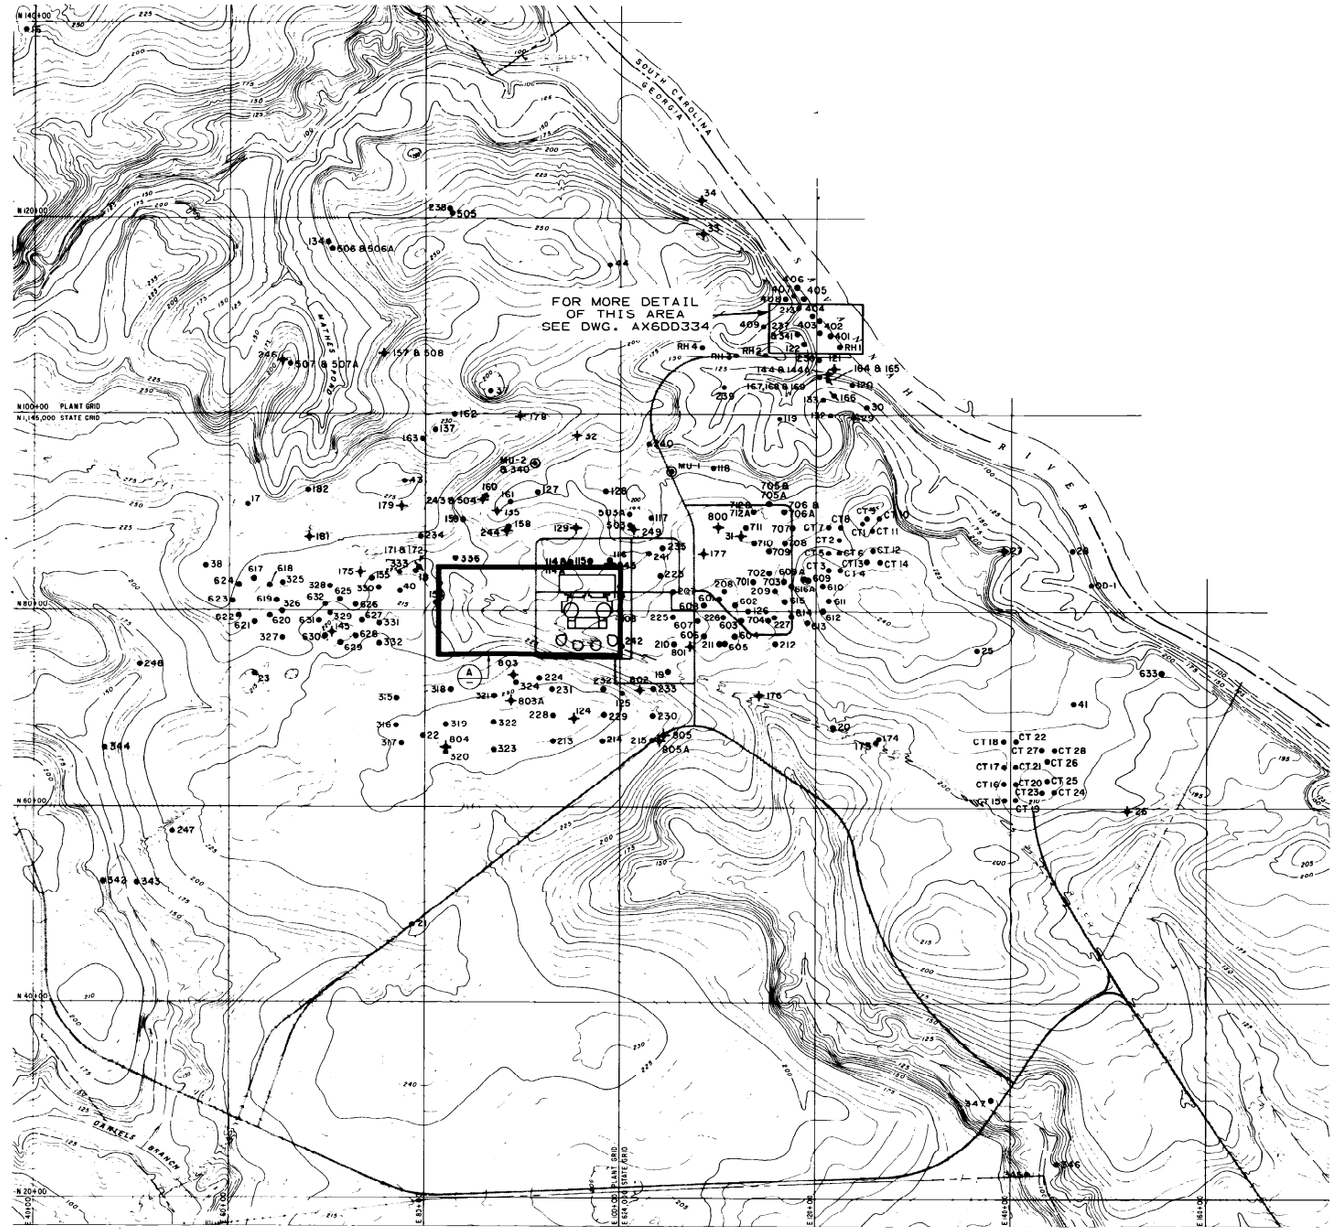

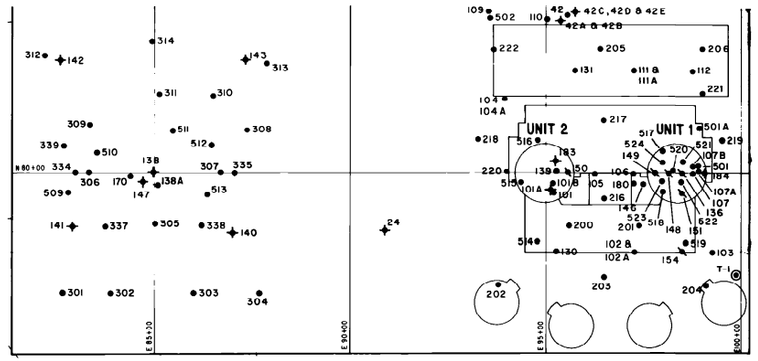

DETAIL (A) PLANT SITE

100 0 100 200
SCALE IN FEET

EXPLANATION

- ●17 Exploration hole
- ✎151 Seismic survey hole
- +31 Ground water observation hole
- ◎T-1 Make-up well

N

REFERENCE:

Hancock Landing Project topographic map prepared by Clyde N. Eldridge Aerial Surveys, Feb 25/71

400 0 400 800 1200
SCALE IN FEET

Contour intervals 5 ft. and 25 ft.

SOUTHERN COMPANY SERVICES, INC.
BIRMINGHAM, ALABAMA

GEORGIA POWER COMPANY
ALVIN W. VOGTLE NUCLEAR PLANT

SITE MAP

NO.	REVISIONS	DATE	DR	CHK	APPV	DTL
△						
0	ISSUED PER REA 96-VAA054	9-30-98	GS	RBH	CBH	WFP

SCALE: NONE

JOB NO. 10604

DRAWING NO. AX6DD343

REV 0

THIS DOCUMENT CONTAINS PROPRIETARY, CONFIDENTIAL, AND/OR TRADE SECRET INFORMATION OF THE SUBSIDIARIES OF THE SOUTHERN COMPANY OR OF THIRD PARTIES. IT IS INTENDED FOR USE ONLY BY EMPLOYEES OF, OR AUTHORIZED CONTRACTORS OF, THE SUBSIDIARIES OF THE SOUTHERN COMPANY. UNAUTHORIZED POSSESSION, USE, DISTRIBUTION, COPYING, DISSEMINATION, OR DISCLOSURE OF ANY PORTION HEREOF IS PROHIBITED.

CAD NAME AX6DD343 SIZE B 11x17

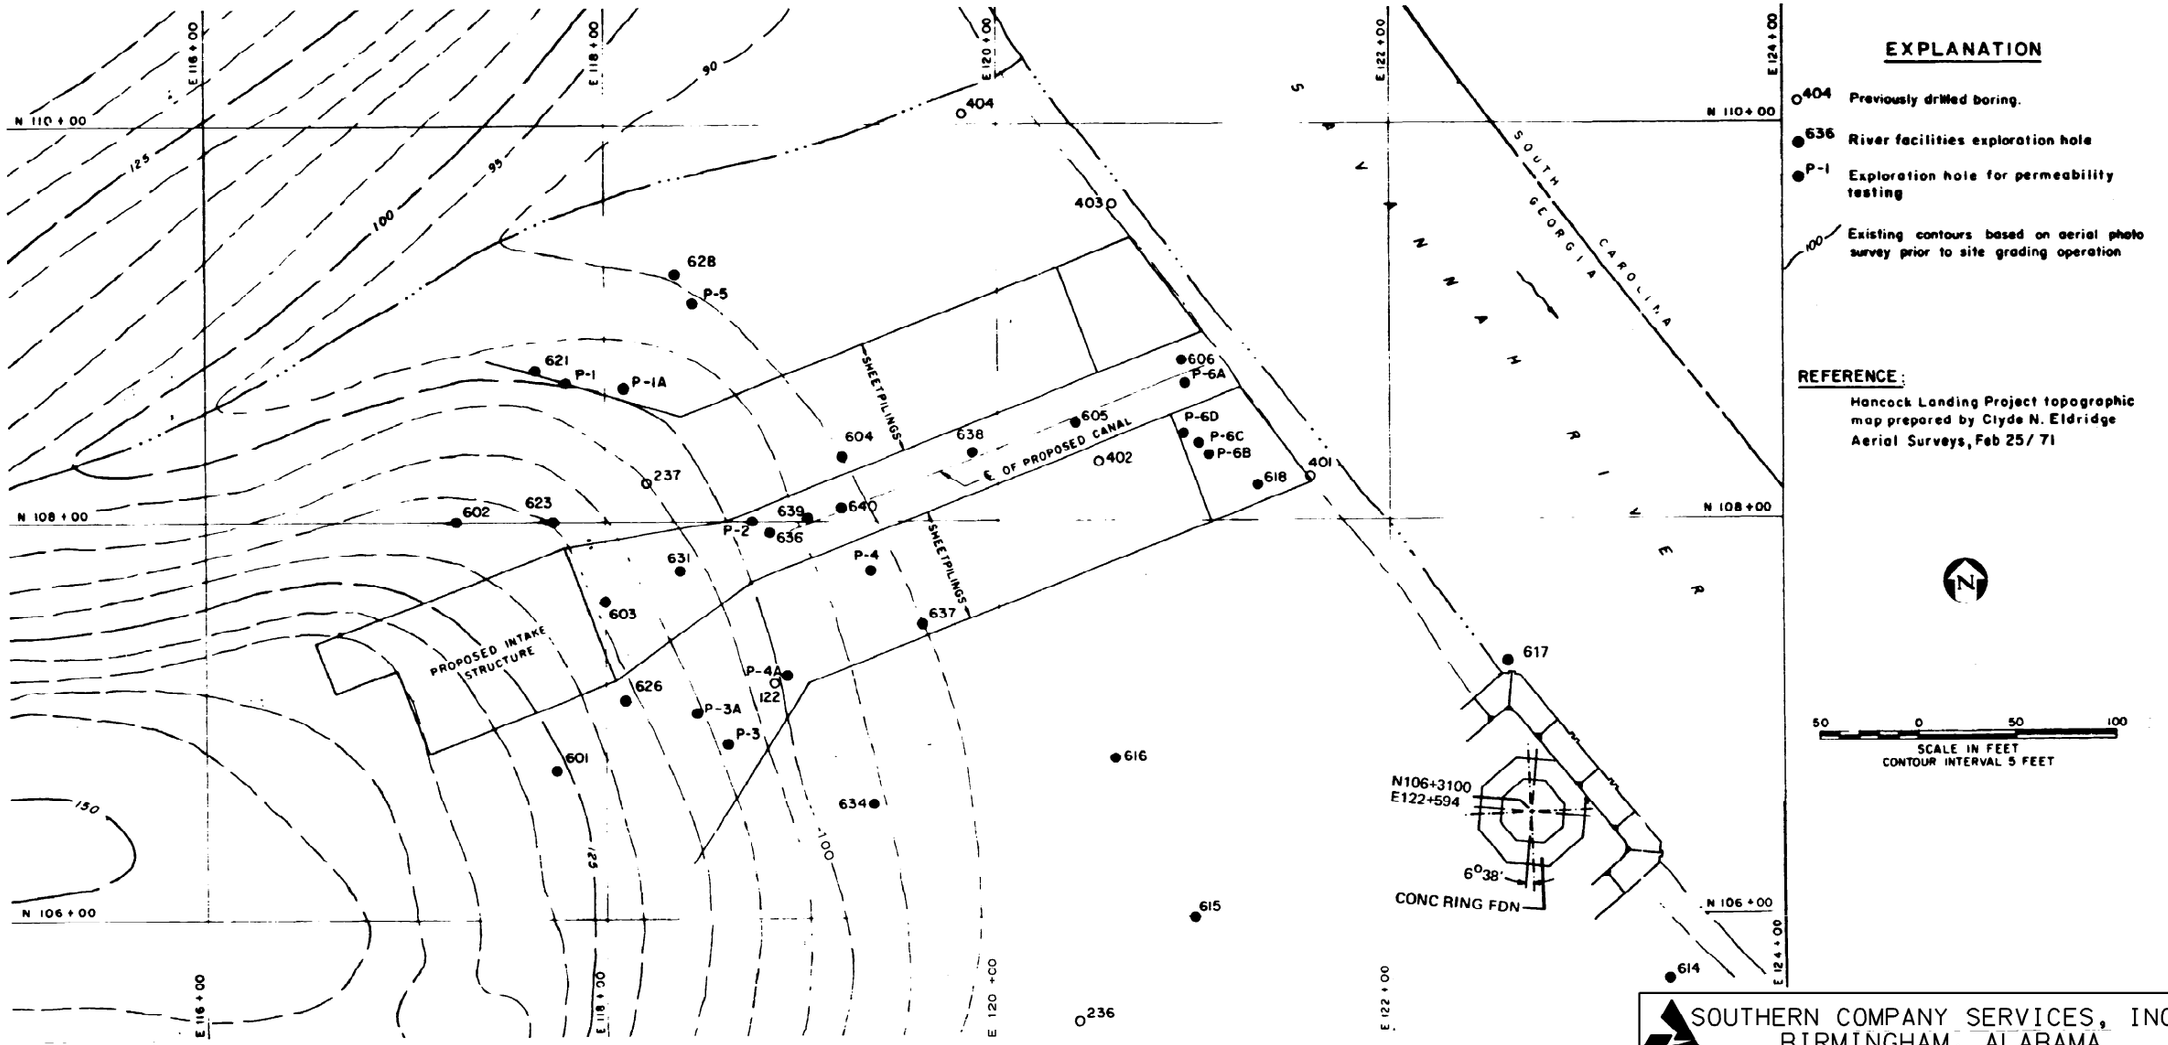

SOUTHERN COMPANY SERVICES, INC.
BIRMINGHAM, ALABAMA

GEORGIA POWER COMPANY
ALVIN W. VOGTLE NUCLEAR PLANT

LOCATION OF TEST HOLES AT RIVER FACILITY

NO.	REVISIONS	DATE	DR	CHK	APPV	DTL
1						
0	ISSUED PER REA 96-VAA054	9-30-98	GS	RBH	CBH	WFP

SCALE: NONE

JOB NO. 10604

DRAWING NO. AX6DD344

REV 0

THIS DOCUMENT CONTAINS PROPRIETARY, CONFIDENTIAL, AND/OR TRADE SECRET INFORMATION OF THE SUBSIDIARIES OF THE SOUTHERN COMPANY OR OF THIRD PARTIES. IT IS INTENDED FOR USE ONLY BY EMPLOYEES OF, OR AUTHORIZED CONTRACTORS OF, THE SUBSIDIARIES OF THE SOUTHERN COMPANY. UNAUTHORIZED POSSESSION, USE, DISTRIBUTION, COPYING, DISSEMINATION, OR DISCLOSURE OF ANY PORTION HEREOF IS PROHIBITED.

CAD NAME AX6DD344

SIZE B 11x17

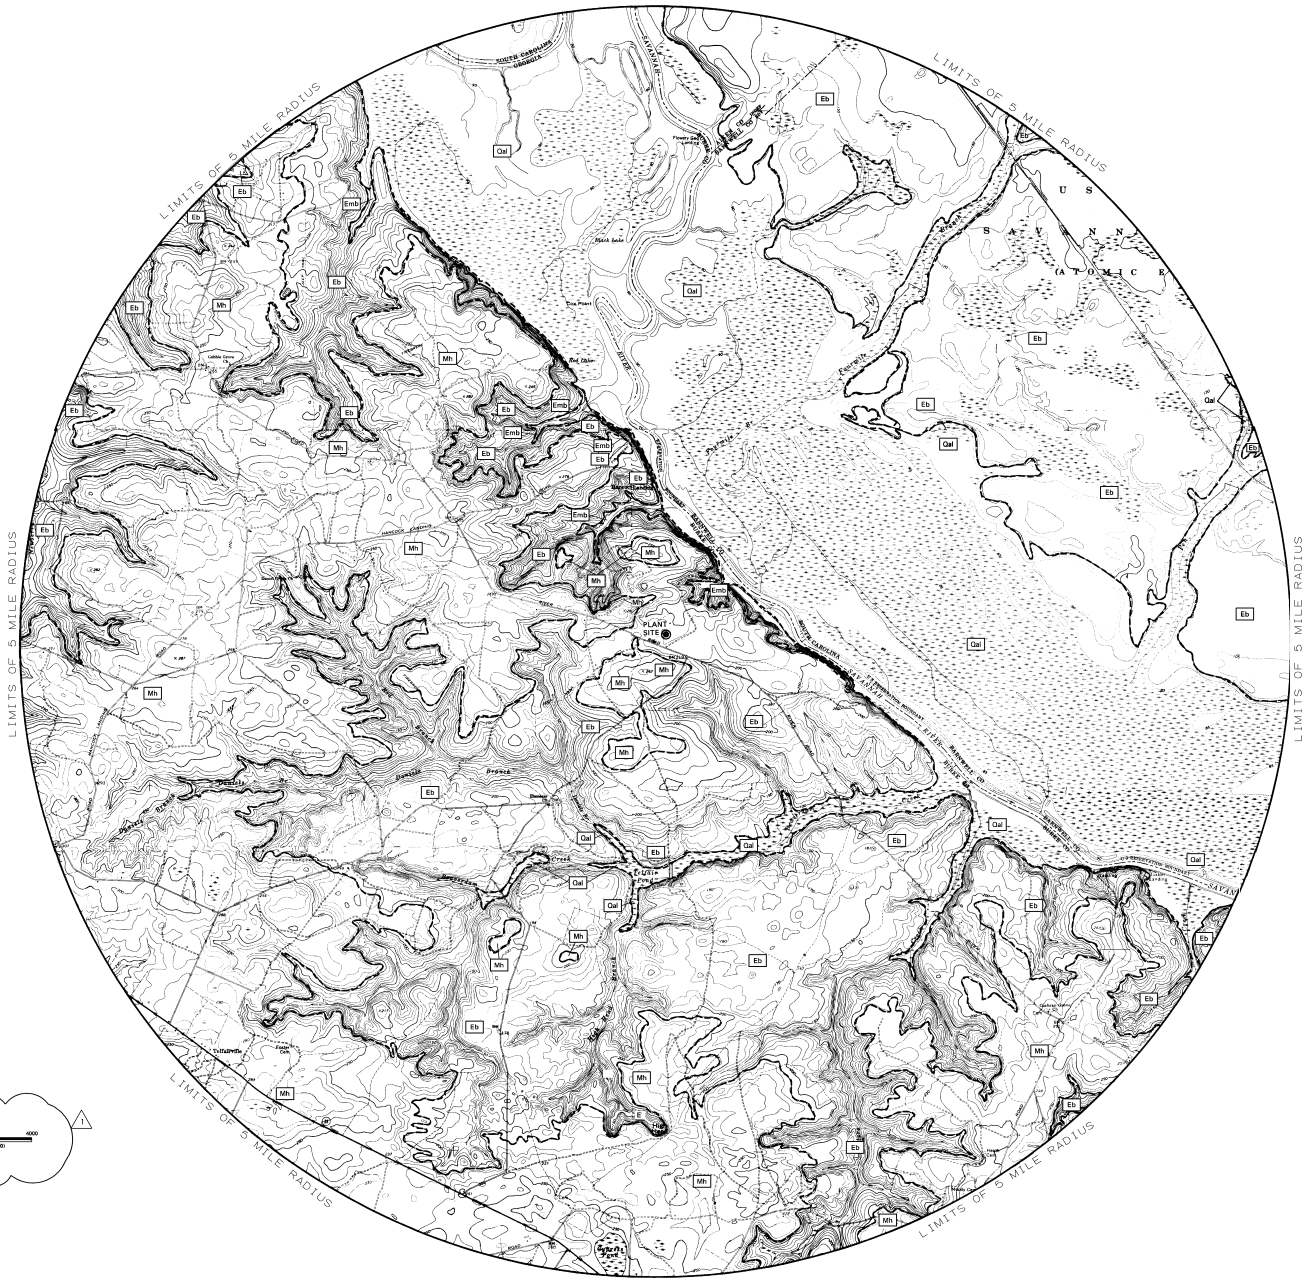

EXPLANATION

Qal	QUATERNARY ALLUVIUM; SILTS, SANDS, AND STREAM GRAVEL.
Mh	HAWTHORN FORMATION; TAN, RED, YELLOW, AND PURPLE SANDY CLAY, SAND AND INTERBEDDED LENSES OF GRAVEL.
Eb	BARNWELL GROUP; RED, BROWN, YELLOW AND WHITE SAND AND SANDY CLAY, WITH GRAY CLAYSTONE AND BASAL LIMESTONE
Emb	LISBON FORMATION; GREENISH-GRAY TO GRAY FOSSILIFEROUS MARL AND INTERCALATED LIMESTONE UNDERLAIN BY GLAUCONITIC QUARZOSE SAND

GEOLOGIC CONTACT, APPROXIMATE OR CONCEALED

SOUTHERN COMPANY SERVICES, INC.
BIRMINGHAM, ALABAMA

GEORGIA POWER COMPANY
ALVIN W. VOGTLE NUCLEAR PLANT

LOCAL GEOLOGIC MAP

SCALE: NONE

DRAWING NO. AX6DD345 REV. 1

JOB NO.10604

SIZE E 34X44

CAD NAME AX6DD345

THIS DOCUMENT CONTAINS PROPRIETARY, CONFIDENTIAL, AND/OR TRADE SECRET INFORMATION OF THE SUBSIDIARIES OF THE SOUTHERN COMPANY OR OF THIRD PARTIES. IT IS INTENDED FOR USE ONLY BY EMPLOYEES OF, OR AUTHORIZED CONTRACTORS OF, THE SUBSIDIARIES OF THE SOUTHERN COMPANY. UNAUTHORIZED POSSESSION, USE, DISTRIBUTION, COPYING, DISSEMINATION, OR DISCLOSURE OF ANY PORTION HEREOF IS PROHIBITED.

NO.	REVISIONS	DATE	DR	CHK	APPV	DTL
2	REVISED PER REA 96-VAA054	10-20-98	GS	RBH	WFP	
1	ISSUED PER REA 96-VAA054	SEE MICROFILM FOR SIGNATURES				

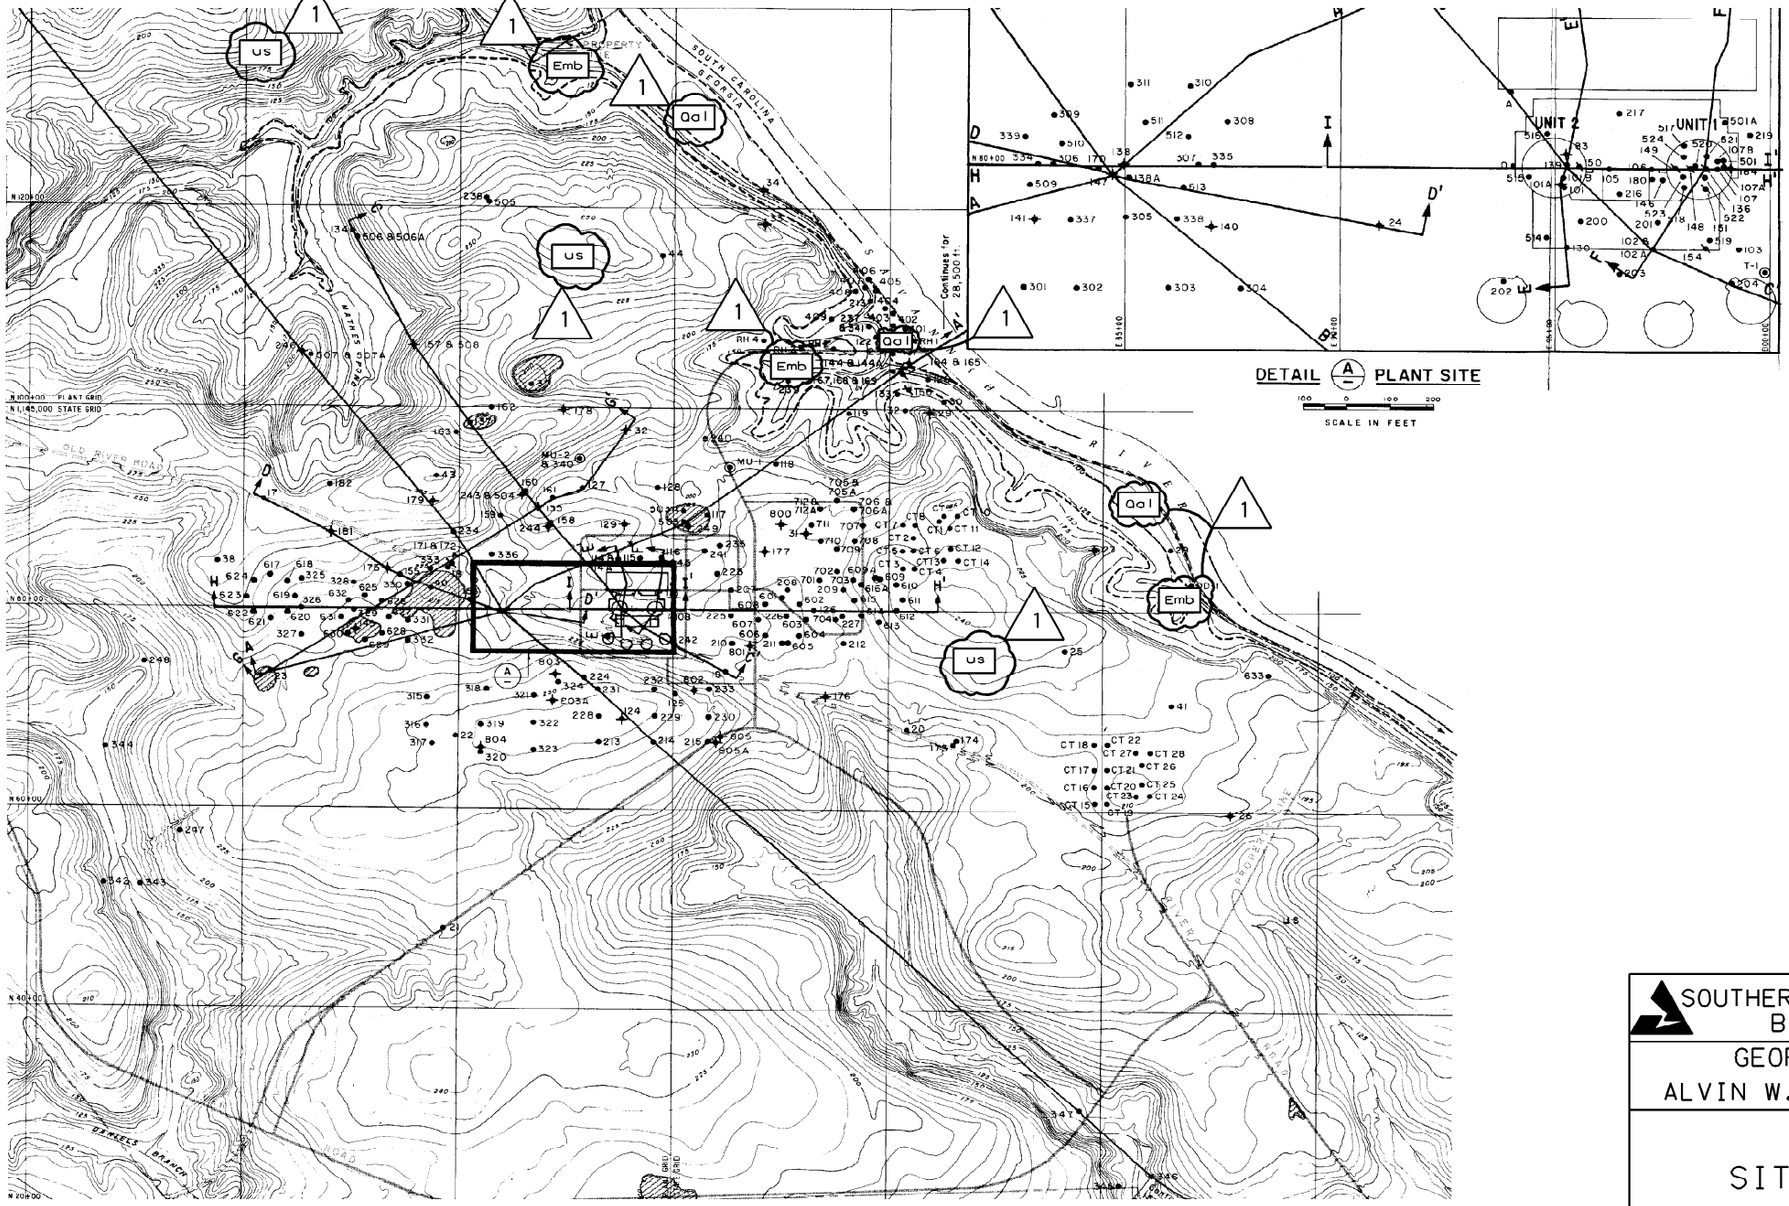

DETAIL (A) PLANT SITE

SCALE IN FEET

EXPLANATION

- 17 Exploration hole
- 151 Seismic survey hole
- 31 Ground water observation hole
- T-1 Make-up well
- Qal Recent alluvium
- US UPPER SANDS: Undifferentiated, unconsolidated, red-brown, yellow, silty sand. Occasionally typified by many clay seams, loose sands and shell deposits. (Hawthorne Formation and Barnwell Group)
- Emb BEARING UNIT: (Blue Bluff Marl) Hard gray-green true marl, fossiliferous and concretionary
- Geologic contact, approximated
- A A' Geologic section
- Surface depression

N

REFERENCE:

Hancock Landing Project topographic map prepared by Clyce N. Eldridge Aerial Surveys, Feb 25/71

400 0 400 800 1200

SCALE IN FEET

Contour intervals 5 ft. and 25 ft.

SOUTHERN COMPANY SERVICES, INC.
BIRMINGHAM, ALABAMA

GEORGIA POWER COMPANY
ALVIN W. VOGTLE NUCLEAR PLANT

SITE GEOLOGIC MAP

NO.	REVISIONS	DATE	DR	CHK	APPV	DTL
1	REVISED PER REA 96-VAA054	10-20-98	GS	RBH	WFP	
0	ISSUED PER REA 96-VAA054	SEE MICROFILM FOR SIGNATURES				

SCALE: NONE

JOB NO. 10604

DRAWING NO. AX6DD351

REV 1

THIS DOCUMENT CONTAINS PROPRIETARY, CONFIDENTIAL, AND/OR TRADE SECRET INFORMATION OF THE SUBSIDIARIES OF THE SOUTHERN COMPANY OR OF THIRD PARTIES. IT IS INTENDED FOR USE ONLY BY EMPLOYEES OF, OR AUTHORIZED CONTRACTORS OF, THE SUBSIDIARIES OF THE SOUTHERN COMPANY. UNAUTHORIZED POSSESSION, USE, DISTRIBUTION, COPYING, DISSEMINATION, OR DISCLOSURE OF ANY PORTION HEREOF IS PROHIBITED.

CAD NAME AX6DD351 SIZE B 11x17

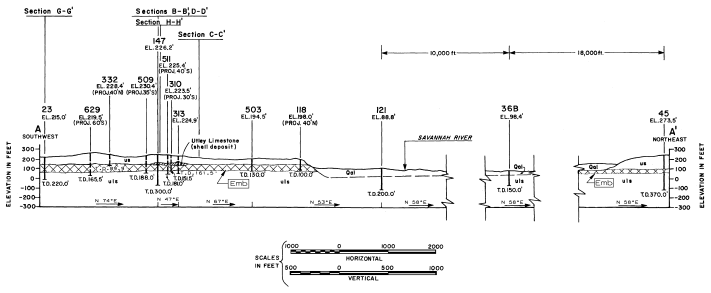

GEOLOGIC SECTION A-A

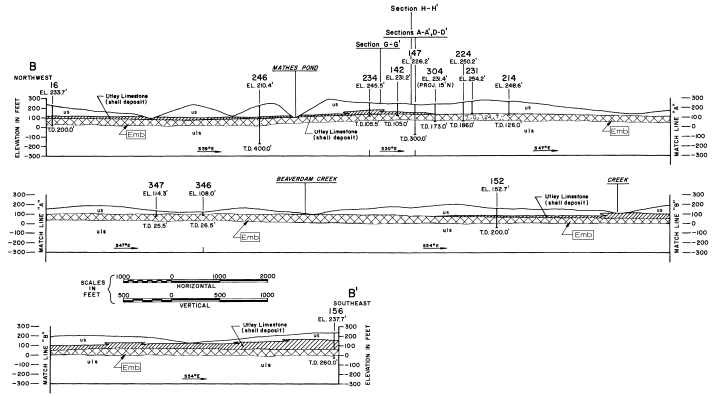

GEOLOGIC SECTION B-B

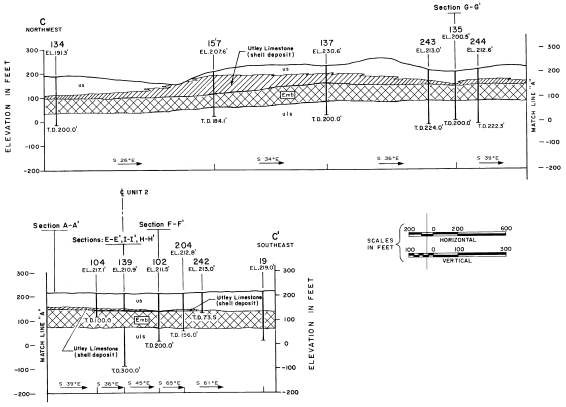

GEOLOGIC SECTION C-C

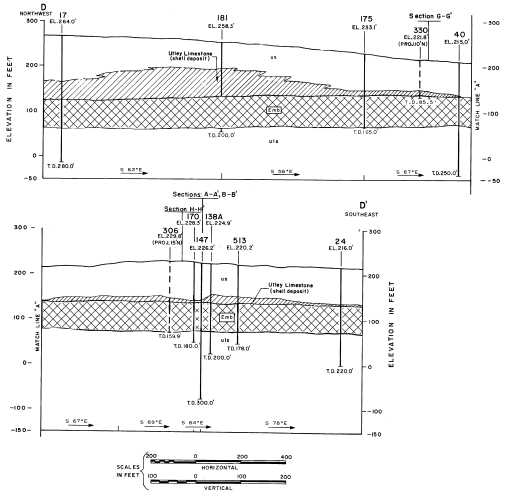

GEOLOGIC SECTION D-D

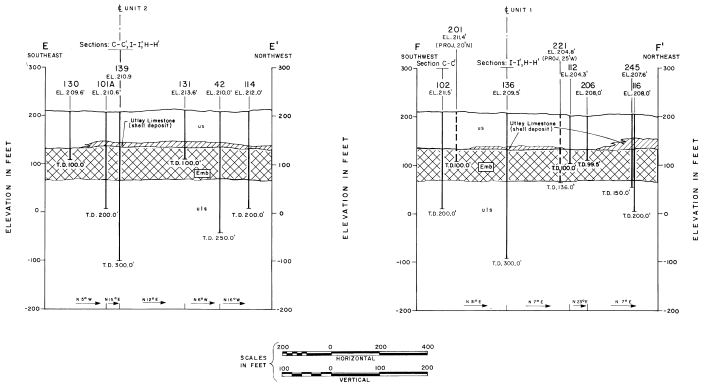

GEOLOGIC SECTION E-E AND F-F

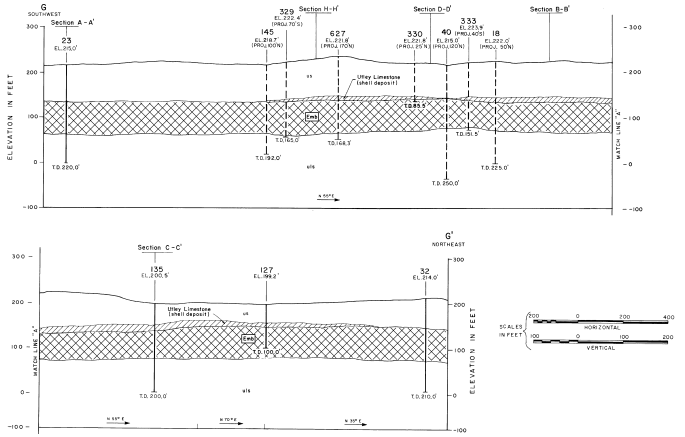

GEOLOGIC SECTION G-G

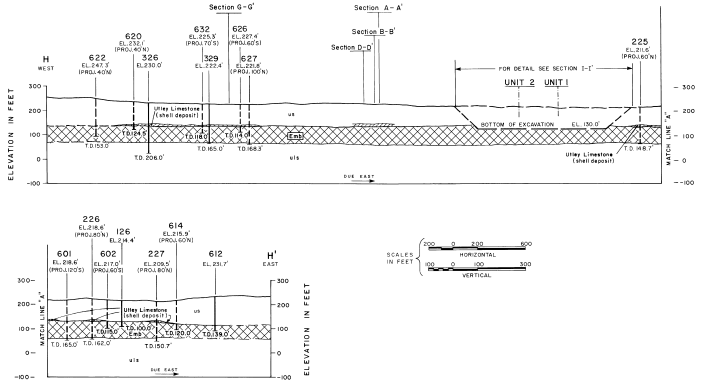

GEOLOGIC SECTION H-H

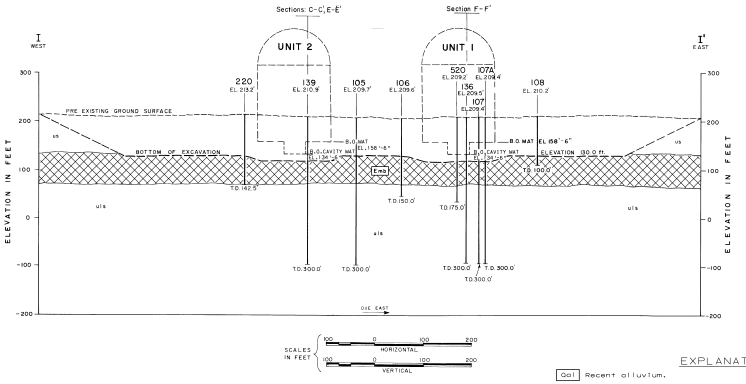

GEOLOGIC SECTION I-I

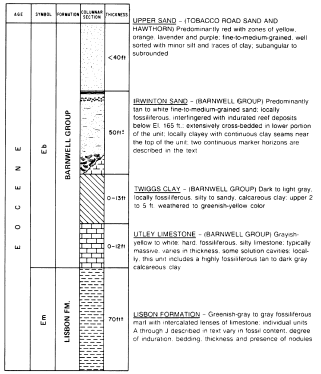

UPPER SAND - (TOBACCO ROAD SAND AND HAWTHORN) Predominantly red with zones of yellow, orange, lavender and purple; fine-to-medium-grained, well sorted with minor silt and traces of clay, subangular to subrounded

IRWINTON SAND - (BARNWELL GROUP) Predominantly tan to white fine-to-medium-grained sand; locally fossiliferous, interlingered with indurated reef deposits, below El. 165 ft. extensively cross-bedded in lower portion of the unit; locally clayey with continuous clay seams near the top of the unit; two continuous marker horizons are described in the text

TWIGGS CLAY - (BARNWELL GROUP) Dark to light gray, locally fossiliferous, silty to sandy, calcareous clay; upper 2 to 5 ft. weathered to greenish-yellow color

UTLEY LIMESTONE - (BARNWELL GROUP) Grayish-yellow to white, hard, fossiliferous, silty limestone; typically massive; varies in thickness; some solution cavities locally, this unit includes a highly fossiliferous tan to dark gray calcareous clay.

LISBON FORMATION - Greenish-gray to gray fossiliferous marl with interbedded lenses of limestone; individual units A through J described in text vary in fossil content, degree of induration, bedding, thickness and presence of nodules

STRATIGRAPHIC COLUMN-POWER BLOCK EXCAVATION

EXPLANATION

- Gal — Recent alluvium.
- US — UPPER SANDS: Undifferentiated uncemented, red-brown, yellow, silty sand. Occasionally typified by many clay seams, loose sands; shell deposits locally at base. Utley Limestone (shell deposit) cross hatched. (Barnwell Group-Hawthorn Formation)
- Emb — BEARING UNITS: Hard gray/green true marl, fossiliferous and concretionary. (Lisbon Formation-Blue Bluff Marl)
- uls — LOWER SANDS: Undifferentiated sand, silt and clay. (Lower Lisbon Formation, Huber and Ellenton Formation)

THIS DOCUMENT CONTAINS PROPRIETARY, CONFIDENTIAL, AND/OR TRADE SECRET INFORMATION OF THE SUBSIDIARIES OF THE SOUTHERN COMPANY OR OF THIRD PARTIES. IT IS INTENDED FOR USE ONLY BY EMPLOYEES OF, OR AUTHORIZED CONTRACTORS OF, THE SUBSIDIARIES OF THE SOUTHERN COMPANY. UNAUTHORIZED POSSESSION, USE, DISTRIBUTION, COPYING, DISSEMINATION, OR DISCLOSURE OF ANY PORTION HEREOF IS PROHIBITED.

NO.	REVISIONS	DATE	DR	CHK	APPV	DTL
1	ISSUED PER REA 96-VAA054	9-30-98	GS	RBH	CBH	WFP

SOUTHERN COMPANY SERVICES, INC.
BIRMINGHAM, ALABAMA

GEORGIA POWER COMPANY
ALVIN W. VOGTLE NUCLEAR PLANT

GEOLOGIC SECTIONS

SCALE: NONE | DRAWING NO. AX6DD352 | REV. 0

JOB NO.10604

SIZE E 34X44

CAD NAME AX6DD352

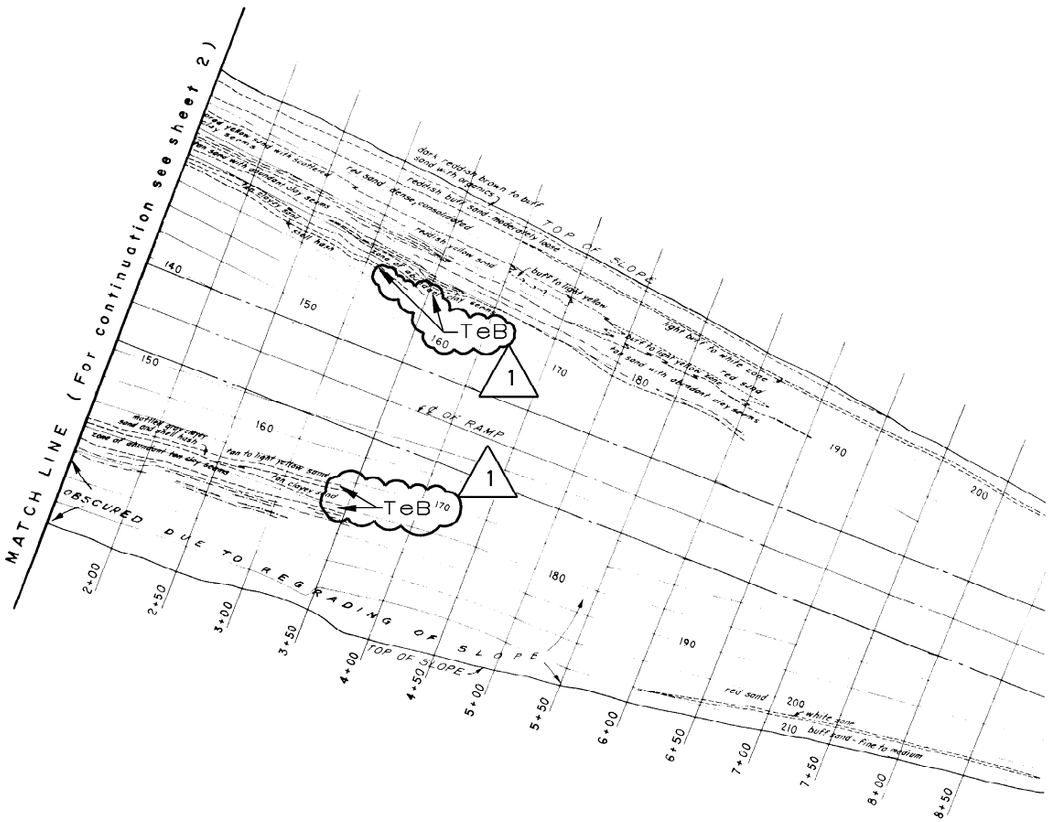

EXPLANATION

- CLAY SEAM
- LOCAL SEEPAGE-VARIES FROM OBSERVED DAMPNESS TO MODERATE TRICKLE
- SEEPAGE ZONE-SEEPAGE OCCURING OVER A LARGER AREA THAN
- SHELL FRAGMENTS
- CS-13 CORE HOLE FOR SAMPLING AND TESTING MARL

EOCENE

- TeB BARNWELL GROUP
- TeM LIBSON FORMATION

SEE DRAWING AX6DD352 AND TEXT FOR DETAILS OF STRATIGRAPHY

NOTES:

1. SIDE SLOPES ARE 2 HORIZONTAL TO 1 VERTICAL.
2. ALL ZONES MAPPED CONSIST OF SAND EXCEPT WHERE OTHERWISE NOTED. SEE DRAWING AX6DD352 AND TEXT FOR DETAILED DESCRIPTIONS OF STRATIGRAPHY. FOR EXAMPLE "YELLOW" REFERS TO YELLOW SAND.
3. BOTTOM OF EXCAVATION=130.00 ft., EXCEPT AUXILLARY BUILDING WHICH IS ELEV.108.75 ft.
4. THE APPARENT IRREGULARITY OF THE UPPER CONTACT OF THE LIBSON FORMATION REFLECTS THE IRREGULAR CONFIGURATION OF THE EXCAVATION AT THE TIME OF MAPPING AND IS NOT RELATED TO STRUCTURE IN THE MARL. SEE DRAWINGS AX6DD372 AND AX6DD373 FOR DETAILED SURVEY INFORMATION ON THIS CONTACT.

N

50 0 50 100 150 200

SCALE IN FEET

SOUTHERN COMPANY SERVICES, INC.
BIRMINGHAM, ALABAMA

GEORGIA POWER COMPANY
ALVIN W. VOGTLE NUCLEAR PLANT

GEOLOGIC MAP
POWER BLOCK AREA

NO.	REVISIONS	DATE	DR	CHK	APPV	DTL
△						
△						
1	REVISED PER REA 96-VAA054	10-20-98	GS	RBH	WFP	
0	ISSUED PER REA 96-VAA054	SEE MICROFILM FOR SIGNATURES				

SCALE: NONE

DRAWING NO. AX6DD360

REV 1

JOB NO. 10604

THIS DOCUMENT CONTAINS PROPRIETARY, CONFIDENTIAL, AND/OR TRADE SECRET INFORMATION OF THE SUBSIDIARIES OF THE SOUTHERN COMPANY OR OF THIRD PARTIES. IT IS INTENDED FOR USE ONLY BY EMPLOYEES OF, OR AUTHORIZED CONTRACTORS OF, THE SUBSIDIARIES OF THE SOUTHERN COMPANY. UNAUTHORIZED POSSESSION, USE, DISTRIBUTION, COPYING, DISSEMINATION, OR DISCLOSURE OF ANY PORTION HEREOF IS PROHIBITED.

CAD NAME AX6DD360 SIZE B 11x17

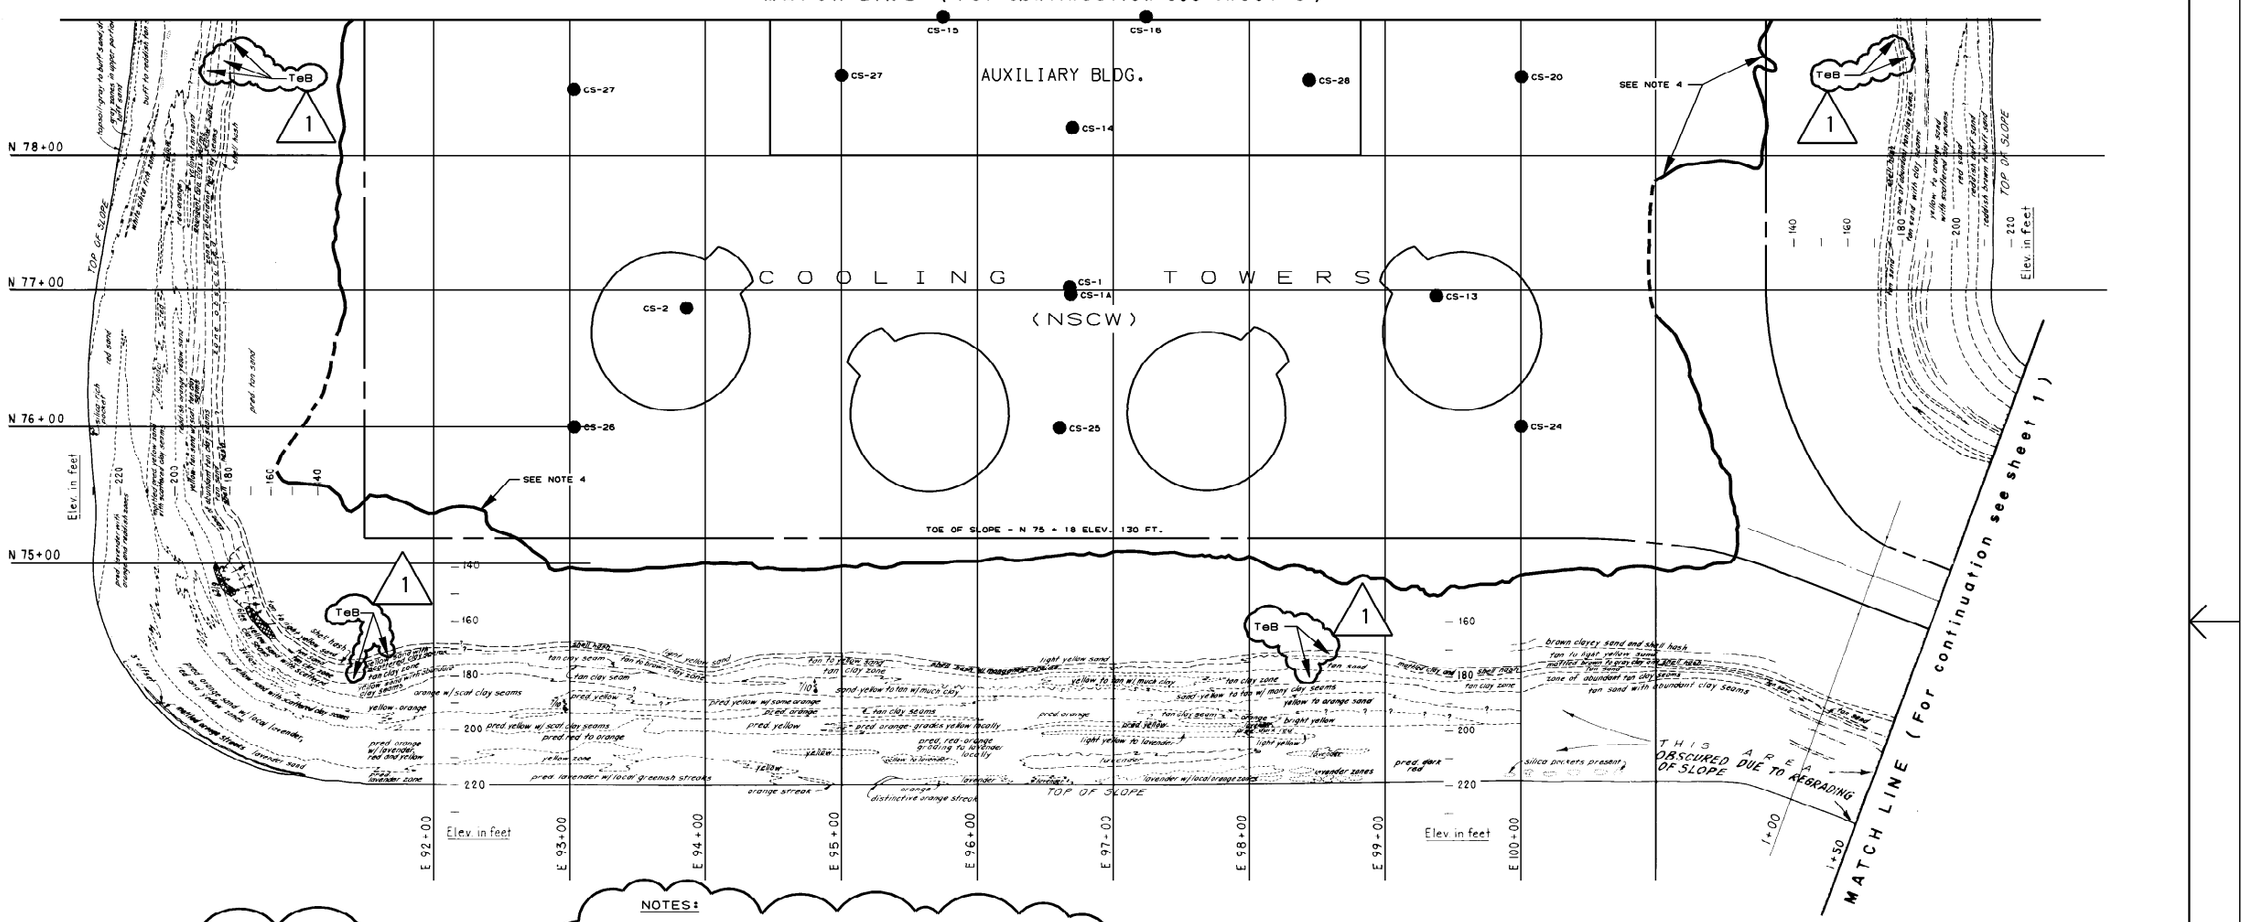

EXPLANATION

- CLAY SEAM
- LOCAL SEEPAGE-VARIES FROM OBSERVED DAMPNESS TO MODERATE TRICKLE
- SEEPAGE ZONE-SEEPAGE OCCURING OVER A LARGER AREA THAN
- SHELL FRAGMENTS
- CS-13 CORE HOLE FOR SAMPLING AND TESTING MARL
- EOCENE
  - TeB BARNWELL GROUP
  - TeM LIBSON FORMATION

SEE DRAWING AX6DD352 AND TEXT FOR DETAILS OF STRATIGRAPHY

NOTES:

1. SIDE SLOPES ARE 2 HORIZONTAL TO 1 VERTICAL.
2. ALL ZONES MAPPED CONSIST OF SAND EXCEPT WHERE OTHERWISE NOTED. SEE DRAWING AX6DD352 AND TEXT FOR DETAILED DESCRIPTIONS OF STRATIGRAPHY. FOR EXAMPLE "YELLOW" REFERS TO YELLOW SAND.
3. BOTTOM OF EXCAVATION=130.00 ft., EXCEPT AUXILLARY BUILDING WHICH IS ELEV.108.75 ft.
4. THE APPARENT IRREGULARITY OF THE UPPER CONTACT OF THE LIBSON FORMATION REFLECTS THE IRREGULAR CONFIGURATION OF THE EXCAVATION AT THE TIME OF MAPPING AND IS NOT RELATED TO STRUCTURE IN THE MARL. SEE DRAWINGS AX6DD372 AND AX6DD373 FOR DETAILED SURVEY INFORMATION ON THIS CONTACT.

1

N

50 0 50 100 150 200
SCALE IN FEET

NO.	REVISIONS	DATE	DR	CHK	APPV	DTL
△						
△						
1	REVISED PER REA 96-VAA054	10-20-98	GS	RBH	WFP	
0	ISSUED PER REA 96-VAA054	SEE MICROFILM FOR SIGNATURES				

SOUTHERN COMPANY SERVICES, INC.
BIRMINGHAM, ALABAMA

GEORGIA POWER COMPANY
ALVIN W. VOGTLE NUCLEAR PLANT

GEOLOGIC MAP POWER BLOCK AREA

SCALE: NONE	DRAWING NO.	REV
JOB NO. 10604	AX6DD361	1

THIS DOCUMENT CONTAINS PROPRIETARY, CONFIDENTIAL, AND/OR TRADE SECRET INFORMATION OF THE SUBSIDIARIES OF THE SOUTHERN COMPANY OR OF THIRD PARTIES. IT IS INTENDED FOR USE ONLY BY EMPLOYEES OF, OR AUTHORIZED CONTRACTORS OF, THE SUBSIDIARIES OF THE SOUTHERN COMPANY. UNAUTHORIZED POSSESSION, USE, DISTRIBUTION, COPYING, DISSEMINATION, OR DISCLOSURE OF ANY PORTION HEREOF IS PROHIBITED.

CAD NAME AX6DD361 SIZE B 11x17

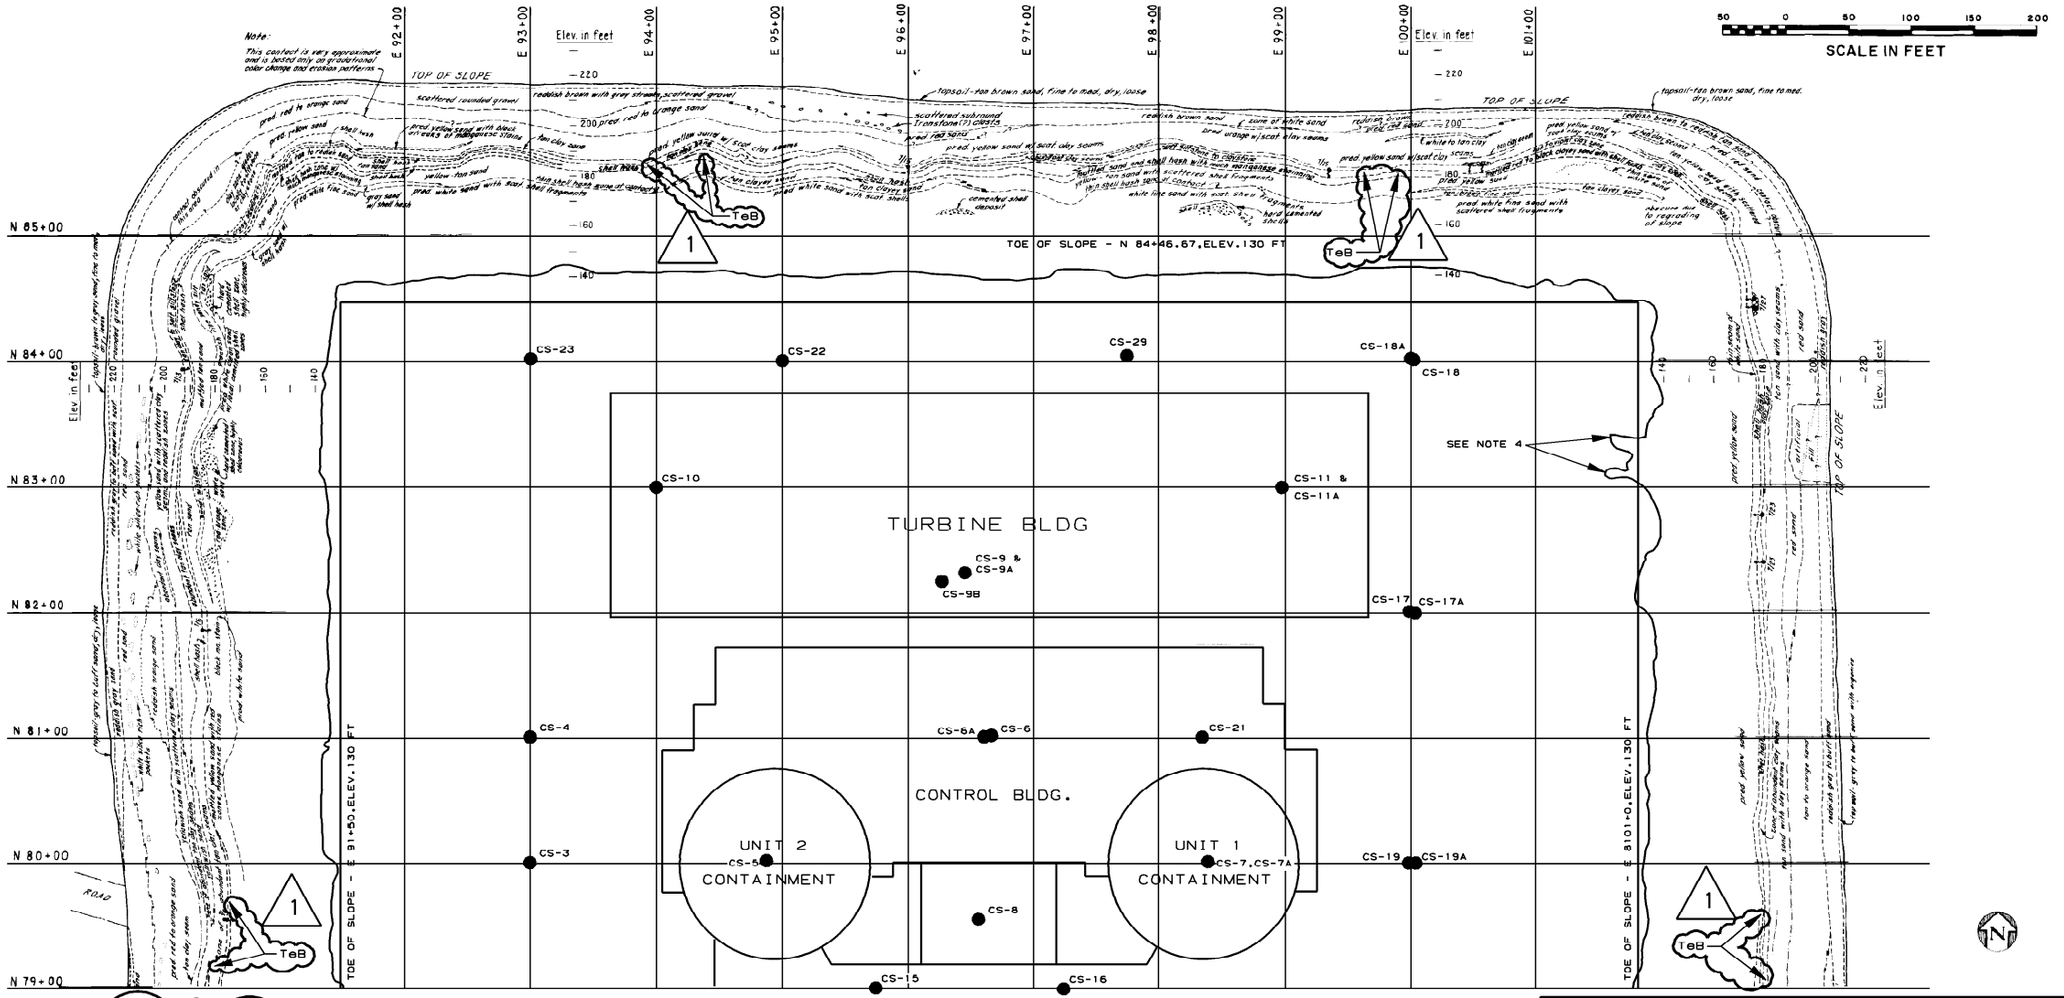

EXPLANATION

- CLAY SEAM
- LOCAL SEEPAGE-VARIES FROM OBSERVED DAMPNESS TO MODERATE TRICKLE
- SEEPAGE ZONE-SEEPAGE OCCURING OVER A LARGER AREA THAN
- SHELL FRAGMENTS
- CS-13 CORE HOLE FOR SAMPLING AND TESTING MARL

EOCENE
- TeB BARNWELL GROUP
- TeM LIBSON FORMATION

SEE DRAWING AX6DD352 AND TEXT FOR DETAILS OF STRATIGRAPHY

NOTES:

1. SIDE SLOPES ARE 2 HORIZONTAL TO 1 VERTICAL.
2. ALL ZONES MAPPED CONSIST OF SAND EXCEPT WHERE OTHERWISE NOTED. SEE DRAWING AX6DD352 AND TEXT FOR DETAILED DESCRIPTIONS OF STRATIGRAPHY. FOR EXAMPLE "YELLOW" REFERS TO YELLOW SAND.
3. BOTTOM OF EXCAVATION=130.00 ft., EXCEPT AUXILLARY BUILDING WHICH IS ELEV.108.75 ft.

NOTES CONT'D

4. THE APPARENT IRREGULARITY OF THE UPPER CONTACT OF THE LIBSON FORMATION REFLECTS THE IRREGULAR CONFIGURATION OF THE EXCAVATION AT THE TIME OF MAPPING AND IS NOT RELATED TO STRUCTURE IN THE MARL. SEE DRAWINGS AX6DD372 AND AX6DD373 FOR DETAILED SURVEY INFORMATION ON THIS CONTACT.

NO.	REVISIONS	DATE	DR	CHK	APPV	DTL
1	REVISED PER REA 96-VAA054	10-20-98	GS	RBH	WFP	
0	ISSUED PER REA 96-VAA054	SEE MICROFILM FOR SIGNATURES				

SOUTHERN COMPANY SERVICES, INC.
BIRMINGHAM, ALABAMA

GEORGIA POWER COMPANY
ALVIN W. VOGTLE NUCLEAR PLANT

GEOLOGIC MAP POWER BLOCK AREA

SCALE: NONE	DRAWING NO.	REV
JOB NO. 10604	AX6DD362	1

THIS DOCUMENT CONTAINS PROPRIETARY, CONFIDENTIAL, AND/OR TRADE SECRET INFORMATION OF THE SUBSIDIARIES OF THE SOUTHERN COMPANY OR OF THIRD PARTIES. IT IS INTENDED FOR USE ONLY BY EMPLOYEES OF, OR AUTHORIZED CONTRACTORS OF, THE SUBSIDIARIES OF THE SOUTHERN COMPANY. UNAUTHORIZED POSSESSION, USE, DISTRIBUTION, COPYING, DISSEMINATION, OR DISCLOSURE OF ANY PORTION HEREOF IS PROHIBITED.

CAD NAME AX6DD362 SIZE B 11x17

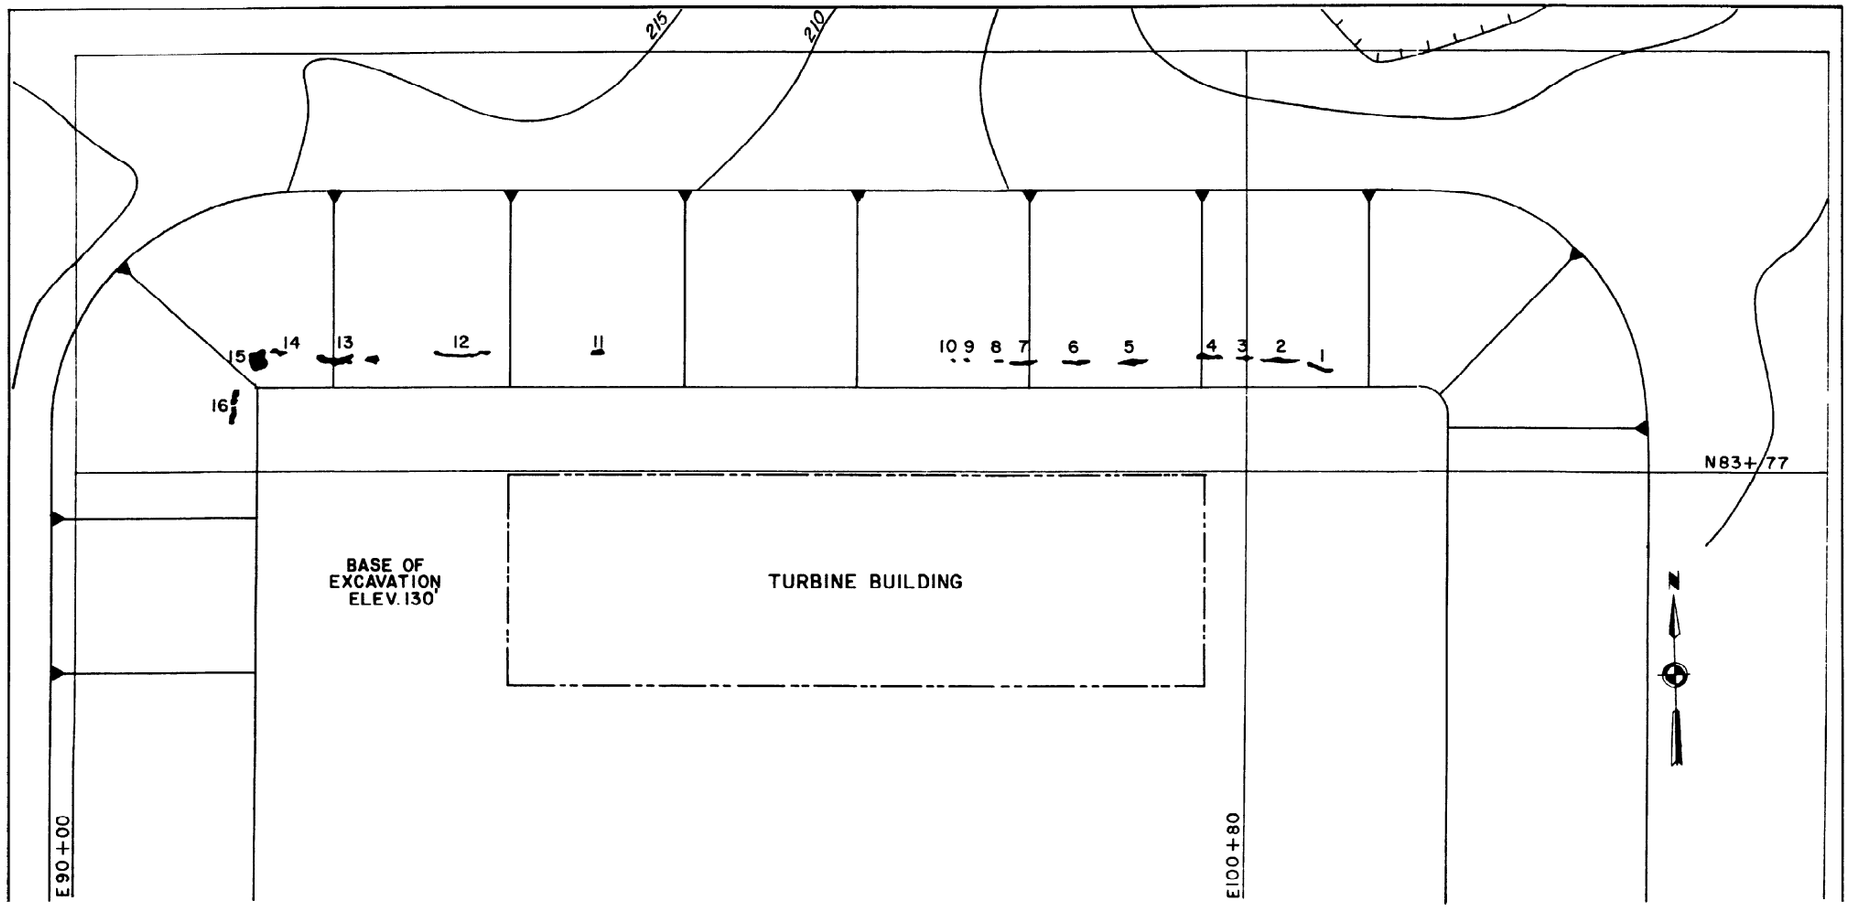

APPROXIMATE CAVITY DIMENSIONS (IN FEET)

CAVITY NO.	LENGTH	HEIGHT	DEPTH
1	17	4.5	25
2	32	–	3-5
3	21	3	–
4	22	2.5-4.0	9-11
5	26	2.5	–
6	18	2-3.5	5-10
7	22	2-4.5	10
8	13	1	–

APPROXIMATE CAVITY DIMENSIONS (IN FEET)

CAVITY NO.	LENGTH	HEIGHT	DEPTH
9	6	3.0-5.5	15
10	11	3	–
11	10	1.5	–
12	45	3	–
13	53	4.5-6.0	12
14	32	2.5-6.0	10-20
15	10	7.0-10.0	25
16	14	3.5-5.0	20-23

EXPLANATION

1 Approximate cavity location

SOUTHERN COMPANY SERVICES, INC.
BIRMINGHAM, ALABAMA

GEORGIA POWER COMPANY
ALVIN W. VOGTLE NUCLEAR PLANT

GEOLOGIC MAP - CAVITIES IN UTLEY LIMESTONE POWER BLOCK CUT SLOPE

NO.	REVISIONS	DATE	DR	CHK	APPV	DTL
0	ISSUED PER REA 96-VAA054	9-30-98	GS	RBH	CBH	WFP

SCALE: NONE

DRAWING NO. AX6DD363

REV 0

JOB NO. 10604

THIS DOCUMENT CONTAINS PROPRIETARY, CONFIDENTIAL, AND/OR TRADE SECRET INFORMATION OF THE SUBSIDIARIES OF THE SOUTHERN COMPANY OR OF THIRD PARTIES. IT IS INTENDED FOR USE ONLY BY EMPLOYEES OF, OR AUTHORIZED CONTRACTORS OF, THE SUBSIDIARIES OF THE SOUTHERN COMPANY. UNAUTHORIZED POSSESSION, USE, DISTRIBUTION, COPYING, DISSEMINATION, OR DISCLOSURE OF ANY PORTION HEREOF IS PROHIBITED.

CAD NAME AX6DD363 SIZE B 11x17

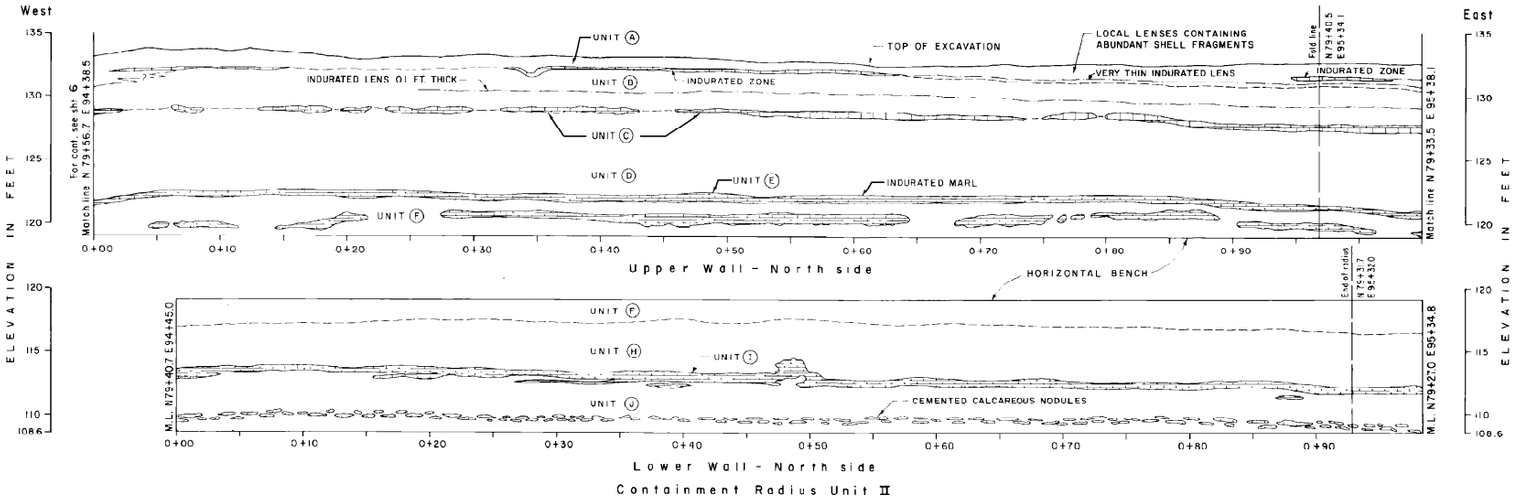

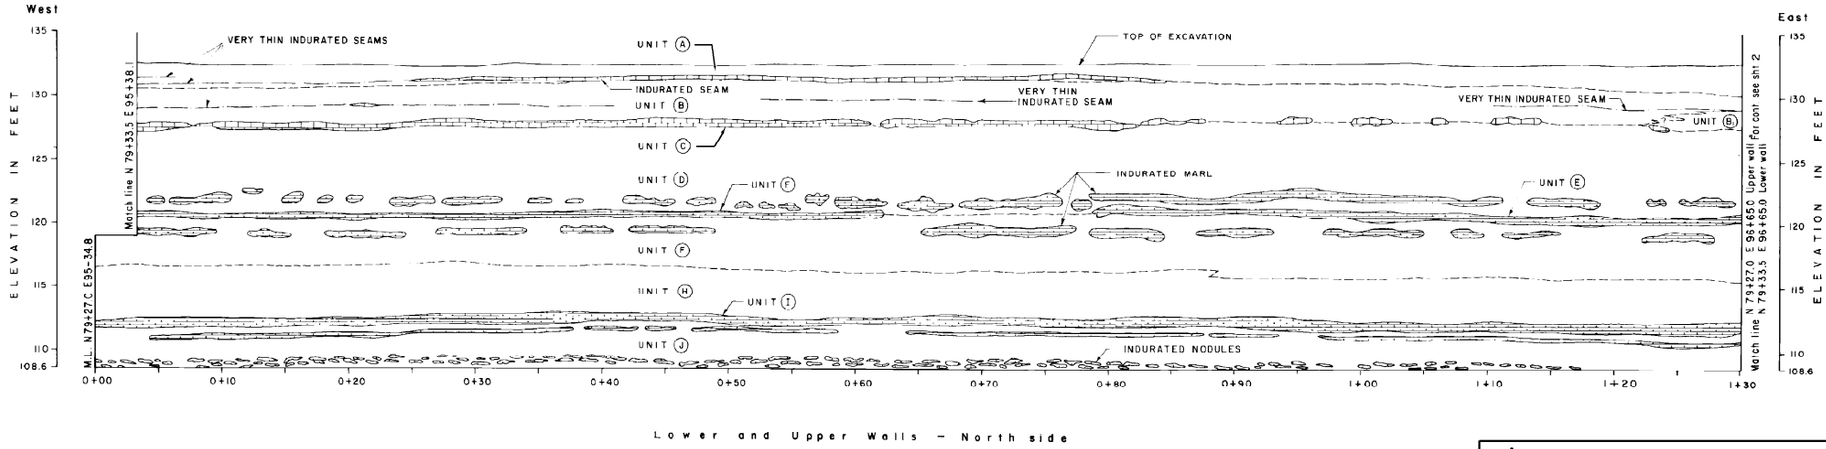

NOTES:

1. FOR EXPLANATION OF GEOLOGIC UNITS SEE DRAWING AX6DD370.
2. STATIONING KEY AND SECTION LOCATION SHOWN ON DRAWING AX6DD374 AND AX6DD375.
3. SECTION CONSIST OF UPPER AND LOWER WELLS SEPARATED BY HORIZONTAL BENCH AT ELEVATION 119 FT. (SEE DRAWING AX6DD374 AND AX6DD375.

SOUTHERN COMPANY SERVICES, INC.
BIRMINGHAM, ALABAMA

GEORGIA POWER COMPANY
ALVIN W. VOGTLE NUCLEAR PLANT

GEOLOGIC SECTIONS AUXILIARY BLDG. BASEMENT

NO.	REVISIONS	DATE	DR	CHK	APPV	DTL
0	ISSUED PER REA 96-VAA054	9-30-98	GS	RBH	CBH	WFP

SCALE: NONE

JOB NO. 10604

DRAWING NO. AX6DD364

REV 0

THIS DOCUMENT CONTAINS PROPRIETARY, CONFIDENTIAL, AND/OR TRADE SECRET INFORMATION OF THE SUBSIDIARIES OF THE SOUTHERN COMPANY OR OF THIRD PARTIES. IT IS INTENDED FOR USE ONLY BY EMPLOYEES OF, OR AUTHORIZED CONTRACTORS OF, THE SUBSIDIARIES OF THE SOUTHERN COMPANY. UNAUTHORIZED POSSESSION, USE, DISTRIBUTION, COPYING, DISSEMINATION, OR DISCLOSURE OF ANY PORTION HEREOF IS PROHIBITED.

CAD NAME AX6DD364 SIZE B 11x17

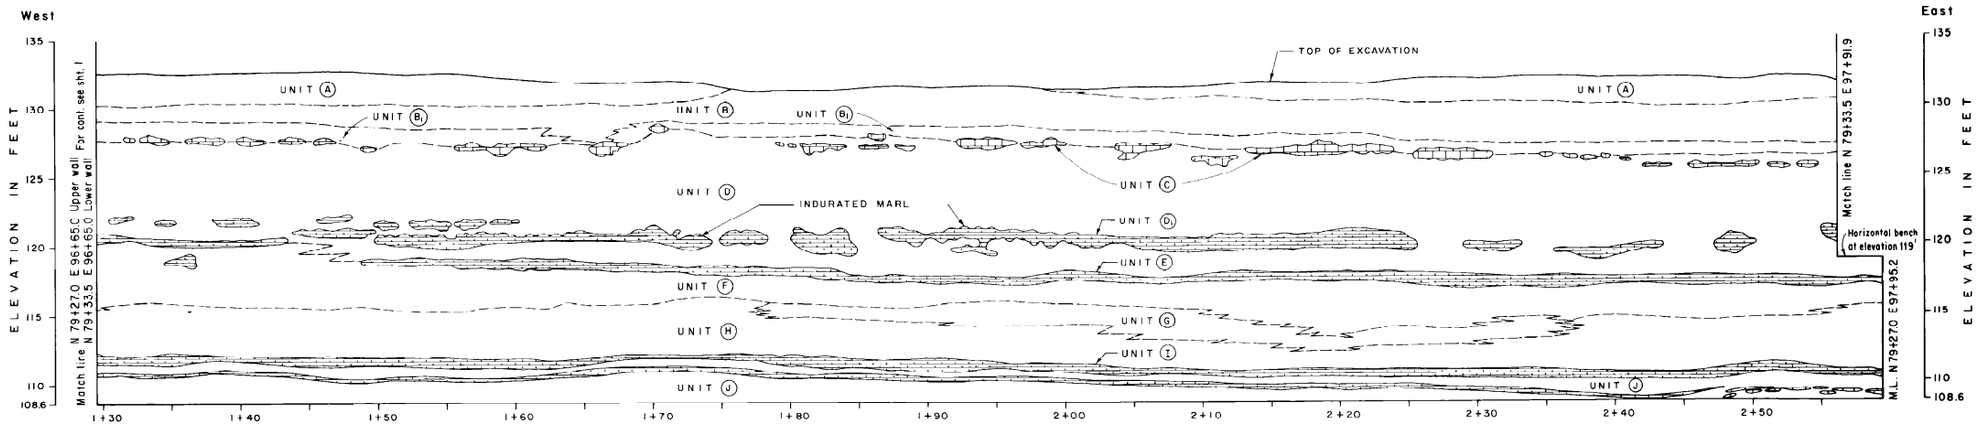

Lower and Upper Walls - North side

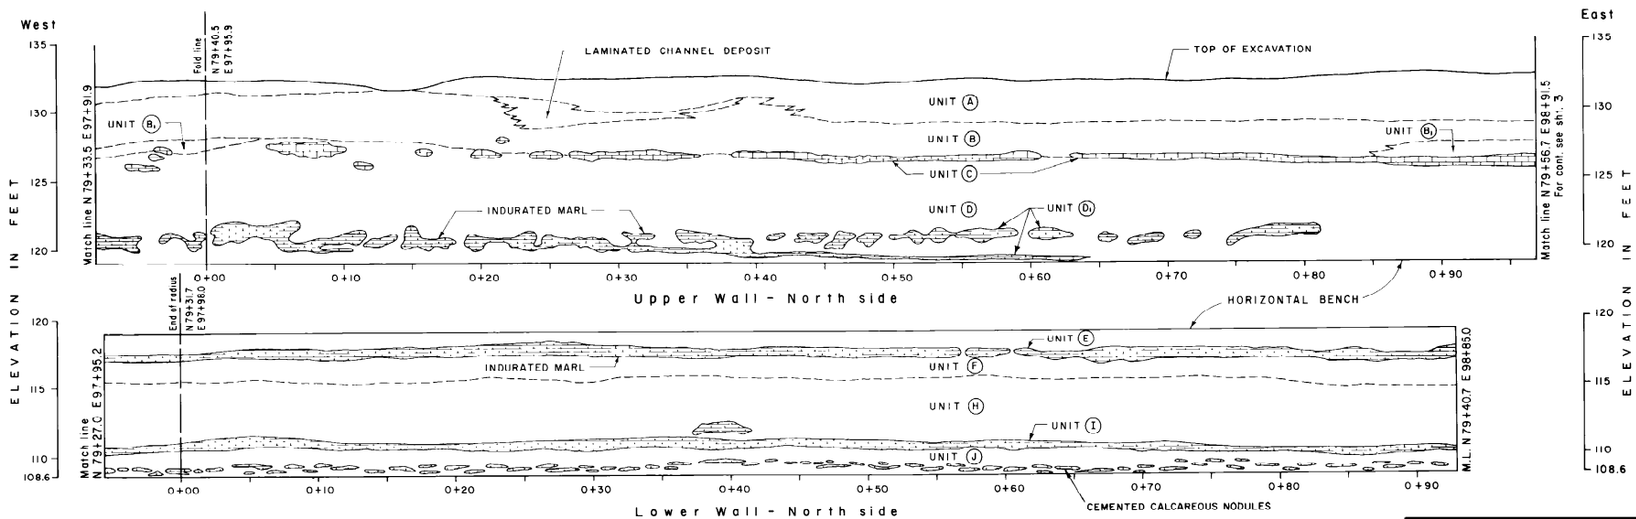

Upper Wall - North side

Lower Wall - North side

Containment Radius Unit I

NOTES:

1. FOR EXPLANATION OF GEOLOGIC UNITS SEE DRAWING AX6DD370.
2. STATIONING KEY AND SECTION LOCATION SHOWN ON DRAWING AX6DD374 AND AX6DD375.
3. SECTION CONSIST OF UPPER AND LOWER WELLS SEPARATED BY HORIZONTAL BENCH AT ELEVATION 119 FT. (SEE DRAWING AX6DD374 AND AX6DD375.

NO.	REVISIONS	DATE	DR	CHK	APPV	DTL
1						
0	ISSUED PER REA 96-VAA054	9-30-98	GS	RBH	CBH	WFP

SOUTHERN COMPANY SERVICES, INC.
BIRMINGHAM, ALABAMA

GEORGIA POWER COMPANY
ALVIN W. VOGTLE NUCLEAR PLANT

GEOLOGIC SECTIONS AUXILIARY BLDG. BASEMENT

SCALE: NONE	DRAWING NO.	REV
JOB NO. 10604	AX6DD365	0

THIS DOCUMENT CONTAINS PROPRIETARY, CONFIDENTIAL, AND/OR TRADE SECRET INFORMATION OF THE SUBSIDIARIES OF THE SOUTHERN COMPANY OR OF THIRD PARTIES. IT IS INTENDED FOR USE ONLY BY EMPLOYEES OF, OR AUTHORIZED CONTRACTORS OF, THE SUBSIDIARIES OF THE SOUTHERN COMPANY. UNAUTHORIZED POSSESSION, USE, DISTRIBUTION, COPYING, DISSEMINATION, OR DISCLOSURE OF ANY PORTION HEREOF IS PROHIBITED.

CAD NAME AX6DD365 SIZE B 11x17

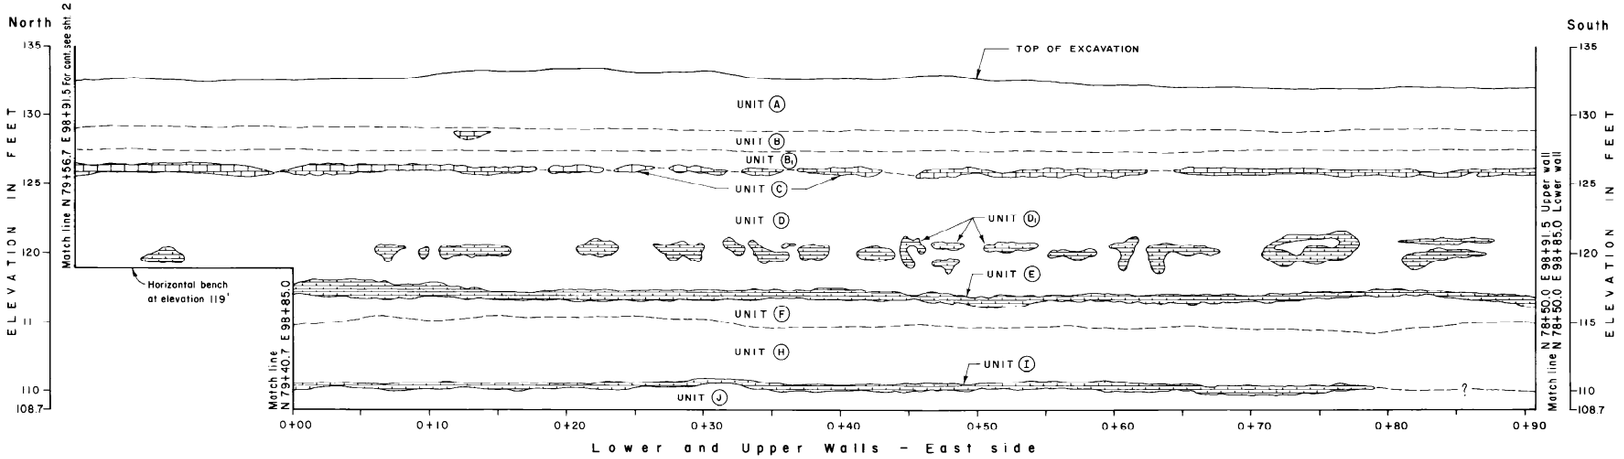

Lower and Upper Walls - East side

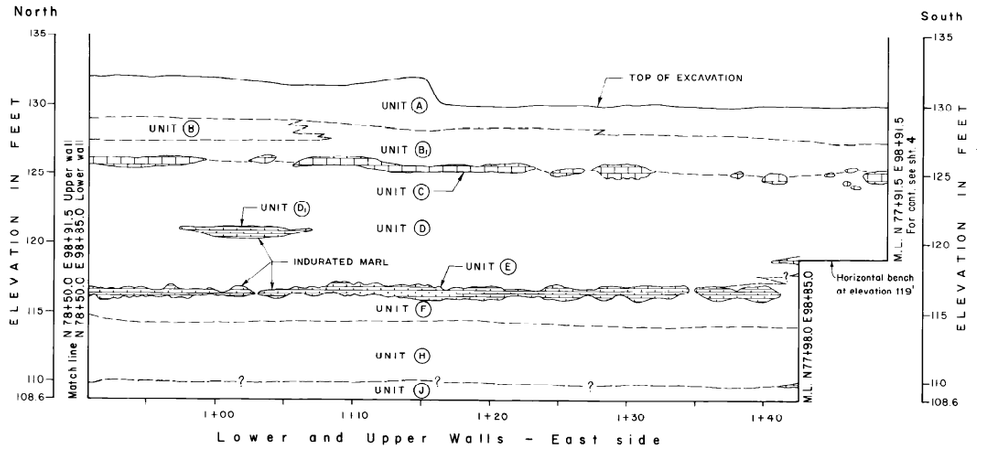

Lower and Upper Walls - East side

NOTES:

1. FOR EXPLANATION OF GEOLOGIC UNITS SEE DRAWING AX6DD370.
2. STATIONING KEY AND SECTION LOCATION SHOWN ON DRAWING AX6DD375.
3. SECTION CONSIST OF UPPER AND LOWER WELLS SEPARATED BY HORIZONTAL BENCH AT ELEVATION 119 FT. (SEE DRAWING AX6DD375.

NO.	REVISIONS	DATE	DR	CHK	APPV	DTL
△						
0	ISSUED PER REA 96-VAA054	9-30-98	GS	RBH	CBH	WFP

SOUTHERN COMPANY SERVICES, INC.
BIRMINGHAM, ALABAMA

GEORGIA POWER COMPANY
ALVIN W. VOGTLE NUCLEAR PLANT

GEOLOGIC SECTIONS AUXILIARY BLDG. BASEMENT

SCALE: NONE	DRAWING NO.	REV
JOB NO. 10604	AX6DD366	0

THIS DOCUMENT CONTAINS PROPRIETARY, CONFIDENTIAL, AND/OR TRADE SECRET INFORMATION OF THE SUBSIDIARIES OF THE SOUTHERN COMPANY OR OF THIRD PARTIES. IT IS INTENDED FOR USE ONLY BY EMPLOYEES OF, OR AUTHORIZED CONTRACTORS OF, THE SUBSIDIARIES OF THE SOUTHERN COMPANY. UNAUTHORIZED POSSESSION, USE, DISTRIBUTION, COPYING, DISSEMINATION, OR DISCLOSURE OF ANY PORTION HEREOF IS PROHIBITED.

CAD NAME AX6DD366 SIZE B 11x17

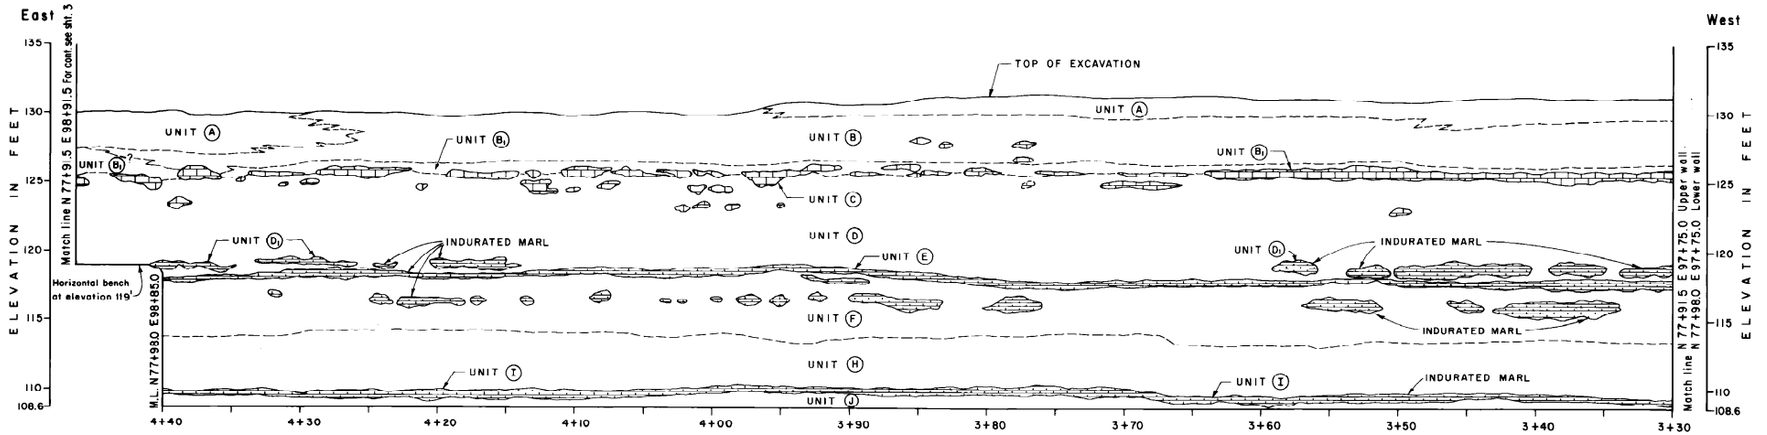

Lower and Upper Walls - South side

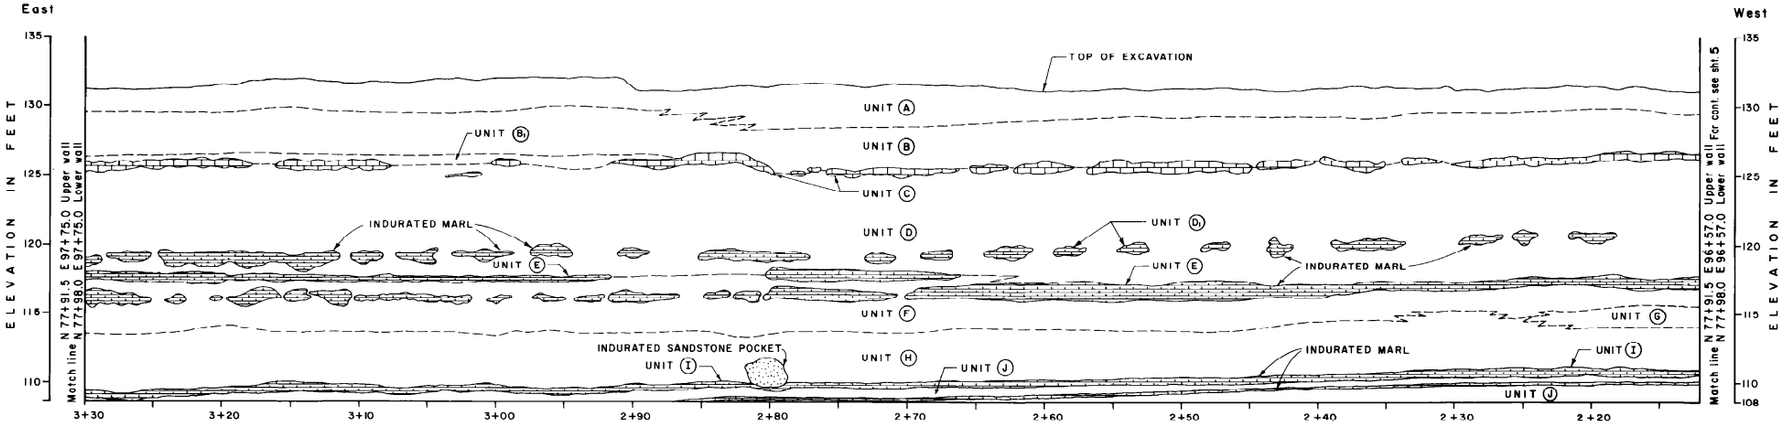

Lower and Upper Walls - South side

NOTES:

1. FOR EXPLANATION OF GEOLOGIC UNITS SEE DRAWING AX6DD370.
2. STATIONING KEY AND SECTION LOCATION SHOWN ON DRAWING AX6DD375.
3. SECTION CONSISTS OF UPPER AND LOWER WELLS SEPARATED BY HORIZONTAL BENCH AT ELEVATION 119 ft. (SEE DRAWING AX6DD375).

NO.	REVISIONS	DATE	DR	CHK	APPV	DTL
△						
0	ISSUED PER REA 96-VAA054	9-30-98	GS	RBH	CBH	WFP

SOUTHERN COMPANY SERVICES, INC.
BIRMINGHAM, ALABAMA

GEORGIA POWER COMPANY
ALVIN W. VOGTLE NUCLEAR PLANT

GEOLOGIC SECTIONS AUXILIARY BLDG. BASEMENT

SCALE: NONE	DRAWING NO.	REV
JOB NO. 10604	AX6DD367	0

THIS DOCUMENT CONTAINS PROPRIETARY, CONFIDENTIAL, AND/OR TRADE SECRET INFORMATION OF THE SUBSIDIARIES OF THE SOUTHERN COMPANY OR OF THIRD PARTIES. IT IS INTENDED FOR USE ONLY BY EMPLOYEES OF, OR AUTHORIZED CONTRACTORS OF, THE SUBSIDIARIES OF THE SOUTHERN COMPANY. UNAUTHORIZED POSSESSION, USE, DISTRIBUTION, COPYING, DISSEMINATION, OR DISCLOSURE OF ANY PORTION HEREOF IS PROHIBITED.

CAD NAME AX6DD367 SIZE B 11x17

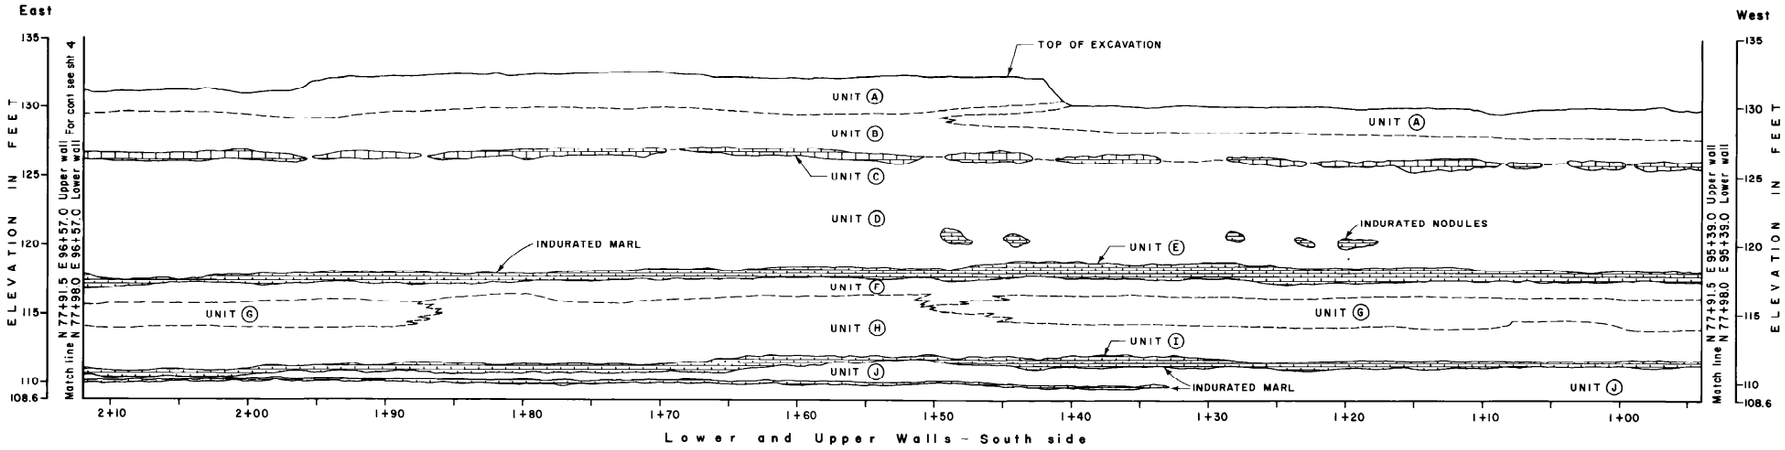

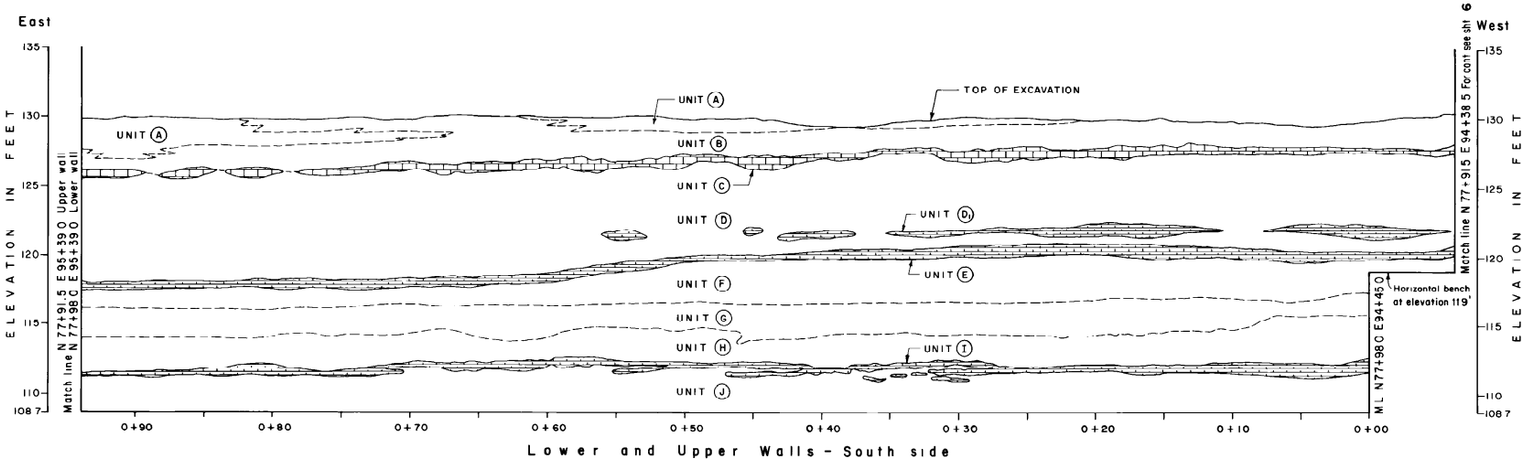

NOTES:

1. FOR EXPLANATION OF GEOLOGIC UNITS SEE DRAWING AX6DD370.
2. STATIONING KEY AND SECTION LOCATION SHOWN ON DRAWING AX6DD374.
3. SECTION CONSISTS OF UPPER AND LOWER WELLS SEPARATED BY HORIZONTAL BENCH AT ELEVATION 119 ft. (SEE DRAWING AX6DD374).

SOUTHERN COMPANY SERVICES, INC.
BIRMINGHAM, ALABAMA

GEORGIA POWER COMPANY
ALVIN W. VOGTLE NUCLEAR PLANT

GEOLOGIC SECTIONS AUXILIARY BLDG. BASEMENT

NO.	REVISIONS	DATE	DR	CHK	APPV	DTL
0	ISSUED PER REA 96-VAA054	9-30-98	GS	RBH	CBH	WFP

SCALE: NONE

JOB NO. 10604

DRAWING NO. AX6DD368

REV 0

THIS DOCUMENT CONTAINS PROPRIETARY, CONFIDENTIAL, AND/OR TRADE SECRET INFORMATION OF THE SUBSIDIARIES OF THE SOUTHERN COMPANY OR OF THIRD PARTIES. IT IS INTENDED FOR USE ONLY BY EMPLOYEES OF, OR AUTHORIZED CONTRACTORS OF, THE SUBSIDIARIES OF THE SOUTHERN COMPANY. UNAUTHORIZED POSSESSION, USE, DISTRIBUTION, COPYING, DISSEMINATION, OR DISCLOSURE OF ANY PORTION HEREOF IS PROHIBITED.

CAD NAME AX6DD368 SIZE B 11x17

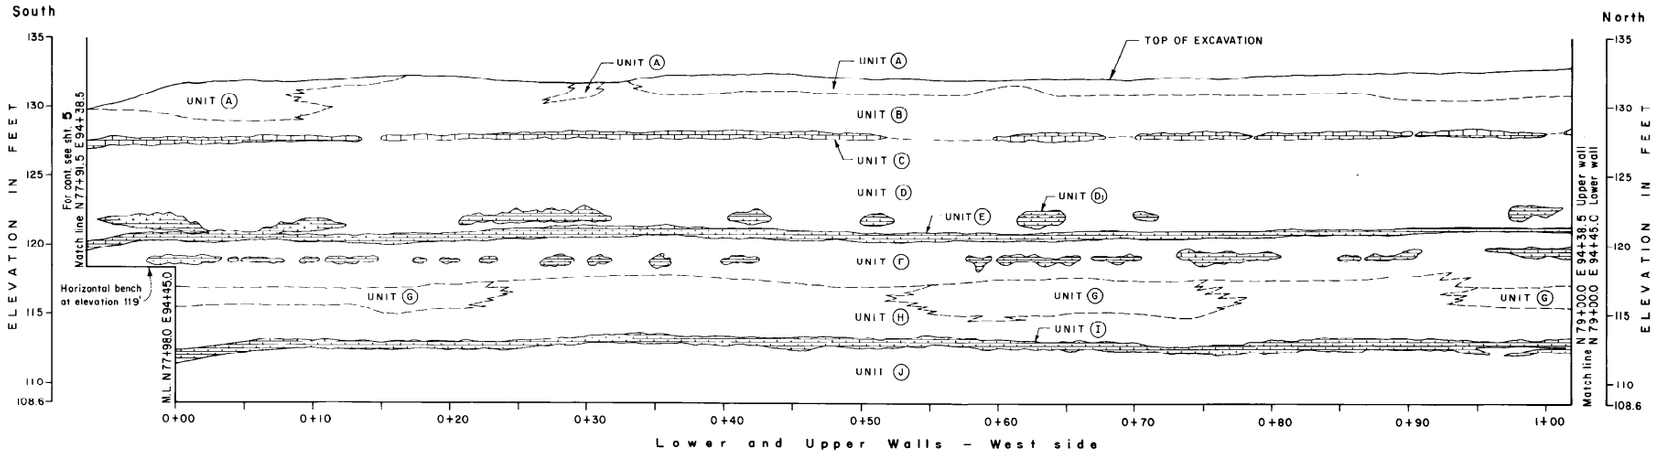

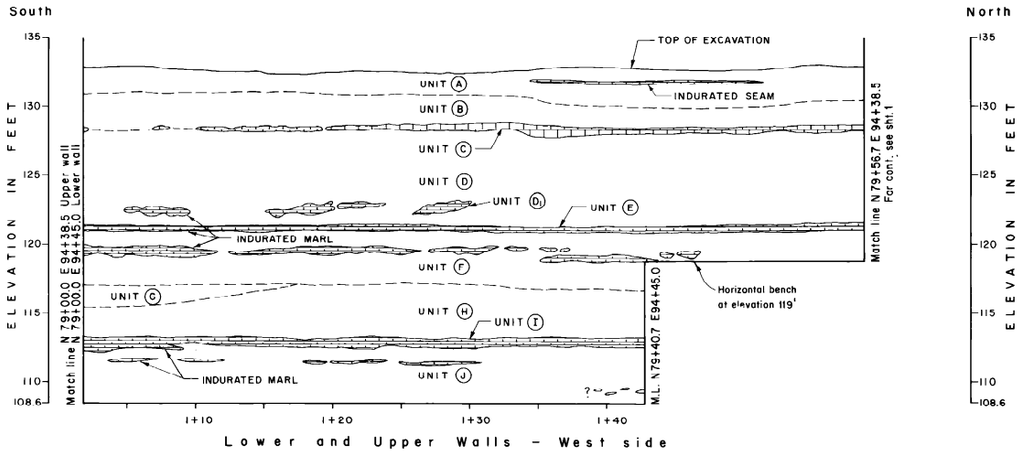

NOTES:

1. FOR EXPLANATION OF GEOLOGIC UNITS SEE DRAWING AX6DD370.
2. STATIONING KEY AND SECTION LOCATION SHOWN ON DRAWING AX6DD374.
3. SECTION CONSISTS OF UPPER AND LOWER WELLS SEPARATED BY HORIZONTAL BENCH AT ELEVATION 119 ft. (SEE DRAWING AX6DD374).

SOUTHERN COMPANY SERVICES, INC.
BIRMINGHAM, ALABAMA

GEORGIA POWER COMPANY
ALVIN W. VOGTLE NUCLEAR PLANT

GEOLOGIC SECTIONS AUXILIARY BLDG. BASEMENT

NO.	REVISIONS	DATE	DR	CHK	APPV	DTL
0	ISSUED PER REA 96-VAA054	9-30-98	GS	RBH	CBH	WFP

SCALE: NONE

JOB NO. 10604

DRAWING NO. AX6DD369

REV 0

THIS DOCUMENT CONTAINS PROPRIETARY, CONFIDENTIAL, AND/OR TRADE SECRET INFORMATION OF THE SUBSIDIARIES OF THE SOUTHERN COMPANY OR OF THIRD PARTIES. IT IS INTENDED FOR USE ONLY BY EMPLOYEES OF, OR AUTHORIZED CONTRACTORS OF, THE SUBSIDIARIES OF THE SOUTHERN COMPANY. UNAUTHORIZED POSSESSION, USE, DISTRIBUTION, COPYING, DISSEMINATION, OR DISCLOSURE OF ANY PORTION HEREOF IS PROHIBITED.

CAD NAME AX6DD369

SIZE B 11x17

UNIT (A) MARL - Silty to clayey dark gray marl; thin light gray laminations which are discontinuous and undulating; parting along laminations common; laminations are conformable with overall attitude of unit; scattered shell fragments; cemented or indurated lenses of sand (up to 0.1' thick) occur locally; appears dessicated at surface after exposure to the atmosphere.

UNIT (A1) INDURATED MARL - Indurated light gray sandy marl, massive, conchoidal fracture, few fossil fragments, moderately hard (can be scratched with a knife); contacts gradational, few dessication cracks develop on exposure to atmosphere, small mica flakes observed without aid of magnification device. Thickness varies from 0.0 to 0.5'.

UNIT (B) SANDY MARL - Very fine-grained sand and silt with widely scattered shell fragments, typically massive although faintly laminated zones are present, sugary texture, dessication cracks poorly developed, moderately soft, medium gray to dark gray.

UNIT (B1) LAMINATED MARL - Dark gray to white alternating discontinuous bands of clay and very fine-grained sand and mixtures of the above; the bands are lenticular and undulatory; few fossils present, locally well indurated, dessication cracks appear upon exposure to atmosphere, gradational contacts except with Unit (C) ; typically moderately soft, can be deformed under finger pressure but hardens upon drying.

UNIT (C) LIMESTONE - Light gray, hard, limestone; conchoidal fracture, no fossils, discontinuous with lenticular pods, up to 1.0-foot thick, sharp contacts.

UNIT (D) FOSSILIFEROUS MARL - Medium gray (lightens upon drying), highly fossiliferous, sandy (very fine-grained) to silty, massive, uniform lithology throughout auxiliary building foundation, many pelecypod fossils retain both valves, discontinuous limestone-like indurated seams occur in the upper portion, large lime-cemented nodules and seams occur near the base of the unit which have gradational contacts with the surrounding material; unit varies from moderately hard to moderately soft.

UNIT (D1) LIMESTONE PODS - Impure limestone to well-cemented marl, discontinuous highly irregular pods and lenses, generally at the same elevation, highly gradational contacts, resembles caliche-like deposit in places, light gray, hard, fossiliferous, silty, massive, no jointing or fractures.

UNIT (E) IMPURE LIMESTONE - Gray, impure limestone appears to be indurated or lime-cemented marl material, fossiliferous, hard, sharp to highly gradational and uneven contacts.

UNIT (F) FOSSILIFEROUS MARL - Very similar to Unit (D) ; medium gray, highly fossiliferous sandy (very fine-grained) to silty, massive gradational contacts in places with both overlying and underlying units, moderately soft, unit forms dessication cracks upon exposure to the atmosphere.

UNIT (G) LAMINATED MARL - Laminated, dark gray to light gray, unit is characterized by sinuous, undulatory, discontinuous laminations, silty to extremely fine sand, scattered shell fragments, small lenticular clay pods, well consolidated, moderately soft (cannot be deformed by finger pressure), no joints or bedding planes, scattered carbonaceous lenses.

UNIT (H) MASSIVE MARL - Massive, silty, firm, uncemented, well consolidated, upper portion of this unit has only sparse fossils but fossils become more numerous near the base, no bedding joints or fractures, medium gray to light gray when dry, moderately soft, cannot be deformed by finger pressure.

UNIT (I) IMPURE LIMESTONE - Fossiliferous, massive, silty limestone, locally discontinuous, hard, light gray to white, locally interbedded with Unit (H) , small carbonaceous inclusions.

UNIT (J) FOSSILIFEROUS MARL - Medium gray, massive fossiliferous silty, marl, scattered shell fragments, numerous limestone pods occur about 3' below the top of the unit; a thin indurated zone is present about 1' below the top of the unit; moderately hard.

NOTE:

FOR GEOLOGIC SECTIONS SEE DRAWINGS AX6DD364 THRU AX6DD369.

SOUTHERN COMPANY SERVICES, INC.
BIRMINGHAM, ALABAMA

GEORGIA POWER COMPANY
ALVIN W. VOGTLE NUCLEAR PLANT

GEOLOGIC SECTIONS AUXILIARY BLDG. BASEMENT

NO.	REVISIONS	DATE	DR	CHK	APPV	DTL
0	ISSUED PER REA 96-VAA054	9-30-98	GS	RBH	CBH	WFP

SCALE: NONE | DRAWING NO. AX6DD370 | REV 0

JOB NO. 10604

THIS DOCUMENT CONTAINS PROPRIETARY, CONFIDENTIAL, AND/OR TRADE SECRET INFORMATION OF THE SUBSIDIARIES OF THE SOUTHERN COMPANY OR OF THIRD PARTIES. IT IS INTENDED FOR USE ONLY BY EMPLOYEES OF, OR AUTHORIZED CONTRACTORS OF, THE SUBSIDIARIES OF THE SOUTHERN COMPANY. UNAUTHORIZED POSSESSION, USE, DISTRIBUTION, COPYING, DISSEMINATION, OR DISCLOSURE OF ANY PORTION HEREOF IS PROHIBITED.

CAD NAME AX6DD370 SIZE B 11x17

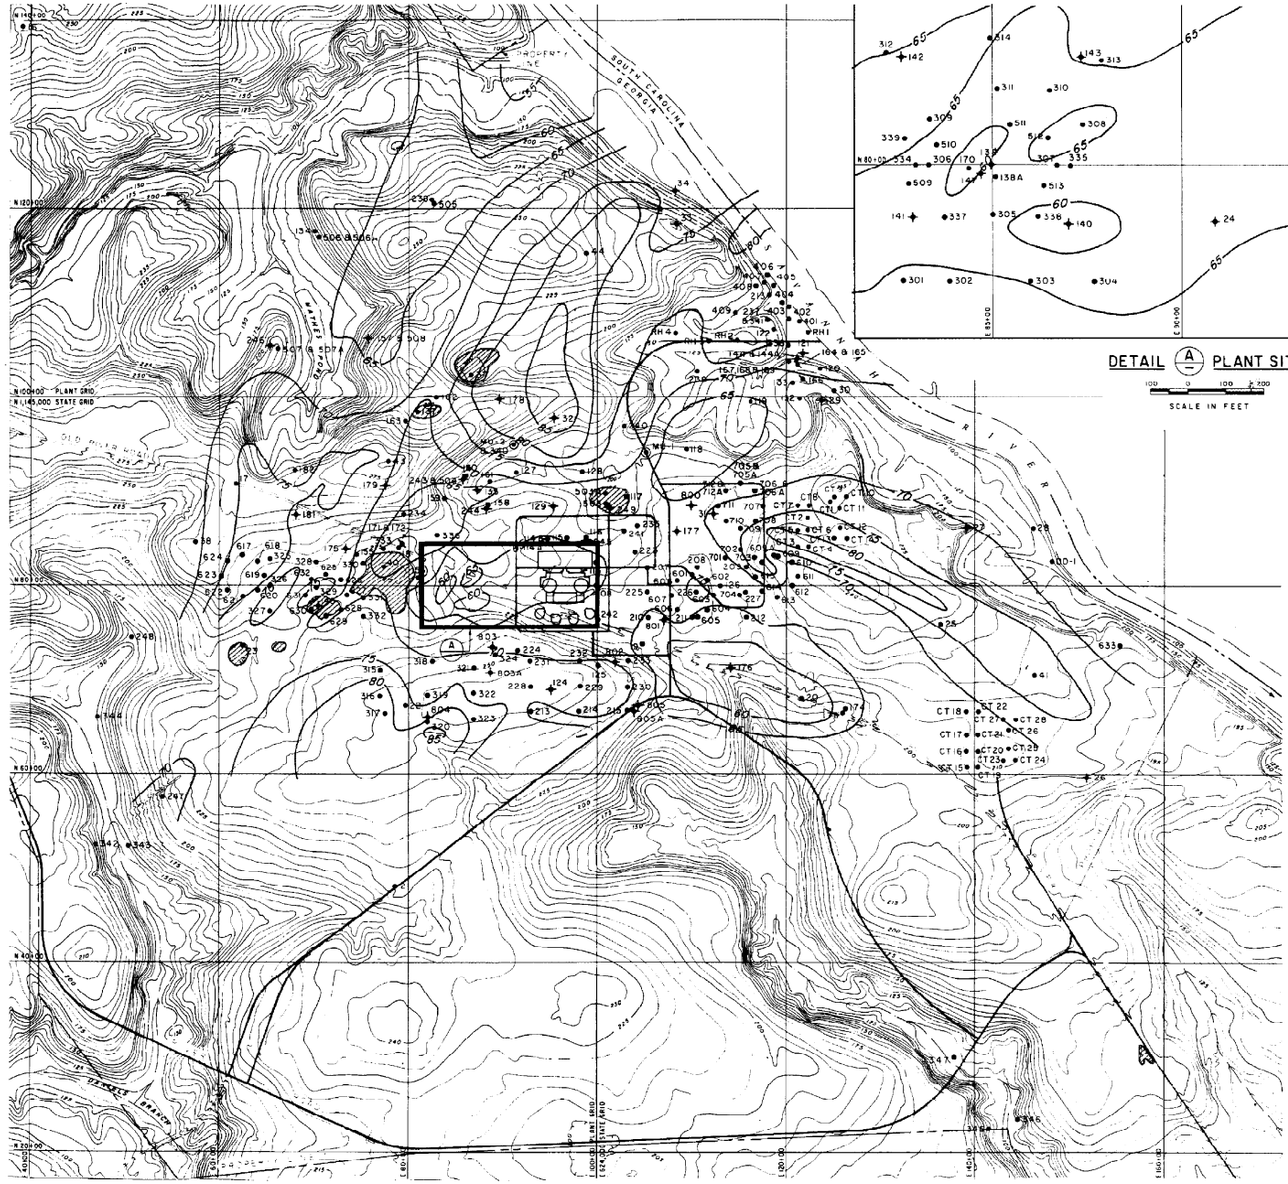

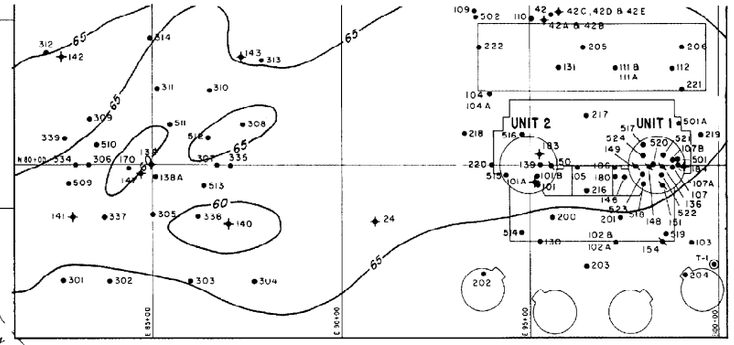

DETAIL (A) PLANT SITE

SCALE IN FEET

EXPLANATION

- Exploration hole
- Seismic survey hole
- Ground water observation hole
- Make-up well
- Surface depression
- Isopach of the marl bearing horizon thickness in feet

REFERENCE:

Hancock Landing Project topographic map prepared by Clyde N. Eldridge Aerial Surveys, Feb 25/71

SCALE IN FEET

Contour intervals 5 ft. and 25 ft.

SOUTHERN COMPANY SERVICES, INC.
BIRMINGHAM, ALABAMA

GEORGIA POWER COMPANY
ALVIN W. VOGTLE NUCLEAR PLANT

ISOPACHS OF THE BEARING HORIZON (BLUE BLUFF MARL)

NO.	REVISIONS	DATE	DR	CHK	APPV	DTL
0	ISSUED PER REA 96-VAA054	9-30-98	GS	RBH	CBH	WFP

SCALE: NONE

JOB NO. 10604

DRAWING NO. AX6DD371

REV 0

THIS DOCUMENT CONTAINS PROPRIETARY, CONFIDENTIAL, AND/OR TRADE SECRET INFORMATION OF THE SUBSIDIARIES OF THE SOUTHERN COMPANY OR OF THIRD PARTIES. IT IS INTENDED FOR USE ONLY BY EMPLOYEES OF, OR AUTHORIZED CONTRACTORS OF, THE SUBSIDIARIES OF THE SOUTHERN COMPANY. UNAUTHORIZED POSSESSION, USE, DISTRIBUTION, COPYING, DISSEMINATION, OR DISCLOSURE OF ANY PORTION HEREOF IS PROHIBITED.

CAD NAME AX6DD371 SIZE B 11x17

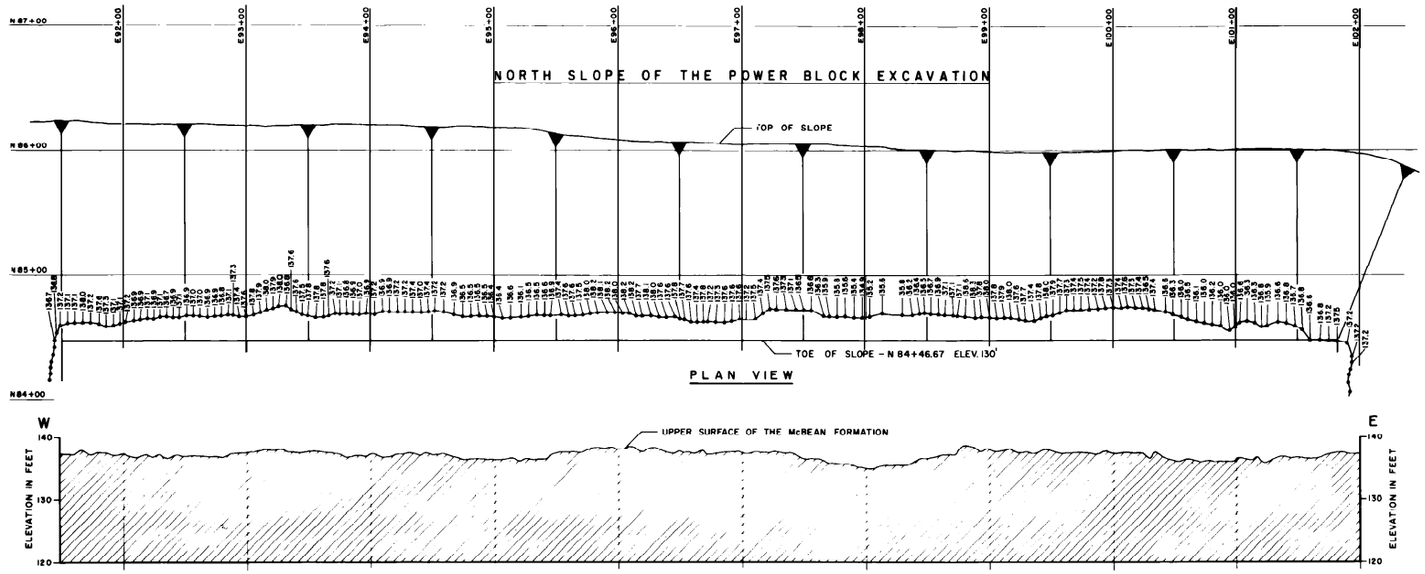

EXPLANATION

135.2 Elevation (in feet) of a point on the top of the Lisbon Fm. located by survey

Lisbon Formation

HORIZONTAL SCALE IN FEET

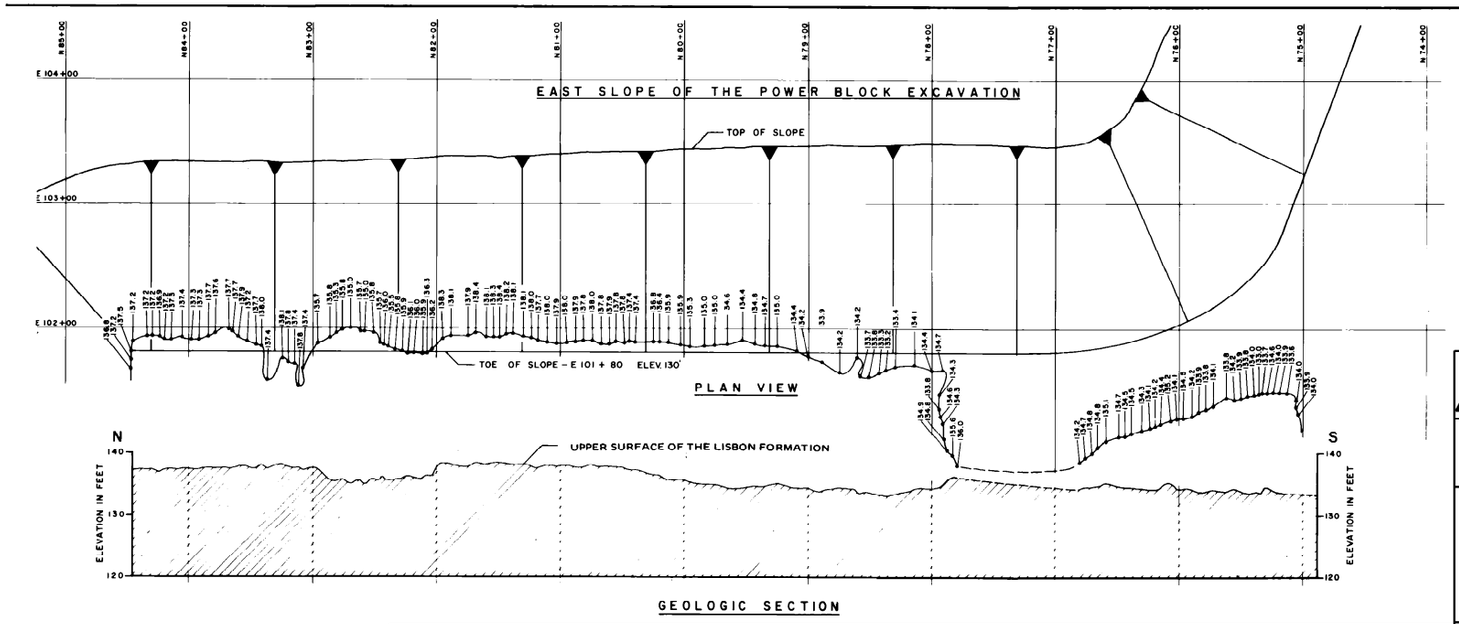

EXPLANATION

135.2 Elevation (in feet) of a point on the top of the Lisbon Fm. located by survey

Lisbon Formation

HORIZONTAL SCALE IN FEET

SOUTHERN COMPANY SERVICES, INC.
BIRMINGHAM, ALABAMA

GEORGIA POWER COMPANY
ALVIN W. VOGTLE NUCLEAR PLANT

UPPER SURFACE OF THE MARL (LIBSON FORMATION) NORTH AND EAST SLOPES

NO.	REVISIONS	DATE	DR	CHK	APPV	DTL
1						
0	ISSUED PER REA 96-VAA054	9-30-98	GS	RBH	CBH	WFP

SCALE: NONE	DRAWING NO.	REV
JOB NO. 10604	AX6DD372	0

THIS DOCUMENT CONTAINS PROPRIETARY, CONFIDENTIAL, AND/OR TRADE SECRET INFORMATION OF THE SUBSIDIARIES OF THE SOUTHERN COMPANY OR OF THIRD PARTIES. IT IS INTENDED FOR USE ONLY BY EMPLOYEES OF, OR AUTHORIZED CONTRACTORS OF, THE SUBSIDIARIES OF THE SOUTHERN COMPANY. UNAUTHORIZED POSSESSION, USE, DISTRIBUTION, COPYING, DISSEMINATION, OR DISCLOSURE OF ANY PORTION HEREOF IS PROHIBITED.

CAD NAME AX6DD372 SIZE B 11x17

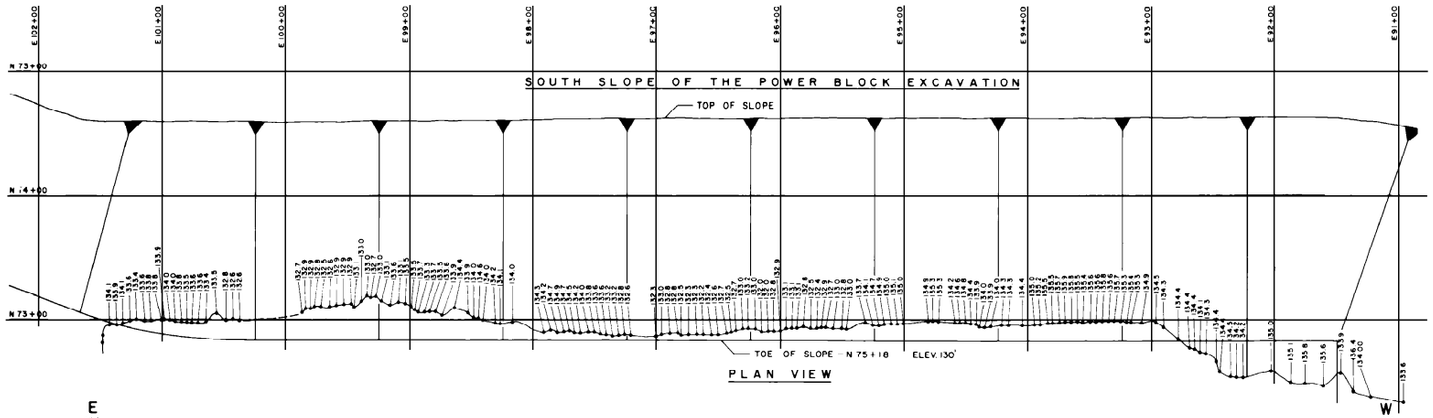

EXPLANATION

135.2 — Elevation (in feet) of a point on the top of the Lisbon Fm. located by survey

Lisbon Formation

N

25 0 25 50 75 100
HORIZONTAL SCALE IN FEET

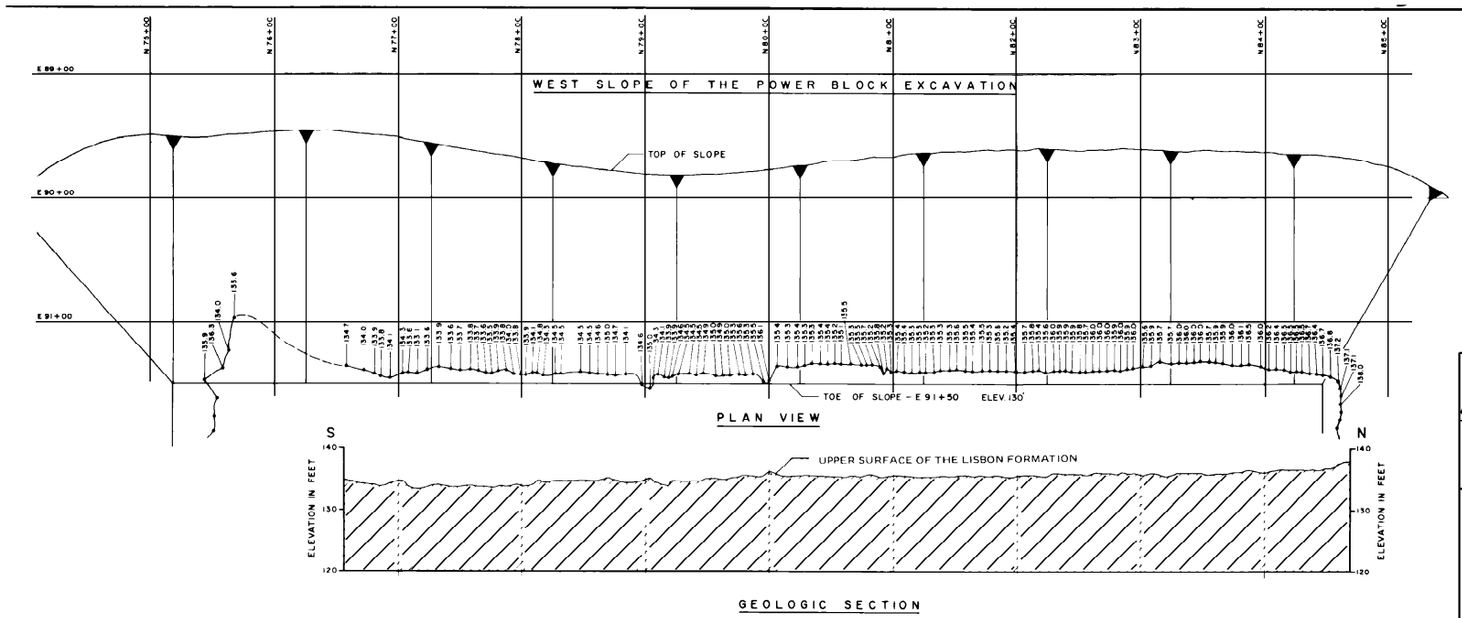

EXPLANATION

135.2 — Elevation (in feet) of a point on the top of the Lisbon Fm. located by survey

Lisbon Formation

N

25 0 25 50 75 100
HORIZONTAL SCALE IN FEET

SOUTHERN COMPANY SERVICES, INC.
BIRMINGHAM, ALABAMA

GEORGIA POWER COMPANY
ALVIN W. VOGTLE NUCLEAR PLANT

UPPER SURFACE OF THE MARL (LIBSON FORMATION) SOUTH AND WEST SLOPES

NO.	REVISIONS	DATE	DR	CHK	APPV	DTL
1						
0	ISSUED PER REA 96-VAA054	9-30-98	GS	RBH	CBH	WFP

SCALE: NONE

JOB NO. 10604

DRAWING NO.	REV
AX6DD373	0

THIS DOCUMENT CONTAINS PROPRIETARY, CONFIDENTIAL, AND/OR TRADE SECRET INFORMATION OF THE SUBSIDIARIES OF THE SOUTHERN COMPANY OR OF THIRD PARTIES. IT IS INTENDED FOR USE ONLY BY EMPLOYEES OF, OR AUTHORIZED CONTRACTORS OF, THE SUBSIDIARIES OF THE SOUTHERN COMPANY. UNAUTHORIZED POSSESSION, USE, DISTRIBUTION, COPYING, DISSEMINATION, OR DISCLOSURE OF ANY PORTION HEREOF IS PROHIBITED.

CAD NAME AX6DD373 SIZE B 11x17

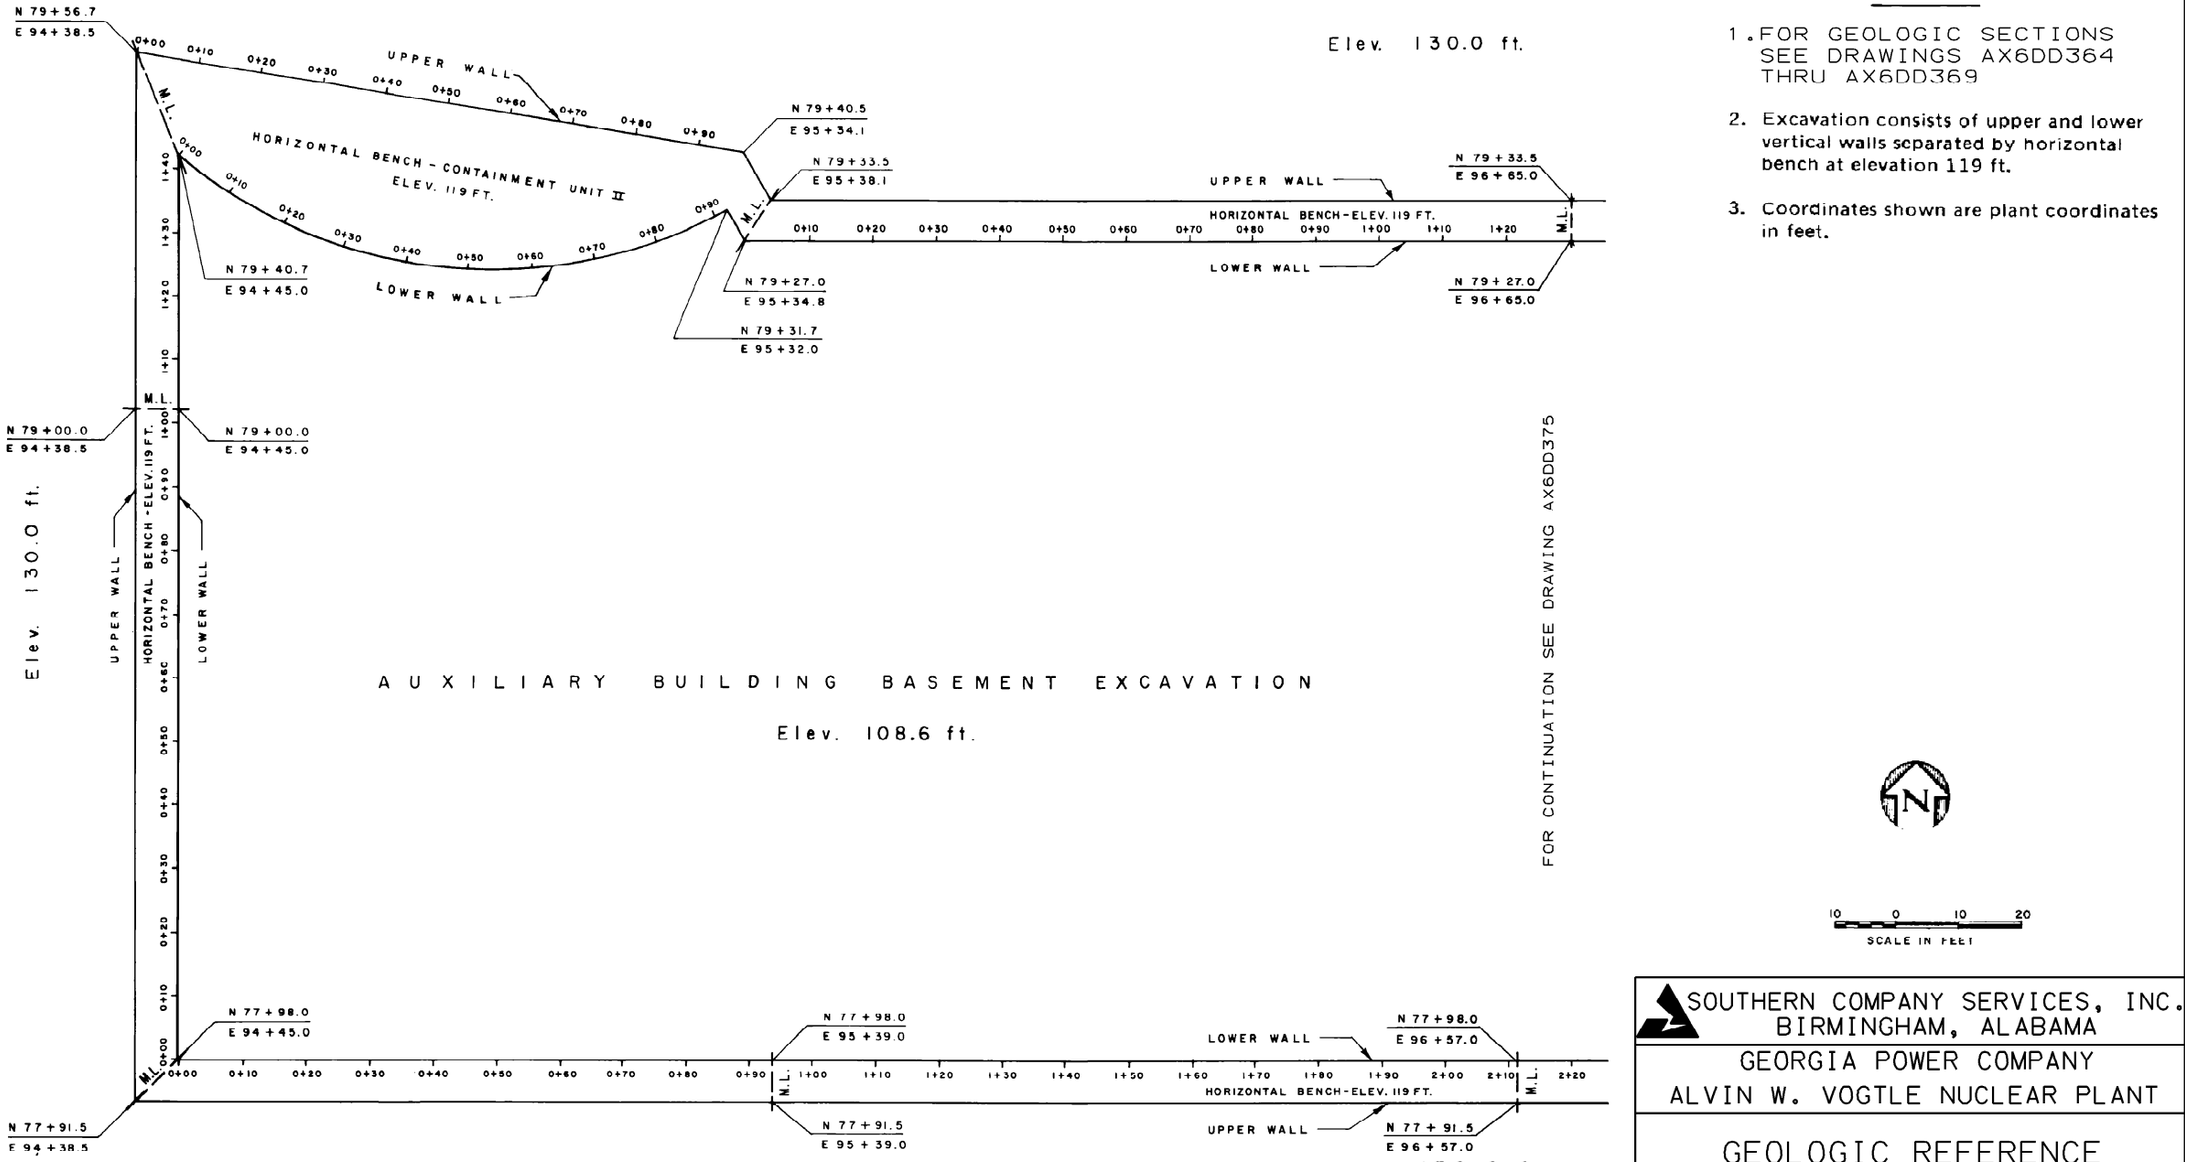

NOTES

1. FOR GEOLOGIC SECTIONS SEE DRAWINGS AX6DD364 THRU AX6DD369
2. Excavation consists of upper and lower vertical walls separated by horizontal bench at elevation 119 ft.
3. Coordinates shown are plant coordinates in feet.

10 0 10 20
SCALE IN FEET

SOUTHERN COMPANY SERVICES, INC.
BIRMINGHAM, ALABAMA

GEORGIA POWER COMPANY
ALVIN W. VOGTLE NUCLEAR PLANT

GEOLOGIC REFERENCE STATIONS-AUXILIARY BLDG. BASEMENT EXCAVATION

NO.	REVISIONS	DATE	DR	CHK	APPV	DTL
0	ISSUED PER REA 96-VAA054	9-30-98	GS	RBH	CBH	WFP

SCALE: NONE

JOB NO. 10604

DRAWING NO. AX6DD374

REV 0

THIS DOCUMENT CONTAINS PROPRIETARY, CONFIDENTIAL, AND/OR TRADE SECRET INFORMATION OF THE SUBSIDIARIES OF THE SOUTHERN COMPANY OR OF THIRD PARTIES. IT IS INTENDED FOR USE ONLY BY EMPLOYEES OF, OR AUTHORIZED CONTRACTORS OF, THE SUBSIDIARIES OF THE SOUTHERN COMPANY. UNAUTHORIZED POSSESSION, USE, DISTRIBUTION, COPYING, DISSEMINATION, OR DISCLOSURE OF ANY PORTION HEREOF IS PROHIBITED.

CAD NAME AX6DD374 SIZE B 11x17

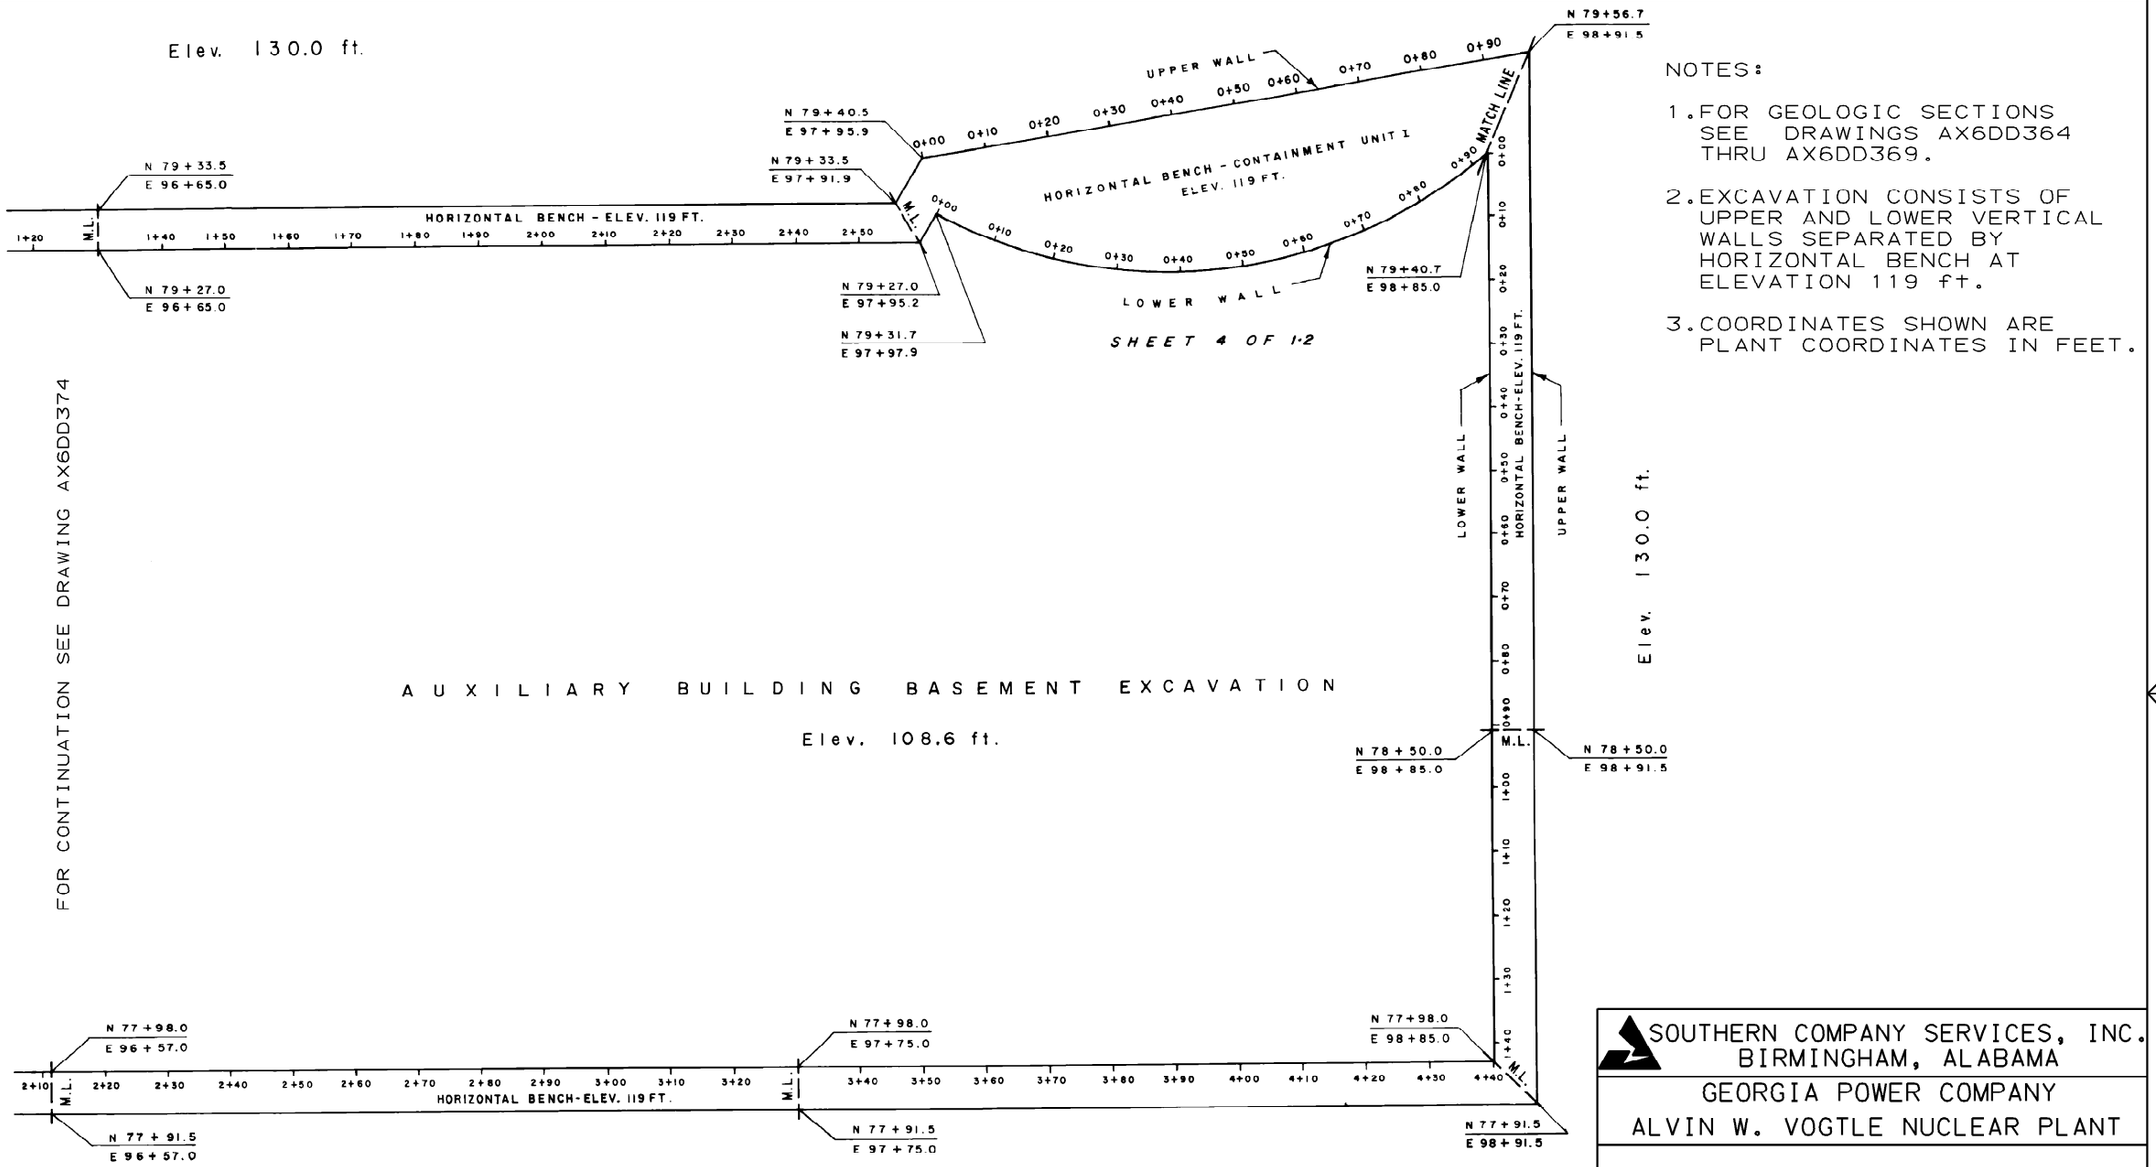

SOUTHERN COMPANY SERVICES, INC.
BIRMINGHAM, ALABAMA

GEORGIA POWER COMPANY
ALVIN W. VOGTLE NUCLEAR PLANT

GEOLOGIC REFERENCE STATIONS-AUXILIARY BLDG. BASEMENT EXCAVATION

NO.	REVISIONS	DATE	DR	CHK	APPV	DTL
0	ISSUED PER REA 96-VAA054	9-30-98	GS	RBH	CBH	WFP

SCALE: NONE | DRAWING NO. AX6DD375 | REV 0

JOB NO. 10604

THIS DOCUMENT CONTAINS PROPRIETARY, CONFIDENTIAL, AND/OR TRADE SECRET INFORMATION OF THE SUBSIDIARIES OF THE SOUTHERN COMPANY OR OF THIRD PARTIES. IT IS INTENDED FOR USE ONLY BY EMPLOYEES OF, OR AUTHORIZED CONTRACTORS OF, THE SUBSIDIARIES OF THE SOUTHERN COMPANY. UNAUTHORIZED POSSESSION, USE, DISTRIBUTION, COPYING, DISSEMINATION, OR DISCLOSURE OF ANY PORTION HEREOF IS PROHIBITED.

CAD NAME AX6DD375 SIZE B 11x17

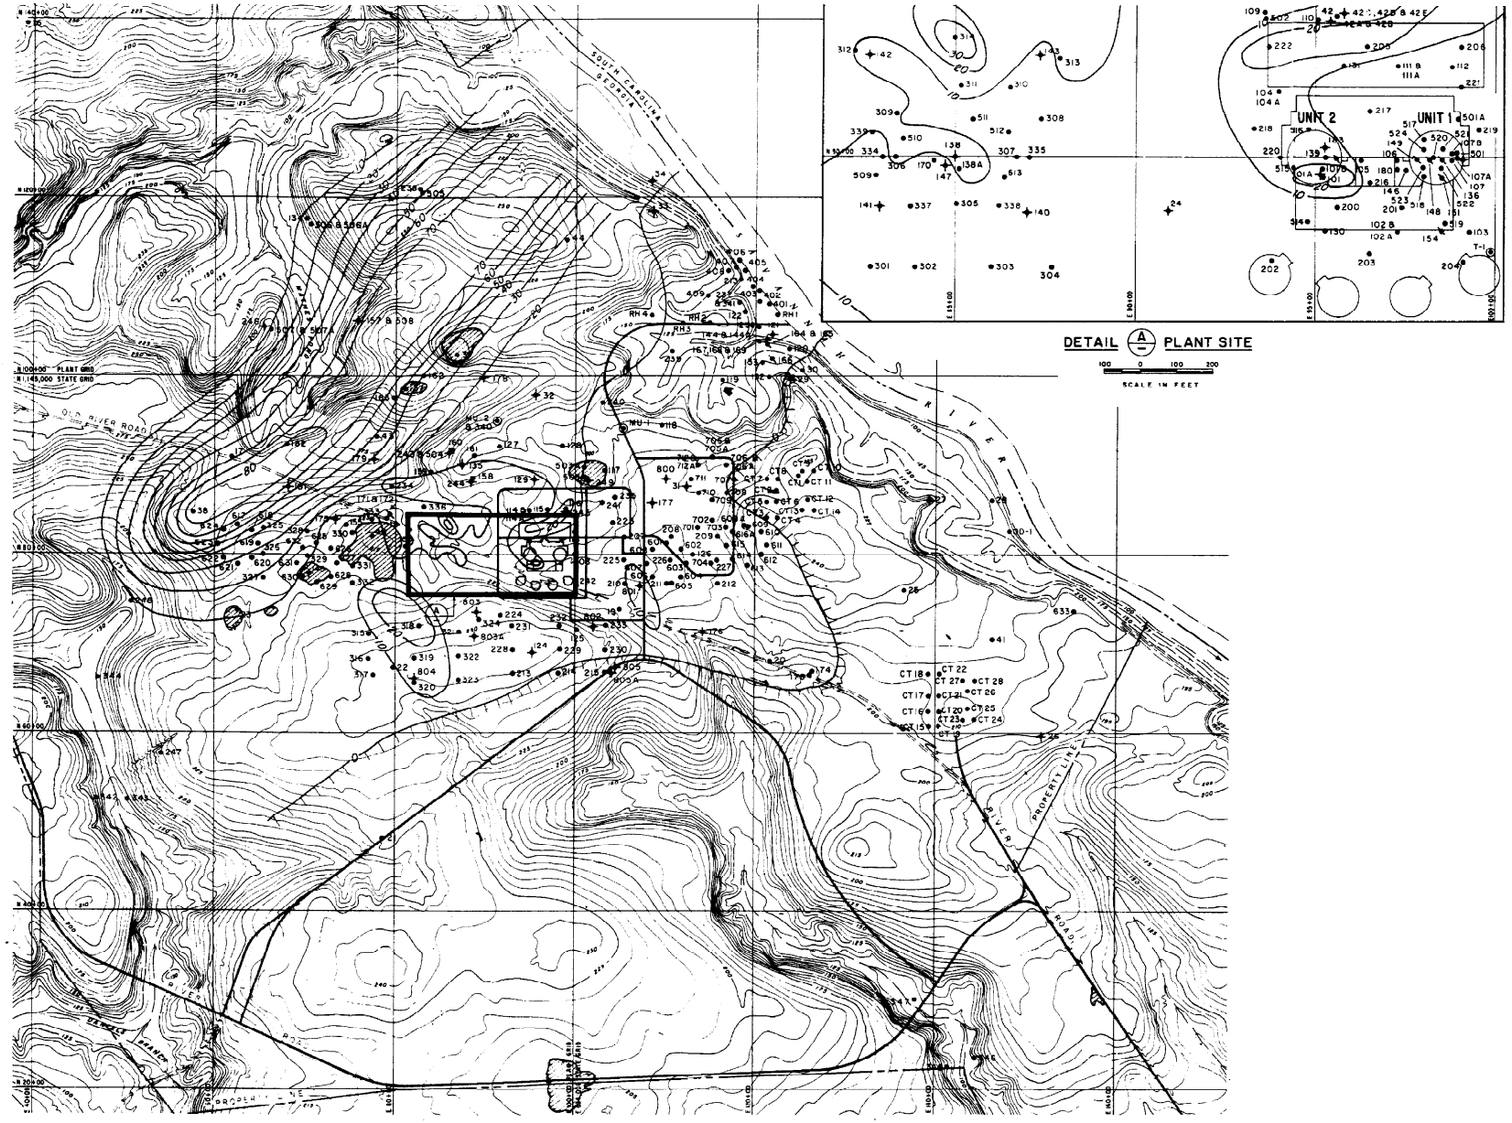

DETAIL (A) PLANT SITE

SCALE IN FEET

EXPLANATION

- 17 — Exploration hole
- 151 — Seismic survey hole
- 31 — Ground water observation hole
- T-1 — Make-up well
- Surface depression
- 50 — Isopach of the shell zone thickness in feet
- Limit of shell zone hachures on side shell zone not present

REFERENCE:

Hancock Landing Project topographic map prepared by Clyde N. Eldridge Aerial Surveys, Feb 25/7

SCALE IN FEET

Contour intervals 5 ft. and 25 ft.

SOUTHERN COMPANY SERVICES, INC.
BIRMINGHAM, ALABAMA

GEORGIA POWER COMPANY
ALVIN W. VOGTLE NUCLEAR PLANT

AREAL EXTENT AND ISOPACHS OF THE SHELL ZONE (UTLEY LIMESTONE)

NO.	REVISIONS	DATE	DR	CHK	APPV	DTL
△						
0	ISSUED PER REA 96-VAA054	9-30-98	GS	RBH	CBH	WFP

SCALE: NONE

JOB NO. 10604

DRAWING NO. AX6DD376

REV 0

THIS DOCUMENT CONTAINS PROPRIETARY, CONFIDENTIAL, AND/OR TRADE SECRET INFORMATION OF THE SUBSIDIARIES OF THE SOUTHERN COMPANY OR OF THIRD PARTIES. IT IS INTENDED FOR USE ONLY BY EMPLOYEES OF, OR AUTHORIZED CONTRACTORS OF, THE SUBSIDIARIES OF THE SOUTHERN COMPANY. UNAUTHORIZED POSSESSION, USE, DISTRIBUTION, COPYING, DISSEMINATION, OR DISCLOSURE OF ANY PORTION HEREOF IS PROHIBITED.

CAD NAME AX6DD376 SIZE B 11x17

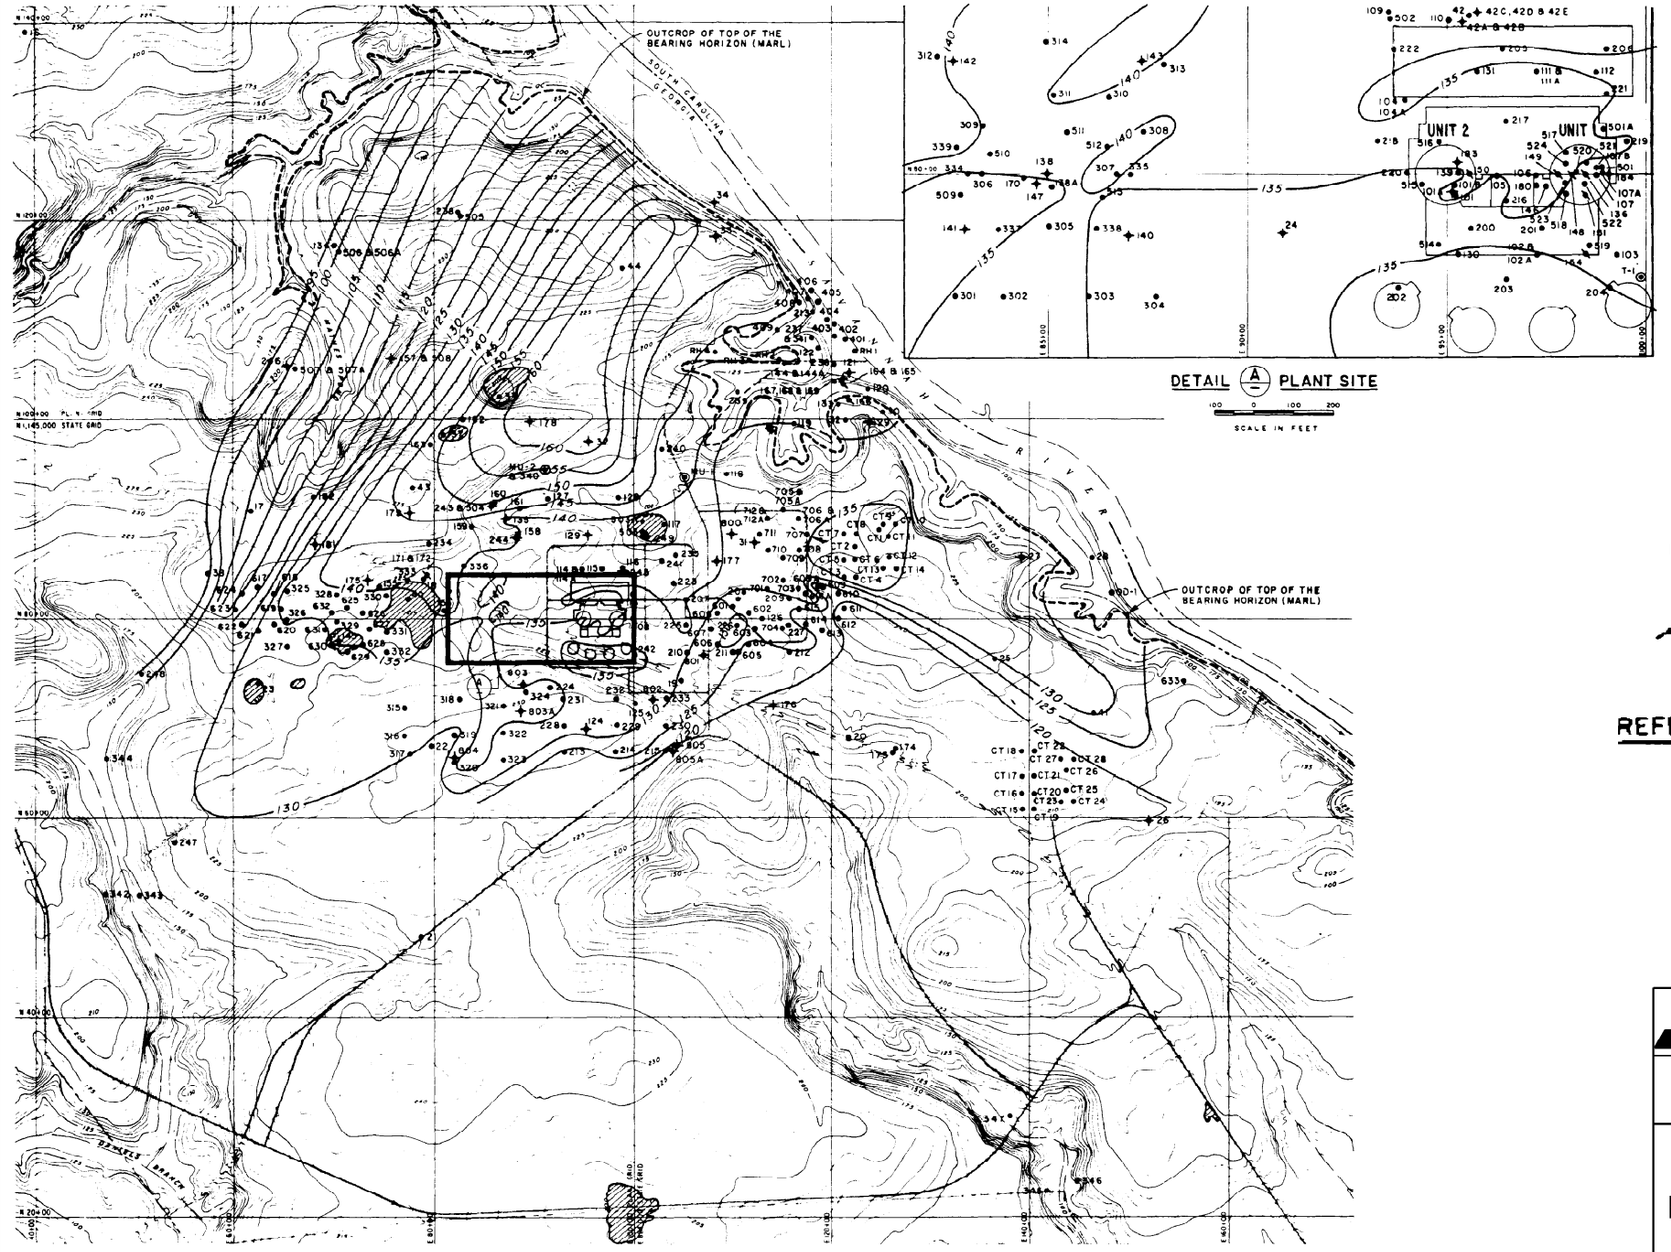

DETAIL (A) PLANT SITE

SCALE IN FEET

EXPLANATION

- EXPLORATION HOLE
- SEISMIC SURVEY HOLE
- GROUND WATER OBSERVATION HOLE
- MAKE-UP WELL
- SURFACE DEPRESSION
- CONTOURS OF THE TOP OF THE BEARING HORIZON IN FEET ABOVE SEA LEVEL

REFERENCE:

Hancock Landing Project topographic map prepared by Clyde N. Eldridge Aerial Surveys, Feb 25/71

SCALE IN FEET

Contour intervals 5 ft and 25 ft

SOUTHERN COMPANY SERVICES, INC.
BIRMINGHAM, ALABAMA

GEORGIA POWER COMPANY
ALVIN W. VOGTLE NUCLEAR PLANT

TOP OF THE BEARING HORIZON (BLUE BLUFF MARL)

NO.	REVISIONS	DATE	DR	CHK	APPV	DTL
1						
0	ISSUED PER REA 96-VAA054	9-30-98	GS	RBH	CBH	WFP

SCALE: NONE

JOB NO. 10604

DRAWING NO. AX6DD377

REV 0

THIS DOCUMENT CONTAINS PROPRIETARY, CONFIDENTIAL, AND/OR TRADE SECRET INFORMATION OF THE SUBSIDIARIES OF THE SOUTHERN COMPANY OR OF THIRD PARTIES. IT IS INTENDED FOR USE ONLY BY EMPLOYEES OF, OR AUTHORIZED CONTRACTORS OF, THE SUBSIDIARIES OF THE SOUTHERN COMPANY. UNAUTHORIZED POSSESSION, USE, DISTRIBUTION, COPYING, DISSEMINATION, OR DISCLOSURE OF ANY PORTION HEREOF IS PROHIBITED.

CAD NAME AX6DD377 SIZE B 11x17

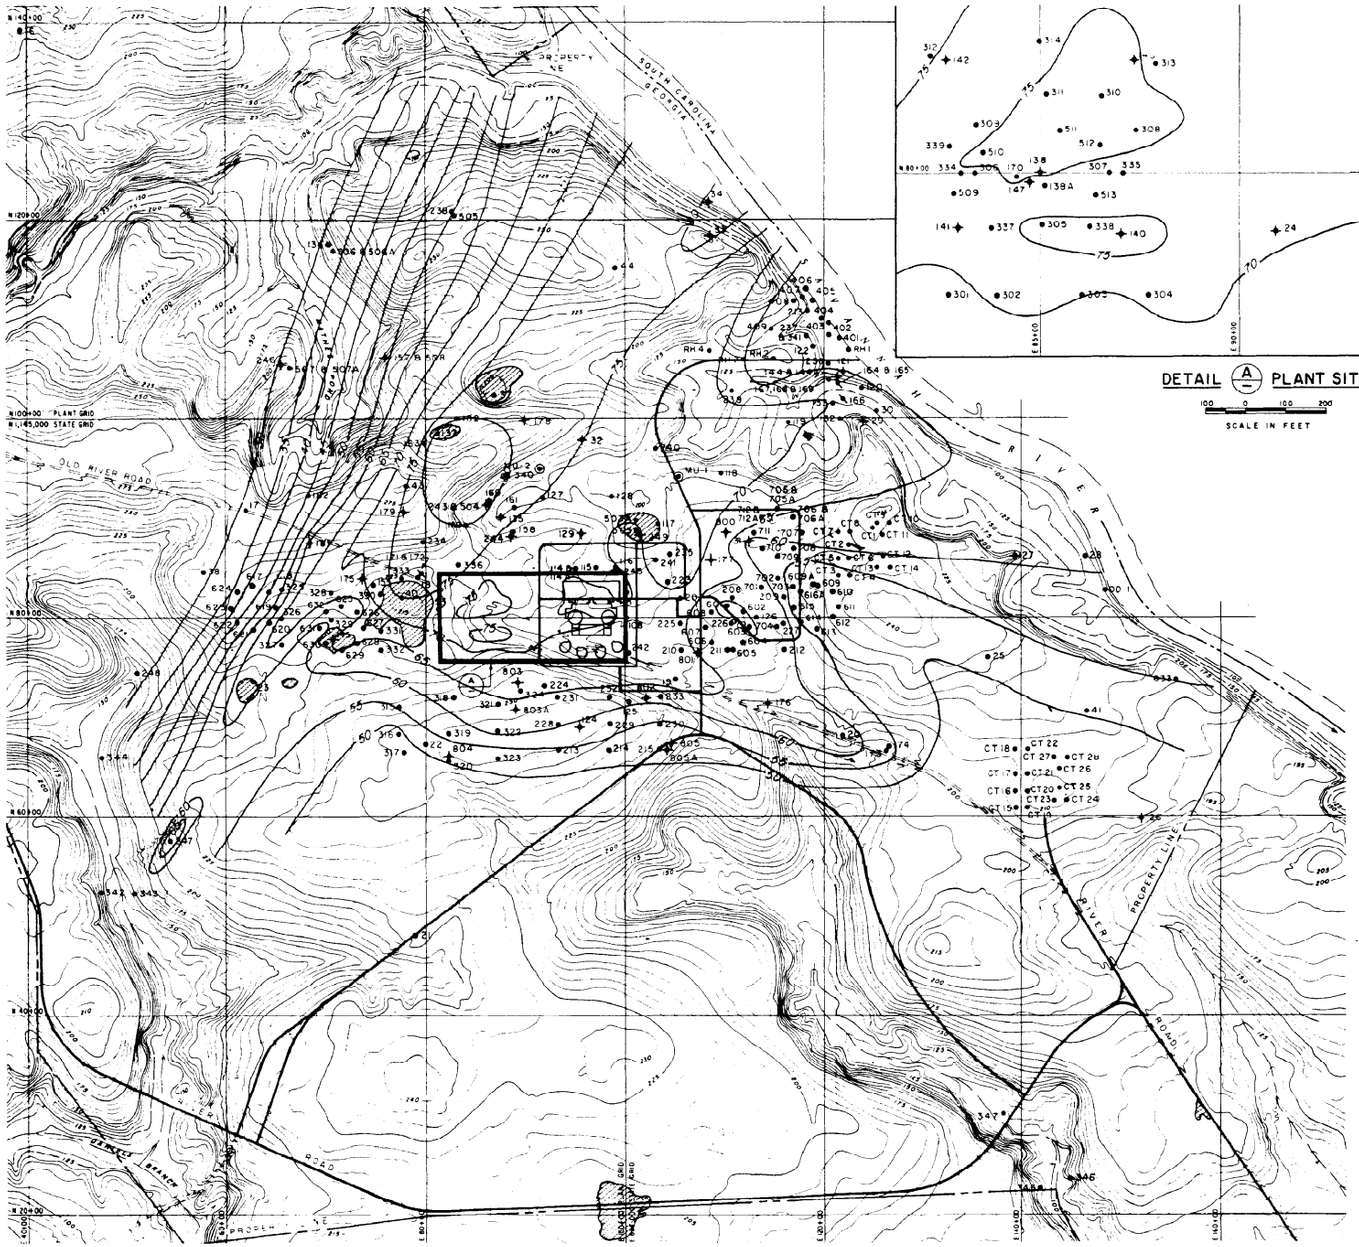

DETAIL (A) PLANT SITE

SCALE IN FEET

EXPLANATION

- 17 EXPLORATION HOLE
- 15 SEISMIC SURVEY HOLE
- 31 GROUND WATER OBSERVATION HOLE
- T-1 MAKE-UP WELL
- SURFACE DEPRESSION
- 10 CONTOURS OF THE TOP OF THE BEARING HORIZON IN FEET ABOVE SEA LEVEL

REFERENCE:

Hancock Landing Project topographic map prepared by Clyde N. Eldridge Aerial Surveys, Feb 25/71

SCALE IN FEET

Contour intervals 5 ft. and 25 ft.

SOUTHERN COMPANY SERVICES, INC.
BIRMINGHAM, ALABAMA

GEORGIA POWER COMPANY
ALVIN W. VOGTLE NUCLEAR PLANT

BOTTOM OF THE BEARING HORIZON (BLUE BLUFF MARL)

NO.	REVISIONS	DATE	DR	CHK	APPV	DTL
1						
0	ISSUED PER REA 96-VAA054	9-30-98	GS	RBH	CBH	WFP

SCALE: NONE | DRAWING NO. AX6DD378 | REV 0

JOB NO. 10604

THIS DOCUMENT CONTAINS PROPRIETARY, CONFIDENTIAL, AND/OR TRADE SECRET INFORMATION OF THE SUBSIDIARIES OF THE SOUTHERN COMPANY OR OF THIRD PARTIES. IT IS INTENDED FOR USE ONLY BY EMPLOYEES OF, OR AUTHORIZED CONTRACTORS OF, THE SUBSIDIARIES OF THE SOUTHERN COMPANY. UNAUTHORIZED POSSESSION, USE, DISTRIBUTION, COPYING, DISSEMINATION, OR DISCLOSURE OF ANY PORTION HEREOF IS PROHIBITED.

CAD NAME AX6DD378 SIZE B 11x17

BIRDWELL GEOPHYSICAL LOGS

HOLE NO. 501

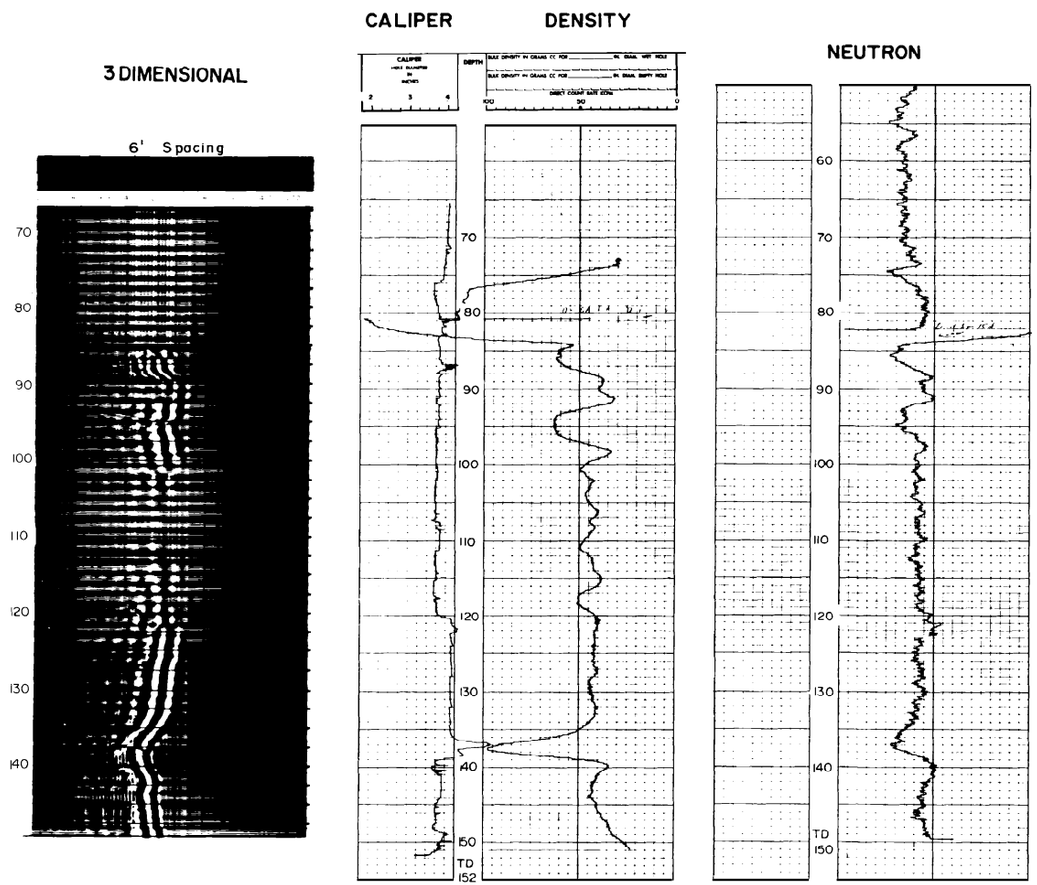

SOUTHERN COMPANY SERVICES, INC.
BIRMINGHAM, ALABAMA

GEORGIA POWER COMPANY
ALVIN W. VOGTLE NUCLEAR PLANT

GEOPHYSICAL LOGS
HOLE NO. 501

NO.	REVISIONS	DATE	DR	CHK	APPV	DTL
△0	ISSUED PER REA 96-VAA054	9-30-98	GS	RBH	CBH	WFP

SCALE: NONE

JOB NO. 10604

DRAWING NO. AX6DD379

REV 0

THIS DOCUMENT CONTAINS PROPRIETARY, CONFIDENTIAL, AND/OR TRADE SECRET INFORMATION OF THE SUBSIDIARIES OF THE SOUTHERN COMPANY OR OF THIRD PARTIES. IT IS INTENDED FOR USE ONLY BY EMPLOYEES OF, OR AUTHORIZED CONTRACTORS OF, THE SUBSIDIARIES OF THE SOUTHERN COMPANY. UNAUTHORIZED POSSESSION, USE, DISTRIBUTION, COPYING, DISSEMINATION, OR DISCLOSURE OF ANY PORTION HEREOF IS PROHIBITED.

CAD NAME AX6DD379

SIZE B 11x17

BIRDWELL GEOPHYSICAL LOGS

HOLE NO. 502

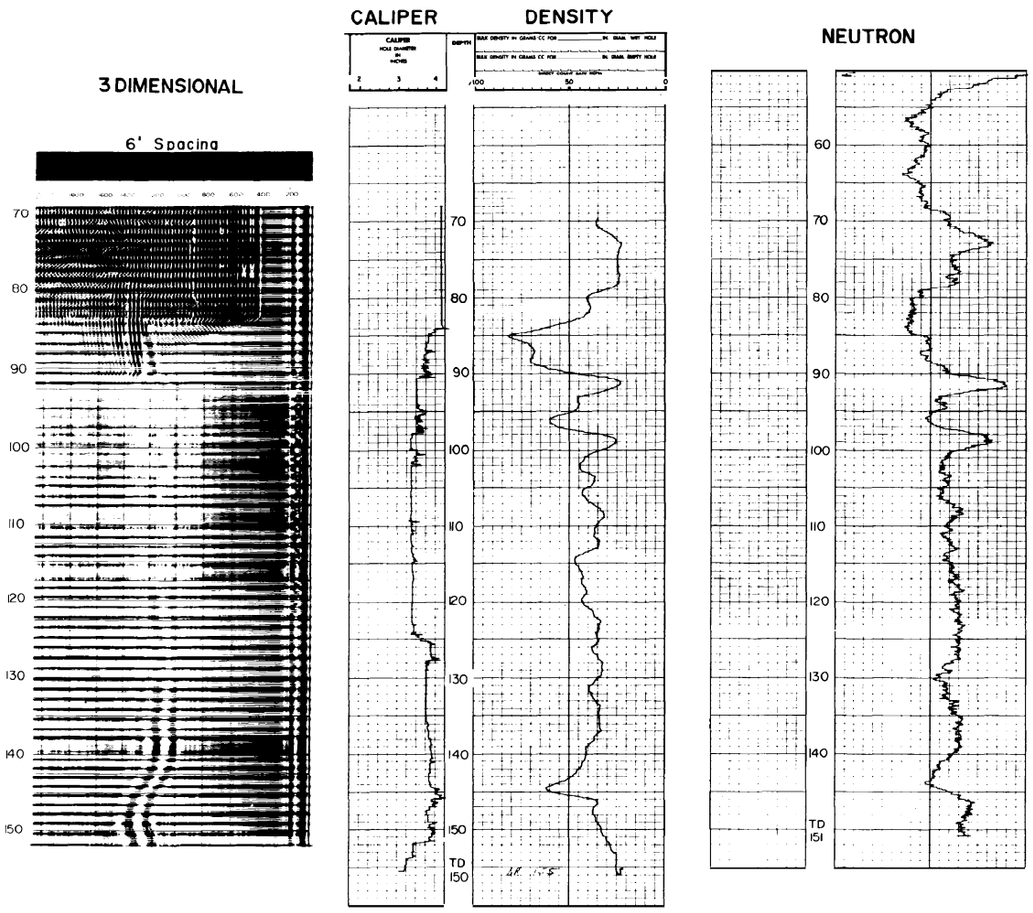

SOUTHERN COMPANY SERVICES, INC.
BIRMINGHAM, ALABAMA

GEORGIA POWER COMPANY
ALVIN W. VOGTLE NUCLEAR PLANT

GEOPHYSICAL LOGS
HOLE NO. 502

NO.	REVISIONS	DATE	DR	CHK	APPV	DTL
△						
0	ISSUED PER REA 96-VAA054	9-30-98	GS	RBH	CBH	WFP

SCALE: NONE

JOB NO. 10604

DRAWING NO. AX6DD380

REV 0

THIS DOCUMENT CONTAINS PROPRIETARY, CONFIDENTIAL, AND/OR TRADE SECRET INFORMATION OF THE SUBSIDIARIES OF THE SOUTHERN COMPANY OR OF THIRD PARTIES. IT IS INTENDED FOR USE ONLY BY EMPLOYEES OF, OR AUTHORIZED CONTRACTORS OF, THE SUBSIDIARIES OF THE SOUTHERN COMPANY. UNAUTHORIZED POSSESSION, USE, DISTRIBUTION, COPYING, DISSEMINATION, OR DISCLOSURE OF ANY PORTION HEREOF IS PROHIBITED.

CAD NAME AX6DD380 SIZE B 11x17

BIRDWELL GEOPHYSICAL LOGS

HOLE NO. 509

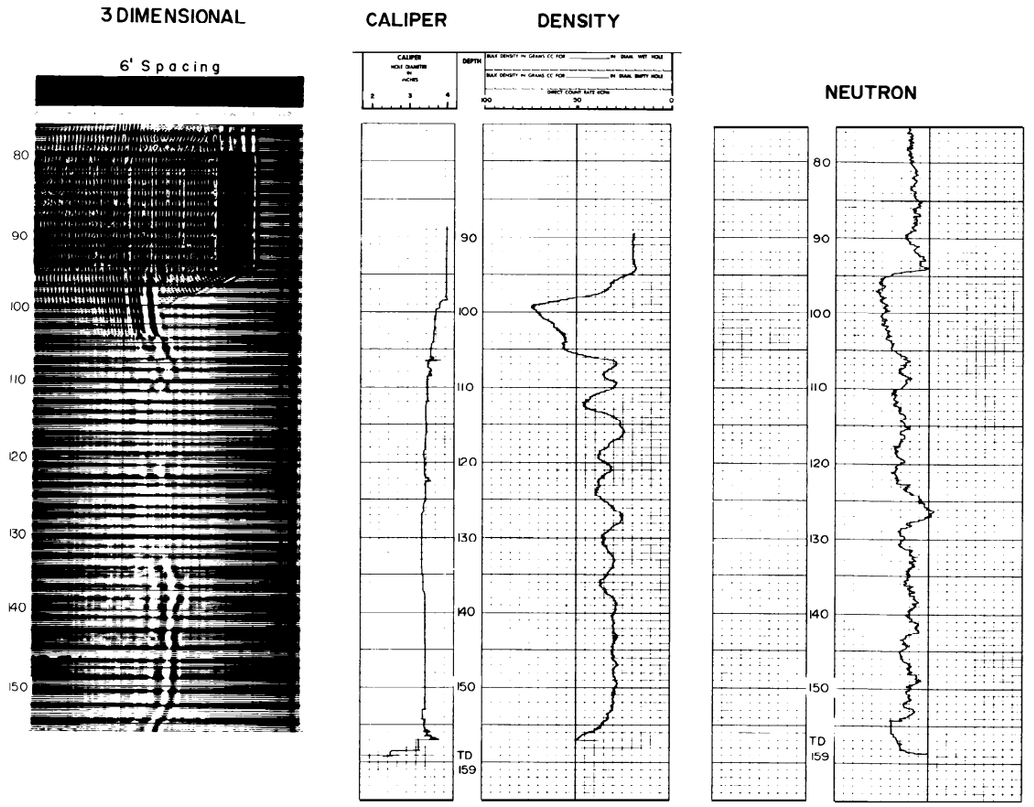

SOUTHERN COMPANY SERVICES, INC.
BIRMINGHAM, ALABAMA

GEORGIA POWER COMPANY
ALVIN W. VOGTLE NUCLEAR PLANT

GEOPHYSICAL LOGS
HOLE NO. 509

NO.	REVISIONS	DATE	DR	CHK	APPV	DTL
0	ISSUED PER REA 96-VAA054	9-30-98	GS	RBH	CBH	WFP

SCALE: NONE

JOB NO. 10604

DRAWING NO. AX6DD381

REV 0

THIS DOCUMENT CONTAINS PROPRIETARY, CONFIDENTIAL, AND/OR TRADE SECRET INFORMATION OF THE SUBSIDIARIES OF THE SOUTHERN COMPANY OR OF THIRD PARTIES. IT IS INTENDED FOR USE ONLY BY EMPLOYEES OF, OR AUTHORIZED CONTRACTORS OF, THE SUBSIDIARIES OF THE SOUTHERN COMPANY. UNAUTHORIZED POSSESSION, USE, DISTRIBUTION, COPYING, DISSEMINATION, OR DISCLOSURE OF ANY PORTION HEREOF IS PROHIBITED.

CAD NAME AX6DD381

SIZE B 11x17

BIRDWELL GEOPHYSICAL LOGS

HOLE NO. 513

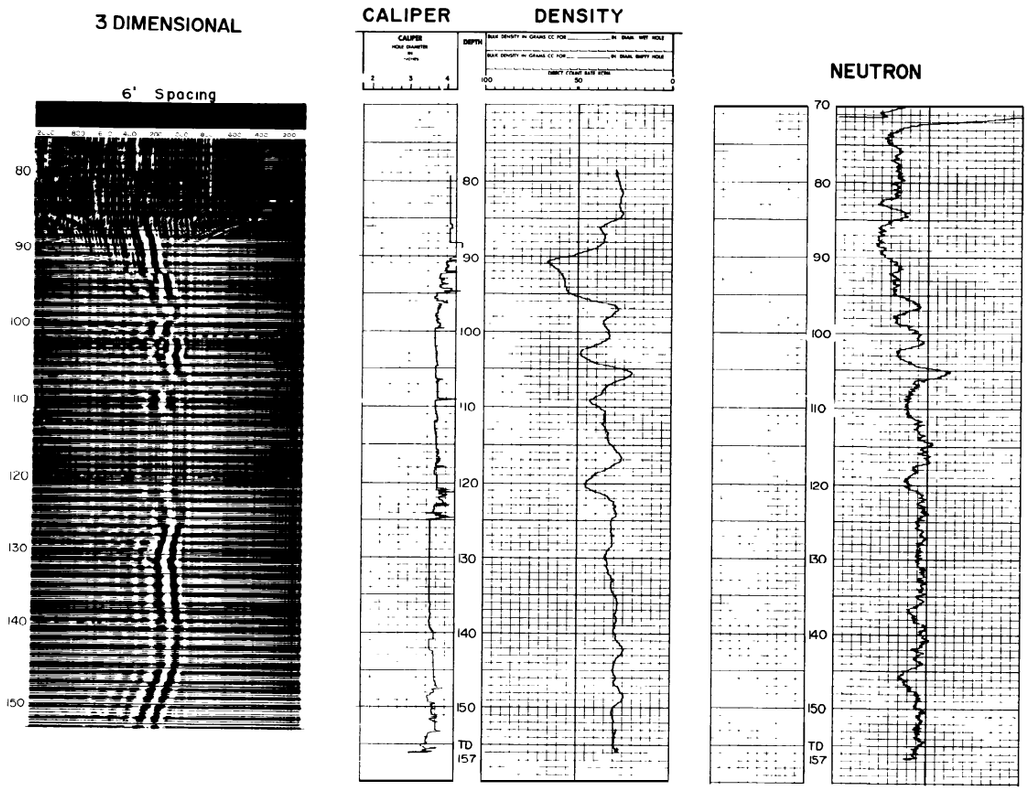

SOUTHERN COMPANY SERVICES, INC.
BIRMINGHAM, ALABAMA

GEORGIA POWER COMPANY
ALVIN W. VOGTLE NUCLEAR PLANT

GEOPHYSICAL LOGS
HOLE NO. 513

NO.	REVISIONS	DATE	DR	CHK	APPV	DTL
0	ISSUED PER REA 96-VAA054	9-30-98	GS	RBH	CBH	WFP

SCALE: NONE

JOB NO. 10604

DRAWING NO. AX6DD382

REV 0

THIS DOCUMENT CONTAINS PROPRIETARY, CONFIDENTIAL, AND/OR TRADE SECRET INFORMATION OF THE SUBSIDIARIES OF THE SOUTHERN COMPANY OR OF THIRD PARTIES. IT IS INTENDED FOR USE ONLY BY EMPLOYEES OF, OR AUTHORIZED CONTRACTORS OF, THE SUBSIDIARIES OF THE SOUTHERN COMPANY. UNAUTHORIZED POSSESSION, USE, DISTRIBUTION, COPYING, DISSEMINATION, OR DISCLOSURE OF ANY PORTION HEREOF IS PROHIBITED.

CAD NAME AX6DD382 SIZE B 11x17

BIRDWELL GEOPHYSICAL LOGS

HOLE NO. 516

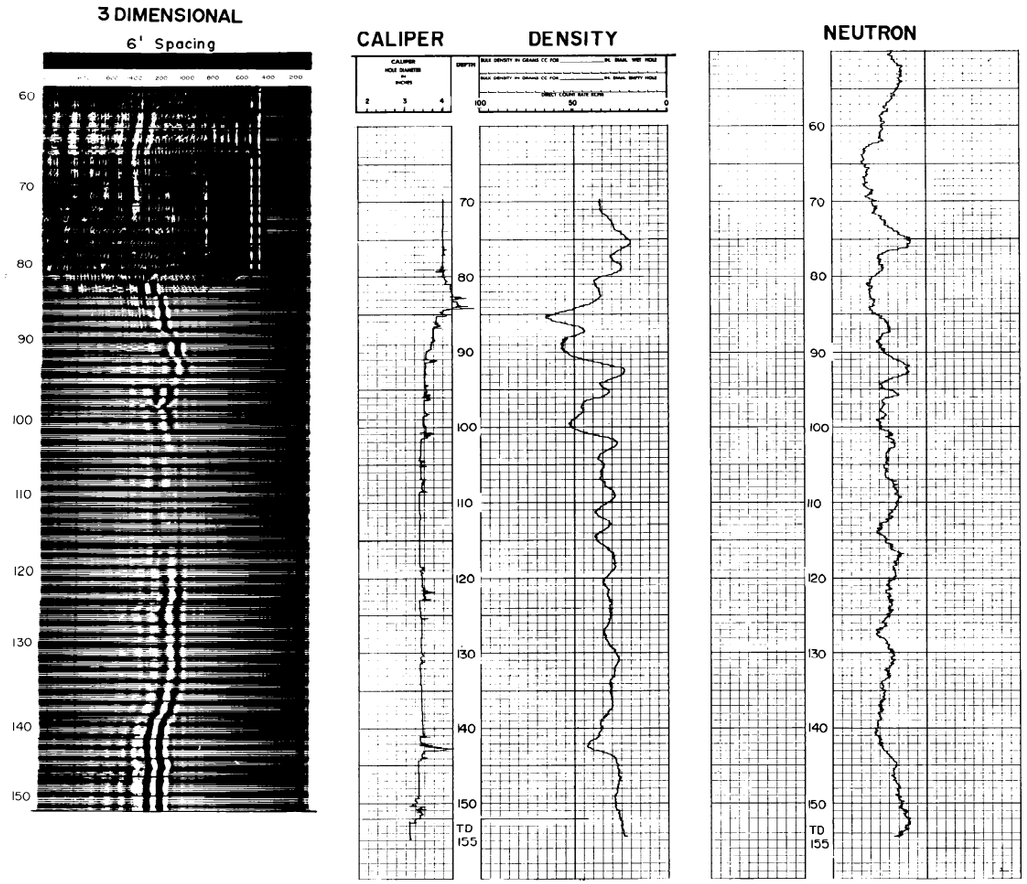

SOUTHERN COMPANY SERVICES, INC.
BIRMINGHAM, ALABAMA

GEORGIA POWER COMPANY
ALVIN W. VOGTLE NUCLEAR PLANT

GEOPHYSICAL LOGS
HOLE NO. 516

NO.	REVISIONS	DATE	DR	CHK	APPV	DTL
△						
0	ISSUED PER REA 96-VAA054	9-30-98	GS	RBH	CBH	WFP

SCALE: NONE

JOB NO. 10604

DRAWING NO. AX6DD383

REV 0

THIS DOCUMENT CONTAINS PROPRIETARY, CONFIDENTIAL, AND/OR TRADE SECRET INFORMATION OF THE SUBSIDIARIES OF THE SOUTHERN COMPANY OR OF THIRD PARTIES. IT IS INTENDED FOR USE ONLY BY EMPLOYEES OF, OR AUTHORIZED CONTRACTORS OF, THE SUBSIDIARIES OF THE SOUTHERN COMPANY. UNAUTHORIZED POSSESSION, USE, DISTRIBUTION, COPYING, DISSEMINATION, OR DISCLOSURE OF ANY PORTION HEREOF IS PROHIBITED.

CAD NAME AX6DD383 SIZE B 11x17

BIRDWELL GEOPHYSICAL LOGS

HOLE NO. 523

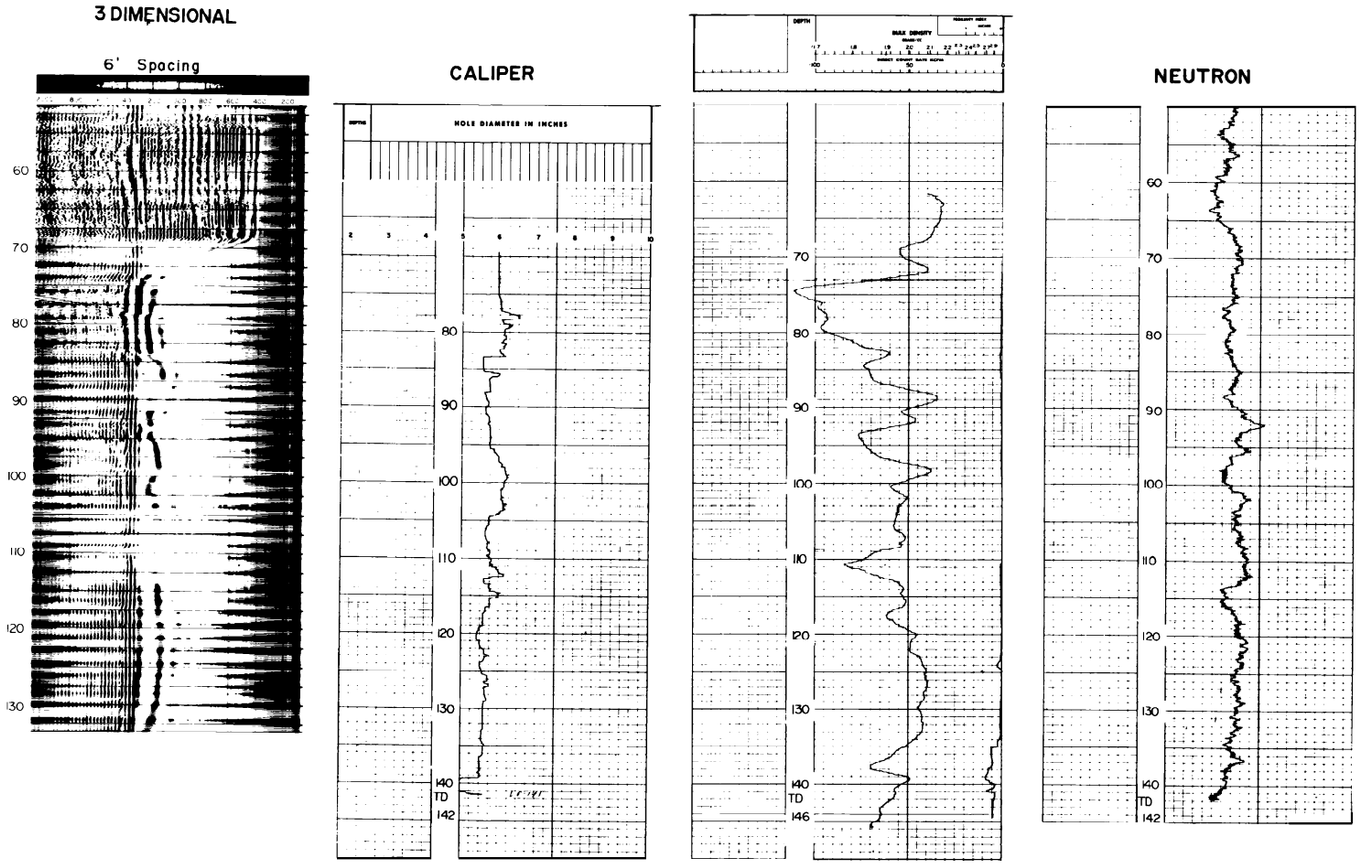

SOUTHERN COMPANY SERVICES, INC.
BIRMINGHAM, ALABAMA

GEORGIA POWER COMPANY
ALVIN W. VOGTLE NUCLEAR PLANT

GEOPHYSICAL LOGS
HOLE NO. 523

NO.	REVISIONS	DATE	DR	CHK	APPV	DTL
0	ISSUED PER REA 96-VAA054	9-30-98	GS	RBH	CBH	WFP

SCALE: NONE

JOB NO. 10604

DRAWING NO. AX6DD384

REV 0

THIS DOCUMENT CONTAINS PROPRIETARY, CONFIDENTIAL, AND/OR TRADE SECRET INFORMATION OF THE SUBSIDIARIES OF THE SOUTHERN COMPANY OR OF THIRD PARTIES. IT IS INTENDED FOR USE ONLY BY EMPLOYEES OF, OR AUTHORIZED CONTRACTORS OF, THE SUBSIDIARIES OF THE SOUTHERN COMPANY. UNAUTHORIZED POSSESSION, USE, DISTRIBUTION, COPYING, DISSEMINATION, OR DISCLOSURE OF ANY PORTION HEREOF IS PROHIBITED.

CAD NAME AX6DD384 SIZE B 11x17

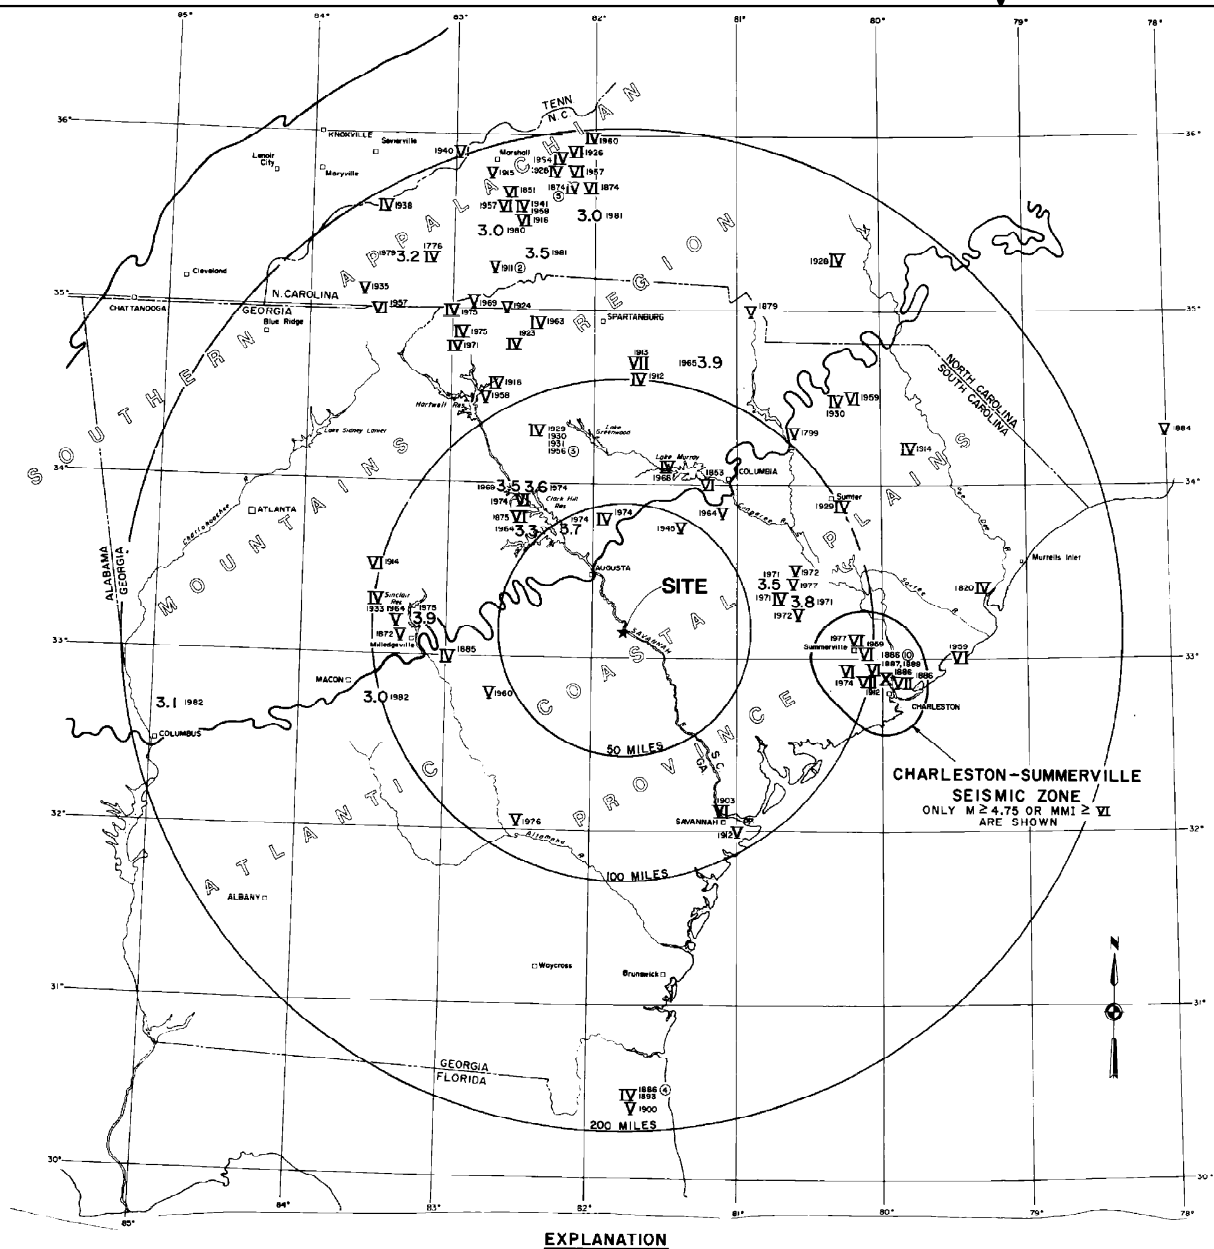

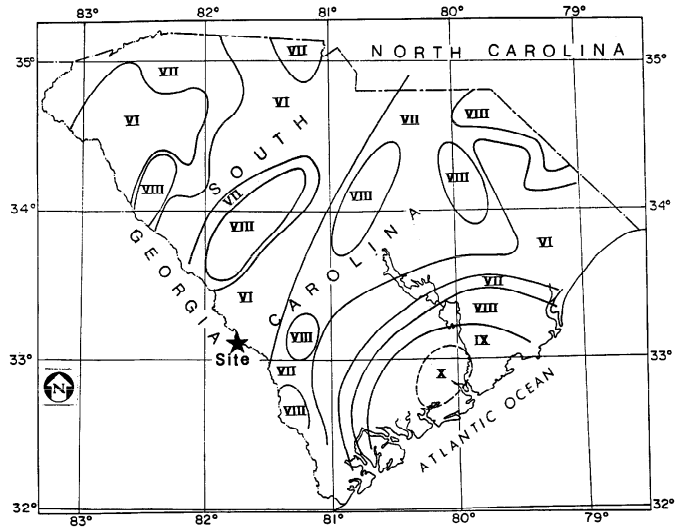

ISOSEISMAL MAP

EXPLANATION

Detailed isoseismal map for the State of South Carolina for the 1886 Charleston earthquake.

REFERENCE:

G. A. Bollinger, 1977.

EXPLANATION

———	Boundary of seismic source-areas used in site analysis.
V 1972	Modified Mercalli intensity plotted at the earthquake epicenter. Year of occurrence noted with a small arabic numeral.
3.3 1979	Magnitude plotted at the earthquake epicenter. Year of occurrence noted as for intensity.

All earthquakes between 1776 and 1982 with intensity greater than or equal to IV or magnitude greater than or equal 3.0 are shown. When both magnitude and intensity data were available, epicentral intensity was plotted.

Epicentral coordinates and a list of sources cited are in Table 2.5.2-1.

Circled numbers indicate multiple occurrences at the same location.

NO.	REVISIONS	DATE	DR	CHK	APPV	DTL
△						
△						
△						
0	ISSUED PER REA 96-VAA054	9-30-98	GS	RBH	CBH	WFP

SOUTHERN COMPANY SERVICES, INC.
BIRMINGHAM, ALABAMA

GEORGIA POWER COMPANY
ALVIN W. VOGTLE NUCLEAR PLANT

SIGNIFICANT SEISMICITY 1776-1982

SCALE: NONE	DRAWING NO.	REV.
JOB NO. 10604	AX6DD385	0

THIS DOCUMENT CONTAINS PROPRIETARY, CONFIDENTIAL, AND/OR TRADE SECRET INFORMATION OF THE SUBSIDIARIES OF THE SOUTHERN COMPANY OR OF THIRD PARTIES. IT IS INTENDED FOR USE ONLY BY EMPLOYEES OF, OR AUTHORIZED CONTRACTORS OF, THE SUBSIDIARIES OF THE SOUTHERN COMPANY. UNAUTHORIZED POSSESSION, USE, DISTRIBUTION, COPYING, DISSEMINATION, OR DISCLOSURE OF ANY PORTION HEREOF IS PROHIBITED.

SIZE C 17X22 CAD NAME AX6DD385

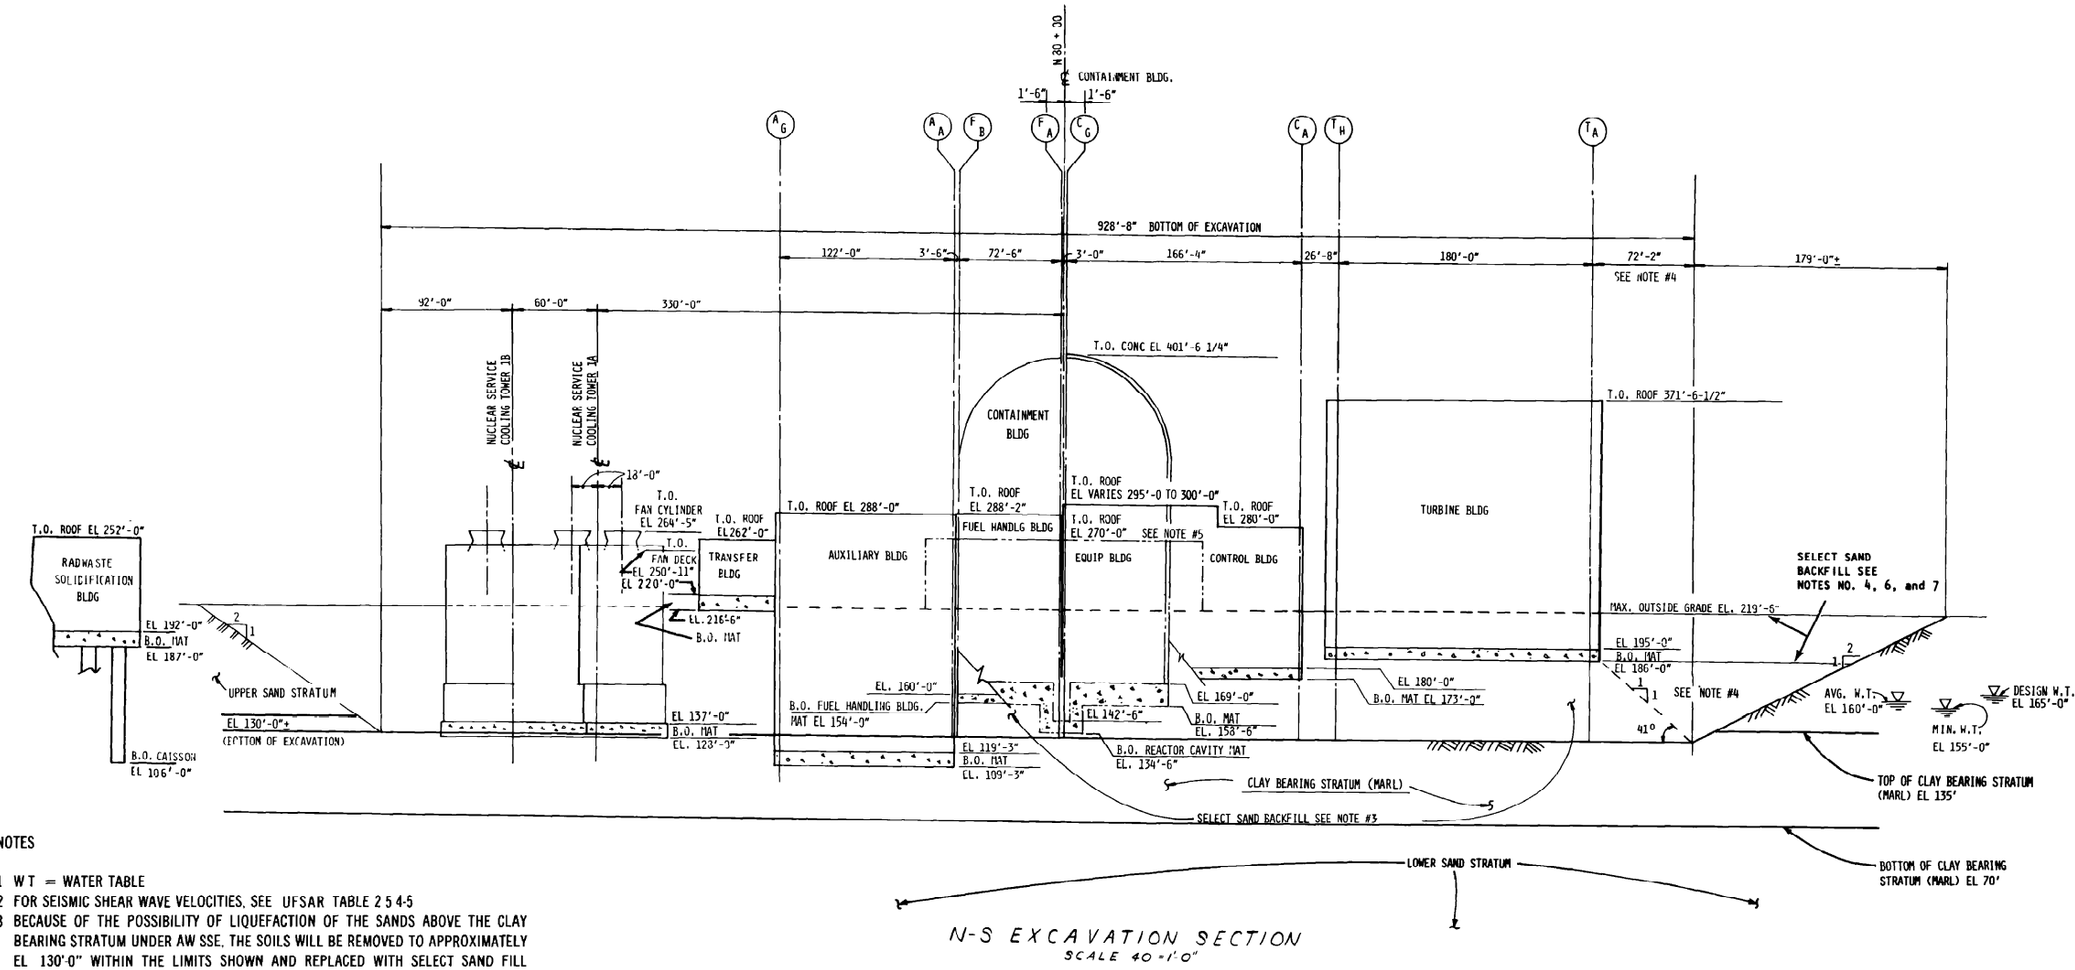

N-S EXCAVATION SECTION
SCALE 40 = 1'0"

NOTES

1 W T = WATER TABLE
2 FOR SEISMIC SHEAR WAVE VELOCITIES, SEE UFSAR TABLE 2 5 4-5
3 BECAUSE OF THE POSSIBILITY OF LIQUEFACTION OF THE SANDS ABOVE THE CLAY BEARING STRATUM UNDER AW SSE, THE SOILS WILL BE REMOVED TO APPROXIMATELY EL 130'0" WITHIN THE LIMITS SHOWN AND REPLACED WITH SELECT SAND FILL COMPACTED TO 97 PERCENT OF THE MAXIMUM DENSITY DETERMINED BY ASTM DESIGNATION D1557 EXCEPT IN THE AREAS WHERE LEAN CONCRETE IS DESIGNATED SEE **NOTES 4,6,7.**
4 DUE TO REMOTENESS FROM CATEGORY 1 STRUCTURES AND LOCATION ABOVE WATER TABLE, SELECT SAND BACKFILL NORTH OF THE TURBINE BUILDING AND ABOVE ELEVATION 185'-6" WILL BE COMPACTED TO 95% OF MAXIMUM DENSITY DETERMINED BY ASTM DESIGNATION D1557
5 REQUIRED SLOPE = 1:1 MIN AND THIS SLOPE SHOULD BE 1-1/2 HORIZONTAL TO 1 VERTICAL IF THE ADJACENT FILL IS NOT PLACED AT THE SAME TIME
6 DUE TO REMOTENESS FROM CATEGORY 1 STRUCTURES AND LOCATION ABOVE WATER TABLE CATEGORY 2 MATERIAL COMPACTED TO 95% OF THE MAXIMUM DENSITY DETERMINED BY ASTM D1557 WILL BE PLACED ABOVE THE IN-SITU SLOPES FORMING THE WEST SIDE OF THE POWER BLOCK EXCAVATION ABOVE 206
7 UP TO 24 IN OF GRADED AGGREGATE MATERIAL COMPACTED TO 97% OF THE MAXIMUM DENSITY DETERMINED IN ACCORDANCE WITH ASTM D1557 WILL BE SUBSTITUTED FOR SAND AND SILTY SAND BACKFILL AS THE FILL IS BROUGHT TO GRADE
8 APPROXIMATELY 2 5 FT OF UNDOCUMENTED FILL HAS BEEN LEFT IN PLACE BENEATH A CONCRETE SLAB LOCATED AT GRADE ABOVE THE IN-SITU EXCAVATION SLOPE SOUTH OF THE UNIT 2 NSCW TOWERS.

NO.	REVISIONS	DATE	DR	CHK	APPV	DTL
△						
0	ISSUED PER REA 96-VAA054	9-30-98	GS	RBH	CBH	WFP

SOUTHERN COMPANY SERVICES, INC.
BIRMINGHAM, ALABAMA

GEORGIA POWER COMPANY
ALVIN W. VOGTLE NUCLEAR PLANT

POWER BLOCK CROSS-SECTION

SCALE: NONE	DRAWING NO.	REV
JOB NO. 10604	AX6DD386	0

THIS DOCUMENT CONTAINS PROPRIETARY, CONFIDENTIAL, AND/OR TRADE SECRET INFORMATION OF THE SUBSIDIARIES OF THE SOUTHERN COMPANY OR OF THIRD PARTIES. IT IS INTENDED FOR USE ONLY BY EMPLOYEES OF, OR AUTHORIZED CONTRACTORS OF, THE SUBSIDIARIES OF THE SOUTHERN COMPANY. UNAUTHORIZED POSSESSION, USE, DISTRIBUTION, COPYING, DISSEMINATION, OR DISCLOSURE OF ANY PORTION HEREOF IS PROHIBITED.

CAD NAME AX6DD386 SIZE B 11x17

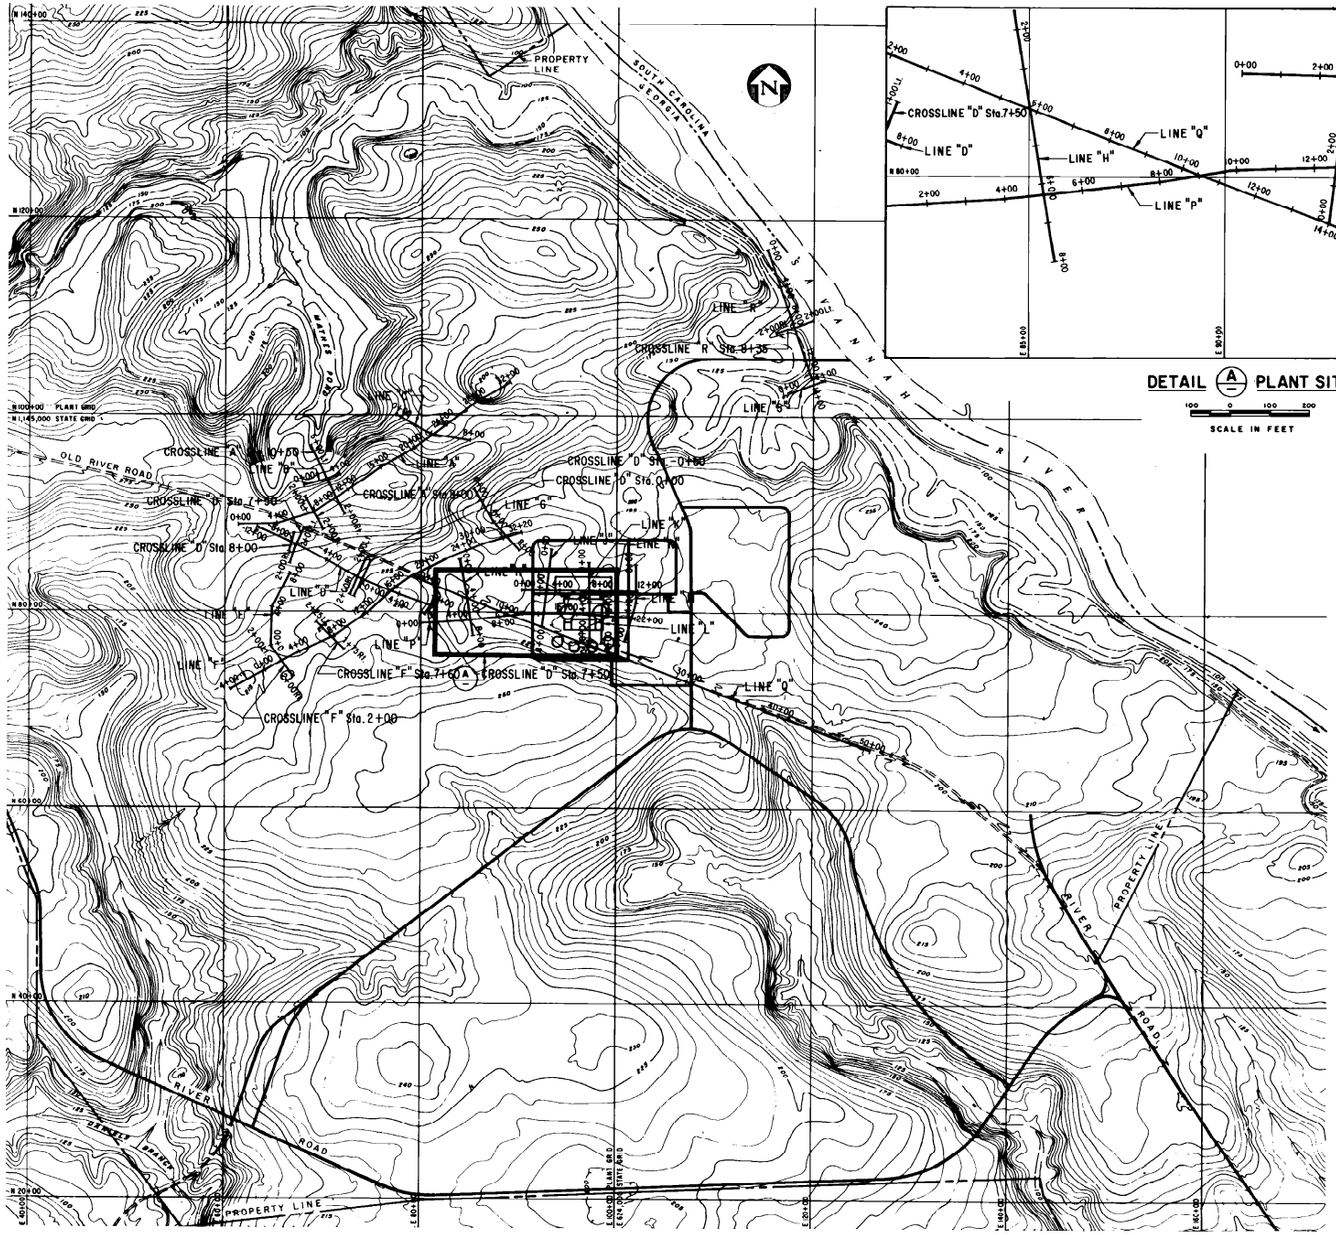

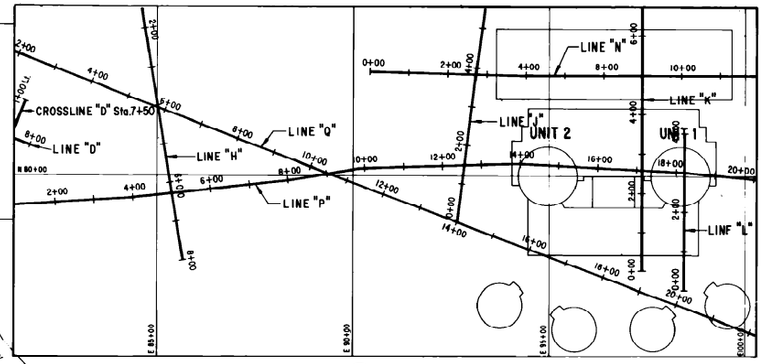

DETAIL (A) PLANT SITE

SCALE IN FEET

NOTE:

FOR SEISMIC PROFILES SEE DRAWINGS AX6DD388 THRU AX6DD393

REFERENCE:

Hancock Landing Project topographic map prepared by Clyde N. Eldridge Aerial Surveys, Feb 25/71

SCALE IN FEET

Contour intervals 5 ft. and 25 ft.

SOUTHERN COMPANY SERVICES, INC.
BIRMINGHAM, ALABAMA

GEORGIA POWER COMPANY
ALVIN W. VOGTLE NUCLEAR PLANT

SITE MAP AND LOCATION OF SEISMIC LINES

NO.	REVISIONS	DATE	DR	CHK	APPV	DTL
1						
0	ISSUED PER REA 96-VAA054	9-30-98	GS	RBH	CBH	WFP

SCALE: NONE

JOB NO. 10604

DRAWING NO. AX6DD387

REV 0

THIS DOCUMENT CONTAINS PROPRIETARY, CONFIDENTIAL, AND/OR TRADE SECRET INFORMATION OF THE SUBSIDIARIES OF THE SOUTHERN COMPANY OR OF THIRD PARTIES. IT IS INTENDED FOR USE ONLY BY EMPLOYEES OF, OR AUTHORIZED CONTRACTORS OF, THE SUBSIDIARIES OF THE SOUTHERN COMPANY. UNAUTHORIZED POSSESSION, USE, DISTRIBUTION, COPYING, DISSEMINATION, OR DISCLOSURE OF ANY PORTION HEREOF IS PROHIBITED.

CAD NAME AX6DD387

SIZE B 11x17

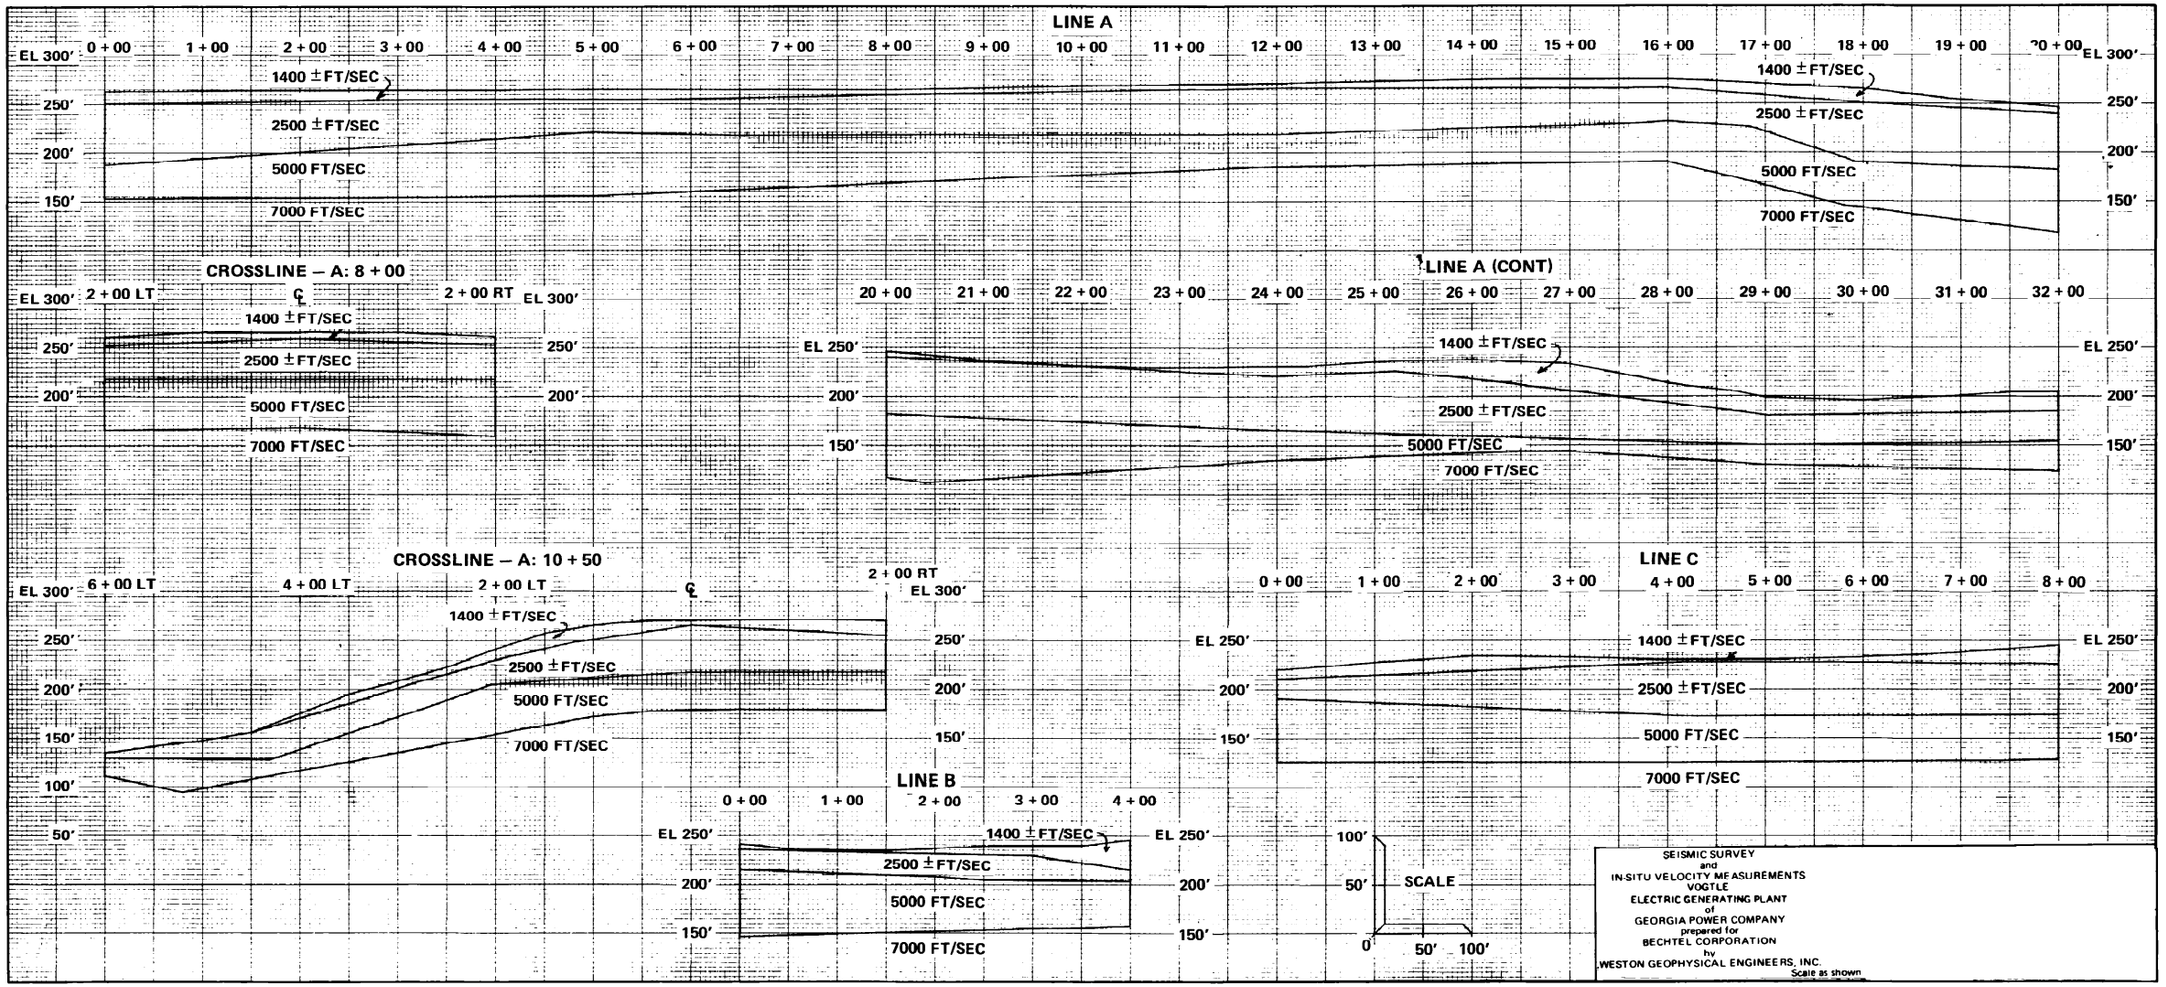

NOTE:

1. FOR PROFILE LOCATIONS SEE DRAWING AX6DD387.

SOUTHERN COMPANY SERVICES, INC.
BIRMINGHAM, ALABAMA

GEORGIA POWER COMPANY
ALVIN W. VOGTLE NUCLEAR PLANT

SEISMIC PROFILES LINES A, B, AND C

NO.	REVISIONS	DATE	DR	CHK	APPV	DTL
△						
0	ISSUED PER REA 96-VAA054	9-30-98	GS	RBH	CBH	WFP

SCALE: NONE

JOB NO. 10604

DRAWING NO. AX6DD388

REV 0

THIS DOCUMENT CONTAINS PROPRIETARY, CONFIDENTIAL, AND/OR TRADE SECRET INFORMATION OF THE SUBSIDIARIES OF THE SOUTHERN COMPANY OR OF THIRD PARTIES. IT IS INTENDED FOR USE ONLY BY EMPLOYEES OF, OR AUTHORIZED CONTRACTORS OF, THE SUBSIDIARIES OF THE SOUTHERN COMPANY. UNAUTHORIZED POSSESSION, USE, DISTRIBUTION, COPYING, DISSEMINATION, OR DISCLOSURE OF ANY PORTION HEREOF IS PROHIBITED.

CAD NAME AX6DD388

SIZE B 11x17

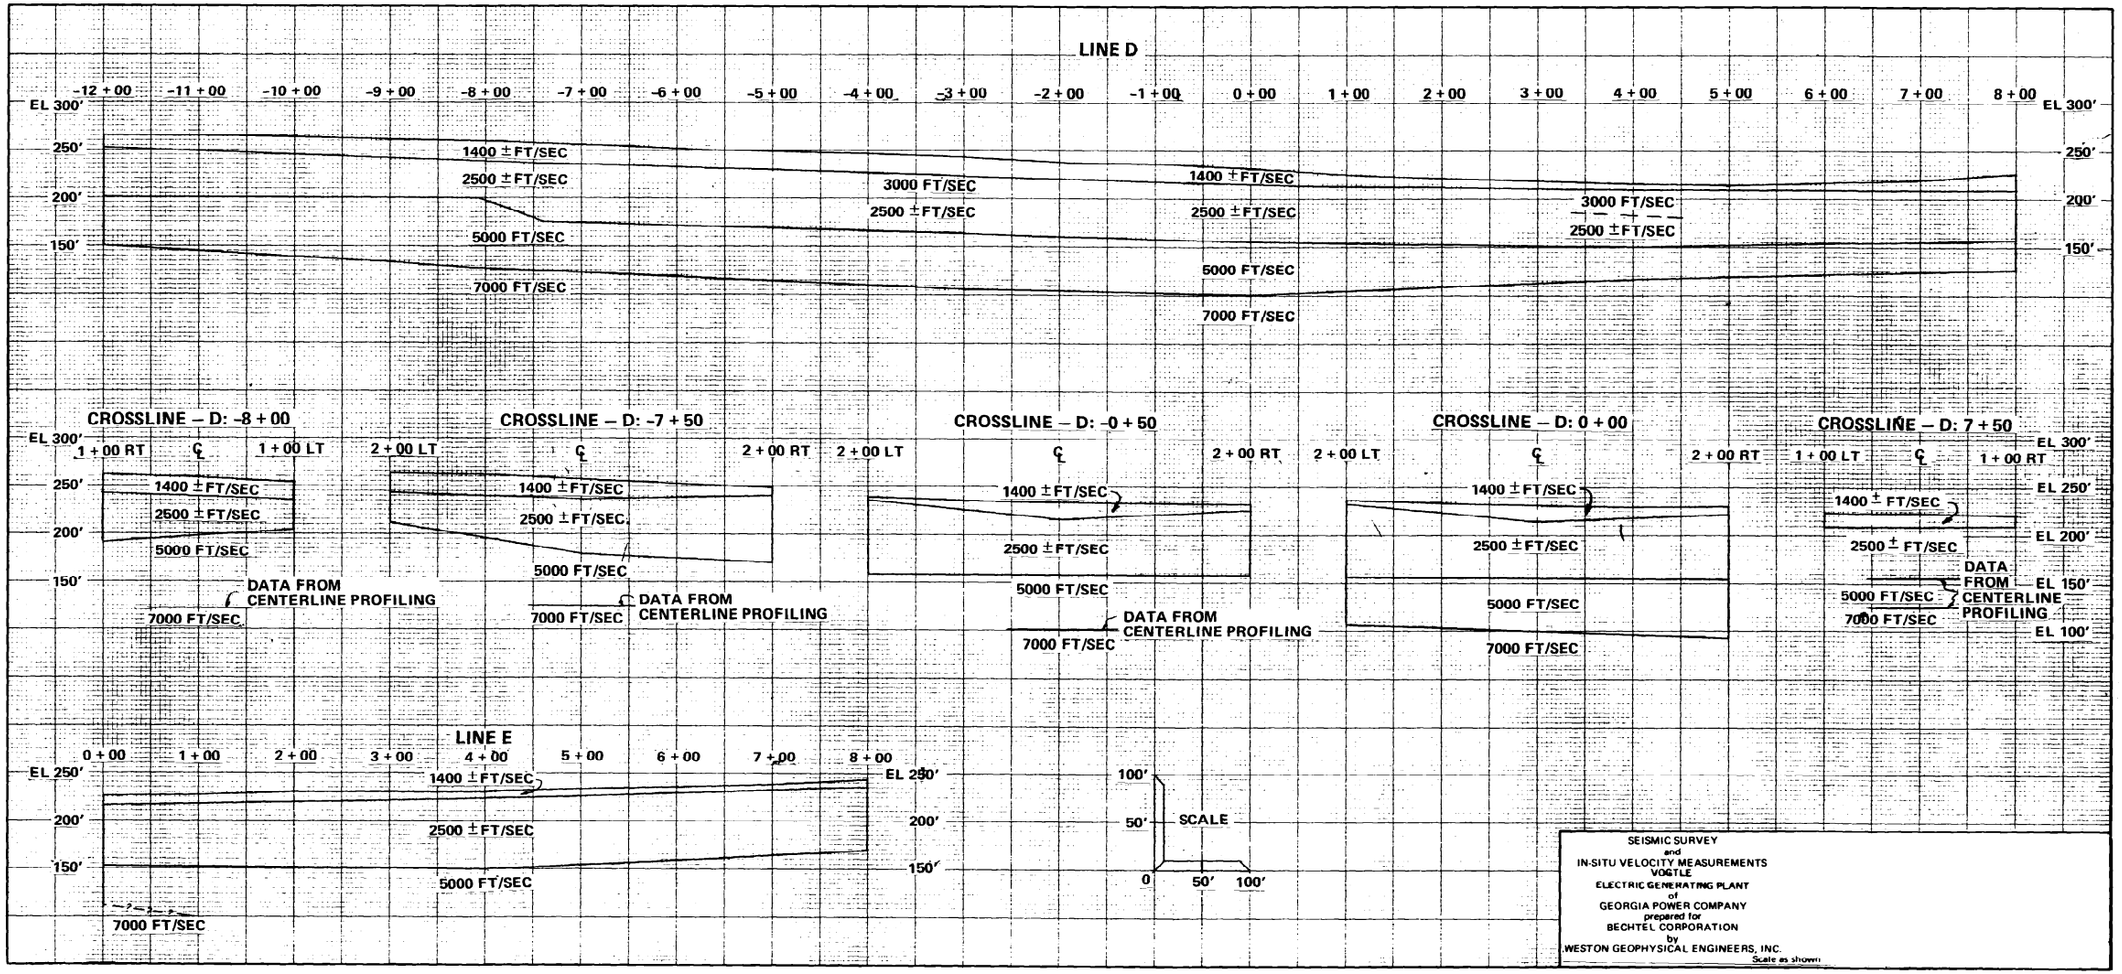

NOTE:

1. FOR PROFILE LOCATIONS SEE DRAWING AX6DD387.

SOUTHERN COMPANY SERVICES, INC.
BIRMINGHAM, ALABAMA

GEORGIA POWER COMPANY
ALVIN W. VOGTLE NUCLEAR PLANT

SEISMIC PROFILES LINES D AND E

NO.	REVISIONS	DATE	DR	CHK	APPV	DTL
△						
0	ISSUE PER REA 96-VAA054	9-30-98	GS	RBH	CBH	WFP

SCALE: NONE

JOB NO. 10604

DRAWING NO. AX6DD389

REV 0

THIS DOCUMENT CONTAINS PROPRIETARY, CONFIDENTIAL, AND/OR TRADE SECRET INFORMATION OF THE SUBSIDIARIES OF THE SOUTHERN COMPANY OR OF THIRD PARTIES. IT IS INTENDED FOR USE ONLY BY EMPLOYEES OF, OR AUTHORIZED CONTRACTORS OF, THE SUBSIDIARIES OF THE SOUTHERN COMPANY. UNAUTHORIZED POSSESSION, USE, DISTRIBUTION, COPYING, DISSEMINATION, OR DISCLOSURE OF ANY PORTION HEREOF IS PROHIBITED.

CAD NAME AX6DD389

SIZE B 11x17

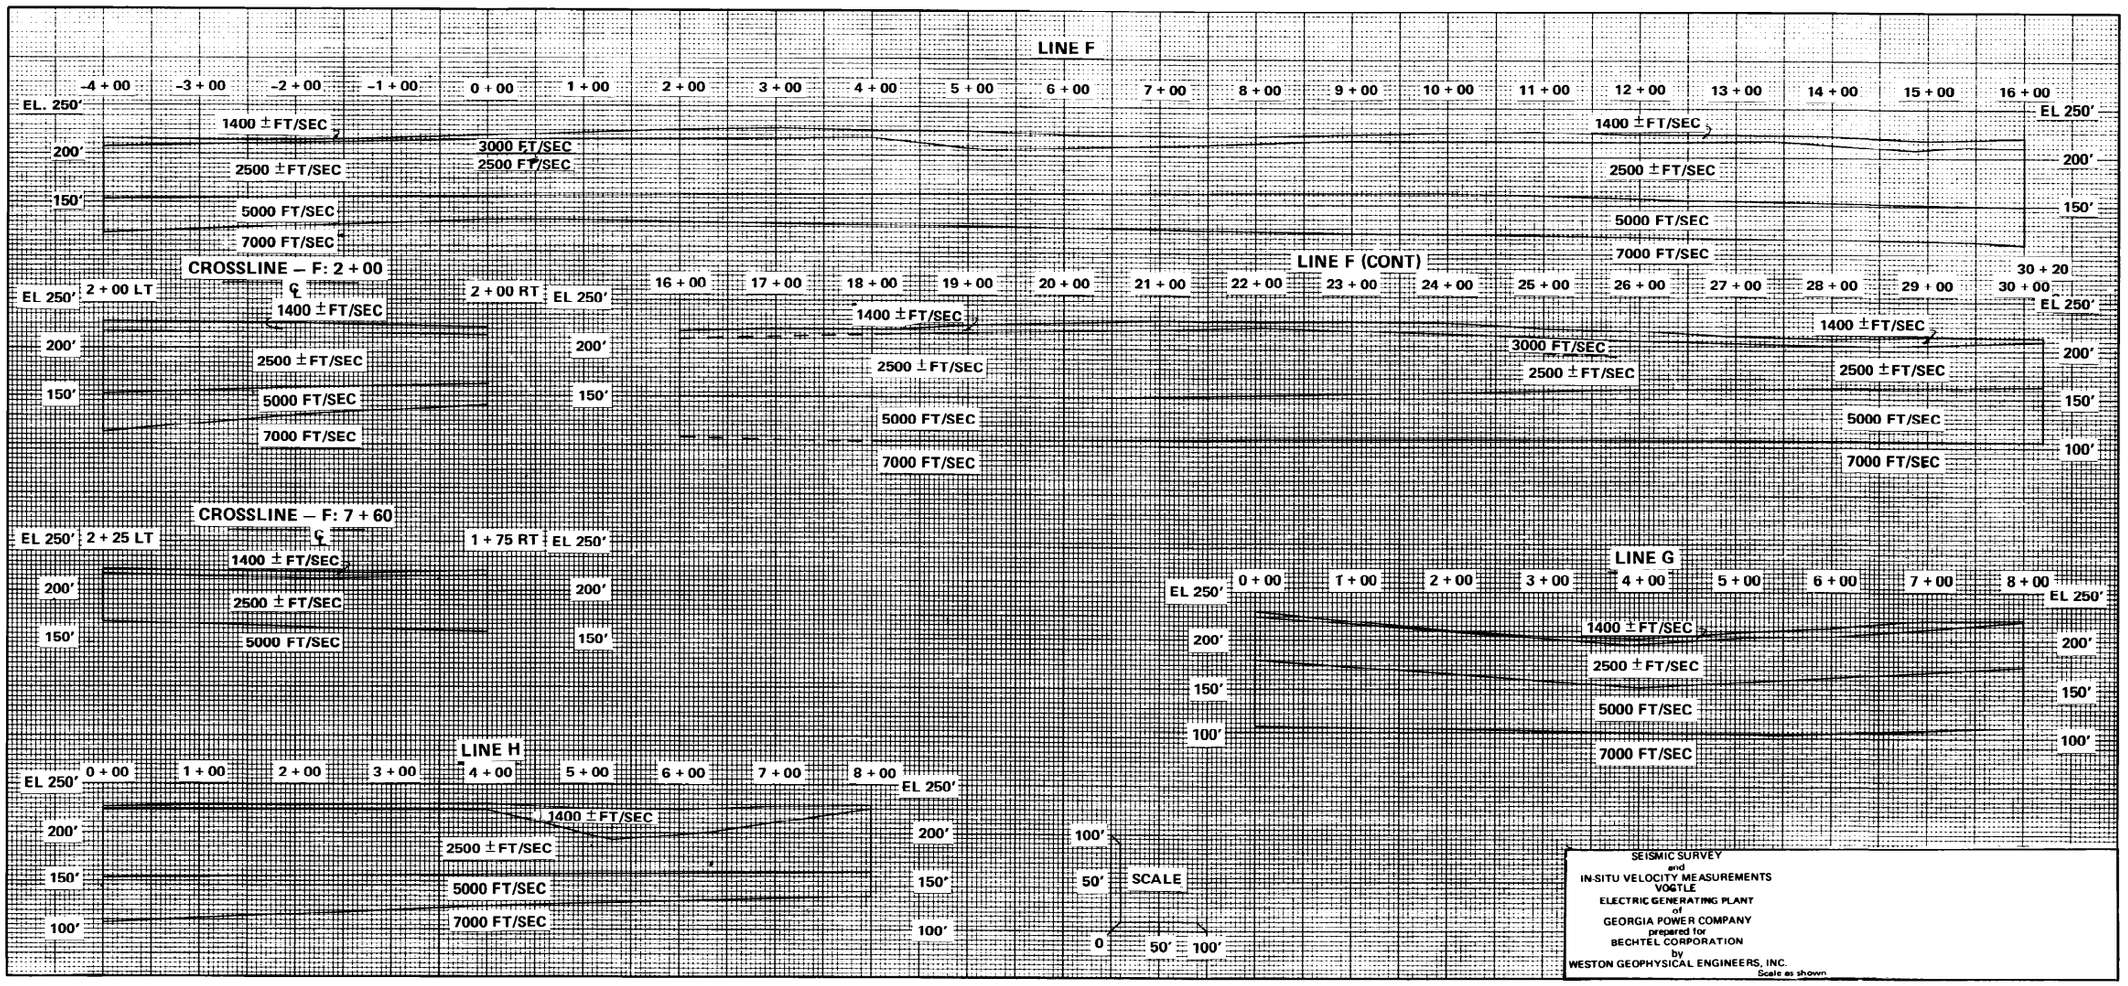

NOTE:

1. FOR PROFILE LOCATIONS SEE DRAWING AX6DD387.

SOUTHERN COMPANY SERVICES, INC.
BIRMINGHAM, ALABAMA

GEORGIA POWER COMPANY
ALVIN W. VOGTLE NUCLEAR PLANT

SEISMIC PROFILES LINES F, G AND H

NO.	REVISIONS	DATE	DR	CHK	APPV	DTL
0	ISSUED PER REA 96-VAA054	9-30-98	GS	RBH	CBH	WFP

SCALE: NONE

JOB NO. 10604

DRAWING NO. AX6DD390

REV 0

THIS DOCUMENT CONTAINS PROPRIETARY, CONFIDENTIAL, AND/OR TRADE SECRET INFORMATION OF THE SUBSIDIARIES OF THE SOUTHERN COMPANY OR OF THIRD PARTIES. IT IS INTENDED FOR USE ONLY BY EMPLOYEES OF, OR AUTHORIZED CONTRACTORS OF, THE SUBSIDIARIES OF THE SOUTHERN COMPANY. UNAUTHORIZED POSSESSION, USE, DISTRIBUTION, COPYING, DISSEMINATION, OR DISCLOSURE OF ANY PORTION HEREOF IS PROHIBITED.

CAD NAME AX6DD390

SIZE B 11x17

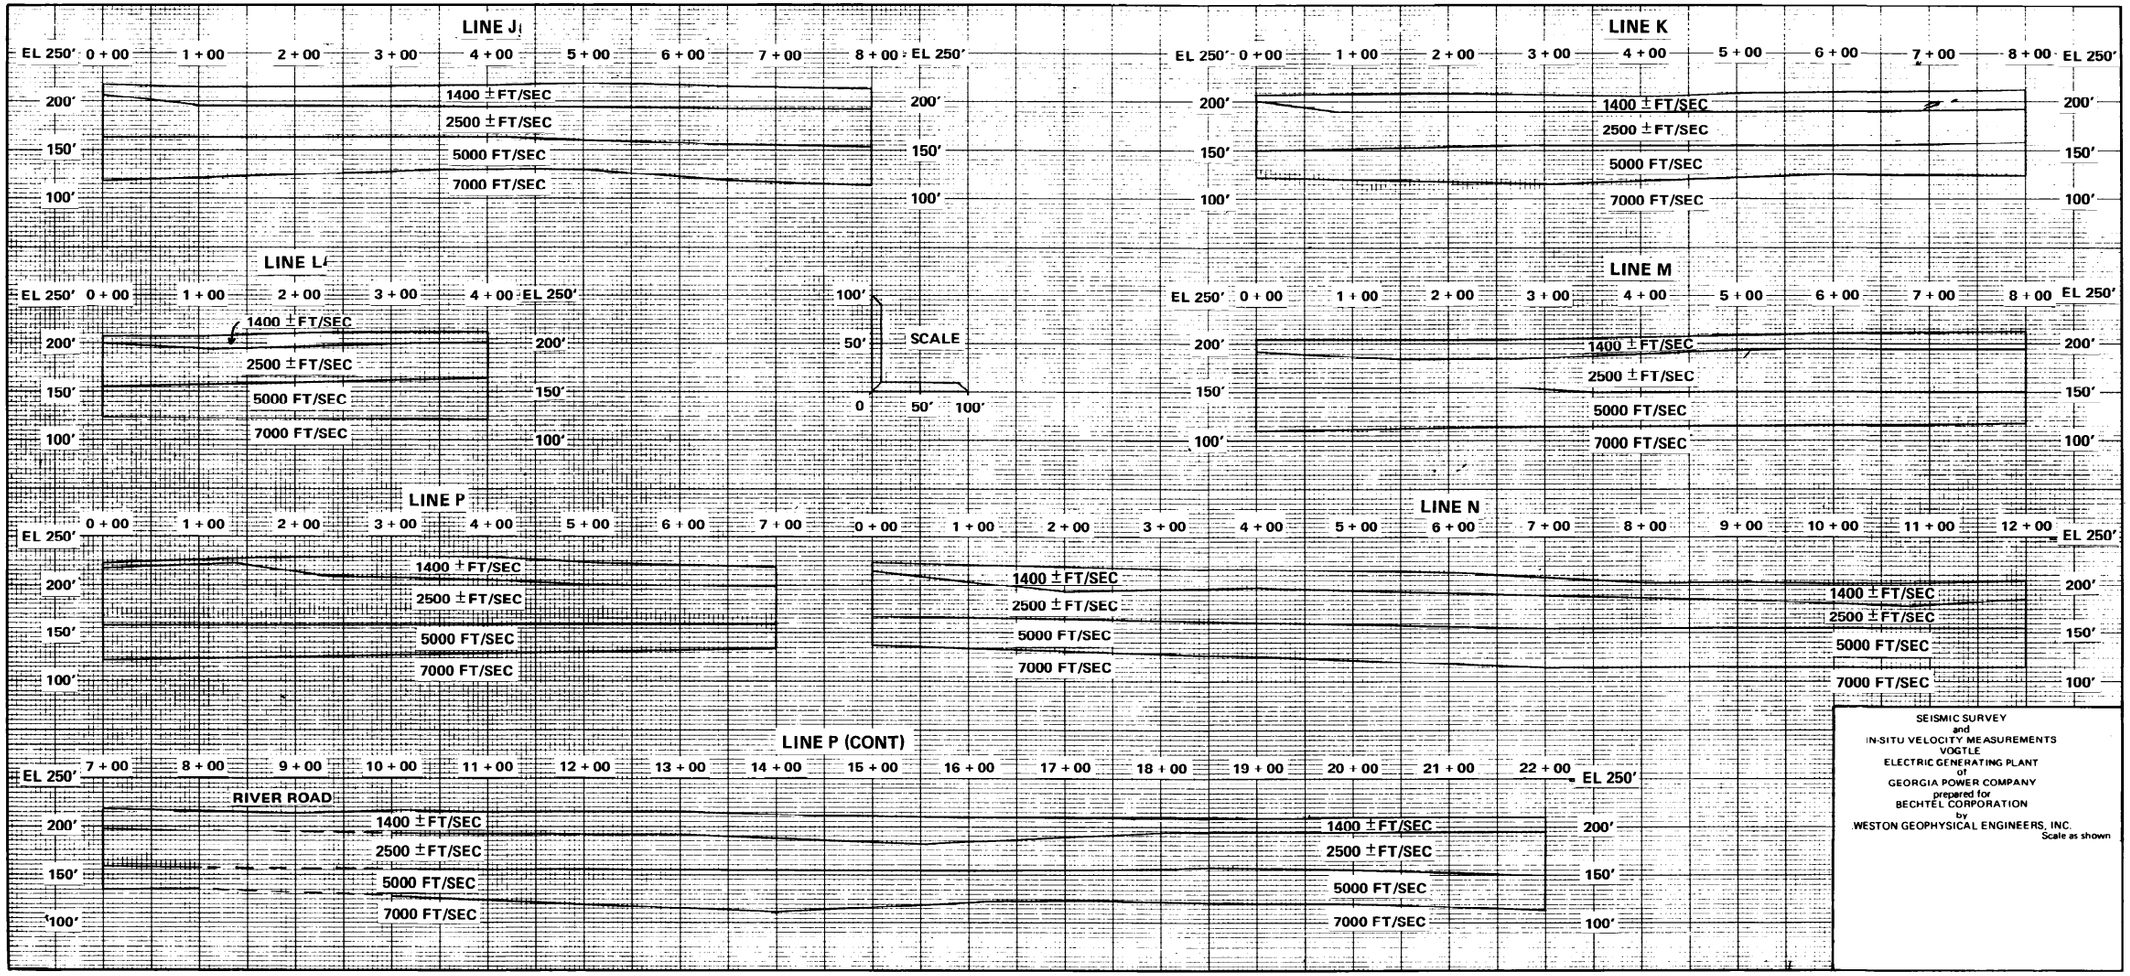

NOTE:

1. FOR PROFILE LOCATIONS SEE DRAWING AX6DD387.

SOUTHERN COMPANY SERVICES, INC.
BIRMINGHAM, ALABAMA

GEORGIA POWER COMPANY
ALVIN W. VOGTLE NUCLEAR PLANT

SEISMIC PROFILES LINES J, K, L, M, N AND P

NO.	REVISIONS	DATE	DR	CHK	APPV	DTL
0	ISSUED PER REA 96-VAA054	9-30-98	GS	RBH	CBH	WFP

SCALE: NONE

JOB NO. 10604

DRAWING NO. AX6DD391

REV 0

THIS DOCUMENT CONTAINS PROPRIETARY, CONFIDENTIAL, AND/OR TRADE SECRET INFORMATION OF THE SUBSIDIARIES OF THE SOUTHERN COMPANY OR OF THIRD PARTIES. IT IS INTENDED FOR USE ONLY BY EMPLOYEES OF, OR AUTHORIZED CONTRACTORS OF, THE SUBSIDIARIES OF THE SOUTHERN COMPANY. UNAUTHORIZED POSSESSION, USE, DISTRIBUTION, COPYING, DISSEMINATION, OR DISCLOSURE OF ANY PORTION HEREOF IS PROHIBITED.

CAD NAME AX6DD391

SIZE B 11x17

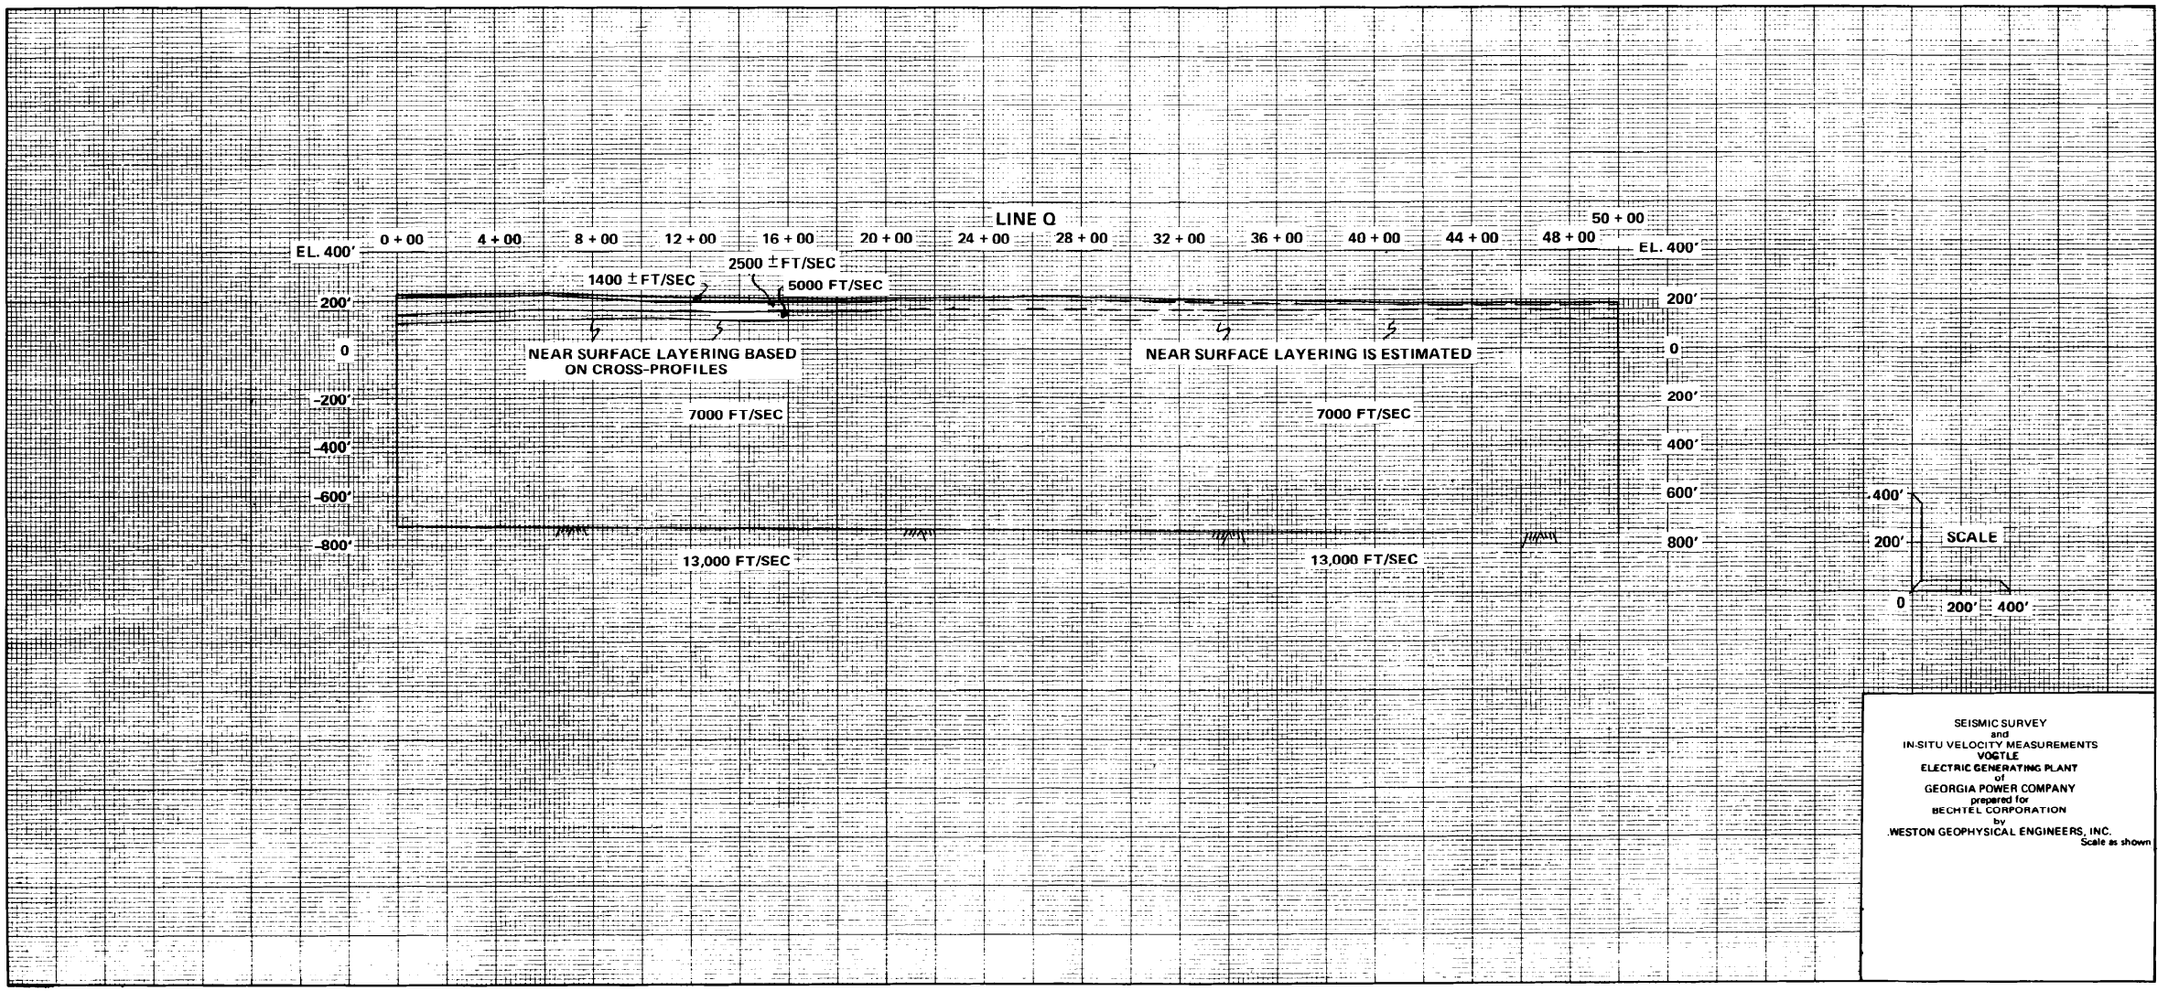

NOTE:

1. FOR PROFILE LOCATIONS SEE DRAWING AX6DD387.

SOUTHERN COMPANY SERVICES, INC.
BIRMINGHAM, ALABAMA

GEORGIA POWER COMPANY
ALVIN W. VOGTLE NUCLEAR PLANT

SEISMIC PROFILES LINE Q

NO.	REVISIONS	DATE	DR	CHK	APPV	DTL
1						
0	ISSUED PER REA 96-VAA054	9-30-98	GS	RBH	CBH	WFP

SCALE: NONE

JOB NO. 10604

DRAWING NO. AX6DD392

REV 0

THIS DOCUMENT CONTAINS PROPRIETARY, CONFIDENTIAL, AND/OR TRADE SECRET INFORMATION OF THE SUBSIDIARIES OF THE SOUTHERN COMPANY OR OF THIRD PARTIES. IT IS INTENDED FOR USE ONLY BY EMPLOYEES OF, OR AUTHORIZED CONTRACTORS OF, THE SUBSIDIARIES OF THE SOUTHERN COMPANY. UNAUTHORIZED POSSESSION, USE, DISTRIBUTION, COPYING, DISSEMINATION, OR DISCLOSURE OF ANY PORTION HEREOF IS PROHIBITED.

CAD NAME AX6DD392 SIZE B 11x17

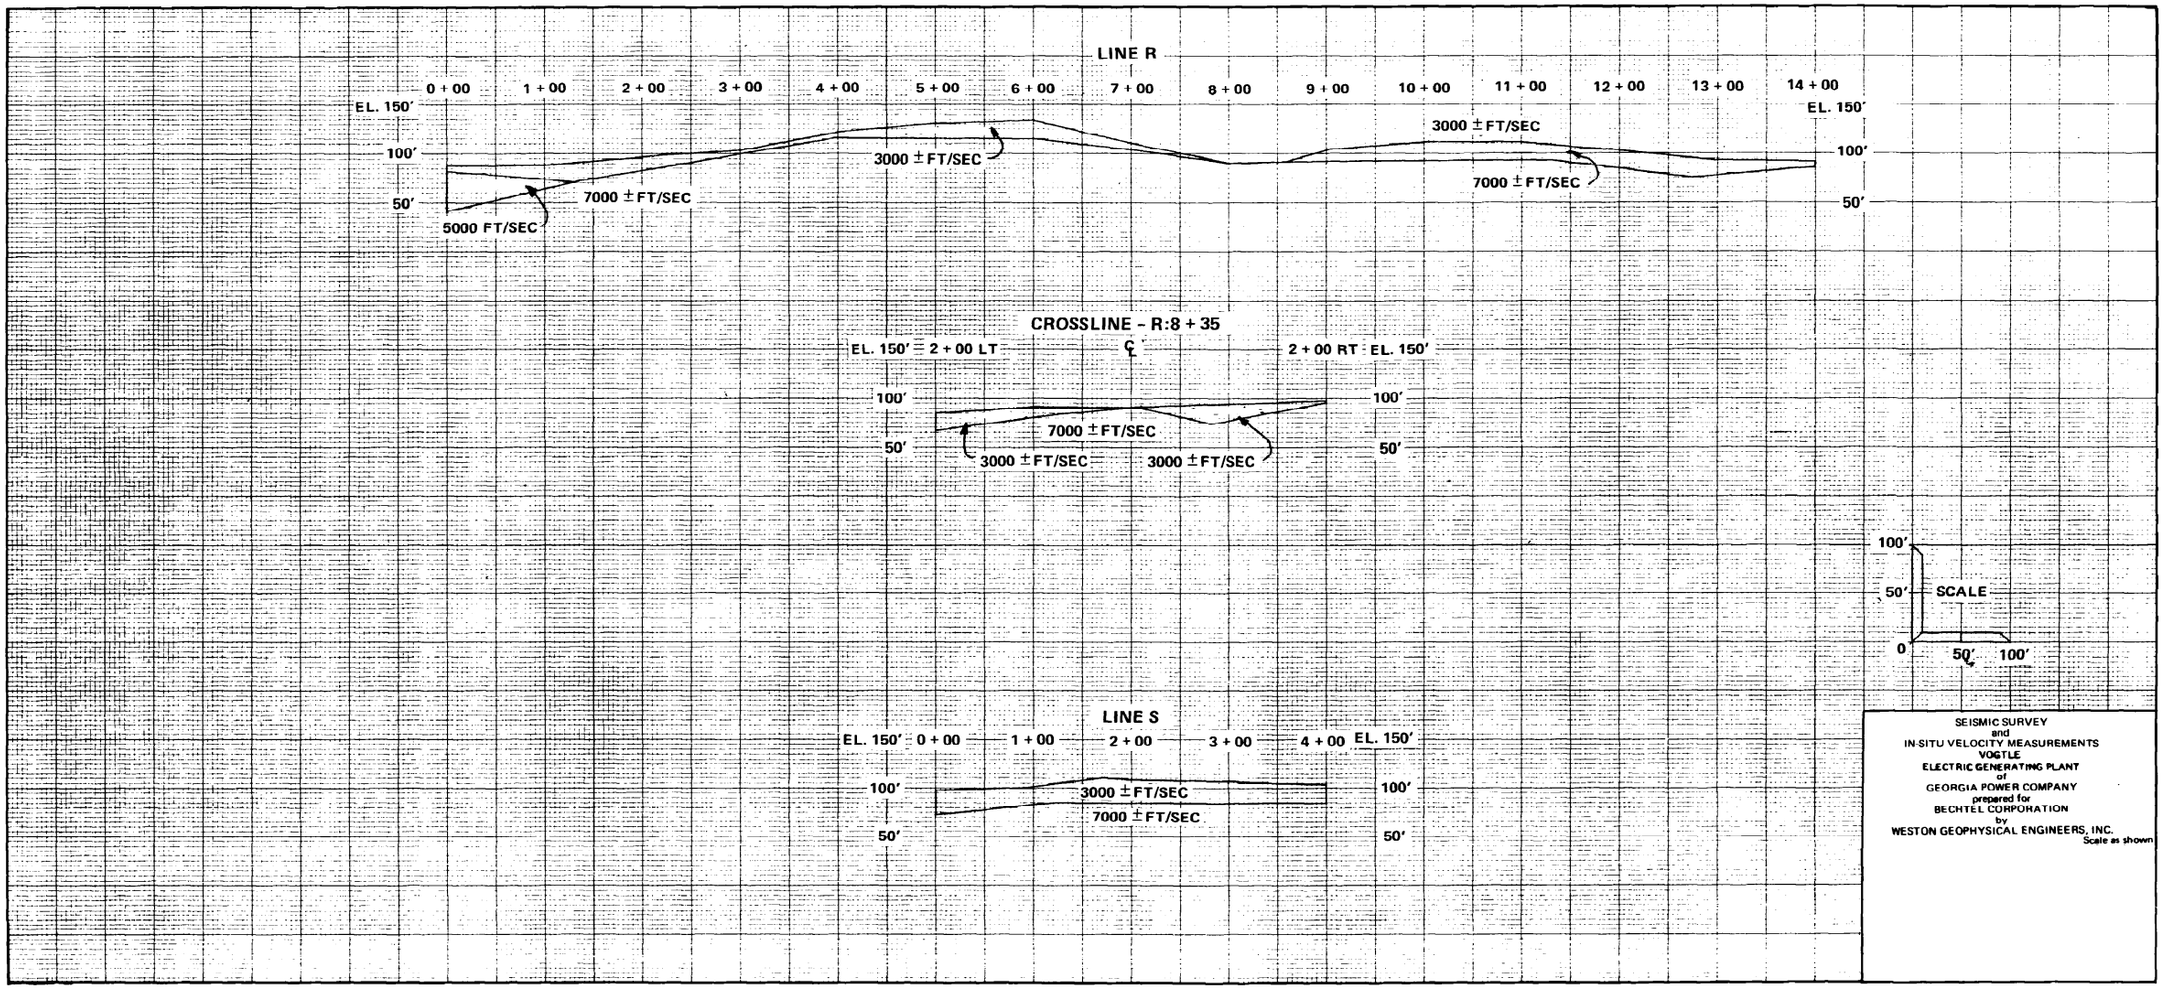

NOTE:

1. FOR PROFILE LOCATIONS SEE DRAWING AX6DD387.

SOUTHERN COMPANY SERVICES, INC.
BIRMINGHAM, ALABAMA

GEORGIA POWER COMPANY
ALVIN W. VOGTLE NUCLEAR PLANT

SEISMIC PROFILES LINES R AND S

NO.	REVISIONS	DATE	DR	CHK	APPV	DTL
△						
0	ISSUED PER REA 96-VAA054	9-30-98	GS	RBH	CBH	WFP

SCALE: NONE

JOB NO. 10604

DRAWING NO. AX6DD393

REV 0

THIS DOCUMENT CONTAINS PROPRIETARY, CONFIDENTIAL, AND/OR TRADE SECRET INFORMATION OF THE SUBSIDIARIES OF THE SOUTHERN COMPANY OR OF THIRD PARTIES. IT IS INTENDED FOR USE ONLY BY EMPLOYEES OF, OR AUTHORIZED CONTRACTORS OF, THE SUBSIDIARIES OF THE SOUTHERN COMPANY. UNAUTHORIZED POSSESSION, USE, DISTRIBUTION, COPYING, DISSEMINATION, OR DISCLOSURE OF ANY PORTION HEREOF IS PROHIBITED.

CAD NAME AX6DD393 SIZE B 11x17

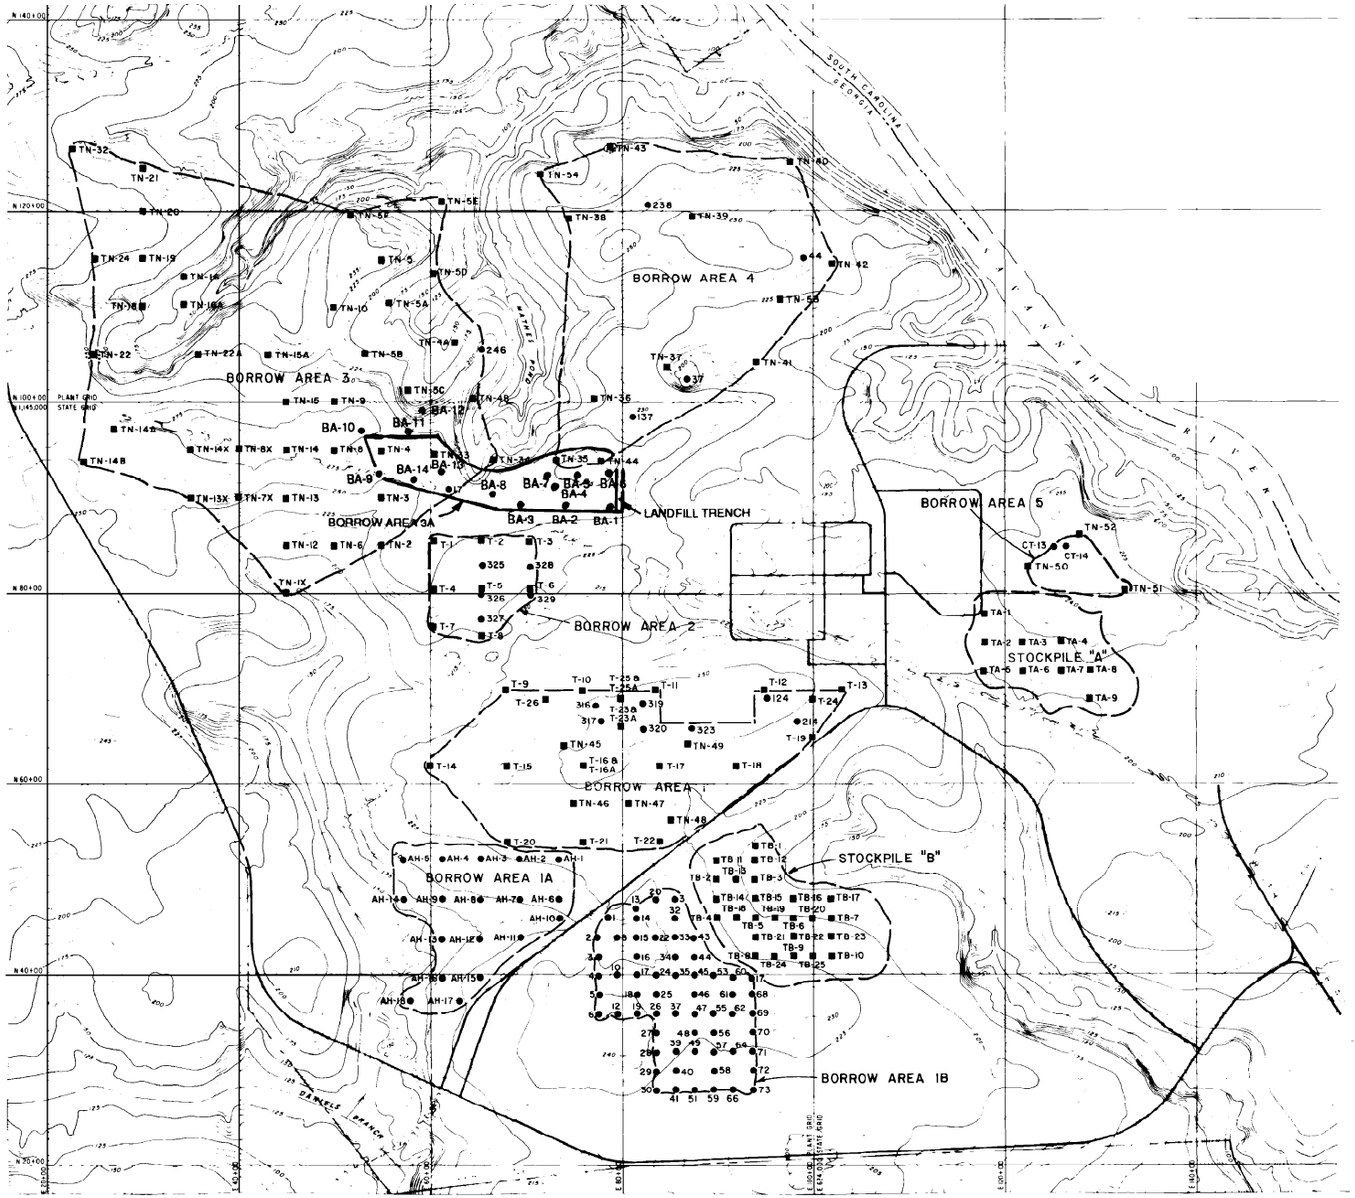

EXPLANATION

TA-1 TEST PIT

20 BORING

REFERENCE:

Hancock Landing Project topographic map prepared by Clyde N. Eldridge Aerial Surveys, Feb. 25/1971

SCALE IN FEET

Contour intervals 5 ft. and 25 ft.

SOUTHERN COMPANY SERVICES, INC.
BIRMINGHAM, ALABAMA

GEORGIA POWER COMPANY
ALVIN W. VOGTLE NUCLEAR PLANT

BORING AND TEST PIT LOCATIONS IN BORROW AREAS AND STOCKPILES PLAN

NO.	REVISIONS	DATE	DR	CHK	APPV	DTL
0	ISSUED PER REA 96-VAA054	9-30-98	GS	RBH	CBH	WFP

SCALE: NONE

JOB NO. 10604

DRAWING NO. AX6DD394

REV 0

THIS DOCUMENT CONTAINS PROPRIETARY, CONFIDENTIAL, AND/OR TRADE SECRET INFORMATION OF THE SUBSIDIARIES OF THE SOUTHERN COMPANY OR OF THIRD PARTIES. IT IS INTENDED FOR USE ONLY BY EMPLOYEES OF, OR AUTHORIZED CONTRACTORS OF, THE SUBSIDIARIES OF THE SOUTHERN COMPANY. UNAUTHORIZED POSSESSION, USE, DISTRIBUTION, COPYING, DISSEMINATION, OR DISCLOSURE OF ANY PORTION HEREOF IS PROHIBITED.

CAD NAME AX6DD394 SIZE B 11x17

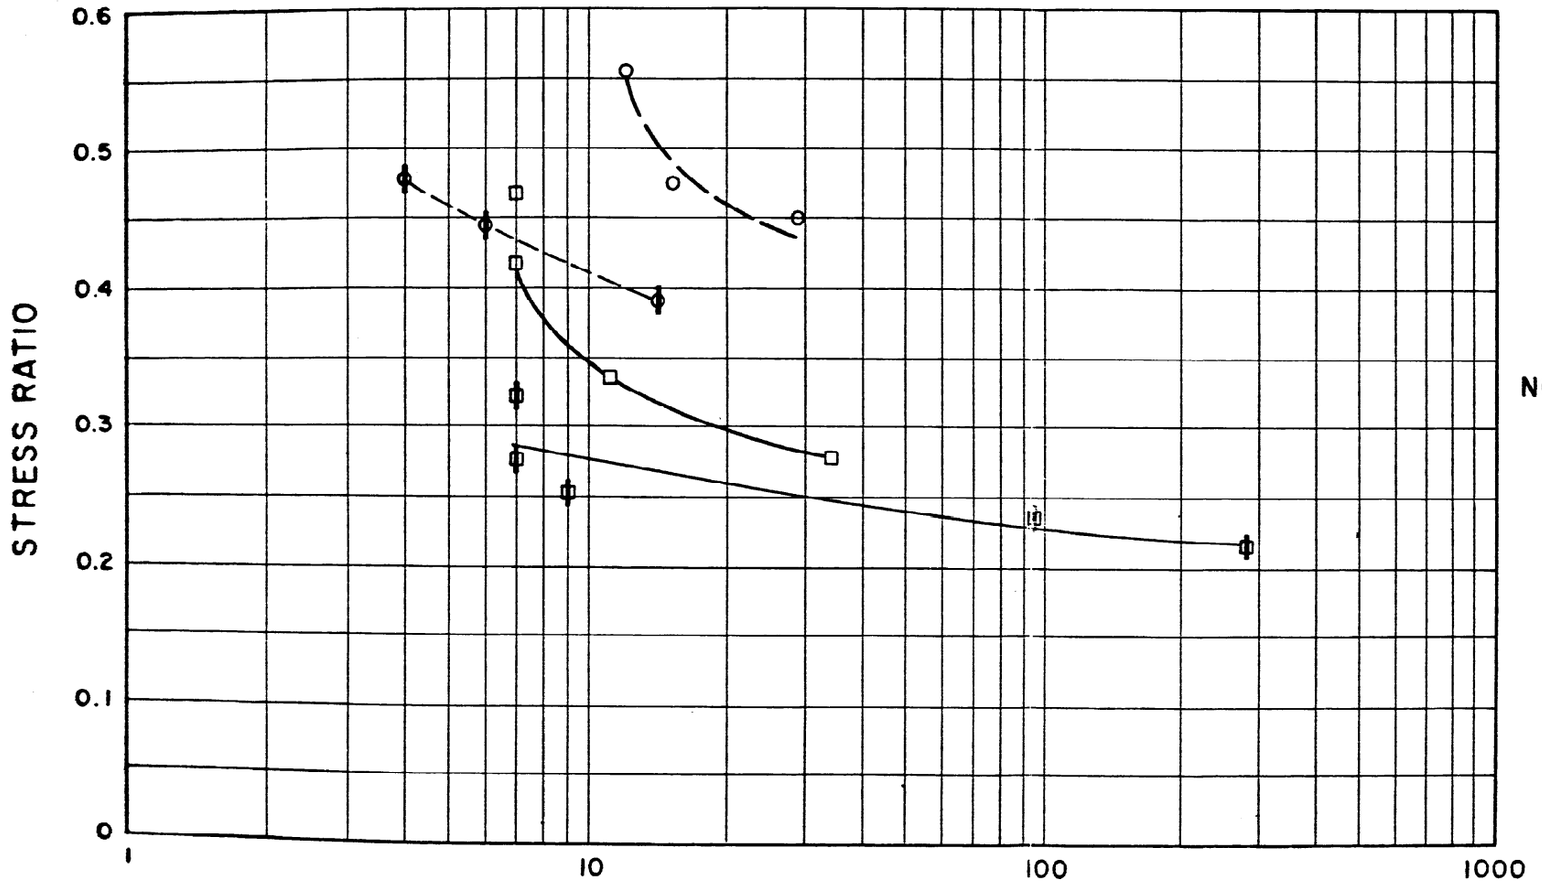

- Sand with 1.5 % fines compacted to 93% maximum density
- Sand with 1.5 % fines compacted to 95 % maximum density
- Silty sand with 11.9 % fines compacted to 93% maximum density
- Silty sand with 11.9 % fines compacted to 95 % maximum density

NOTES:

1. All samples compacted to specified density by ASTM D-1557
2. Test data relate to samples obtained from Stockpile "A"

SOUTHERN COMPANY SERVICES, INC.
BIRMINGHAM, ALABAMA

GEORGIA POWER COMPANY
ALVIN W. VOGTLE NUCLEAR PLANT

RESULTS OF CYCLIC TRIAXIAL TESTS (93- AND 95-PERCENT RELATIVE COMPACTION)

NO.	REVISIONS	DATE	DR	CHK	APPV	DTL
△						
0	ISSUED PER REA 96-VAA054	9-30-98	GS	RBH	CBH	WFP

SCALE: NONE	DRAWING NO.	REV
JOB NO. 10604	AX6DD395	0

THIS DOCUMENT CONTAINS PROPRIETARY, CONFIDENTIAL, AND/OR TRADE SECRET INFORMATION OF THE SUBSIDIARIES OF THE SOUTHERN COMPANY OR OF THIRD PARTIES. IT IS INTENDED FOR USE ONLY BY EMPLOYEES OF, OR AUTHORIZED CONTRACTORS OF, THE SUBSIDIARIES OF THE SOUTHERN COMPANY. UNAUTHORIZED POSSESSION, USE, DISTRIBUTION, COPYING, DISSEMINATION, OR DISCLOSURE OF ANY PORTION HEREOF IS PROHIBITED.

CAD NAME AX6DD395 SIZE B 11x17

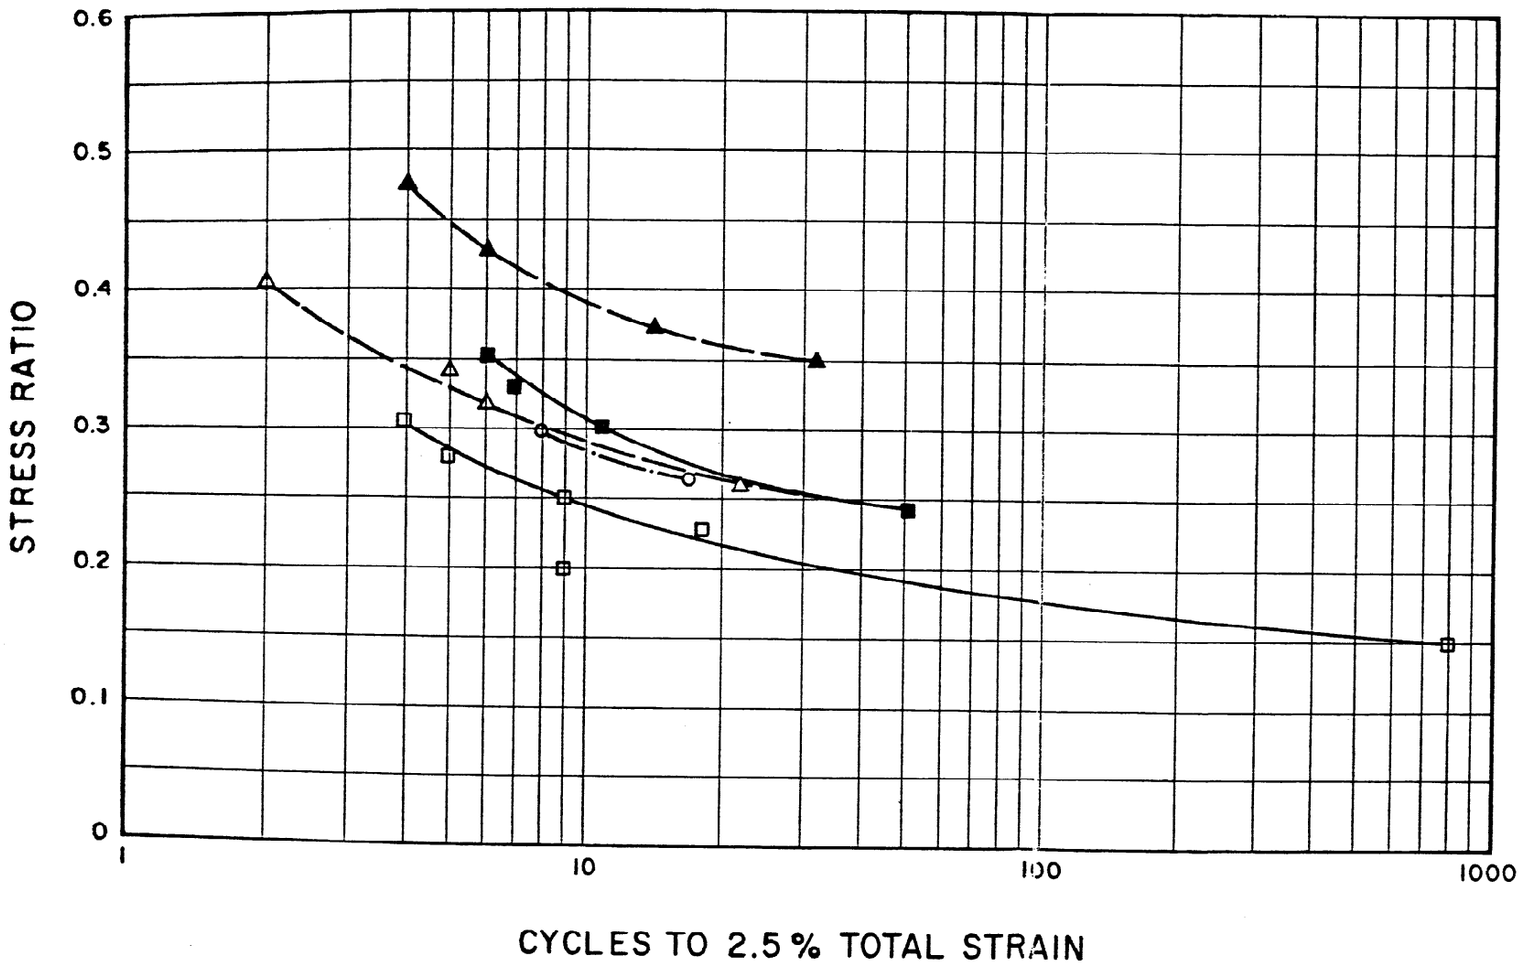

- □ Sand with 3 % fines compacted to 95 % maximum density
- ■ Sand with 3 % fines compacted to 97 % maximum density
- △ Clayey sand with 25 % fines compacted to 95% maximum density
- ▲ Clayey sand with 25 % fines compacted to 97 % maximum density
- o Silty sand with 11 % fines compacted to 95 % maximum density

NOTES:

1. All samples compacted to specified density by ASTM D-1557
2. Test data relate to samples obtained from Borrow Area I

SOUTHERN COMPANY SERVICES, INC.
BIRMINGHAM, ALABAMA

GEORGIA POWER COMPANY
ALVIN W. VOGTLE NUCLEAR PLANT

RESULTS OF CYCLIC TRIAXIAL TESTS (95- AND 97-PERCENT RELATIVE COMPACTION)

NO.	REVISIONS	DATE	DR	CHK	APPV	DTL
△						
0	ISSUED PER REA 96-VAA054	9-30-98	GS	RBH	CBH	WFP

SCALE: NONE	DRAWING NO.	REV
JOB NO. 10604	AX6DD396	0

THIS DOCUMENT CONTAINS PROPRIETARY, CONFIDENTIAL, AND/OR TRADE SECRET INFORMATION OF THE SUBSIDIARIES OF THE SOUTHERN COMPANY OR OF THIRD PARTIES. IT IS INTENDED FOR USE ONLY BY EMPLOYEES OF, OR AUTHORIZED CONTRACTORS OF, THE SUBSIDIARIES OF THE SOUTHERN COMPANY. UNAUTHORIZED POSSESSION, USE, DISTRIBUTION, COPYING, DISSEMINATION, OR DISCLOSURE OF ANY PORTION HEREOF IS PROHIBITED.

CAD NAME AX6DD396 SIZE B 11x17

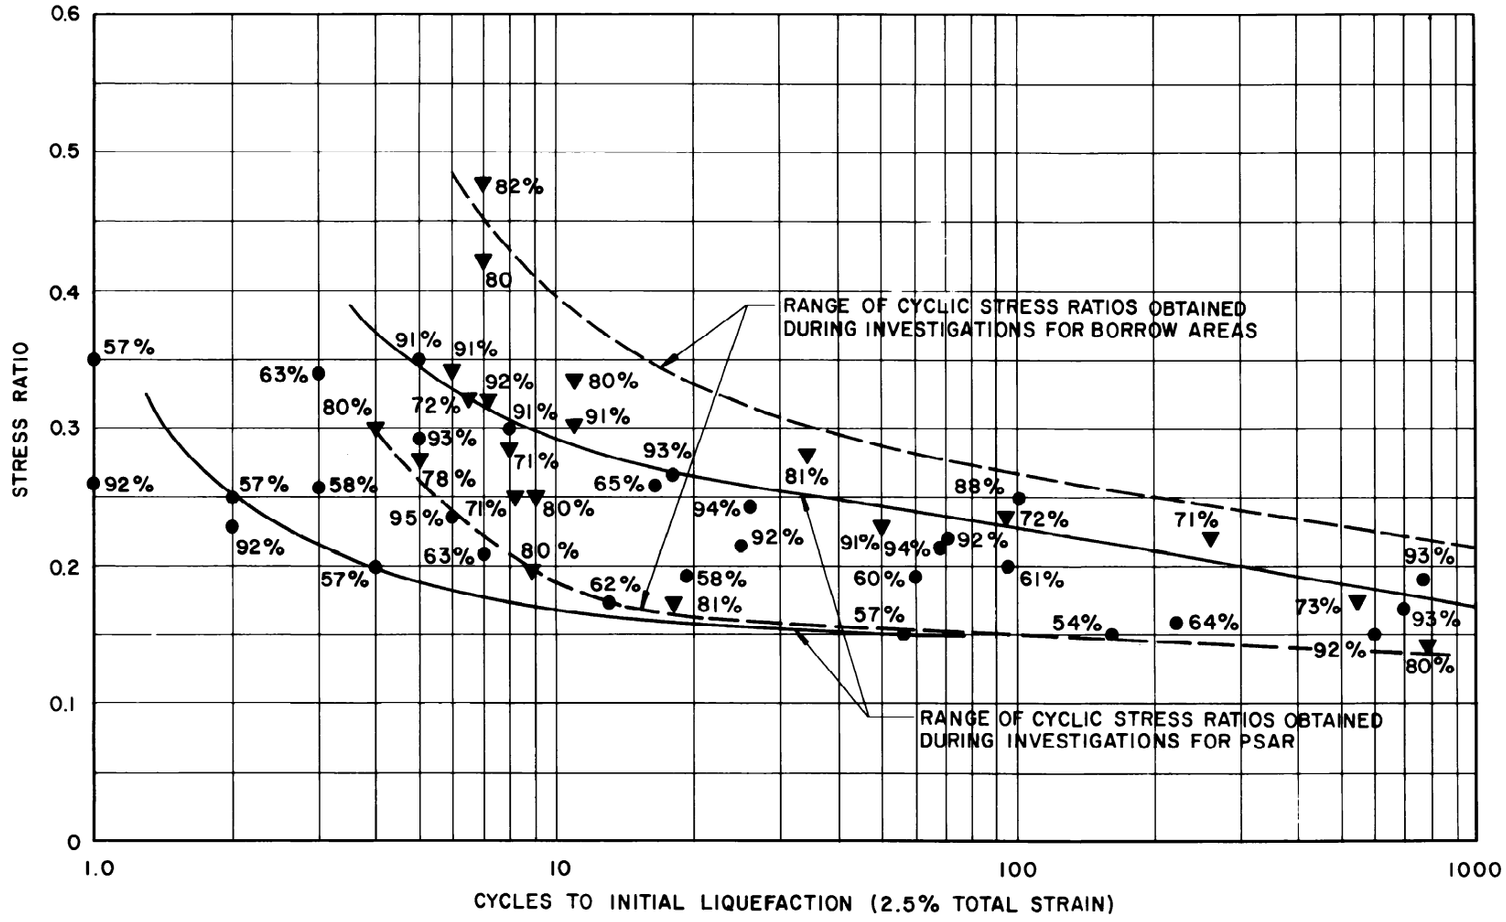

NOTES:

1. ▼ DATA OBTAINED DURING INVESTIGATIONS FOR BORROW SOURCES.
2. ● DATA OBTAINED DURING PSAR INVESTIGATIONS.
3. PERCENTAGES (58%) — INDICATE RELATIVE DENSITY.

SOUTHERN COMPANY SERVICES, INC.
BIRMINGHAM, ALABAMA

GEORGIA POWER COMPANY
ALVIN W. VOGTLE NUCLEAR PLANT

LABORATORY RESULTS OF CYCLIC TRIAXIAL TEST

NO.	REVISIONS	DATE	DR	CHK	APPV	DTL
0	ISSUED PER REA 96-VAA054	9-30-98	GS	RBH	CBH	WFP

SCALE: NONE | DRAWING NO. AX6DD397 | REV 0

JOB NO. 10604

THIS DOCUMENT CONTAINS PROPRIETARY, CONFIDENTIAL, AND/OR TRADE SECRET INFORMATION OF THE SUBSIDIARIES OF THE SOUTHERN COMPANY OR OF THIRD PARTIES. IT IS INTENDED FOR USE ONLY BY EMPLOYEES OF, OR AUTHORIZED CONTRACTORS OF, THE SUBSIDIARIES OF THE SOUTHERN COMPANY. UNAUTHORIZED POSSESSION, USE, DISTRIBUTION, COPYING, DISSEMINATION, OR DISCLOSURE OF ANY PORTION HEREOF IS PROHIBITED.

CAD NAME AX6DD397 SIZE B 11x17

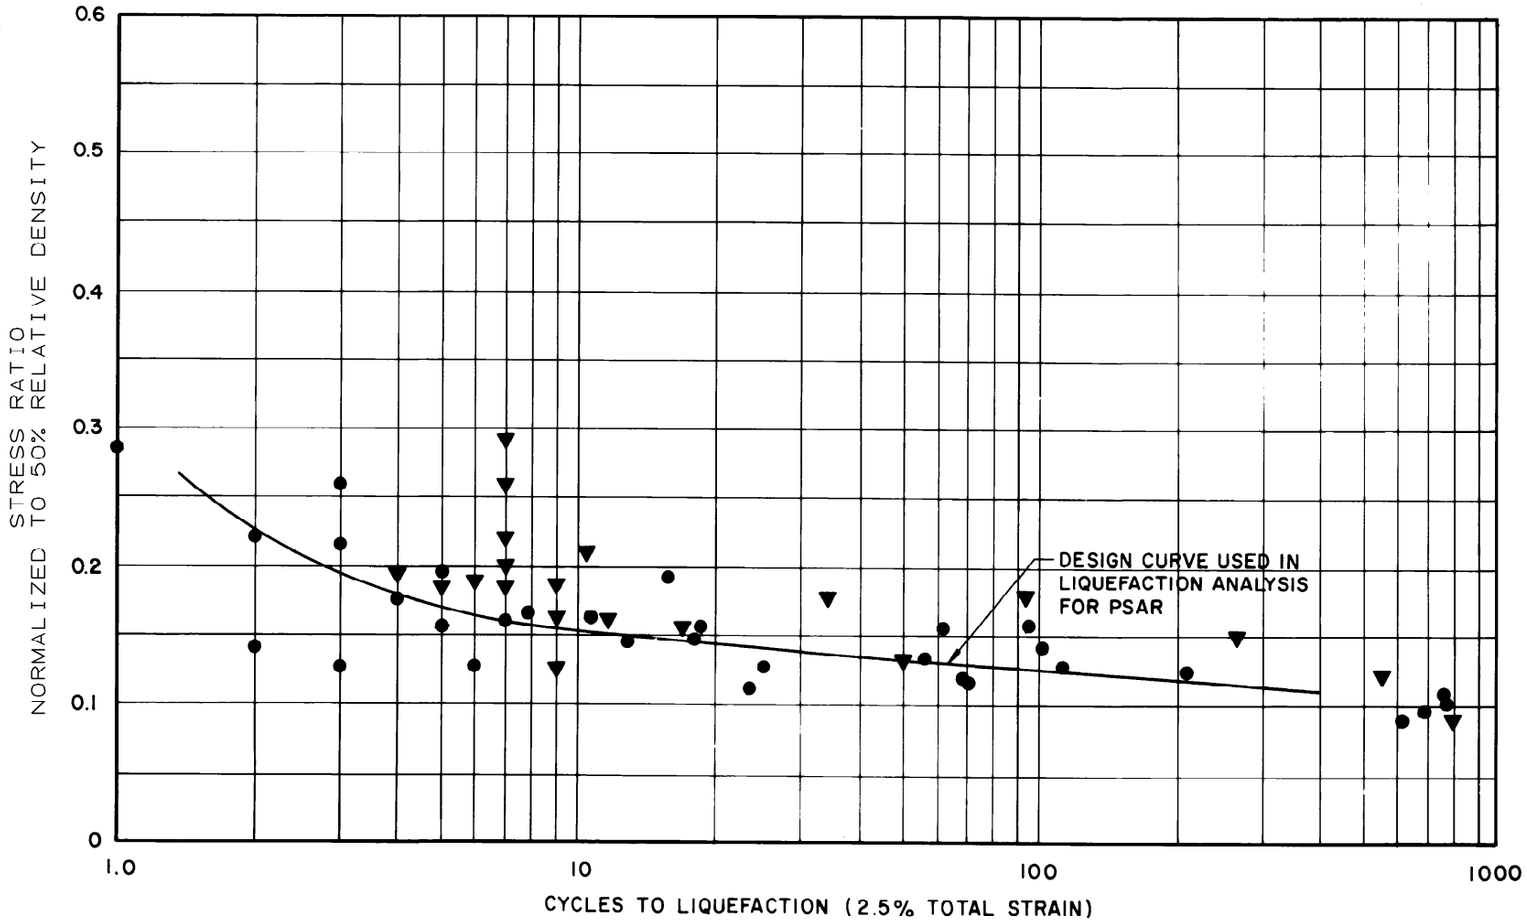

NOTES:

1. ▼ DATA OBTAINED DURING INVESTIGATIONS FOR BORROW SOURCES.
2. ● DATA OBTAINED DURING PSAR INVESTIGATIONS.

SOUTHERN COMPANY SERVICES, INC.
BIRMINGHAM, ALABAMA

GEORGIA POWER COMPANY
ALVIN W. VOGTLE NUCLEAR PLANT

CYCLIC TRIAXIAL TEST DATA NORMALIZED TO 50-PERCENT RELATIVE DENSITY

NO.	REVISIONS	DATE	DR	CHK	APPV	DTL
△0	ISSUED PER REA 96-VAA054	9-30-98	GS	RBH	CBH	WFP

SCALE: NONE

DRAWING NO. AX6DD398

REV 0

JOB NO. 10604

CAD NAME AX6DD398

SIZE B 11x17

THIS DOCUMENT CONTAINS PROPRIETARY, CONFIDENTIAL, AND/OR TRADE SECRET INFORMATION OF THE SUBSIDIARIES OF THE SOUTHERN COMPANY OR OF THIRD PARTIES. IT IS INTENDED FOR USE ONLY BY EMPLOYEES OF, OR AUTHORIZED CONTRACTORS OF, THE SUBSIDIARIES OF THE SOUTHERN COMPANY. UNAUTHORIZED POSSESSION, USE, DISTRIBUTION, COPYING, DISSEMINATION, OR DISCLOSURE OF ANY PORTION HEREOF IS PROHIBITED.

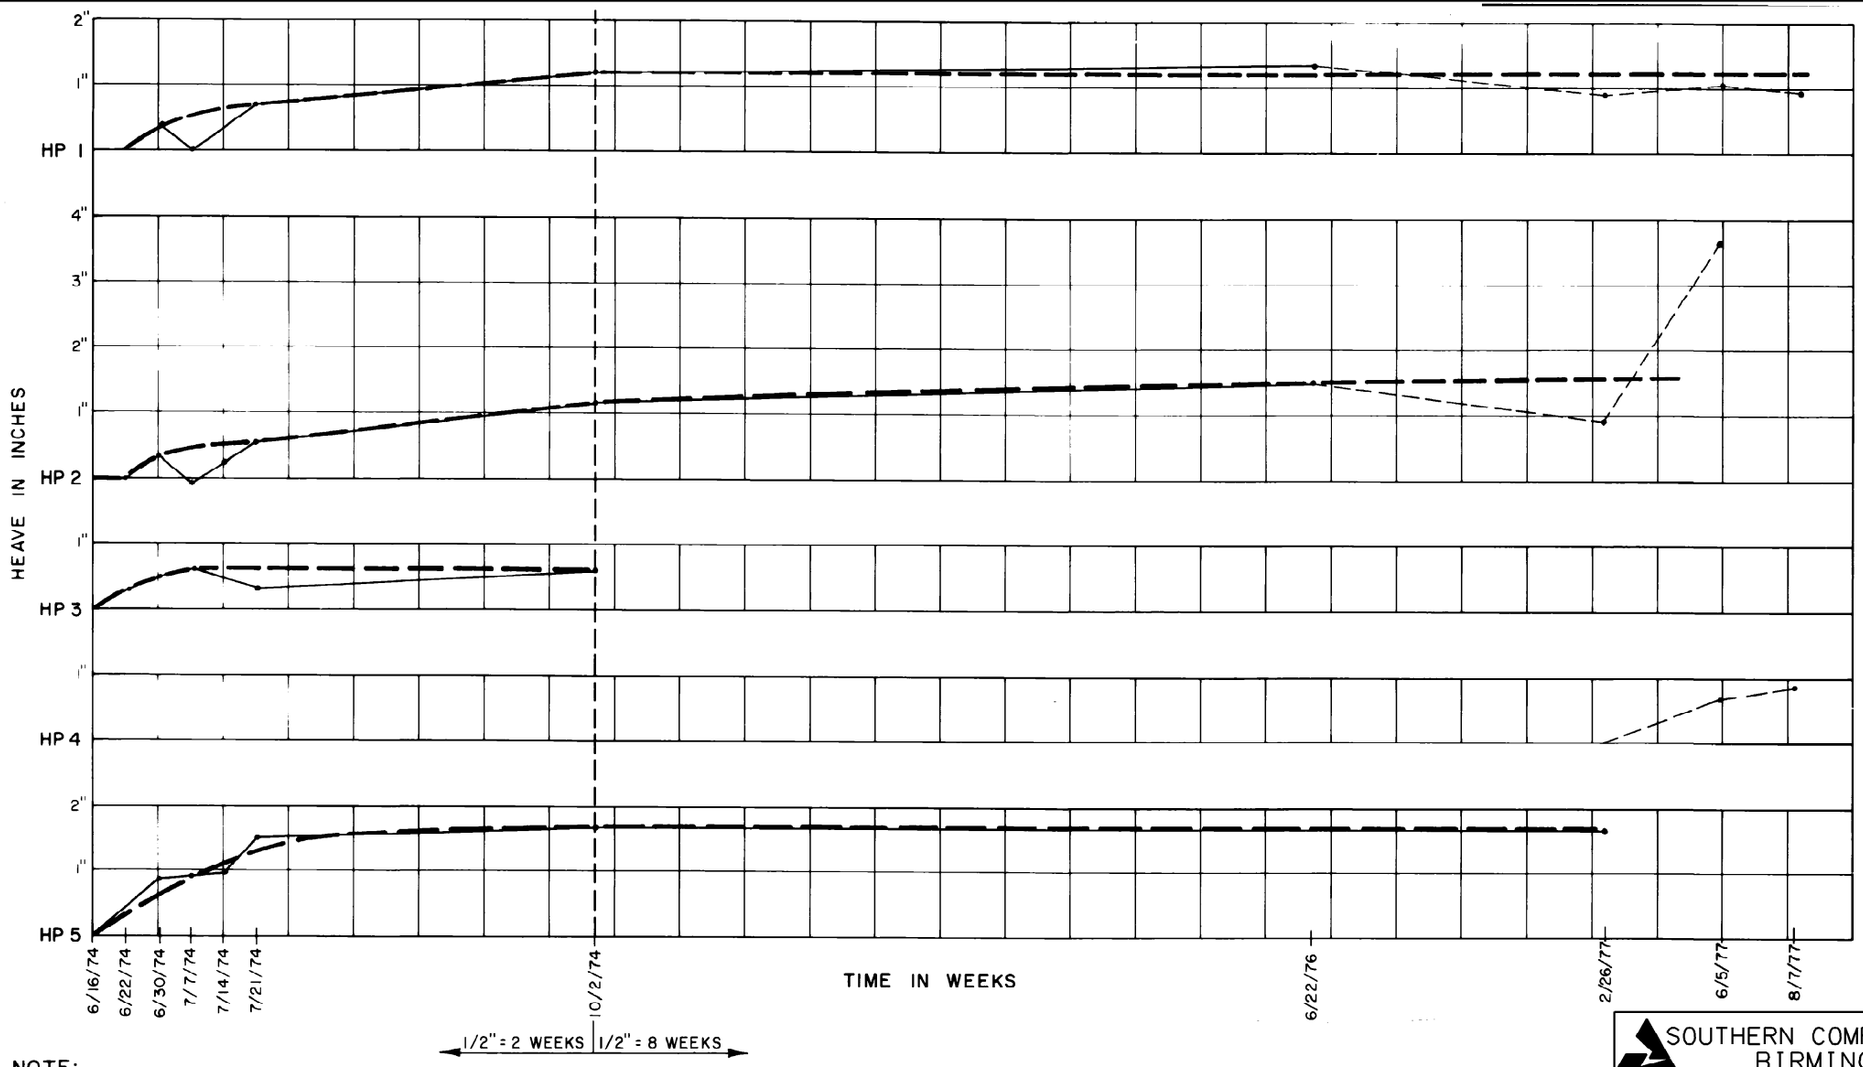

NOTE:

- ORIGINAL FIELD DATA
- QUESTIONABLE ORIGINAL FIELD DATA
- AVERAGE CURVE ASSUMING HEAVE INCREASES OR STAYS CONSTANT WITH TIME

SOUTHERN COMPANY SERVICES, INC.
BIRMINGHAM, ALABAMA

GEORGIA POWER COMPANY
ALVIN W. VOGTLE NUCLEAR PLANT

PLOT OF HEAVE VERSUS TIME

NO.	REVISIONS	DATE	DR	CHK	APPV	DTL
△						
0	ISSUED PER REA 96-VAA054	9-30-98	GS	RBH	CBH	WFP

SCALE: NONE

JOB NO. 10604

DRAWING NO. AX6DD399

REV 0

THIS DOCUMENT CONTAINS PROPRIETARY, CONFIDENTIAL, AND/OR TRADE SECRET INFORMATION OF THE SUBSIDIARIES OF THE SOUTHERN COMPANY OR OF THIRD PARTIES. IT IS INTENDED FOR USE ONLY BY EMPLOYEES OF, OR AUTHORIZED CONTRACTORS OF, THE SUBSIDIARIES OF THE SOUTHERN COMPANY. UNAUTHORIZED POSSESSION, USE, DISTRIBUTION, COPYING, DISSEMINATION, OR DISCLOSURE OF ANY PORTION HEREOF IS PROHIBITED.

CAD NAME AX6DD399

SIZE B 11x17

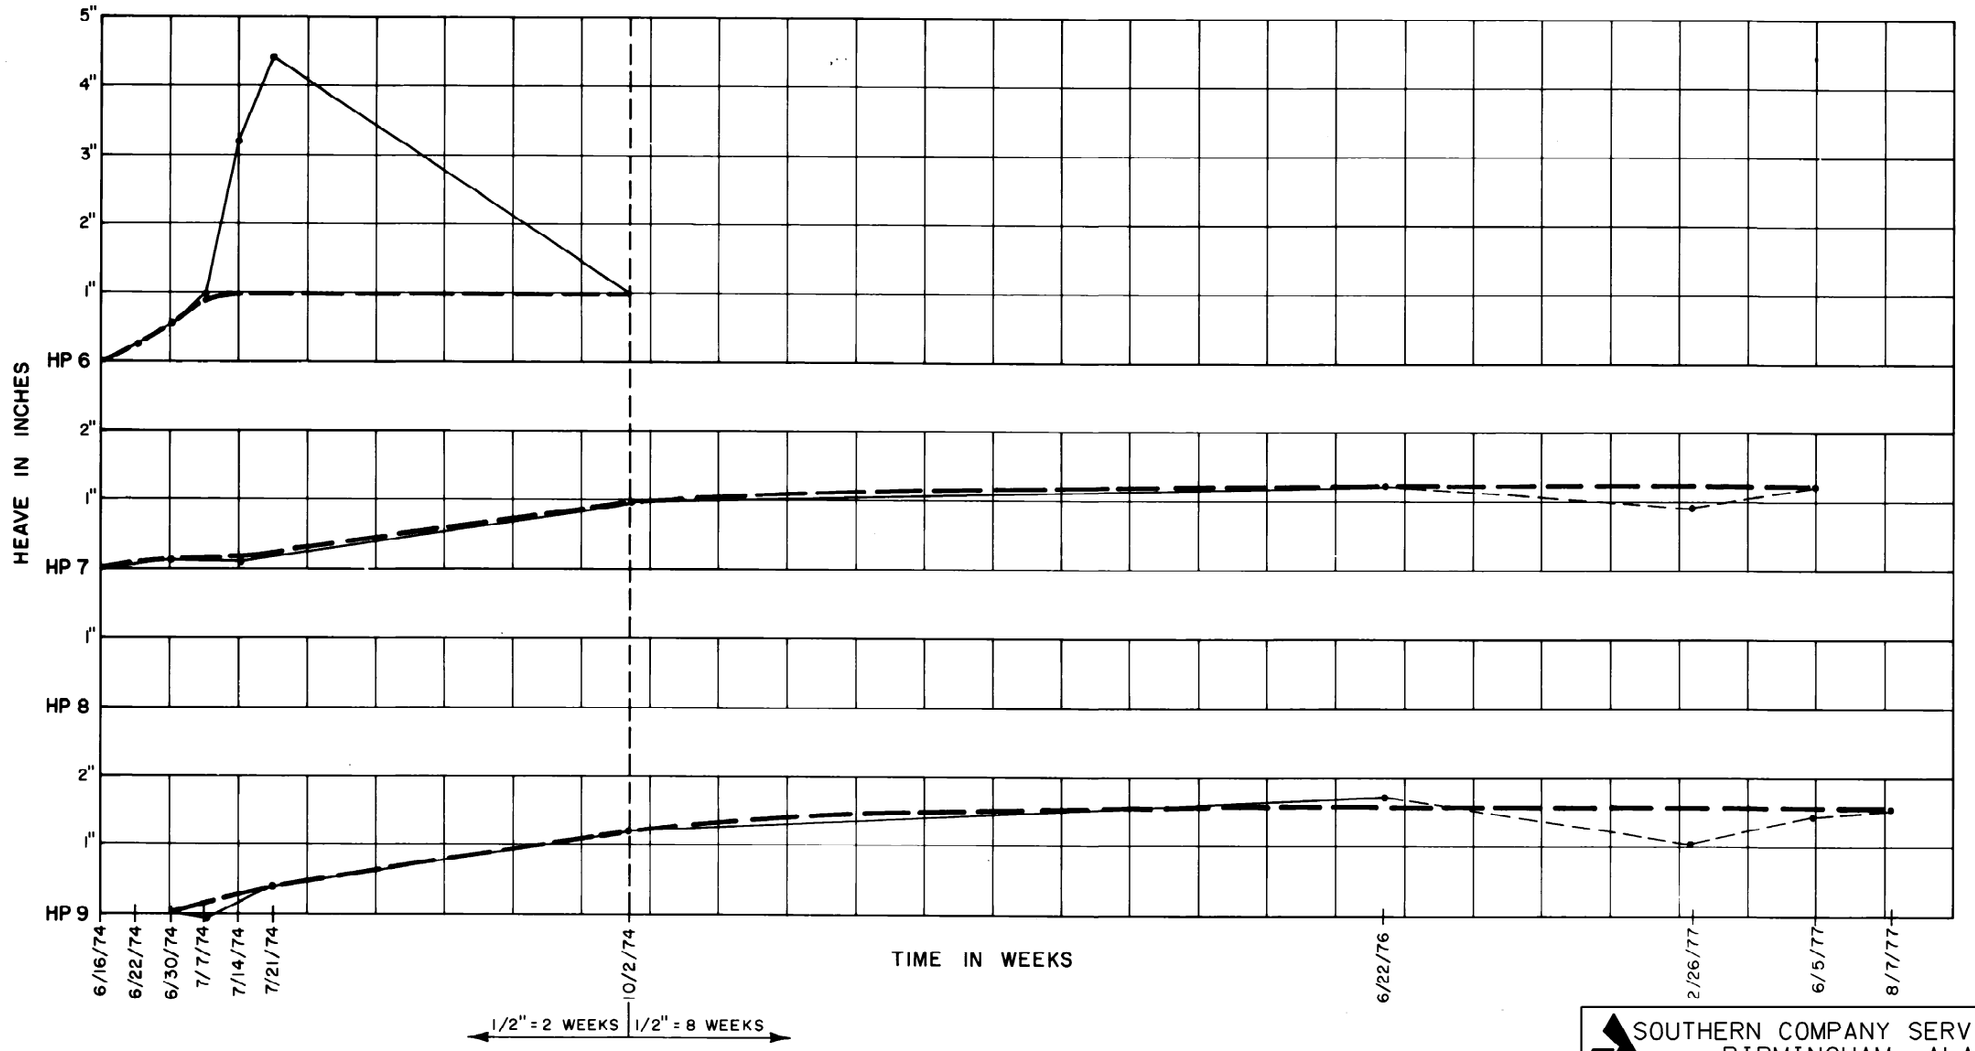

NOTE:

——— ORIGINAL FIELD DATA

– – – – QUESTIONABLE ORIGINAL FIELD DATA

— — — AVERAGE CURVE ASSUMING HEAVE INCREASES OR STAYS CONSTANT WITH TIME

NO.	REVISIONS	DATE	DR	CHK	APPV	DTL
△						
0	ISSUED PER REA 96-VAA054	9-30-98	GS	RBH	CBH	WFP

SOUTHERN COMPANY SERVICES, INC.
BIRMINGHAM, ALABAMA

GEORGIA POWER COMPANY
ALVIN W. VOGTLE NUCLEAR PLANT

PLOT OF HEAVE VERSUS TIME

SCALE: NONE	DRAWING NO.	REV
JOB NO. 10604	AX6DD400	0

THIS DOCUMENT CONTAINS PROPRIETARY, CONFIDENTIAL, AND/OR TRADE SECRET INFORMATION OF THE SUBSIDIARIES OF THE SOUTHERN COMPANY OR OF THIRD PARTIES. IT IS INTENDED FOR USE ONLY BY EMPLOYEES OF, OR AUTHORIZED CONTRACTORS OF, THE SUBSIDIARIES OF THE SOUTHERN COMPANY. UNAUTHORIZED POSSESSION, USE, DISTRIBUTION, COPYING, DISSEMINATION, OR DISCLOSURE OF ANY PORTION HEREOF IS PROHIBITED.

CAD NAME AX6DD400 SIZE B 11x17

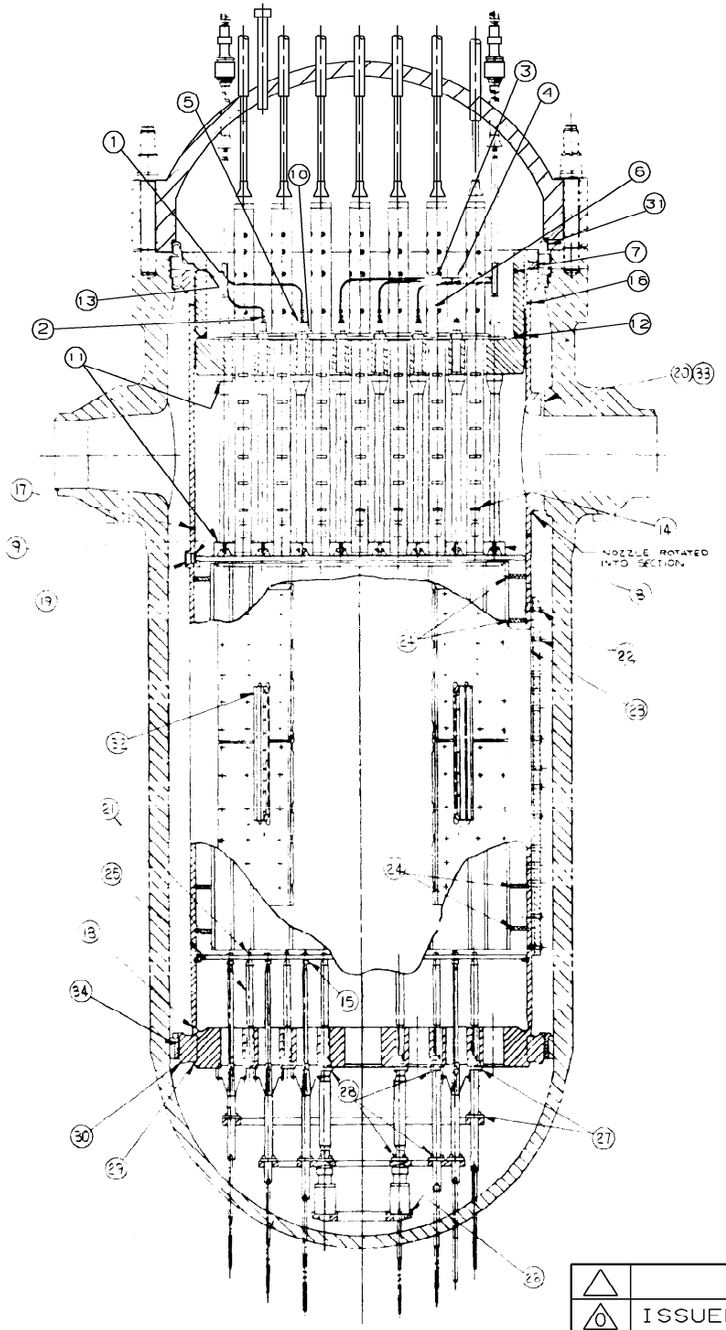

SEE NOTES	STEP	FEATURES TO BE EXAMINED
1	1	THERMOCOUPLE CONDUIT CLAMPS INSIDE THE THERMOCOUPLE COLUMN
1, 5	2	CONDUIT SWAGELOK FITTINGS, THEIR BANDINGS, AND THE TAB TYPE LOCKS
1	3	CLAMP ARRANGEMENTS AT THE MOUNTING BRACKET LOCATIONS
1	4	CONDUIT CLAMP WELDS
1	5	UPPER SUPPORT COLUMN NUT TO EXTENSION WELDS
1	6	ACCESSIBLE CONDUIT SUPPORT BRACKET WELDS
6	7	HOLD DOWN SPRING INTERFACE SURFACE CONDITION
1	8	ACCESSIBLE WELDS ON SUPPORT COLUMN LOWER NOZZLES
3, 6	9	UPPER CORE PLATE INSERTS
2	10	THERMOCOUPLE COLUMN AND GUIDE TUBE SCREW LOCKING DEVICES
2	11	ACCESSIBLE SUPPORT COLUMN, AND CORE PLATE INSERT SCREW LOCKING DEVICES
1	12	UPPER SUPPORT SKIRT TO PLATE GIRTH WELD
1	13	UPPER SUPPORT SKIRT TO FLANGE GIRTH WELD
1	14	ACCESSIBLE GUIDE TUBE WELDS
8	15	ACCESSIBLE (2) INSTRUMENTATION GUIDE COLUMN LOCKING COLLARS NEAREST THE MANWAY
1	16	UPPER BARREL TO FLANGE GIRTH WELD
1	17	UPPER BARREL TO LOWER BARREL GIRTH WELD
1	18	LOWER BARREL TO CORE SUPPORT GIRTH WELD
1, 4	19	UPPER CORE PLATE ALIGNING PIN WELDS AND BEARING SURFACES
6	20	OUTLET NOZZLE INTERFACE SURFACE CONDITION
1, 2 & 7	21	CORE SUPPORT COLUMNS AND THEIR SCREW LOCKING DEVICES
1, 2	22	NEUTRON SHIELD PANEL SCREW LOCKING DEVICES
7	23	INTERFACE SURFACES AT THE SPACER PADS ALONG THE TOP AND BOTTOM ENDS OF THE NEUTRON PANELS
1	24	BAFFLE ASSEMBLY SCREW LOCKING ARRANGEMENTS AT THE TWO TOP AND THE TWO BOTTOM FORMER ELEVATIONS
2	25	LOWER CORE PLATE TO CORE BARREL SCREW LOCKING DEVICES ACCESSIBLE AT THE 0°, 90°, 180°, AND 270° AXES
1	26	SECONDARY CORE SUPPORT HOUSING TO BASE PLATE WELD
1, 2, & 7	27	LOCKING DEVICES AND CONTACT OF THE BOTTOM INSTRUMENTATION GUIDE COLUMNS WHERE ATTACHED TO THE CORE SUPPORT AND TIE PLATES
1, 2	28	LOCKING DEVICES OF THE SECONDARY CORE SUPPORT COLUMNS WHERE ATTACHED TO THE CORE SUPPORT AND TIE PLATE
1	29	RADIAL SUPPORT KEY WELDS
1, 4	30	RADIAL SUPPORT KEY LOCKING ARRANGEMENTS AND BEARING SURFACES
1, 4	31	HEAD AND VESSEL ALIGNING PINS SCREW LOCKING DEVICES AND BEARING SURFACES
1, 2	32	IRRADIATION SPECIMEN GUIDE SCREW LOCKING DEVICES AND DOWEL PINS
6	33	VESSEL NOZZLE INTERFACE SURFACE CONDITION
1, 3 & 4	34	VESSEL CLEVIS LOCKING ARRANGEMENTS AND BEARING SURFACES

NOTES

1. VISUALLY EXAMINE WELDS USING 5 10X MAGNIFICATION. NO CRACKS ALLOWED.
2. VERIFY THAT LOCKING DEVICES ARE CRIMPED AND UNDAMAGED.
3. VERIFY THAT INSERTS ARE SEATED (.0015 [0.038] FEELER MUST NOT PASS THRU INTERFACE.)
4. VISUALLY EXAMINE FACES FOR DAMAGE USING 5 10X MAGNIFICATION
5. VERIFY THAT FITTINGS ARE TIGHT.
6. VISUALLY EXAMINE INTERFACE SURFACES FOR ANY EVIDENCE OF DAMAGE.
7. VERIFY SEATING USING A .0015 [0.038] FEELER CAGE. FEELER MUST NOT PASS THRU 90°.
8. VERIFY THAT LOCKING COLLARS ARE TIGHT. NO MOVEMENT ALLOWED.

NO.	REVISIONS	DATE	DR	CHK	APPV	DTL
△						
0	ISSUED PER REA 96-VAA054	9-30-98	GS	RBH	CBH	WFP

SOUTHERN COMPANY SERVICES, INC.
BIRMINGHAM, ALABAMA

GEORGIA POWER COMPANY
ALVIN W. VOGTLE NUCLEAR PLANT

VIBRATION CHECKOUT FUNCTIONAL TEST INSPECTION POINTS

SCALE: NONE	DRAWING NO.	REV
JOB NO. 10604	AX6DD401	0

THIS DOCUMENT CONTAINS PROPRIETARY, CONFIDENTIAL, AND/OR TRADE SECRET INFORMATION OF THE SUBSIDIARIES OF THE SOUTHERN COMPANY OR OF THIRD PARTIES. IT IS INTENDED FOR USE ONLY BY EMPLOYEES OF, OR AUTHORIZED CONTRACTORS OF, THE SUBSIDIARIES OF THE SOUTHERN COMPANY. UNAUTHORIZED POSSESSION, USE, DISTRIBUTION, COPYING, DISSEMINATION, OR DISCLOSURE OF ANY PORTION HEREOF IS PROHIBITED.

CAD NAME AX6DD401 SIZE B 11x17

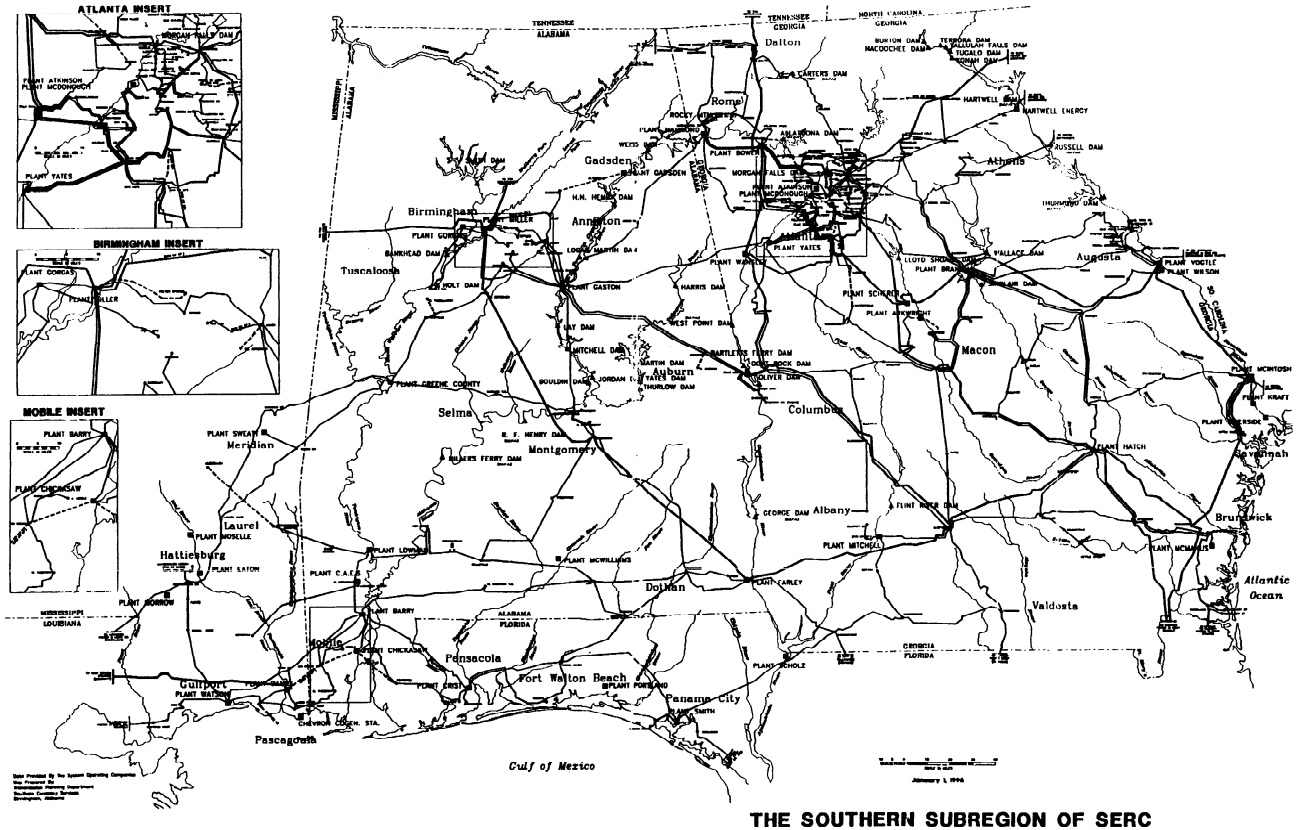

THE SOUTHERN SUBREGION OF SERC
ELECTRIC PRODUCTION &
TRANSMISSION FACILITIES

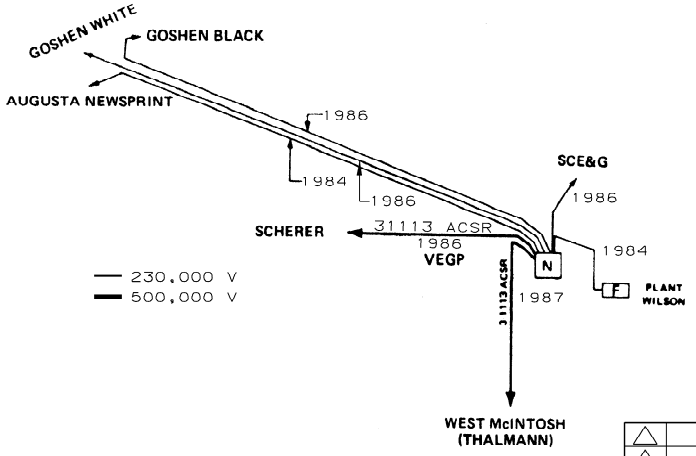

NO.	REVISIONS	DATE	DR	CHK	APPV	DTL
0	ISSUED PER REA 96-VAA054	9-30-98	GS	RBH	CBH	WFP

SOUTHERN COMPANY SERVICES, INC.
BIRMINGHAM, ALABAMA

GEORGIA POWER COMPANY
ALVIN W. VOGTLE NUCLEAR PLANT

THE SOUTHERN COMPANY
GRID SYSTEM

SCALE: NONE	DRAWING NO.	REV.
JOB NO. 10604	AX6DD402	0

THIS DOCUMENT CONTAINS PROPRIETARY, CONFIDENTIAL, AND/OR TRADE SECRET INFORMATION OF THE SUBSIDIARIES OF THE SOUTHERN COMPANY OR OF THIRD PARTIES. IT IS INTENDED FOR USE ONLY BY EMPLOYEES OF, OR AUTHORIZED CONTRACTORS OF, THE SUBSIDIARIES OF THE SOUTHERN COMPANY. UNAUTHORIZED POSSESSION, USE, DISTRIBUTION, COPYING, DISSEMINATION, OR DISCLOSURE OF ANY PORTION HEREOF IS PROHIBITED.

SIZE C 17X22 CAD NAME AX6DD402

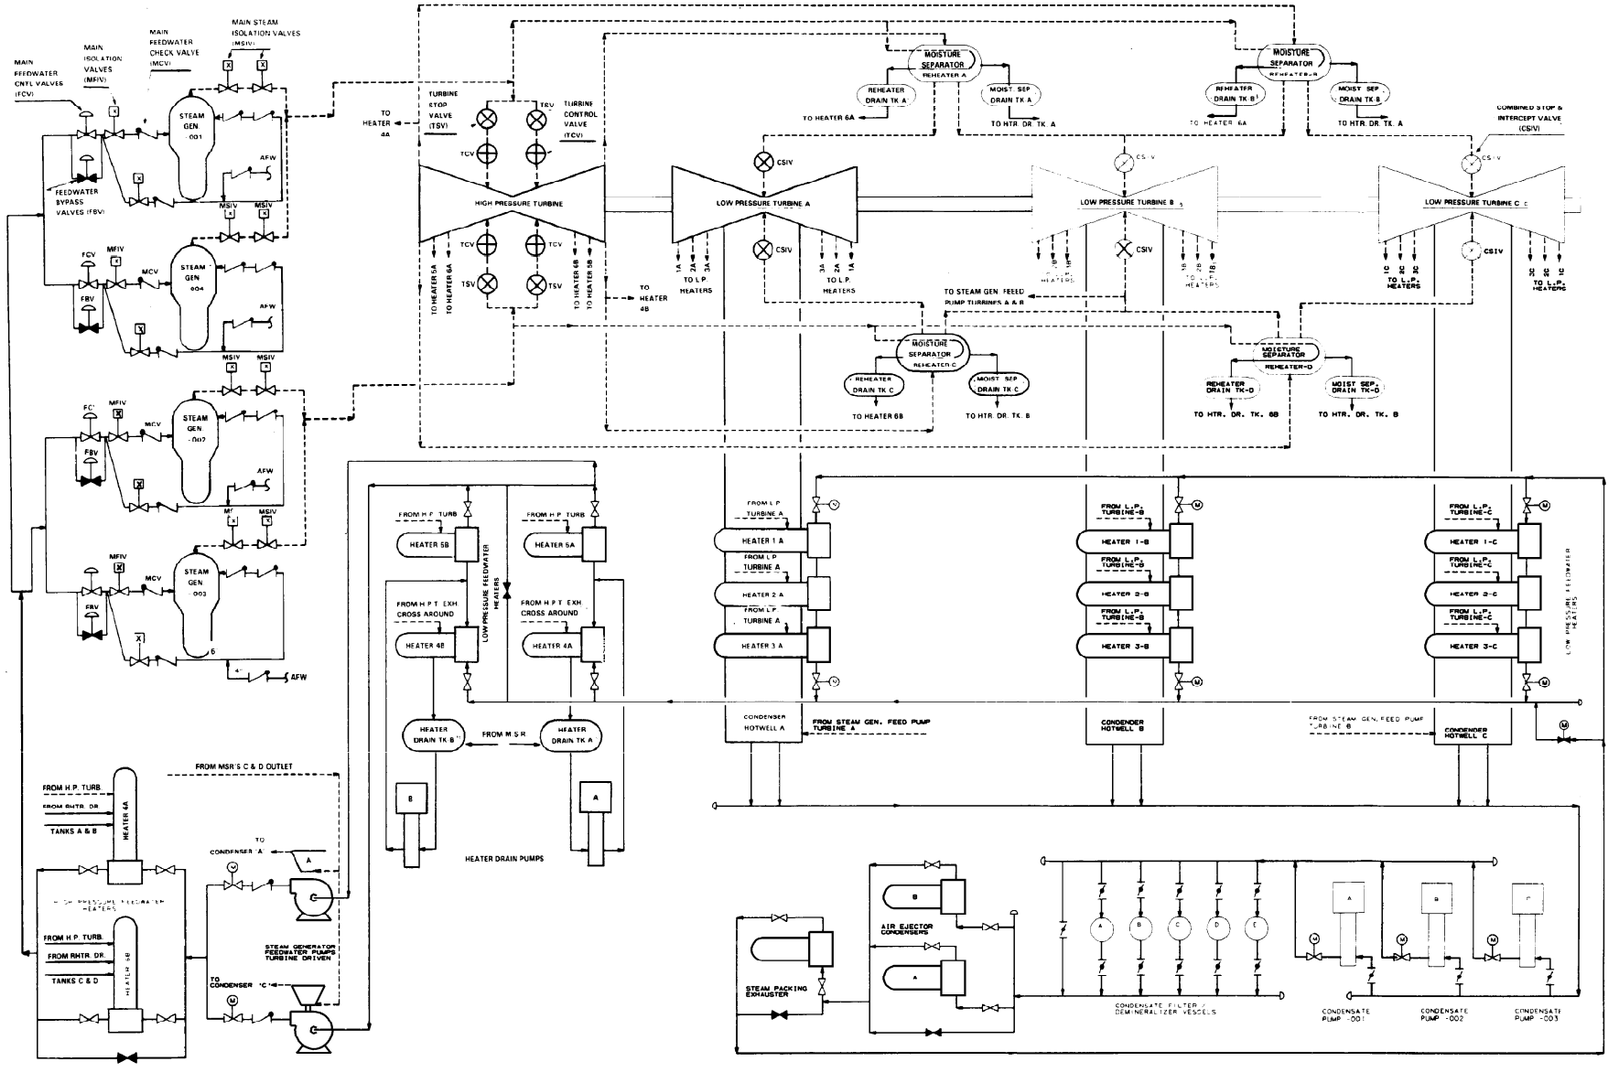

LEGEND:

STEAM

CONDENSATE AND FEEDWATER

SOUTHERN COMPANY SERVICES, INC.
BIRMINGHAM, ALABAMA

GEORGIA POWER COMPANY
ALVIN W. VOGTLE NUCLEAR PLANT

STEAM AND POWER CONVERSION SYSTEMS

NO.	REVISIONS	DATE	DR	CHK	APPV	DTL
0	ISSUED PER REA 96-VAA054	9-30-98	GS	RBH	CBH	WFP

SCALE: NONE

JOB NO. 10604

DRAWING NO. AX6DD403

REV 0

THIS DOCUMENT CONTAINS PROPRIETARY, CONFIDENTIAL, AND/OR TRADE SECRET INFORMATION OF THE SUBSIDIARIES OF THE SOUTHERN COMPANY OR OF THIRD PARTIES. IT IS INTENDED FOR USE ONLY BY EMPLOYEES OF, OR AUTHORIZED CONTRACTORS OF, THE SUBSIDIARIES OF THE SOUTHERN COMPANY. UNAUTHORIZED POSSESSION, USE, DISTRIBUTION, COPYING, DISSEMINATION, OR DISCLOSURE OF ANY PORTION HEREOF IS PROHIBITED.

CAD NAME AX6DD403

SIZE B 11x17

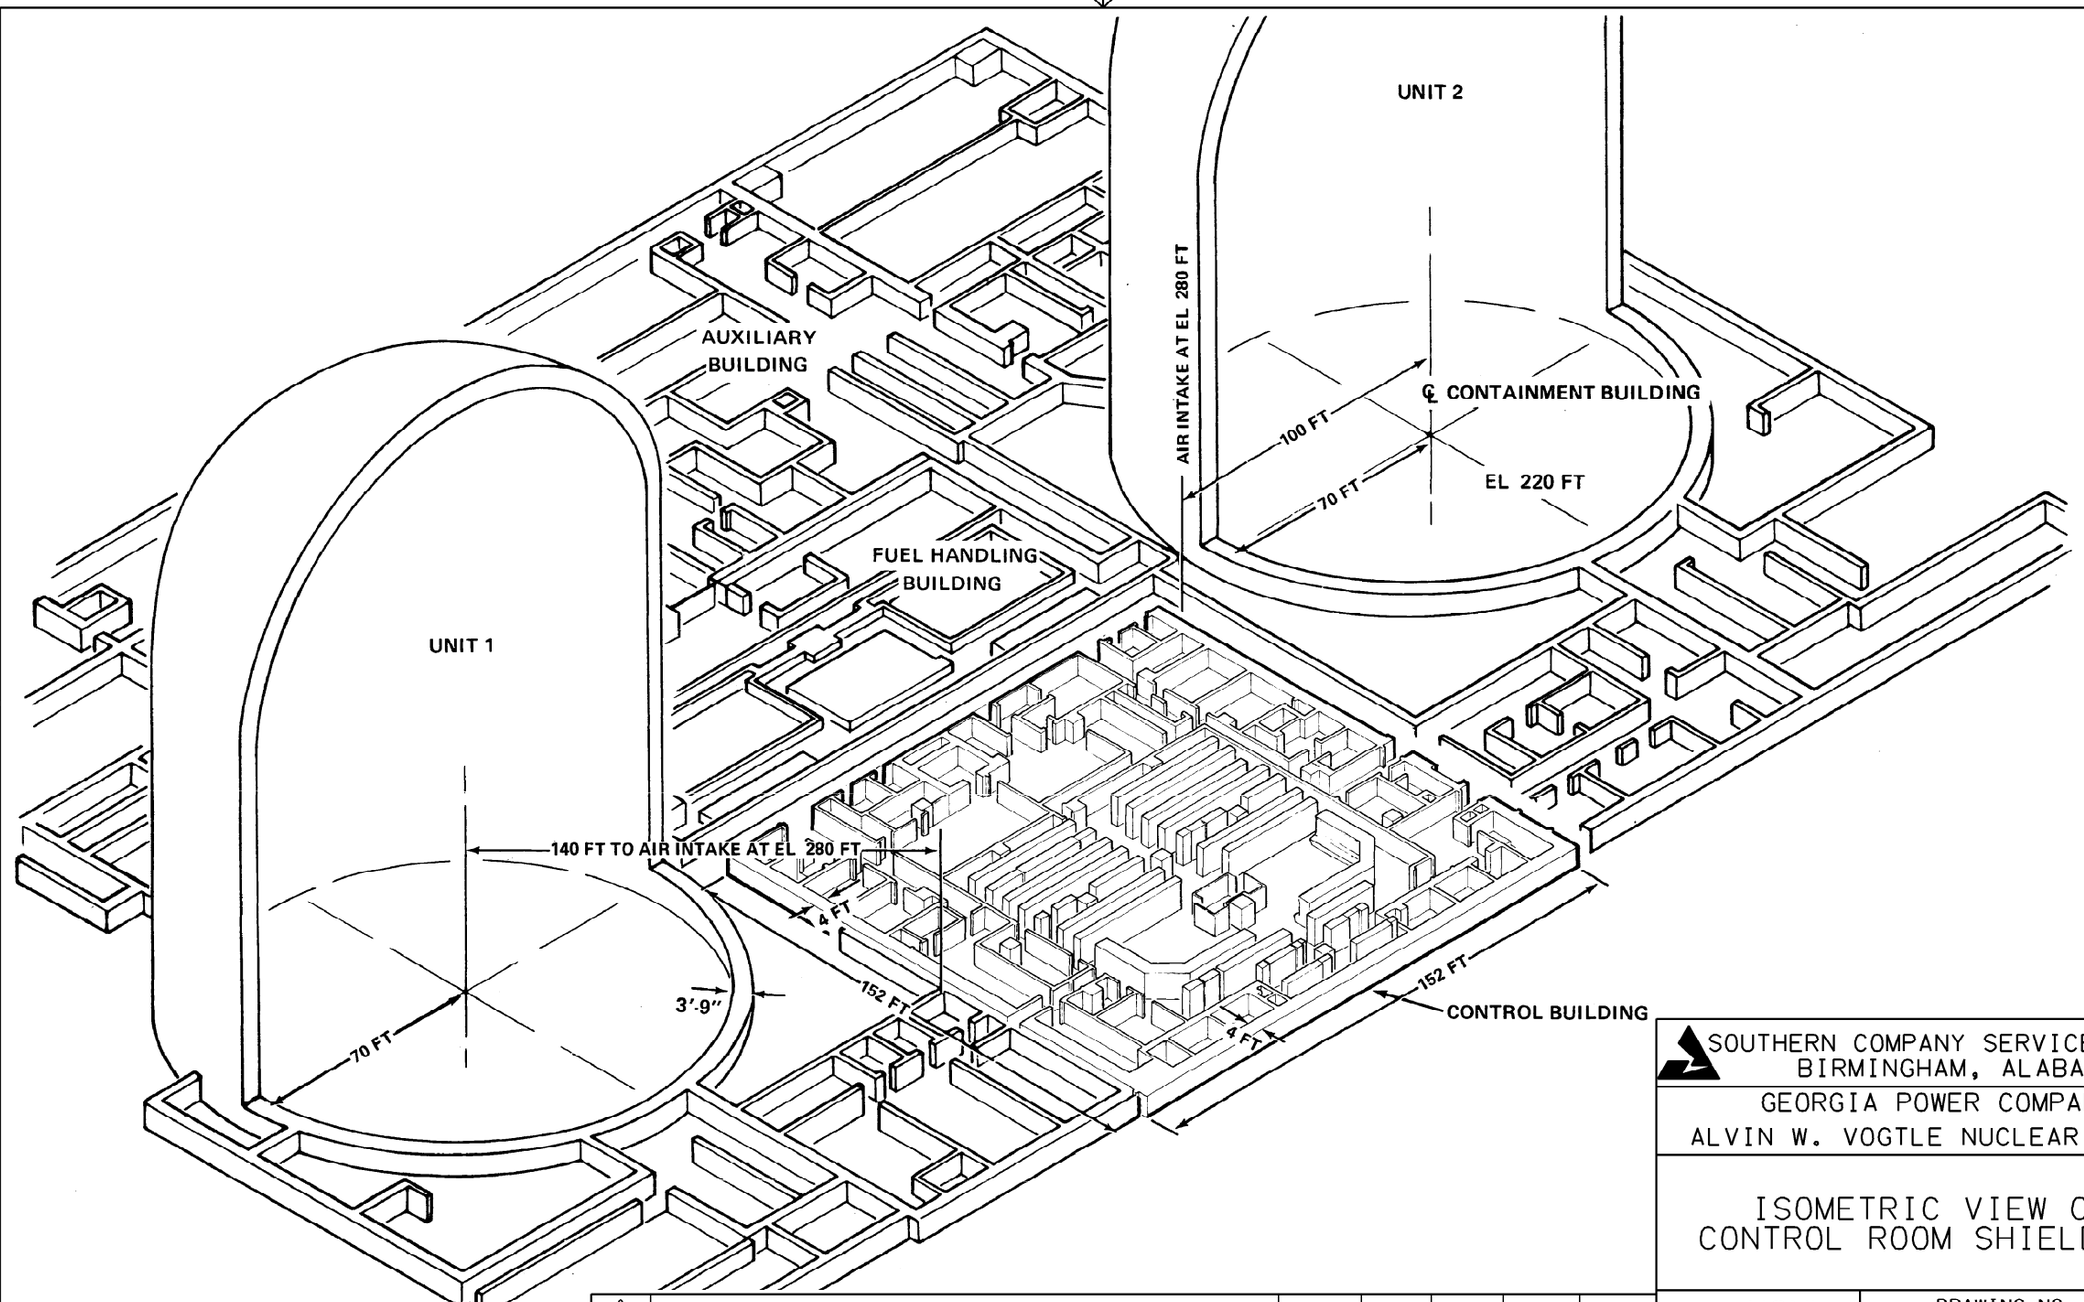

NO.	REVISIONS	DATE	DR	CHK	APPV	DTL
△						
0	ISSUED PER REA 96-VAA054	9-30-98	GS	RBH	CBH	WFP

SOUTHERN COMPANY SERVICES, INC.
BIRMINGHAM, ALABAMA

GEORGIA POWER COMPANY
ALVIN W. VOGTLE NUCLEAR PLANT

ISOMETRIC VIEW OF CONTROL ROOM SHIELDING

SCALE: NONE	DRAWING NO.	REV
JOB NO. 10604	AX6DD404	0

THIS DOCUMENT CONTAINS PROPRIETARY, CONFIDENTIAL, AND/OR TRADE SECRET INFORMATION OF THE SUBSIDIARIES OF THE SOUTHERN COMPANY OR OF THIRD PARTIES. IT IS INTENDED FOR USE ONLY BY EMPLOYEES OF, OR AUTHORIZED CONTRACTORS OF, THE SUBSIDIARIES OF THE SOUTHERN COMPANY. UNAUTHORIZED POSSESSION, USE, DISTRIBUTION, COPYING, DISSEMINATION, OR DISCLOSURE OF ANY PORTION HEREOF IS PROHIBITED.

CAD NAME AX6DD404 SIZE B 11x17

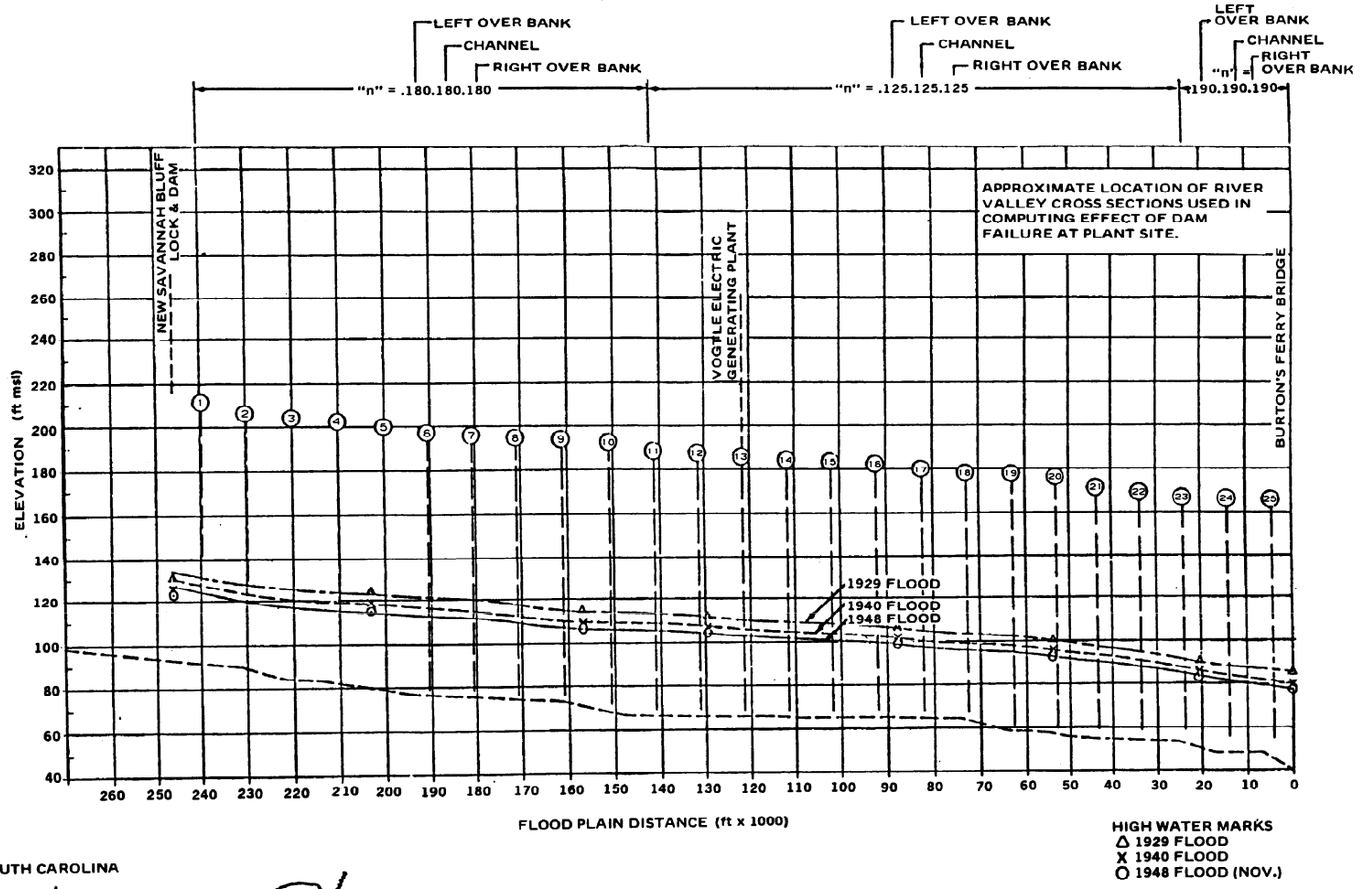

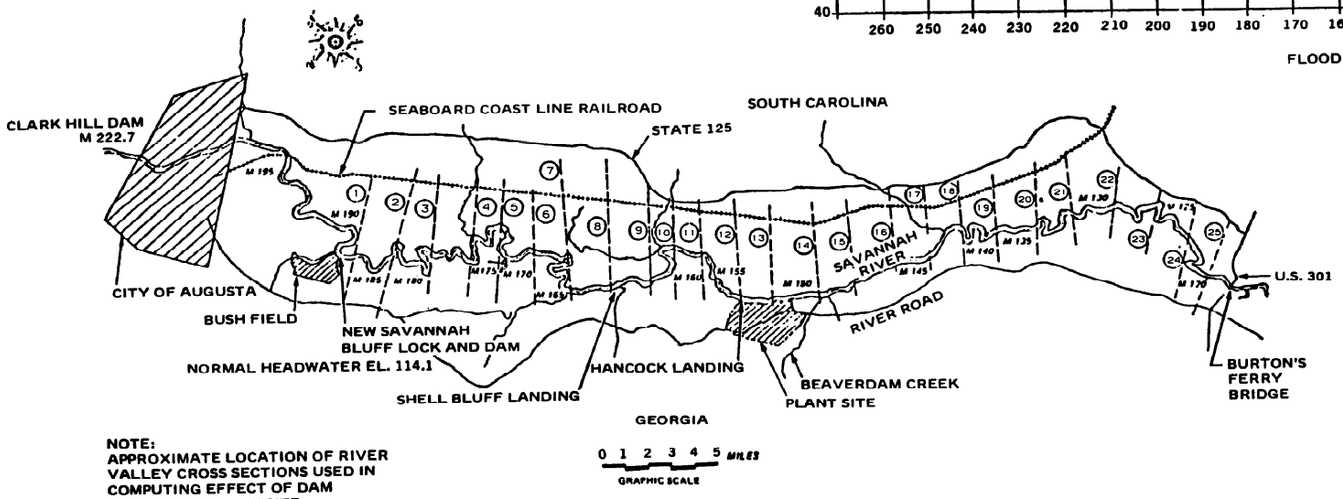

NOTE:
APPROXIMATE LOCATION OF RIVER VALLEY CROSS SECTIONS USED IN COMPUTING EFFECT OF DAM FAILURE AT PLANT SITE.
UNSTEADY NONUNIFORM FLOW.

LEGEND

---- CROSS SECTION
M 175 RIVER MILE 175

NO.	REVISIONS	DATE	DR	CHK	APPV	DTL
△						
0	ISSUED PER REA 96-VAA054	9-30-98	GS	RBH	CBH	WFP

SOUTHERN COMPANY SERVICES, INC.
BIRMINGHAM, ALABAMA

GEORGIA POWER COMPANY
ALVIN W. VOGTLE NUCLEAR PLANT

LOCATION OF SAVANNAH RIVER VALLEY CROSS-SECTION, UNSTEADY, NONUNIFORM FLOW

SCALE: NONE	DRAWING NO.	REV
JOB NO. 10604	AX6DD406	0

THIS DOCUMENT CONTAINS PROPRIETARY, CONFIDENTIAL, AND/OR TRADE SECRET INFORMATION OF THE SUBSIDIARIES OF THE SOUTHERN COMPANY OR OF THIRD PARTIES. IT IS INTENDED FOR USE ONLY BY EMPLOYEES OF, OR AUTHORIZED CONTRACTORS OF, THE SUBSIDIARIES OF THE SOUTHERN COMPANY. UNAUTHORIZED POSSESSION, USE, DISTRIBUTION, COPYING, DISSEMINATION, OR DISCLOSURE OF ANY PORTION HEREOF IS PROHIBITED.

CAD NAME AX6DD406 SIZE B 11x17

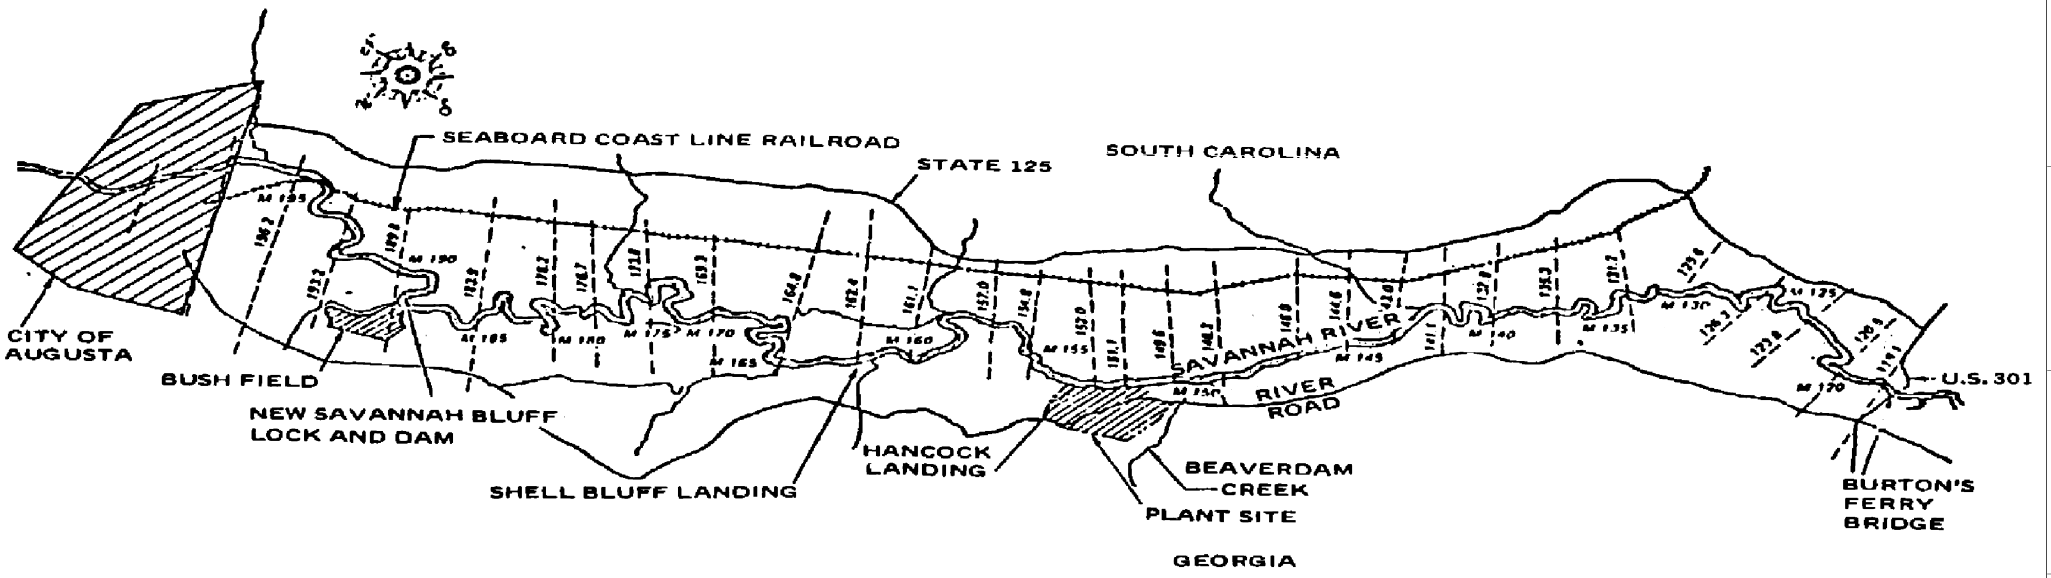

NOTE:
APPROXIMATE LOCATION OF RIVER VALLEY CROSS SECTIONS USED IN COMPUTING BACKWATER PROFILES FOR VARIOUS FLOODS.

LEGEND

– – – – CROSS SECTION
M 140 RIVER MILE 140

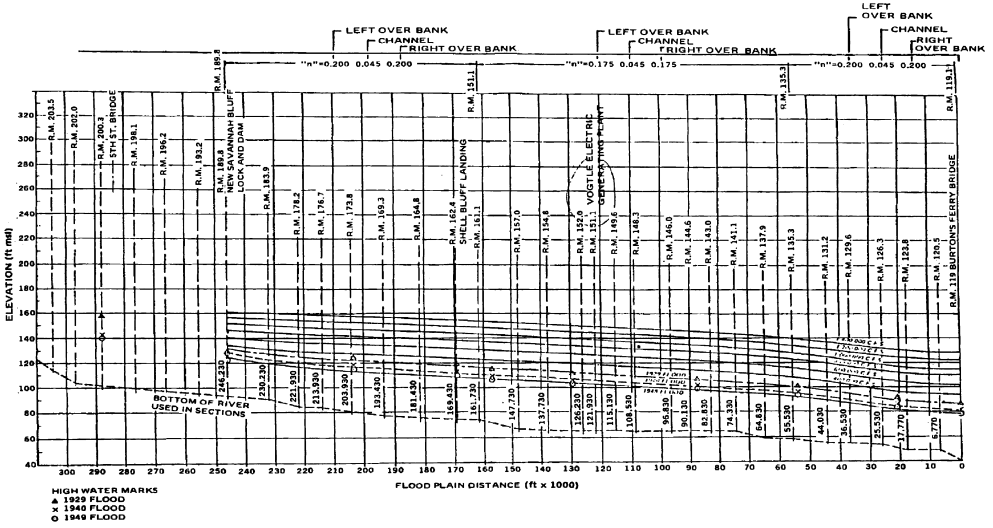

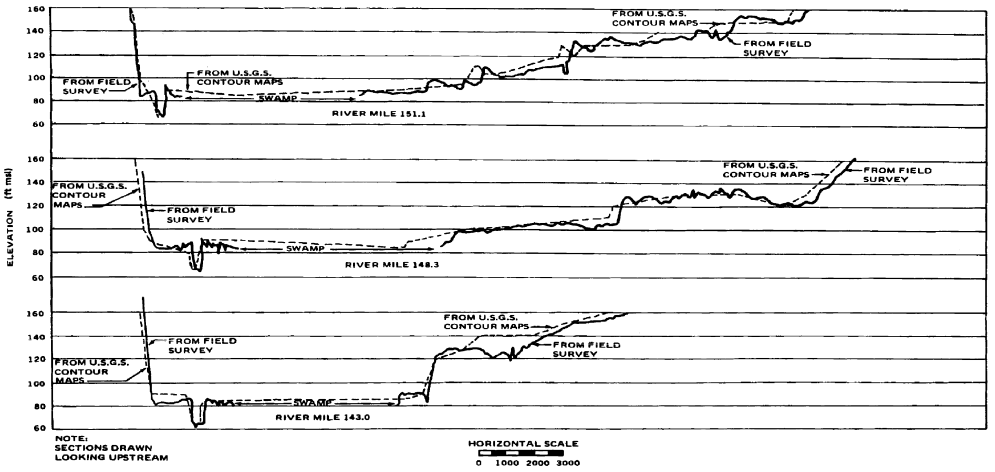

SOUTHERN COMPANY SERVICES, INC.
BIRMINGHAM, ALABAMA

GEORGIA POWER COMPANY
ALVIN W. VOGTLE NUCLEAR PLANT

SAVANNAH RIVER VALLEY
CROSS-SECTION, UNSTEADY,
NONUNIFORM FLOW

SCALE: NONE
DRAWING NO. AX6DD407
REV. 0
JOB NO. 10604
SIZE E 34x44
CAD NAME AX6DD320

NO.	REVISIONS	DATE	DR	CHK	APPV	DTL
3	ISSUED PER REA 96-VAA054	9-30-98	GS	RBH	CBH	WFP

THIS DOCUMENT CONTAINS PROPRIETARY, CONFIDENTIAL, AND/OR TRADE SECRET INFORMATION OF THE SUBSIDIARIES OF THE SOUTHERN COMPANY OR OF THIRD PARTIES. IT IS INTENDED FOR USE ONLY BY EMPLOYEES OF, OR AUTHORIZED CONTRACTORS OF, THE SUBSIDIARIES OF THE SOUTHERN COMPANY. UNAUTHORIZED POSSESSION, USE, DISTRIBUTION, COPYING, DISSEMINATION, OR DISCLOSURE OF ANY PORTION HEREOF IS PROHIBITED.

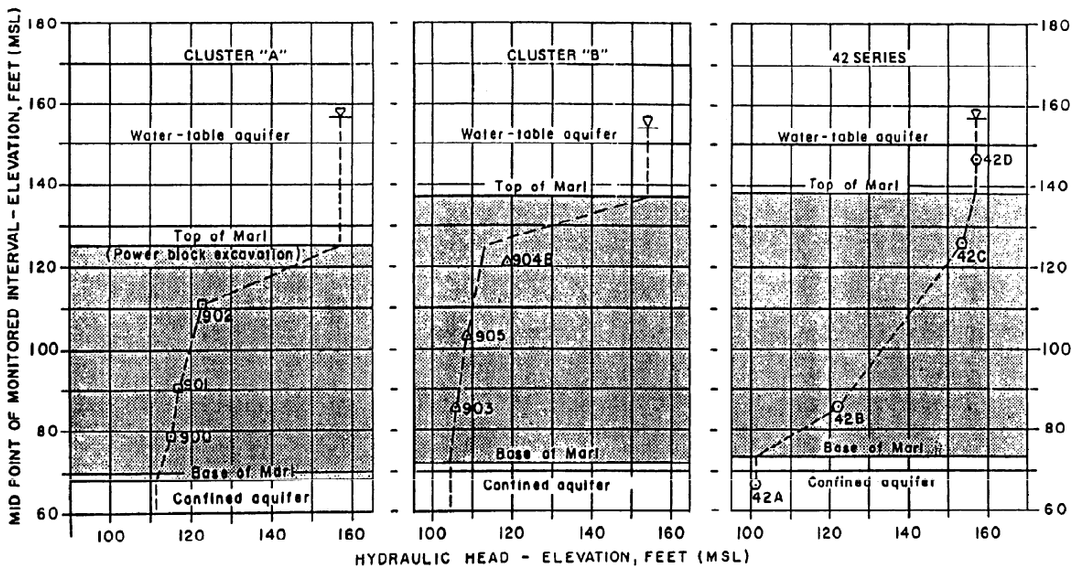

NOTES:
1. Measurements in 900 thru 905 - Nov. 1985
2. Measurements in 42 Series - April 1972
3. Levels for water table and confined aquifers at clusters A and B based on measurements Nov. 1985

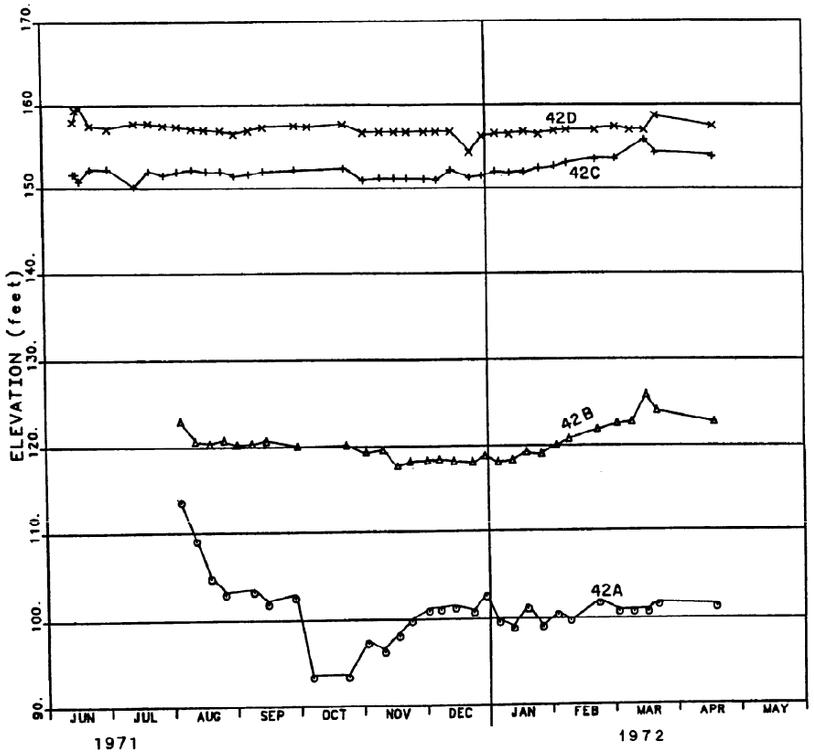

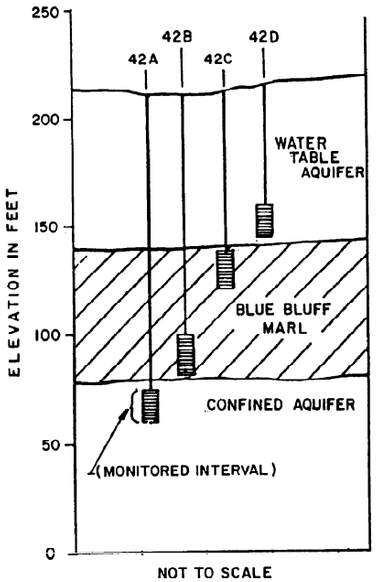

SEE DRAWING AX6DD323 FOR WELL LOCATIONS

TABULATION OF WATER LEVELS WITH NOTES ON MEASUREMENTS AND LEVEL FLUCTUATIONS ARE IN "GROUND WATER SUPPLEMENT", MARCH 1985 (REFERENCE 10).

SOUTHERN COMPANY SERVICES, INC.
BIRMINGHAM, ALABAMA

GEORGIA POWER COMPANY
ALVIN W. VOGTLE NUCLEAR PLANT

WELL 42 SERIES (BLUE BLUFF MARL) HYDROGRAPHS AND PIEZOMETER PROFILES

NO.	REVISIONS	DATE	DR	CHK	APPV	DTL
△						
0	ISSUED PER REA 96-VAA054	9-30-98	GS	RBH	CBH	WFP

SCALE: NONE | DRAWING NO. AX6DD408 | REV 0

JOB NO. 10604

THIS DOCUMENT CONTAINS PROPRIETARY, CONFIDENTIAL, AND/OR TRADE SECRET INFORMATION OF THE SUBSIDIARIES OF THE SOUTHERN COMPANY OR OF THIRD PARTIES. IT IS INTENDED FOR USE ONLY BY EMPLOYEES OF, OR AUTHORIZED CONTRACTORS OF, THE SUBSIDIARIES OF THE SOUTHERN COMPANY. UNAUTHORIZED POSSESSION, USE, DISTRIBUTION, COPYING, DISSEMINATION, OR DISCLOSURE OF ANY PORTION HEREOF IS PROHIBITED.

CAD NAME AX6DD406 SIZE B 11x17

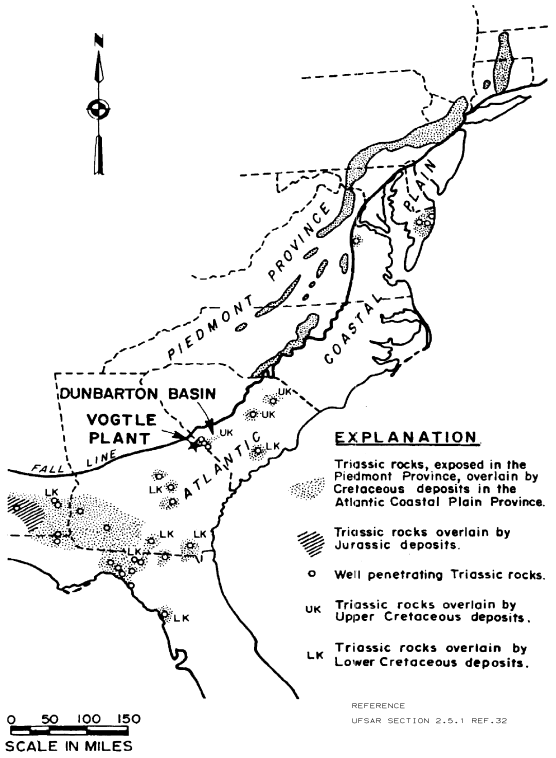

TRIASSIC ROCKS ALONG THE EASTERN SEABOARD

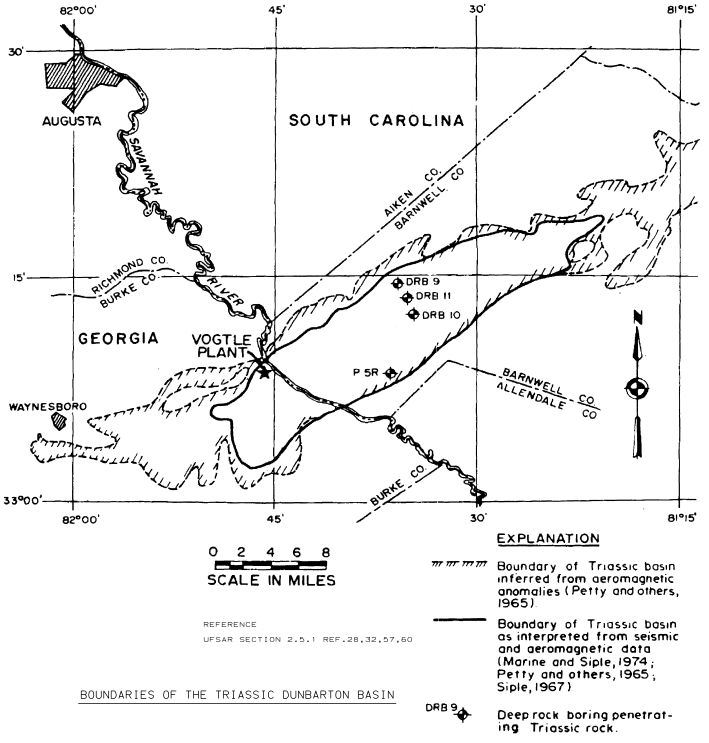

BOUNDARIES OF THE TRIASSIC DUNBARTON BASIN

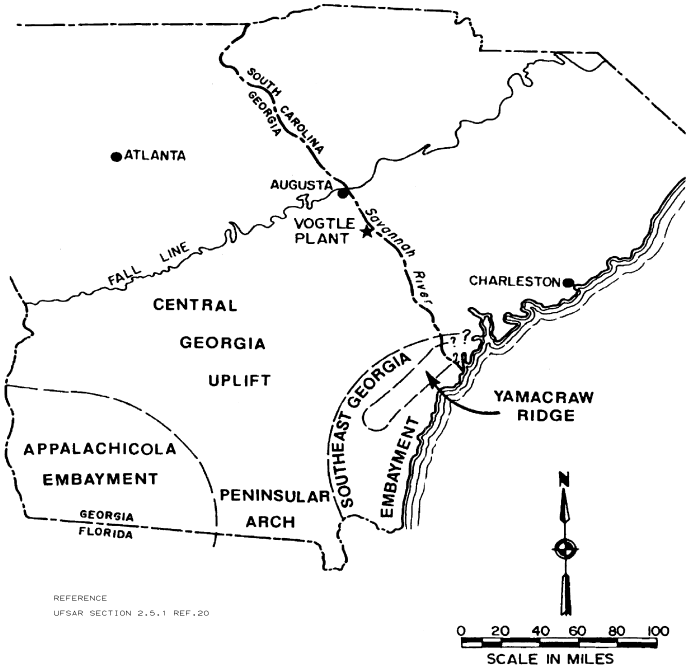

BASEMENT FEATURES GEORGIA COASTAL PLAIN

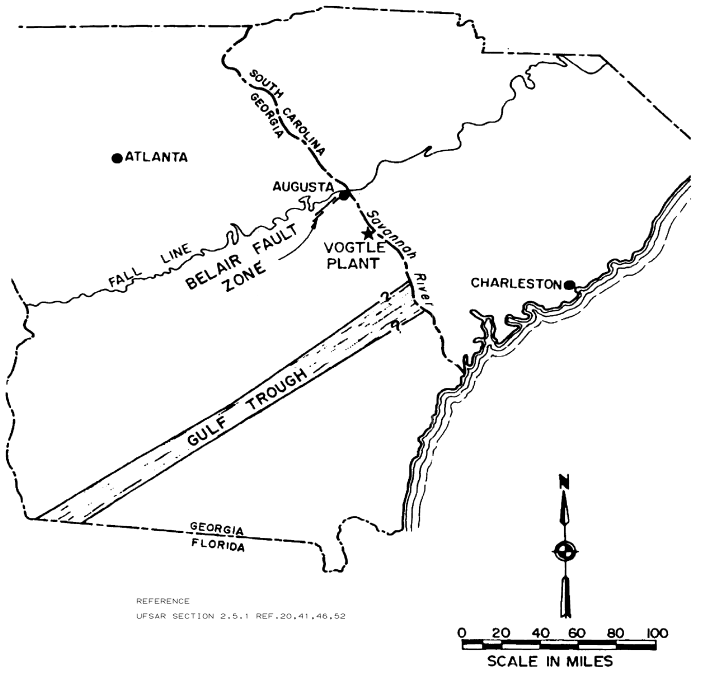

APPROXIMATE LOCATIONS OF BELAIR FAULT ZONE AND GULF TROUGH

THIS DOCUMENT CONTAINS PROPRIETARY, CONFIDENTIAL, AND/OR TRADE SECRET INFORMATION OF THE SUBSIDIARIES OF THE SOUTHERN COMPANY OR OF THIRD PARTIES. IT IS INTENDED FOR USE ONLY BY EMPLOYEES OF, OR AUTHORIZED CONTRACTORS OF, THE SUBSIDIARIES OF THE SOUTHERN COMPANY. UNAUTHORIZED POSSESSION, USE, DISTRIBUTION, COPYING, DISSEMINATION, OR DISCLOSURE OF ANY PORTION HEREOF IS PROHIBITED.

NO.	REVISIONS	DATE	DR	CHK	APPV	DTL
3	ISSUED PER REA 96-VAA054	9-30-98	GS	RBH	CBH	WFP

SOUTHERN COMPANY SERVICES, INC.
BIRMINGHAM, ALABAMA

GEORGIA POWER COMPANY
ALVIN W. VOGTLE NUCLEAR PLANT

REGIONAL GEOLOGIC STRUCTURES

SCALE: NONE | DRAWING NO. AX6DD409 | REV. 0
JOB NO. 10604
SIZE E 34X44
CAD NAME AX6DD409

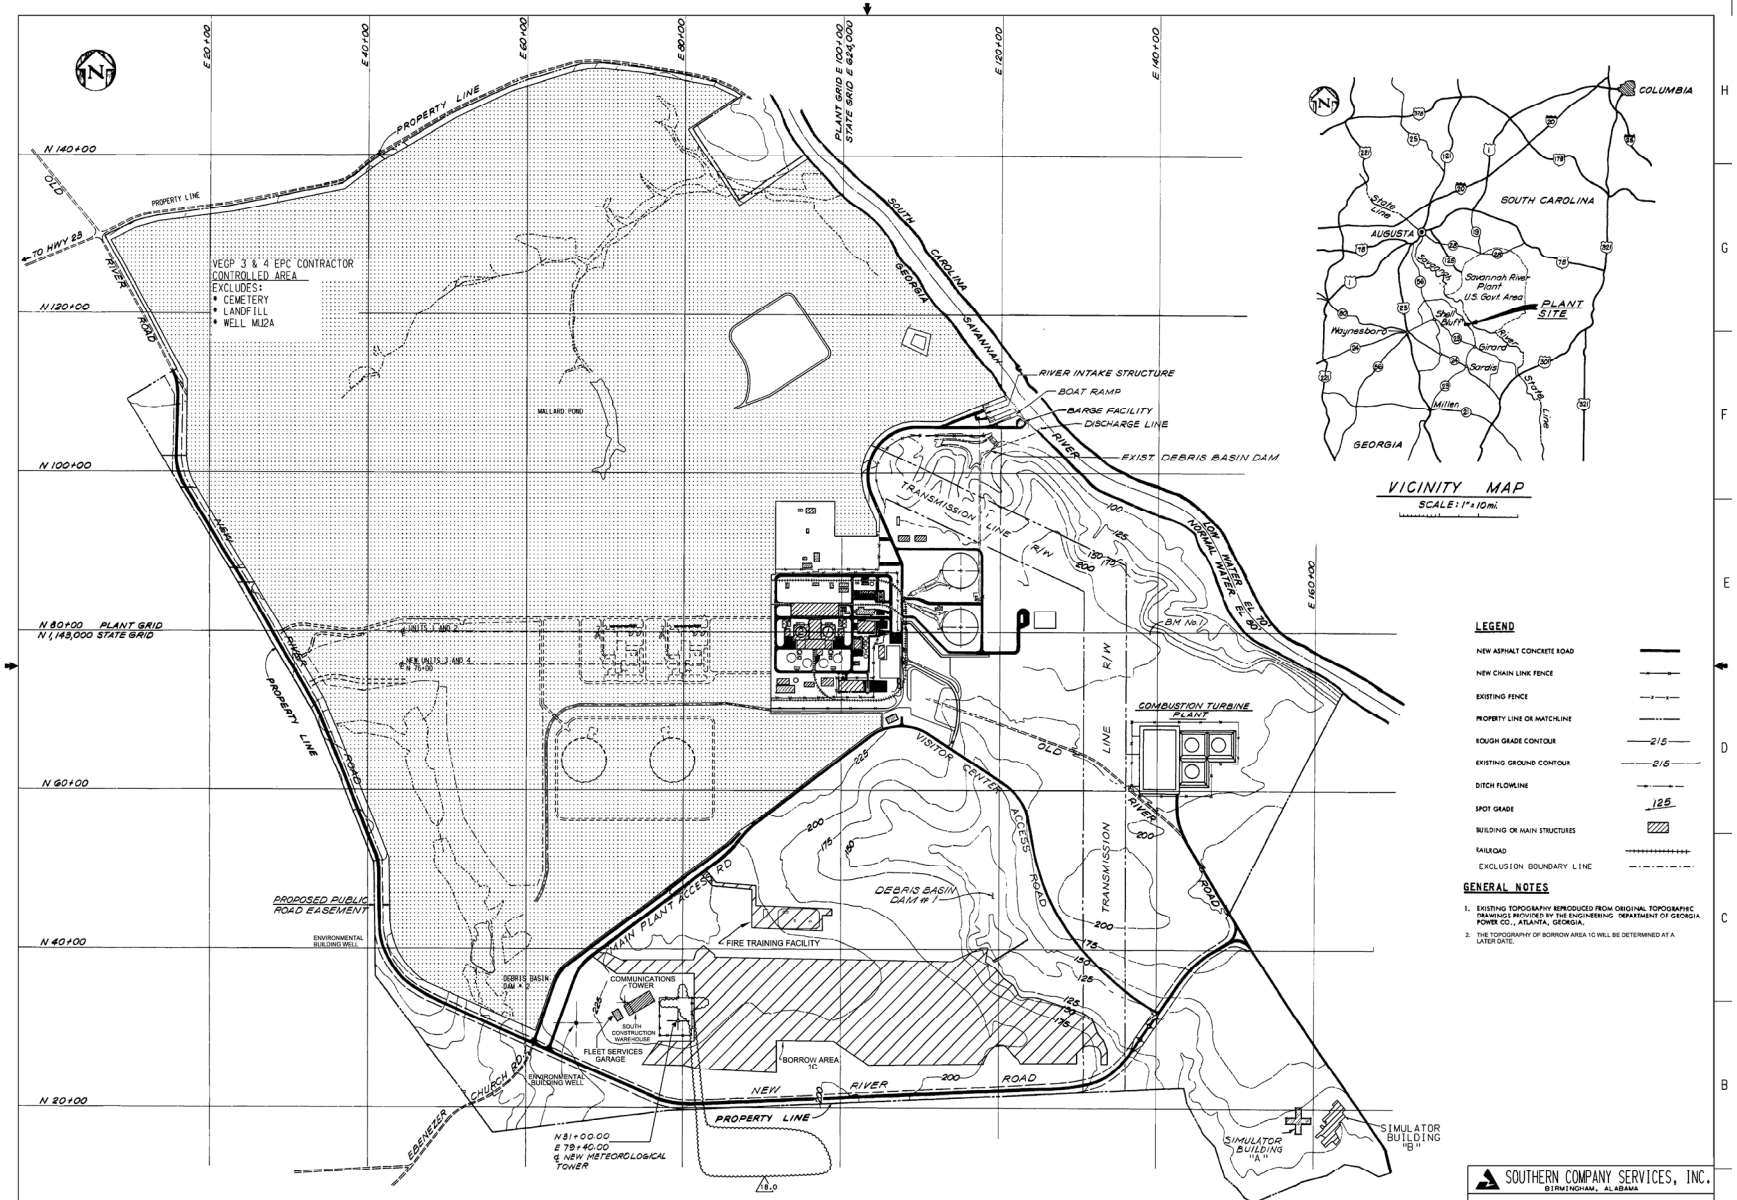

VICINITY MAP
SCALE: 1"=10mi.

LEGEND

- NEW ASPHALT CONCRETE ROAD
- NEW CHAIN LINK FENCE
- EXISTING FENCE
- PROPERTY LINE OR MATCHLINE
- ROUGH GRADE CONTOUR — 215
- EXISTING GROUND CONTOUR — 215
- DITCH FLOWLINE
- SPOT GRADE — 125
- BUILDING OR MAIN STRUCTURES
- RAILROAD
- EXCLUSION BOUNDARY LINE

GENERAL NOTES

1. EXISTING TOPOGRAPHY REPRODUCED FROM ORIGINAL TOPOGRAPHIC DRAWINGS PROVIDED BY THE ENGINEERING DEPARTMENT OF GEORGIA POWER CO., ATLANTA, GEORGIA.
2. THE TOPOGRAPHY OF BORROW AREA 1C WILL BE DETERMINED AT A LATER DATE.

THIS DOCUMENT CONTAINS PROPRIETARY, CONFIDENTIAL, AND/OR TRADE SECRET INFORMATION OF THE SUBSIDIARIES OF THE SOUTHERN COMPANY OR OF THIRD PARTIES. IT IS INTENDED FOR USE ONLY BY EMPLOYEES OF, OR AUTHORIZED CONTRACTORS OF, THE SUBSIDIARIES OF THE SOUTHERN COMPANY. UNAUTHORIZED POSSESSION, USE, DISTRIBUTION, COPYING, DISSEMINATION, OR DISCLOSURE OF ANY PORTION HEREOF IS PROHIBITED.

VERSIONS		DATE	DR	CHK	APPV
18.0	REVISED PER ABN SNC143331E023, VER. 1.0	09/25/15	TDA	ALM	WLN

SOUTHERN COMPANY SERVICES, INC.
BIRMINGHAM, ALABAMA

GEORGIA POWER COMPANY
ALVIN W. VOGTLE NUCLEAR PLANT

LOCATION AND VICINITY MAP

SCALE: 1"=500'-0"	DRAWING NO.	VER.
JOB NO. 10604	CX2D45V002	18.0

CAD NAME: CX2D45V002

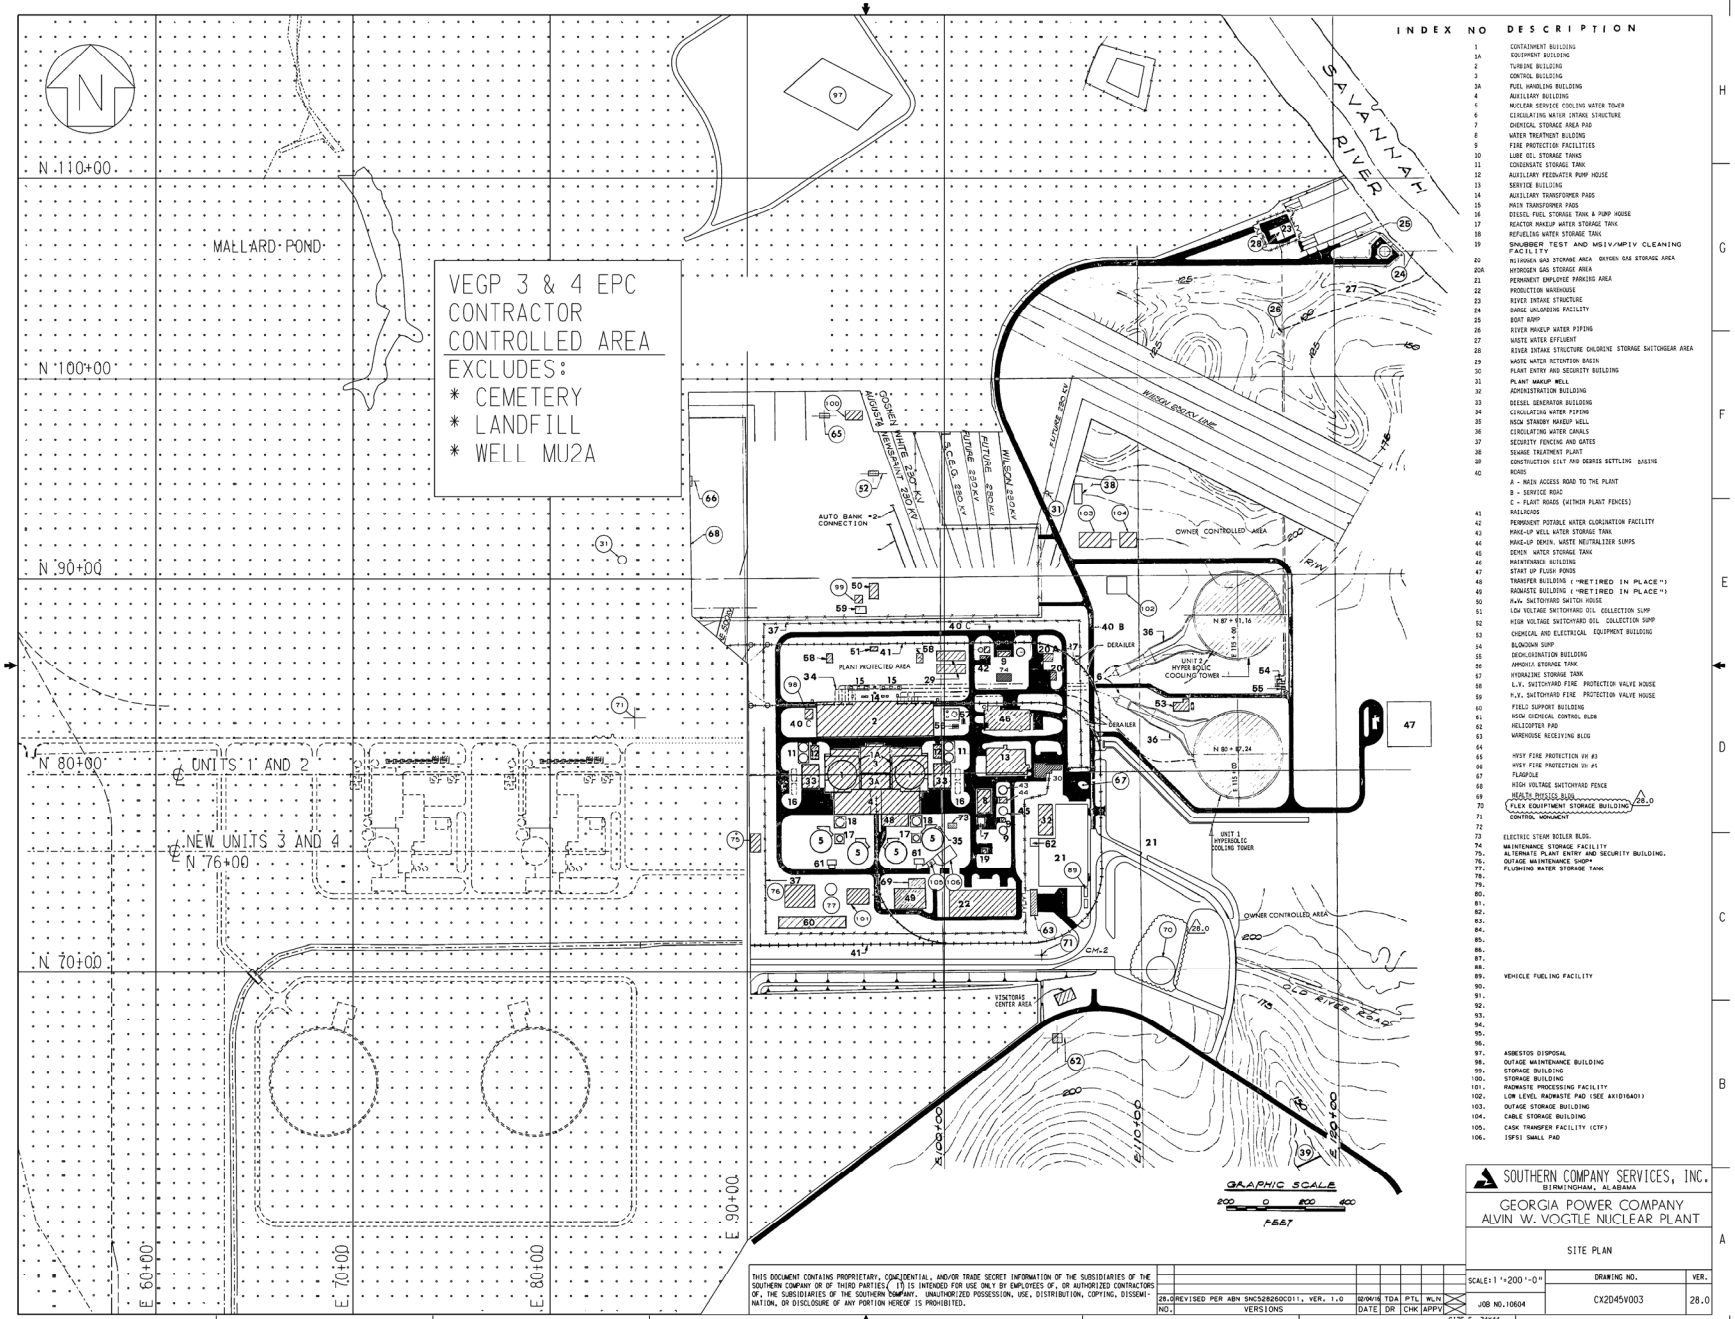

INDEX NO DESCRIPTION

1 CONTAINMENT BUILDING
1A EQUIPMENT BUILDING
2 TURBINE BUILDING
3 CONTROL BUILDING
3A FUEL HANDLING BUILDING
4 AUXILIARY BUILDING
5 NUCLEAR SERVICE COOLING WATER TOWER
6 CIRCULATING WATER INTAKE STRUCTURE
7 CHEMICAL STORAGE AREA PAD
8 WATER TREATMENT BUILDING
9 FIRE PROTECTION FACILITIES
10 LUBE OIL STORAGE TANKS
11 CONDENSATE STORAGE TANK
12 AUXILIARY FEEDWATER PUMP HOUSE
13 SERVICE BUILDING
14 AUXILIARY TRANSFORMER PADS
15 MAIN TRANSFORMER PADS
16 DIESEL FUEL STORAGE TANK & PUMP HOUSE
17 REACTOR MAKEUP WATER STORAGE TANK
18 REFUELING WATER STORAGE TANK
19 SNUBBER TEST AND MSIV/MPIV CLEANING FACILITY
20 NITROGEN GAS STORAGE AREA OXYGEN GAS STORAGE AREA
20A HYDROGEN GAS STORAGE AREA
21 PERMANENT EMPLOYEE PARKING AREA
22 PRODUCTION WAREHOUSE
23 RIVER INTAKE STRUCTURE
24 BARGE UNLOADING FACILITY
25 BOAT RAMP
26 RIVER MAKEUP WATER PIPING
27 WASTE WATER EFFLUENT
28 RIVER INTAKE STRUCTURE CHLORINE STORAGE SWITCHGEAR AREA
29 WASTE WATER RETENTION BASIN
30 PLANT ENTRY AND SECURITY BUILDING
31 PLANT MAKUP WELL
32 ADMINISTRATION BUILDING
33 DIESEL GENERATOR BUILDING
34 CIRCULATING WATER PIPING
35 NSCW STANDBY MAKEUP WELL
36 CIRCULATING WATER CANALS
37 SECURITY FENCING AND GATES
38 SEWAGE TREATMENT PLANT
39 CONSTRUCTION SILT AND DEBRIS SETTLING BASINS
40 ROADS
A - MAIN ACCESS ROAD TO THE PLANT
B - SERVICE ROAD
C - PLANT ROADS (WITHIN PLANT FENCES)
41 RAILROADS
42 PERMANENT POTABLE WATER CHLORINATION FACILITY
43 MAKE-UP WELL WATER STORAGE TANK
44 MAKE-UP DEMIN. WASTE NEUTRALIZER SUMPS
45 DEMIN WATER STORAGE TANK
46 MAINTENANCE BUILDING
47 START UP FLUSH PONDS
48 TRANSFER BUILDING (*RETIRED IN PLACE*)
49 RADWASTE BUILDING (*RETIRED IN PLACE*)
50 H.V. SWITCHYARD SWITCH HOUSE
51 LOW VOLTAGE SWITCHYARD OIL COLLECTION SUMP
52 HIGH VOLTAGE SWITCHYARD OIL COLLECTION SUMP
53 CHEMICAL AND ELECTRICAL EQUIPMENT BUILDING
54 BLOWDOWN SUMP
55 DECHLORINATION BUILDING
56 AMMONIA STORAGE TANK
57 HYDRAZINE STORAGE TANK
58 L.V. SWITCHYARD FIRE PROTECTION VALVE HOUSE
59 H.V. SWITCHYARD FIRE PROTECTION VALVE HOUSE
60 FIELD SUPPORT BUILDING
61 NSCW CHEMICAL CONTROL BLDG
62 HELICOPTER PAD
63 WAREHOUSE RECEIVING BLDG
64
65 HVSY FIRE PROTECTION VH #3
66 HVSY FIRE PROTECTION VH #4
67 FLAGPOLE
68 HIGH VOLTAGE SWITCHYARD FENCE
69 HEALTH PHYSICS BLDG.
70 FLEX EQUIPMENT STORAGE BUILDING 28.0
71 CONTROL MONUMENT
72
73 ELECTRIC STEAM BOILER BLDG.
74 MAINTENANCE STORAGE FACILITY
75 ALTERNATE PLANT ENTRY AND SECURITY BUILDING.
76 OUTAGE MAINTENANCE SHOP*
77 FLUSHING WATER STORAGE TANK
78
79
80
81
82
83
84
85
86
87
88
89 VEHICLE FUELING FACILITY
90
91
92
93
94
95
96
97 ASBESTOS DISPOSAL
98 OUTAGE MAINTENANCE BUILDING
99 STORAGE BUILDING
100 STORAGE BUILDING
101 RADWASTE PROCESSING FACILITY
102 LOW LEVEL RADWASTE PAD (SEE AX1D16A01)
103 OUTAGE STORAGE BUILDING
104 CABLE STORAGE BUILDING
105 CASK TRANSFER FACILITY (CTF)
106 ISFSI SMALL PAD

THIS DOCUMENT CONTAINS PROPRIETARY, CONFIDENTIAL, AND/OR TRADE SECRET INFORMATION OF THE SUBSIDIARIES OF THE SOUTHERN COMPANY OR OF THIRD PARTIES. IT IS INTENDED FOR USE ONLY BY EMPLOYEES OF, OR AUTHORIZED CONTRACTORS OF, THE SUBSIDIARIES OF THE SOUTHERN COMPANY. UNAUTHORIZED POSSESSION, USE, DISTRIBUTION, COPYING, DISSEMINATION, OR DISCLOSURE OF ANY PORTION HEREOF IS PROHIBITED.

NO.	VERSIONS	DATE	DR	CHK	APPV
28.0	REVISED PER ABN SNC528260CD11, VER. 1.0	02/04/16	TDA	PTL	WLN

SOUTHERN COMPANY SERVICES, INC.
BIRMINGHAM, ALABAMA

GEORGIA POWER COMPANY
ALVIN W. VOGTLE NUCLEAR PLANT

SITE PLAN

SCALE: 1"=200'-0"	DRAWING NO.	VER.
JOB NO. 10604	CX2D45V003	28.0

SIZE E 34x44

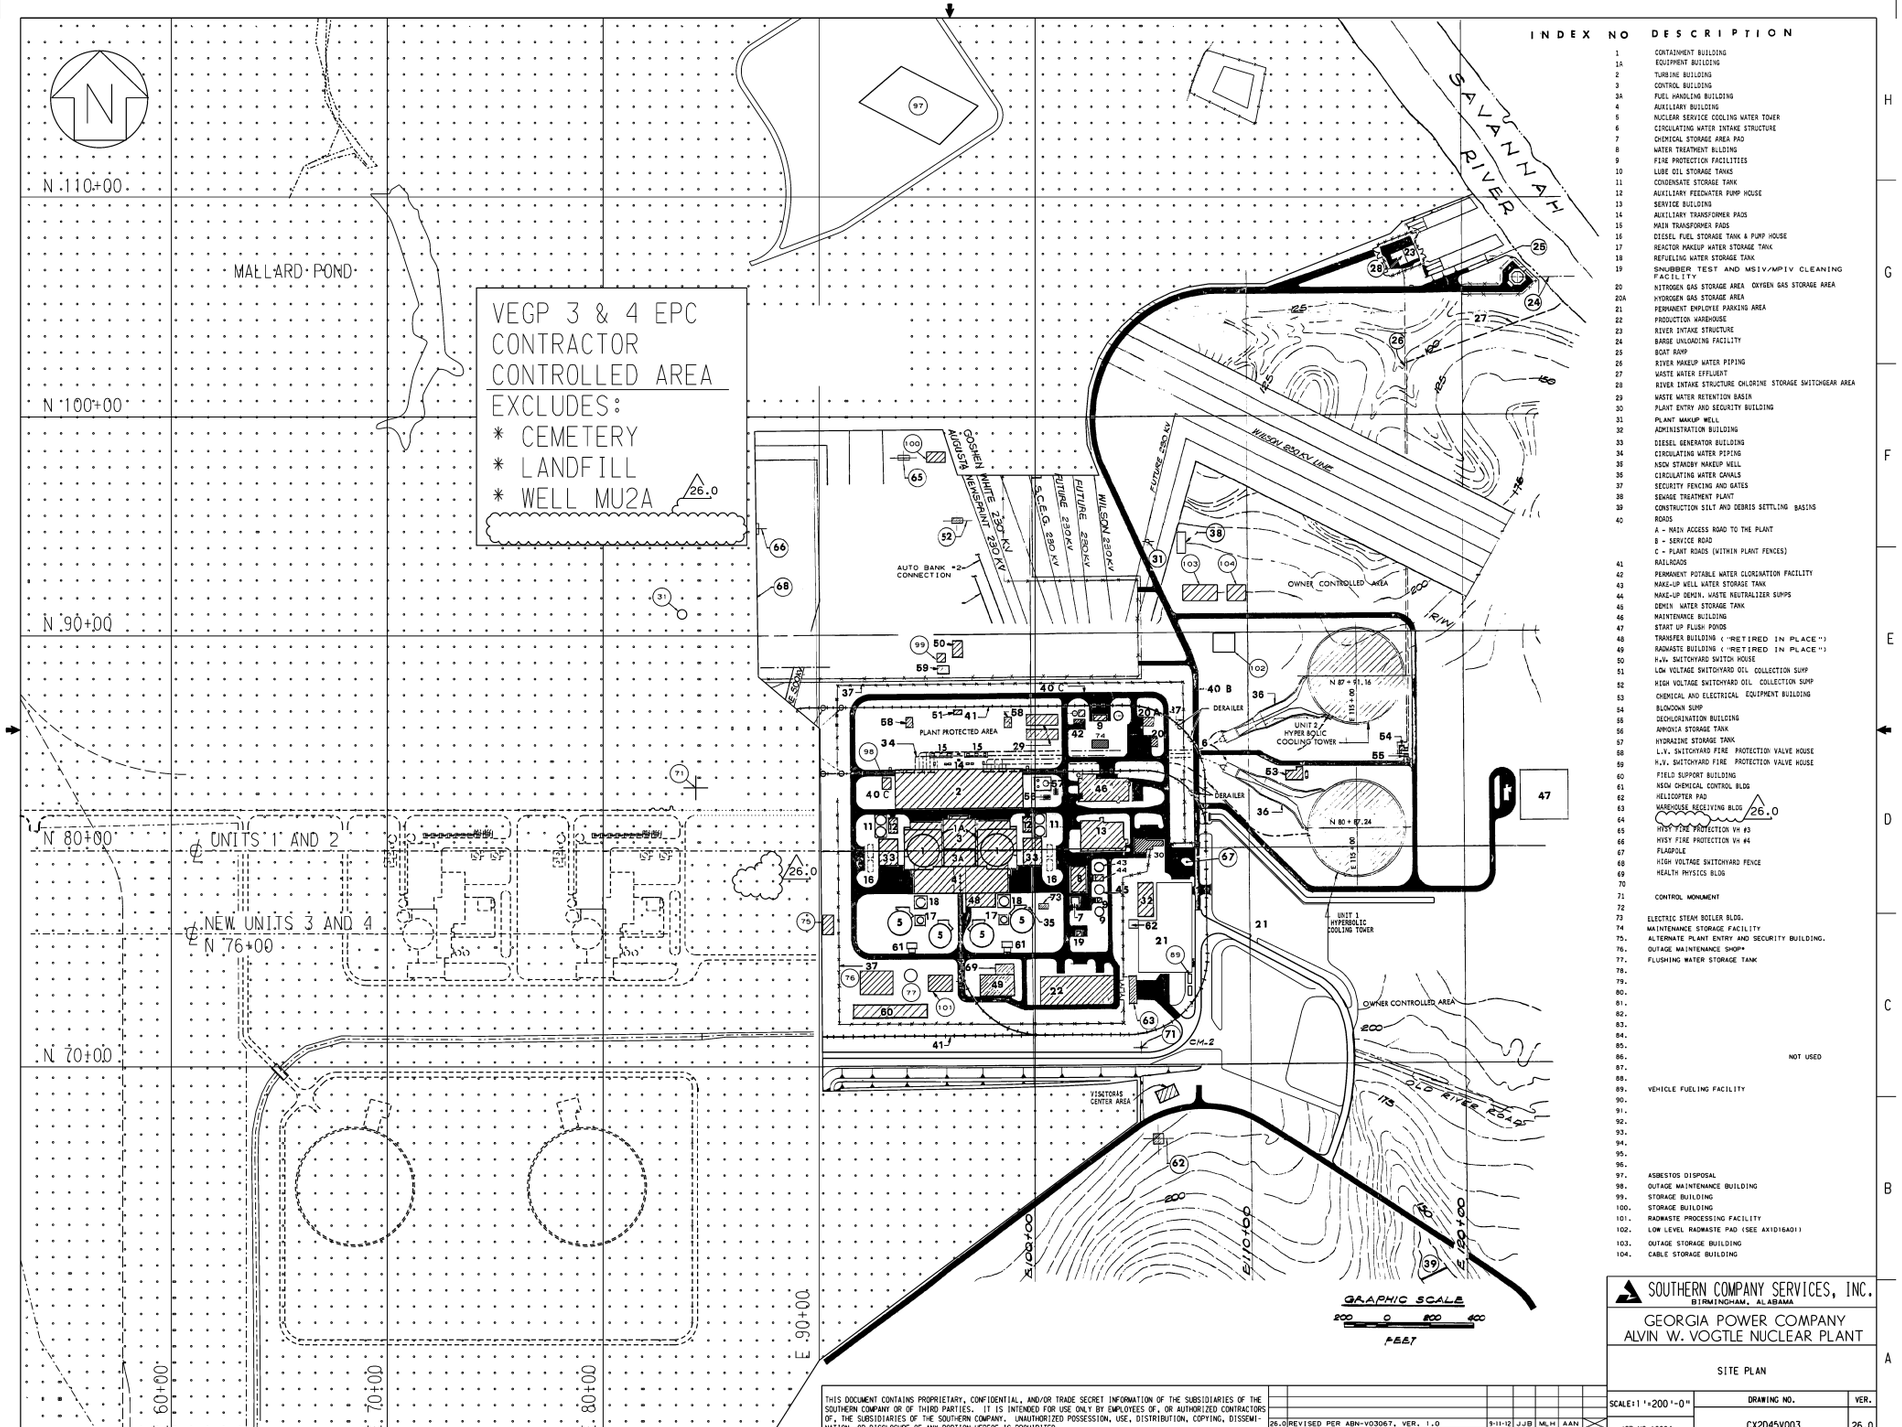

INDEX NO DESCRIPTION

1	CONTAINMENT BUILDING
1A	EQUIPMENT BUILDING
2	TURBINE BUILDING
3	CONTROL BUILDING
3A	FUEL HANDLING BUILDING
4	AUXILIARY BUILDING
5	NUCLEAR SERVICE COOLING WATER TOWER
6	CIRCULATING WATER INTAKE STRUCTURE
7	CHEMICAL STORAGE AREA PAD
8	WATER TREATMENT BUILDING
9	FIRE PROTECTION FACILITIES
10	LUBE OIL STORAGE TANKS
11	CONDENSATE STORAGE TANK
12	AUXILIARY FEEDWATER PUMP HOUSE
13	SERVICE BUILDING
14	AUXILIARY TRANSFORMER PADS
15	MAIN TRANSFORMER PADS
16	DIESEL FUEL STORAGE TANK & PUMP HOUSE
17	REACTOR MAKEUP WATER STORAGE TANK
18	REFUELING WATER STORAGE TANK
19	SNUBBER TEST AND MSIV/MPIV CLEANING FACILITY
20	NITROGEN GAS STORAGE AREA OXYGEN GAS STORAGE AREA
20A	HYDROGEN GAS STORAGE AREA
21	PERMANENT EMPLOYEE PARKING AREA
22	PRODUCTION WAREHOUSE
23	RIVER INTAKE STRUCTURE
24	BARGE UNLOADING FACILITY
25	BOAT RAMP
26	RIVER MAKEUP WATER PIPING
27	WASTE WATER EFFLUENT
28	RIVER INTAKE STRUCTURE CHLORINE STORAGE SWITCHGEAR AREA
29	WASTE WATER RETENTION BASIN
30	PLANT ENTRY AND SECURITY BUILDING
31	PLANT MAKEUP WELL
32	ADMINISTRATION BUILDING
33	DIESEL GENERATOR BUILDING
34	CIRCULATING WATER PIPING
35	NSOV STANDBY MAKEUP WELL
36	CIRCULATING WATER CANALS
37	SECURITY FENCING AND GATES
38	SEWAGE TREATMENT PLANT
39	CONSTRUCTION SILT AND DEBRIS SETTLING BASINS
40	ROADS A - MAIN ACCESS ROAD TO THE PLANT B - SERVICE ROAD C - PLANT ROADS (WITHIN PLANT FENCES)
41	RAILROADS
42	PERMANENT POTABLE WATER CHLORINATION FACILITY
43	MAKE-UP WELL WATER STORAGE TANK
44	MAKE-UP DEMIN. WASTE NEUTRALIZER SUMPS
45	DEMIN WATER STORAGE TANK
46	MAINTENANCE BUILDING
47	START UP FLUSH PONDS
48	TRANSFER BUILDING (-RETIRED IN PLACE-)
49	RADWASTE BUILDING (-RETIRED IN PLACE-)
50	H.V. SWITCHYARD SWITCH HOUSE
51	LOW VOLTAGE SWITCHYARD OIL COLLECTION SUMP
52	HIGH VOLTAGE SWITCHYARD OIL COLLECTION SUMP
53	CHEMICAL AND ELECTRICAL EQUIPMENT BUILDING
54	BLOWDOWN SUMP
55	DECHLORINATION BUILDING
56	AMMONIA STORAGE TANK
57	HYDRAZINE STORAGE TANK
58	L.V. SWITCHYARD FIRE PROTECTION VALVE HOUSE
59	H.V. SWITCHYARD FIRE PROTECTION VALVE HOUSE
60	FIELD SUPPORT BUILDING
61	NSOV CHEMICAL CONTROL BLDG
62	HELICOPTER PAD
63	WAREHOUSE RECEIVING BLDG 26.0
64	
65	HVSY FIRE PROTECTION VH #3
66	HVSY FIRE PROTECTION VH #4
67	FLAGPOLE
68	HIGH VOLTAGE SWITCHYARD FENCE
69	HEALTH PHYSICS BLDG
70	
71	CONTROL MONUMENT
72	
73	ELECTRIC STEAM BOILER BLDG.
74	MAINTENANCE STORAGE FACILITY
75.	ALTERNATE PLANT ENTRY AND SECURITY BUILDING.
76.	OUTAGE MAINTENANCE SHOP*
77.	FLUSHING WATER STORAGE TANK
78.	
79.	
80.	
81.	
82.	
83.	
84.	
85.	
86.	NOT USED
87.	
88.	
89.	VEHICLE FUELING FACILITY
90.	
91.	
92.	
93.	
94.	
95.	
96.	
97.	ASBESTOS DISPOSAL
98.	OUTAGE MAINTENANCE BUILDING
99.	STORAGE BUILDING
100.	STORAGE BUILDING
101.	RADWASTE PROCESSING FACILITY
102.	LOW LEVEL RADWASTE PAD (SEE AX1D16A01)
103.	OUTAGE STORAGE BUILDING
104.	CABLE STORAGE BUILDING

THIS DOCUMENT CONTAINS PROPRIETARY, CONFIDENTIAL, AND/OR TRADE SECRET INFORMATION OF THE SUBSIDIARIES OF THE SOUTHERN COMPANY OR OF THIRD PARTIES. IT IS INTENDED FOR USE ONLY BY EMPLOYEES OF, OR AUTHORIZED CONTRACTORS OF, THE SUBSIDIARIES OF THE SOUTHERN COMPANY. UNAUTHORIZED POSSESSION, USE, DISTRIBUTION, COPYING, DISSEMINATION, OR DISCLOSURE OF ANY PORTION HEREOF IS PROHIBITED.

NO.	VERSIONS	DATE	DR	CHK	APPV
26.0	REVISED PER ABN-V03067, VER. 1.0	9-11-12	JJB	MLH	AAN

SOUTHERN COMPANY SERVICES, INC.
BIRMINGHAM, ALABAMA

GEORGIA POWER COMPANY
ALVIN W. VOGTLE NUCLEAR PLANT

SITE PLAN

SCALE: 1"=200'-0" | JOB NO. 10604 | DRAWING NO. CX2D45V003 | VER. 26.0

SIZE E 34x44

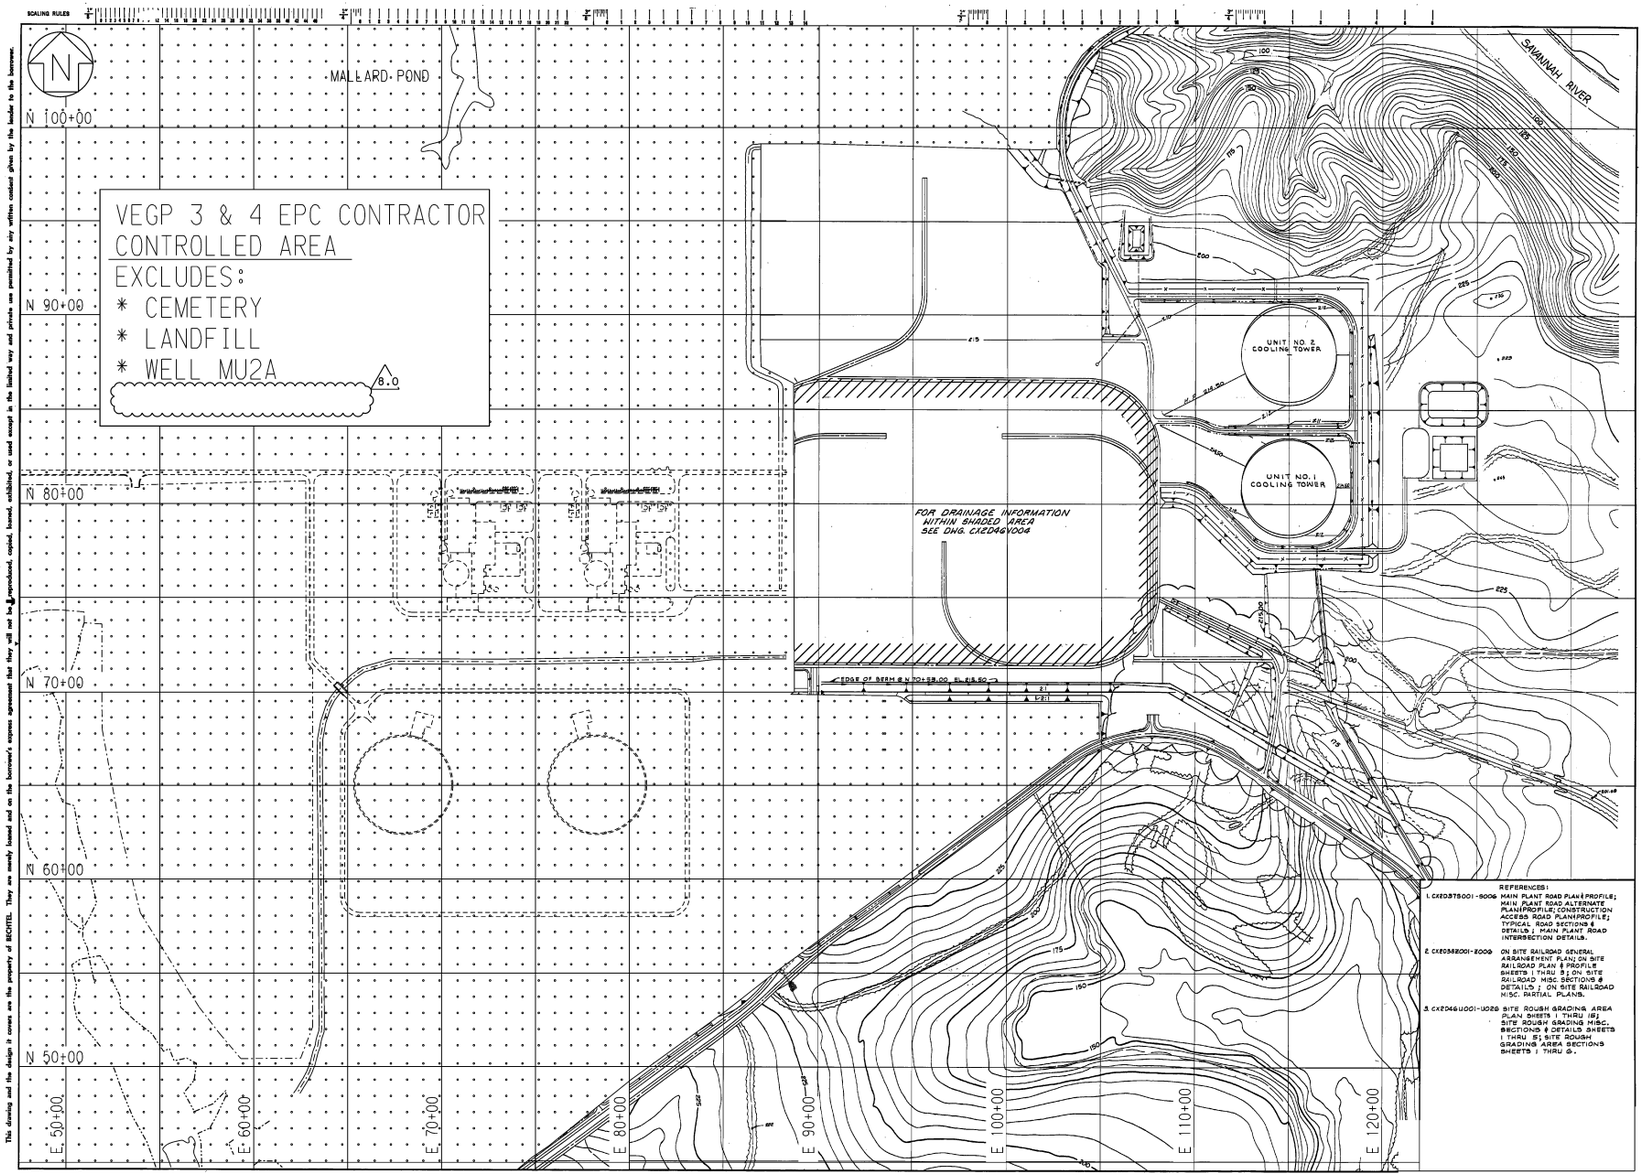

This drawing and the design it covers are the property of BECHTEL. They are merely loaned and on the borrower's express agreement that they will not be reproduced, copied, loaned, exhibited, or used except in the limited way and private use permitted by any written consent given by the lender to the borrower.

THIS DOCUMENT CONTAINS PROPRIETARY, CONFIDENTIAL, AND/OR TRADE SECRET INFORMATION OF THE SUBSIDIARIES OF THE SOUTHERN COMPANY OR OF THIRD PARTIES. IT IS INTENDED FOR USE ONLY BY EMPLOYEES OF, OR AUTHORIZED CONTRACTORS OF, THE SUBSIDIARIES OF THE SOUTHERN COMPANY. UNAUTHORIZED POSSESSION, USE, DISTRIBUTION, COPYING, DISSEMINATION, OR DISCLOSURE OF ANY PORTION HEREOF IS PROHIBITED.

NO.	VERSIONS	DATE	DR	CHK	APPV
8.0	REVISED PER ABN-V03067, VER. 1.0	9-11-12	JJB	MLH	AAN

SOUTHERN COMPANY SERVICES, INC.
BIRMINGHAM, ALABAMA

GEORGIA POWER COMPANY
ALVIN W. VOGTLE NUCLEAR PLANT

SITE ROUGH GRADING AND DRAINAGE PLAN

SCALE: 1"=200'-0"	DRAWING NO.	VER.
JOB NO. 10504	CX2D46V003	8.0

SIZE E 34x44

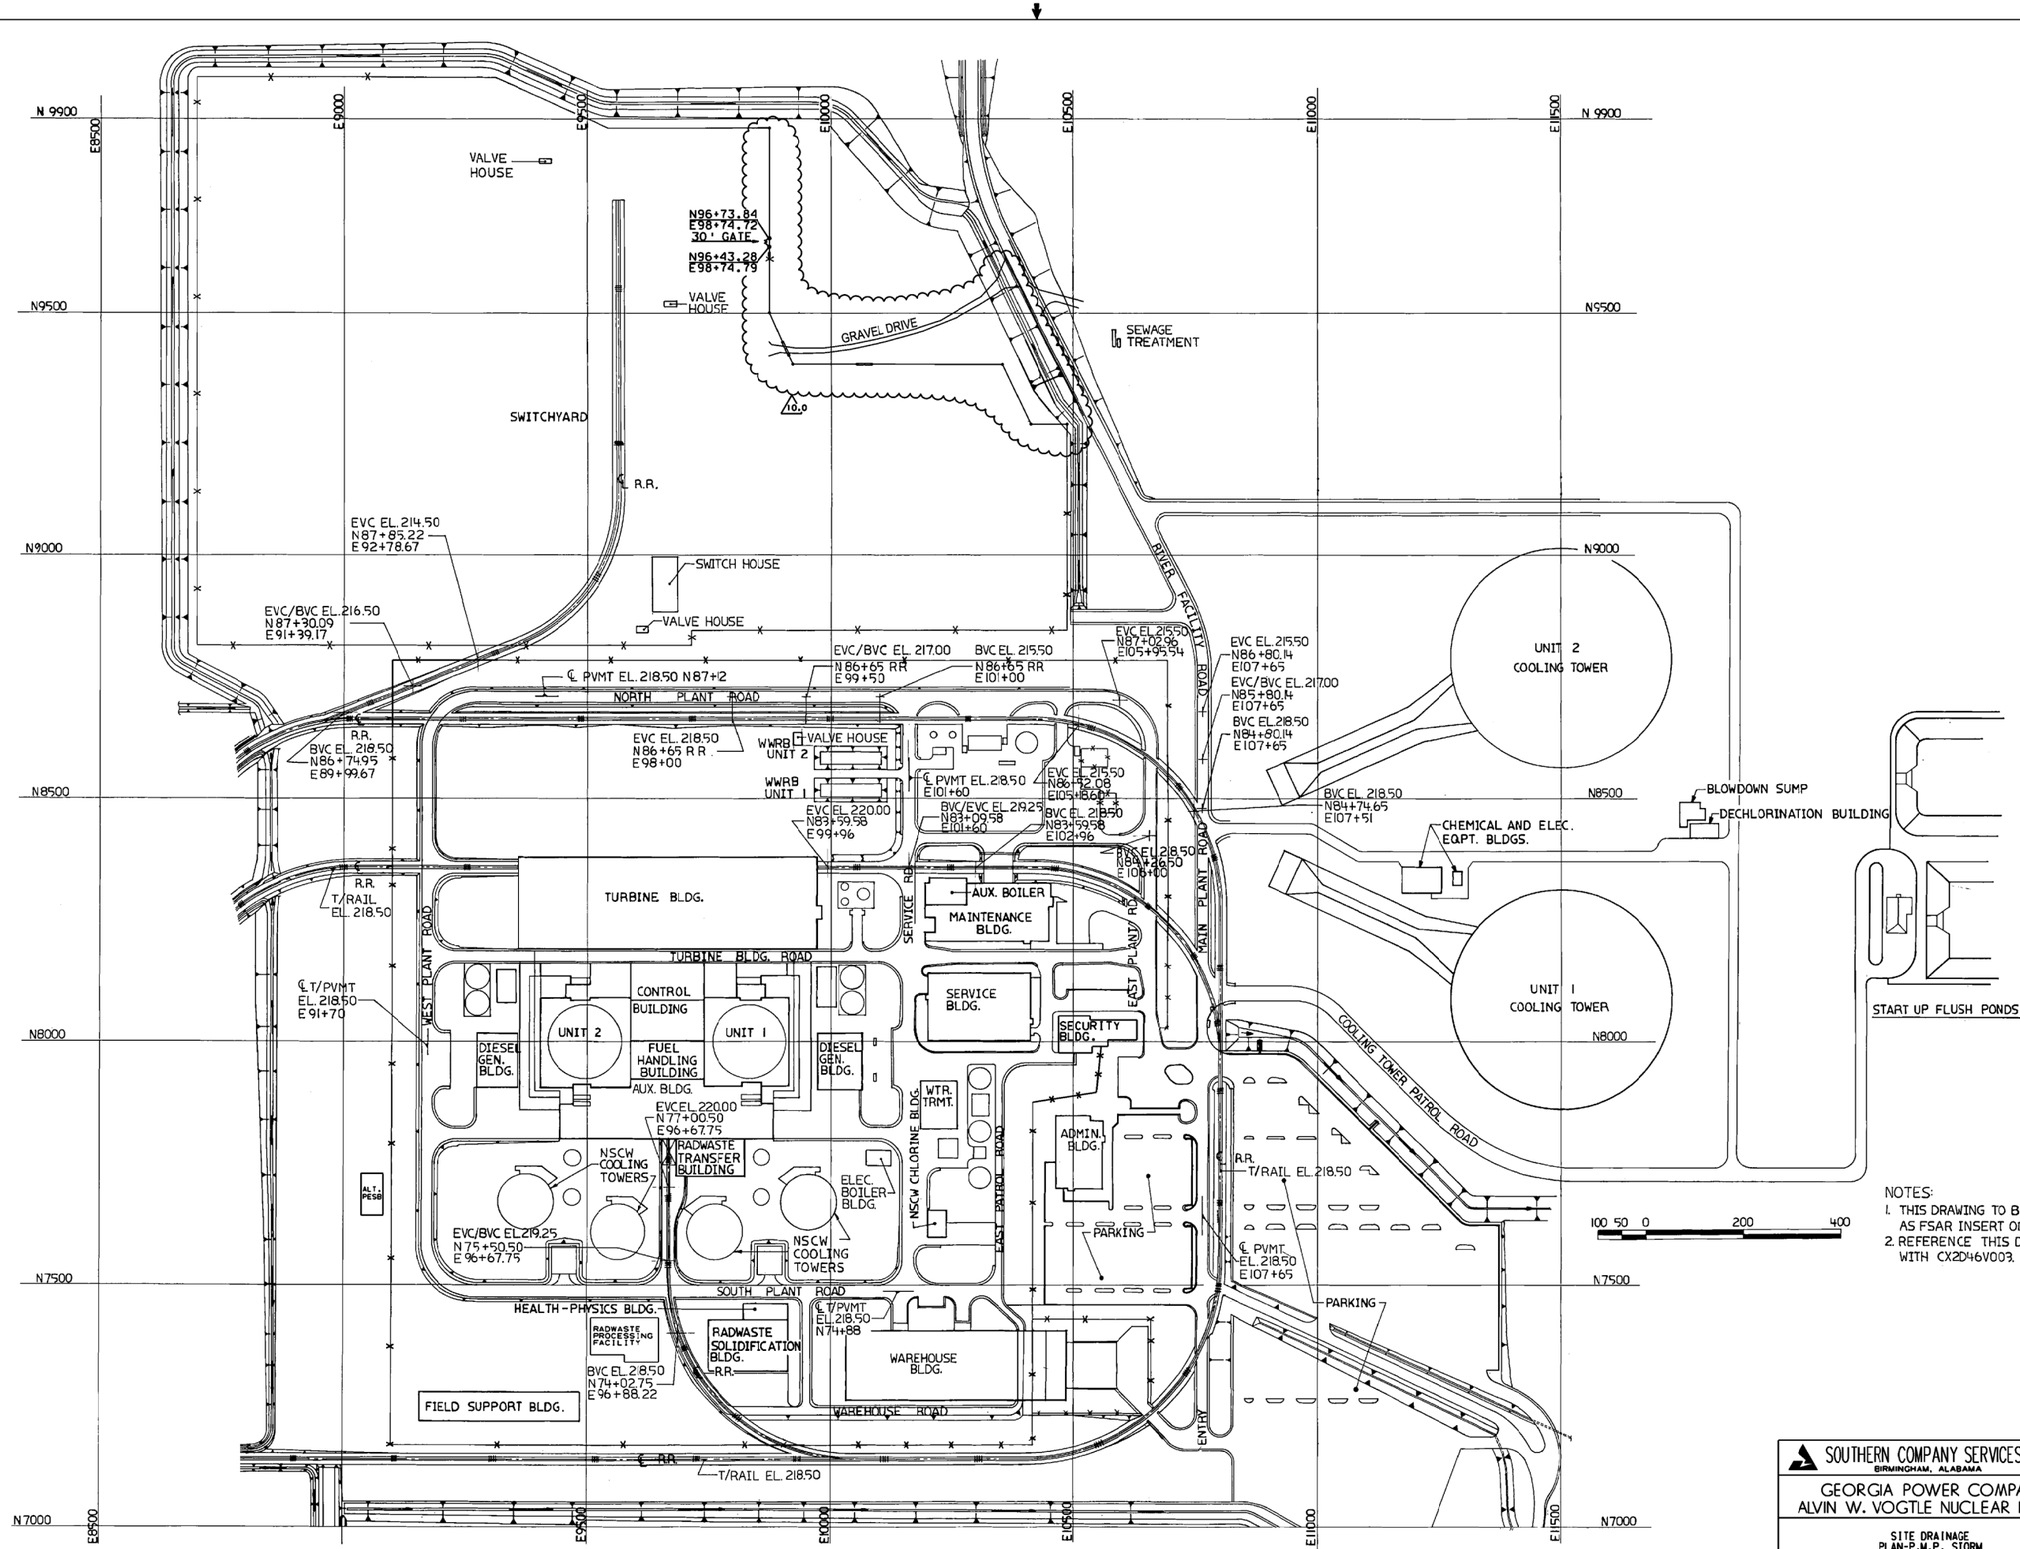

NOTES:
1. THIS DRAWING TO BE USED AS FSAR INSERT ONLY.
2. REFERENCE THIS DRAWING WITH CX2D46V003.

THIS DOCUMENT CONTAINS PROPRIETARY, CONFIDENTIAL, AND/OR TRADE SECRET INFORMATION OF THE SUBSIDIARIES OF THE SOUTHERN COMPANY OR OF THIRD PARTIES. IT IS INTENDED FOR USE ONLY BY EMPLOYEES OF, OR AUTHORIZED CONTRACTORS OF, THE SUBSIDIARIES OF THE SOUTHERN COMPANY. UNAUTHORIZED POSSESSION, USE, DISTRIBUTION, COPYING, DISSEMINATION, OR DISCLOSURE OF ANY PORTION HEREOF IS PROHIBITED.

NO.	VERSIONS	DATE	DR	CHK	APPV
10.0	REVISED PER ABN A1006959010005, VER 2.0	05/10/14	DCP	MWC	WLN

SOUTHERN COMPANY SERVICES, INC.
BIRMINGHAM, ALABAMA

GEORGIA POWER COMPANY
ALVIN W. VOGTLE NUCLEAR PLANT

SITE DRAINAGE
PLAN-P.M.P. STORM

SCALE: N.T.S	DRAWING NO.	VER.
JOB NO.10604	CX2D46V004	10.0

SIZE E 34X44

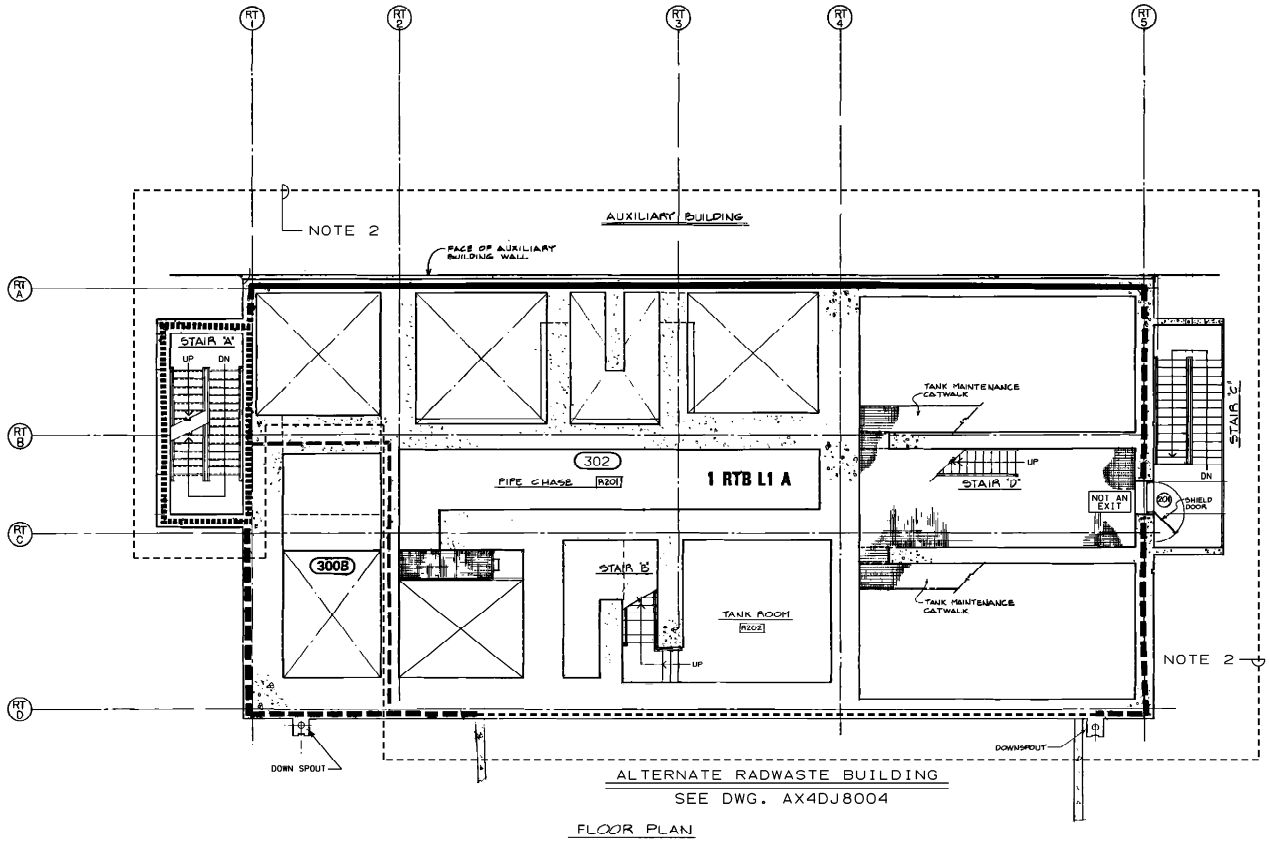

ALTERNATE RADWASTE BUILDING
SEE DWG. AX4DJ8004

FLOOR PLAN

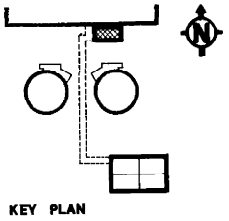

KEY PLAN

NOTES:
1. THE BACKGROUND USED ON THIS DRAWING IS PROVIDED FOR ORIENTATION PURPOSES ONLY.
2. "RETIRED IN PLACE".

LEGEND
- 3 HR RATED FIRE AREA BOUNDARY
- UNRATED FIRE AREA BOUNDARY
- 3 HR RATED BOUNDARY
- 2 HR RATED BOUNDARY
- PRE-ACTION SPRINKLER SYSTEM
- HALON SYSTEM
- FIRE HOSE CABINET
- FIRE HOSE REEL
- PORTABLE EXTINGUISHER (DRY-CHEMICAL)
- EXIT SIGN LOCATION
- FIRE ALARM PULL BOX
- KNOCK OUT PANEL
- FIRE ZONE BOUNDARY
- XXX FIRE ZONE DESIGNATOR

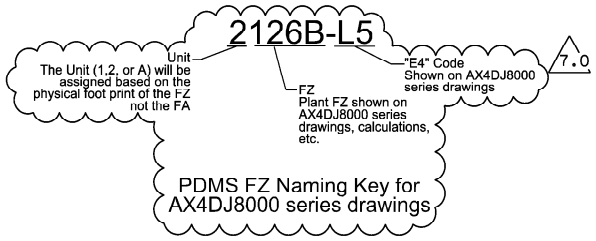

ELECTRICAL CABLE LOCATION CROSS REFERENCE		
FIRE ZONE	UNIT 1 E4 CODE	UNIT 2 E4 CODE
300B	X3	—
302	X3	

NO.	VERSIONS	DATE	DR	CHK	APPV
7.0	REVISED PER ABN-V02931, VER. 1.0.	4-30-12	JJB	LCF	AAN

SOUTHERN COMPANY SERVICES, INC.
BIRMINGHAM, ALABAMA

GEORGIA POWER COMPANY
ALVIN W. VOGTLE NUCLEAR PLANT

FIRE AREAS
RADWASTE TRANSFER BUILDING
PARTIAL LEVEL 1
FLOOR PLAN EL. 237'-0"

SCALE: NONE	DRAWING NO.	VER.
JOB NO. 10604	AX4DJ8005	7.0

THIS DOCUMENT CONTAINS PROPRIETARY, CONFIDENTIAL, AND/OR TRADE SECRET INFORMATION OF THE SUBSIDIARIES OF THE SOUTHERN COMPANY OR OF THIRD PARTIES. IT IS INTENDED FOR USE ONLY BY EMPLOYEES OF, OR AUTHORIZED CONTRACTORS OF, THE SUBSIDIARIES OF THE SOUTHERN COMPANY. UNAUTHORIZED POSSESSION, USE, DISTRIBUTION, COPYING, DISSEMINATION, OR DISCLOSURE OF ANY PORTION HEREOF IS PROHIBITED.

SIZE C 17X22 CAD NAME AX4DJ8005

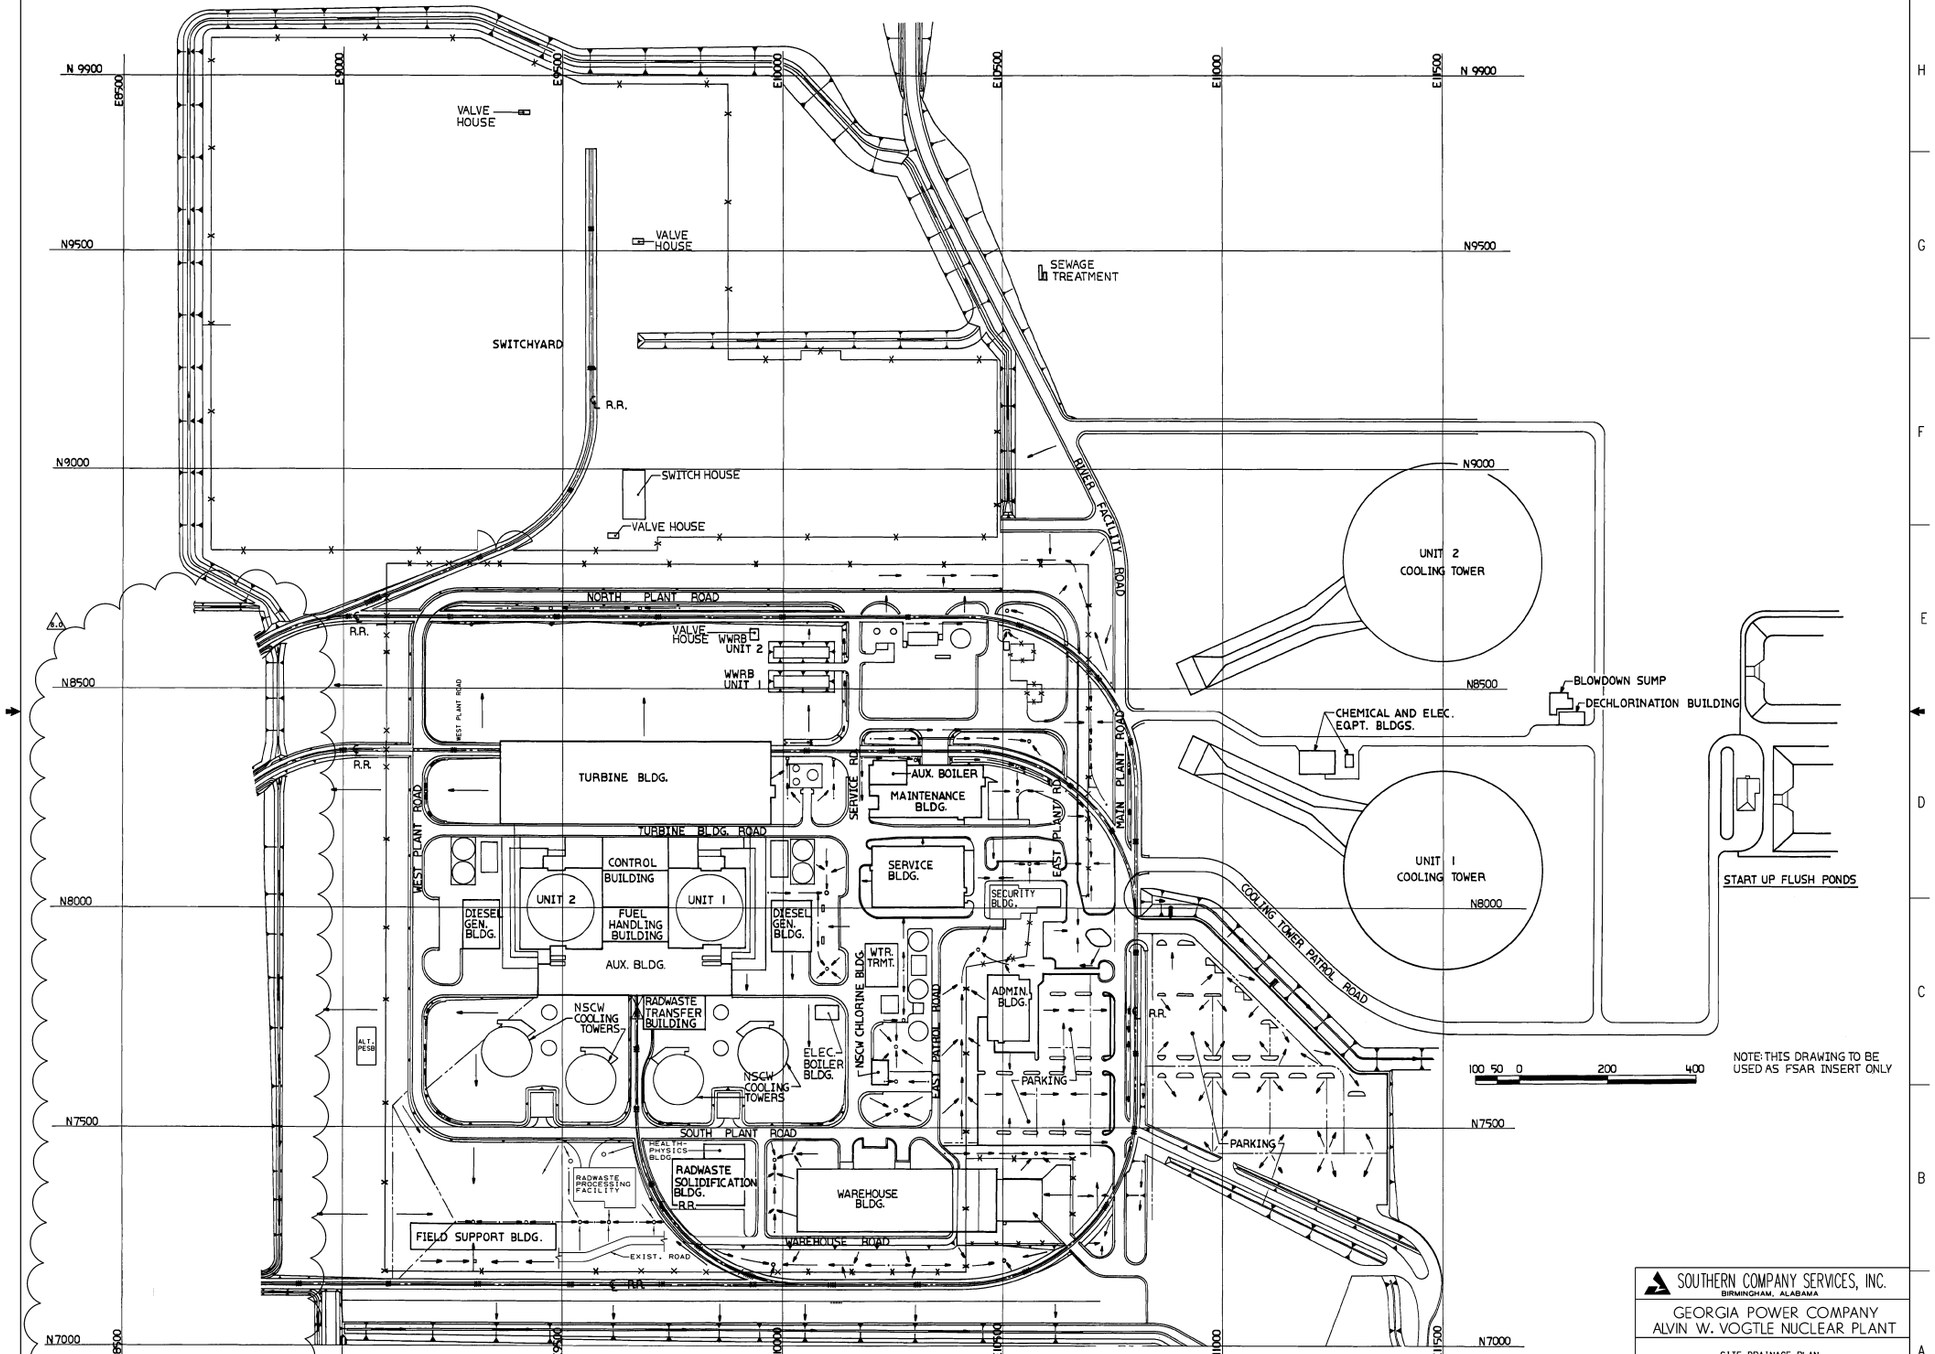

THIS DOCUMENT CONTAINS PROPRIETARY, CONFIDENTIAL, AND/OR TRADE SECRET INFORMATION OF THE SUBSIDIARIES OF THE SOUTHERN COMPANY OR OF THIRD PARTIES. IT IS INTENDED FOR USE ONLY BY EMPLOYEES OF, OR AUTHORIZED CONTRACTORS OF, THE SUBSIDIARIES OF THE SOUTHERN COMPANY. UNAUTHORIZED POSSESSION, USE, DISTRIBUTION, COPYING, DISSEMINATION, OR DISCLOSURE OF ANY PORTION HEREOF IS PROHIBITED.

NO.	VERSIONS	DATE	DR	CHK	APPV
8.0	REVISED PER ABN-VO3077, VER. 1.0	11/09/12	PVK	LCF	RKF

SOUTHERN COMPANY SERVICES, INC.
BIRMINGHAM, ALABAMA

GEORGIA POWER COMPANY
ALVIN W. VOGTLE NUCLEAR PLANT

SITE DRAINAGE PLAN
100 YEAR, 6 HOUR STORM

SCALE: 1"=100'

DRAWING NO. CX2D46V005

VER. 8.0

JOB NO. 10604

SIZE E 34X44

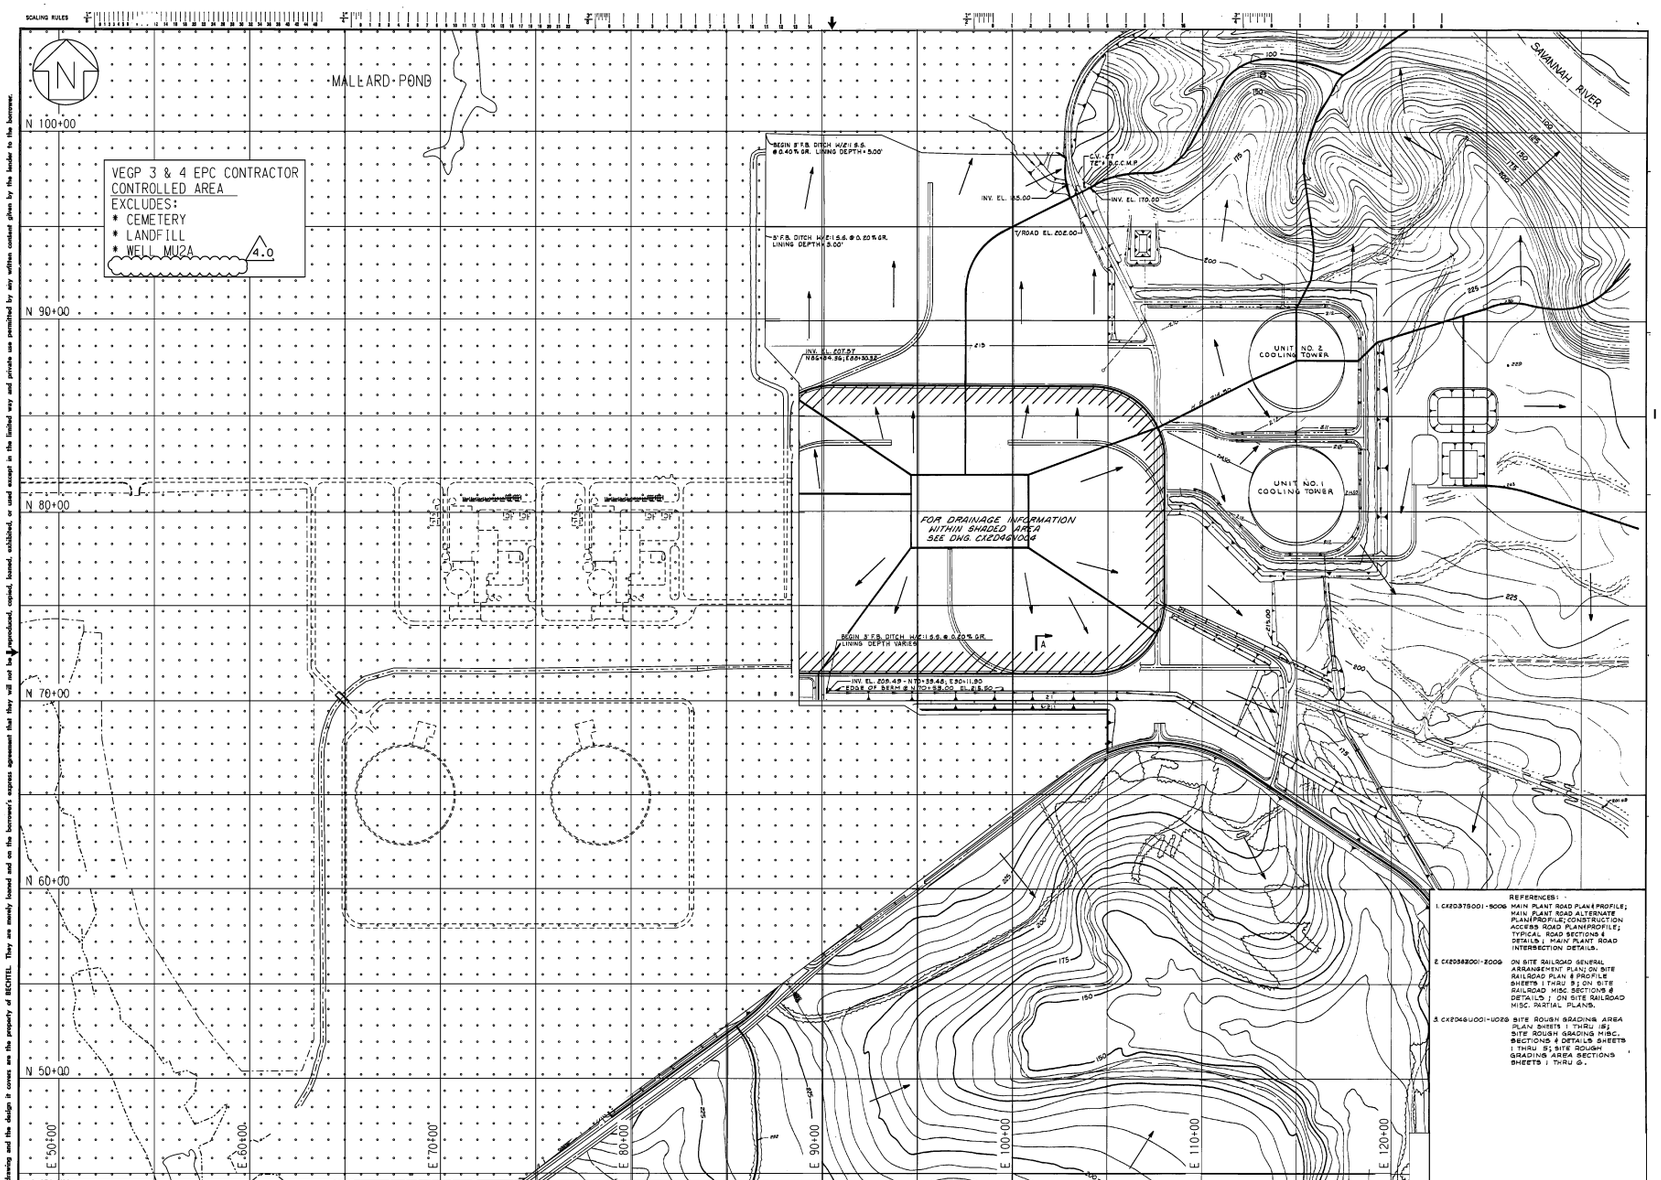

This drawing and the design it conveys are the property of BECHTEL. They are merely loaned and on the borrower's express agreement that they will not be reproduced, copied, loaned, exhibited, or used except in the limited way and private use permitted by any written consent given by the lender to the borrower.

THIS DOCUMENT CONTAINS PROPRIETARY, CONFIDENTIAL, AND/OR TRADE SECRET INFORMATION OF THE SUBSIDIARIES OF THE SOUTHERN COMPANY OR OF THIRD PARTIES. IT IS INTENDED FOR USE ONLY BY EMPLOYEES OF, OR AUTHORIZED CONTRACTORS OF, THE SUBSIDIARIES OF THE SOUTHERN COMPANY. UNAUTHORIZED POSSESSION, USE, DISTRIBUTION, COPYING, DISSEMINATION, OR DISCLOSURE OF ANY PORTION HEREOF IS PROHIBITED.

NO.	VERSIONS	DATE	DR	CHK	APPV
4.0	REVISED PER ABN-V03067, VER. 1.0	9-11-12	JJB	MLH	AAN

SOUTHERN COMPANY SERVICES, INC.
BIRMINGHAM, ALABAMA

GEORGIA POWER COMPANY
ALVIN W. VOGTLE NUCLEAR PLANT

SITE GRADING AND DRAINAGE
PLAN
SUB-DRAINAGE AREAS

SCALE: 1"=200'-0" | DRAWING NO. CX2D46V006 | VER. 4.0

JOB NO. 10604

SIZE E 34x44

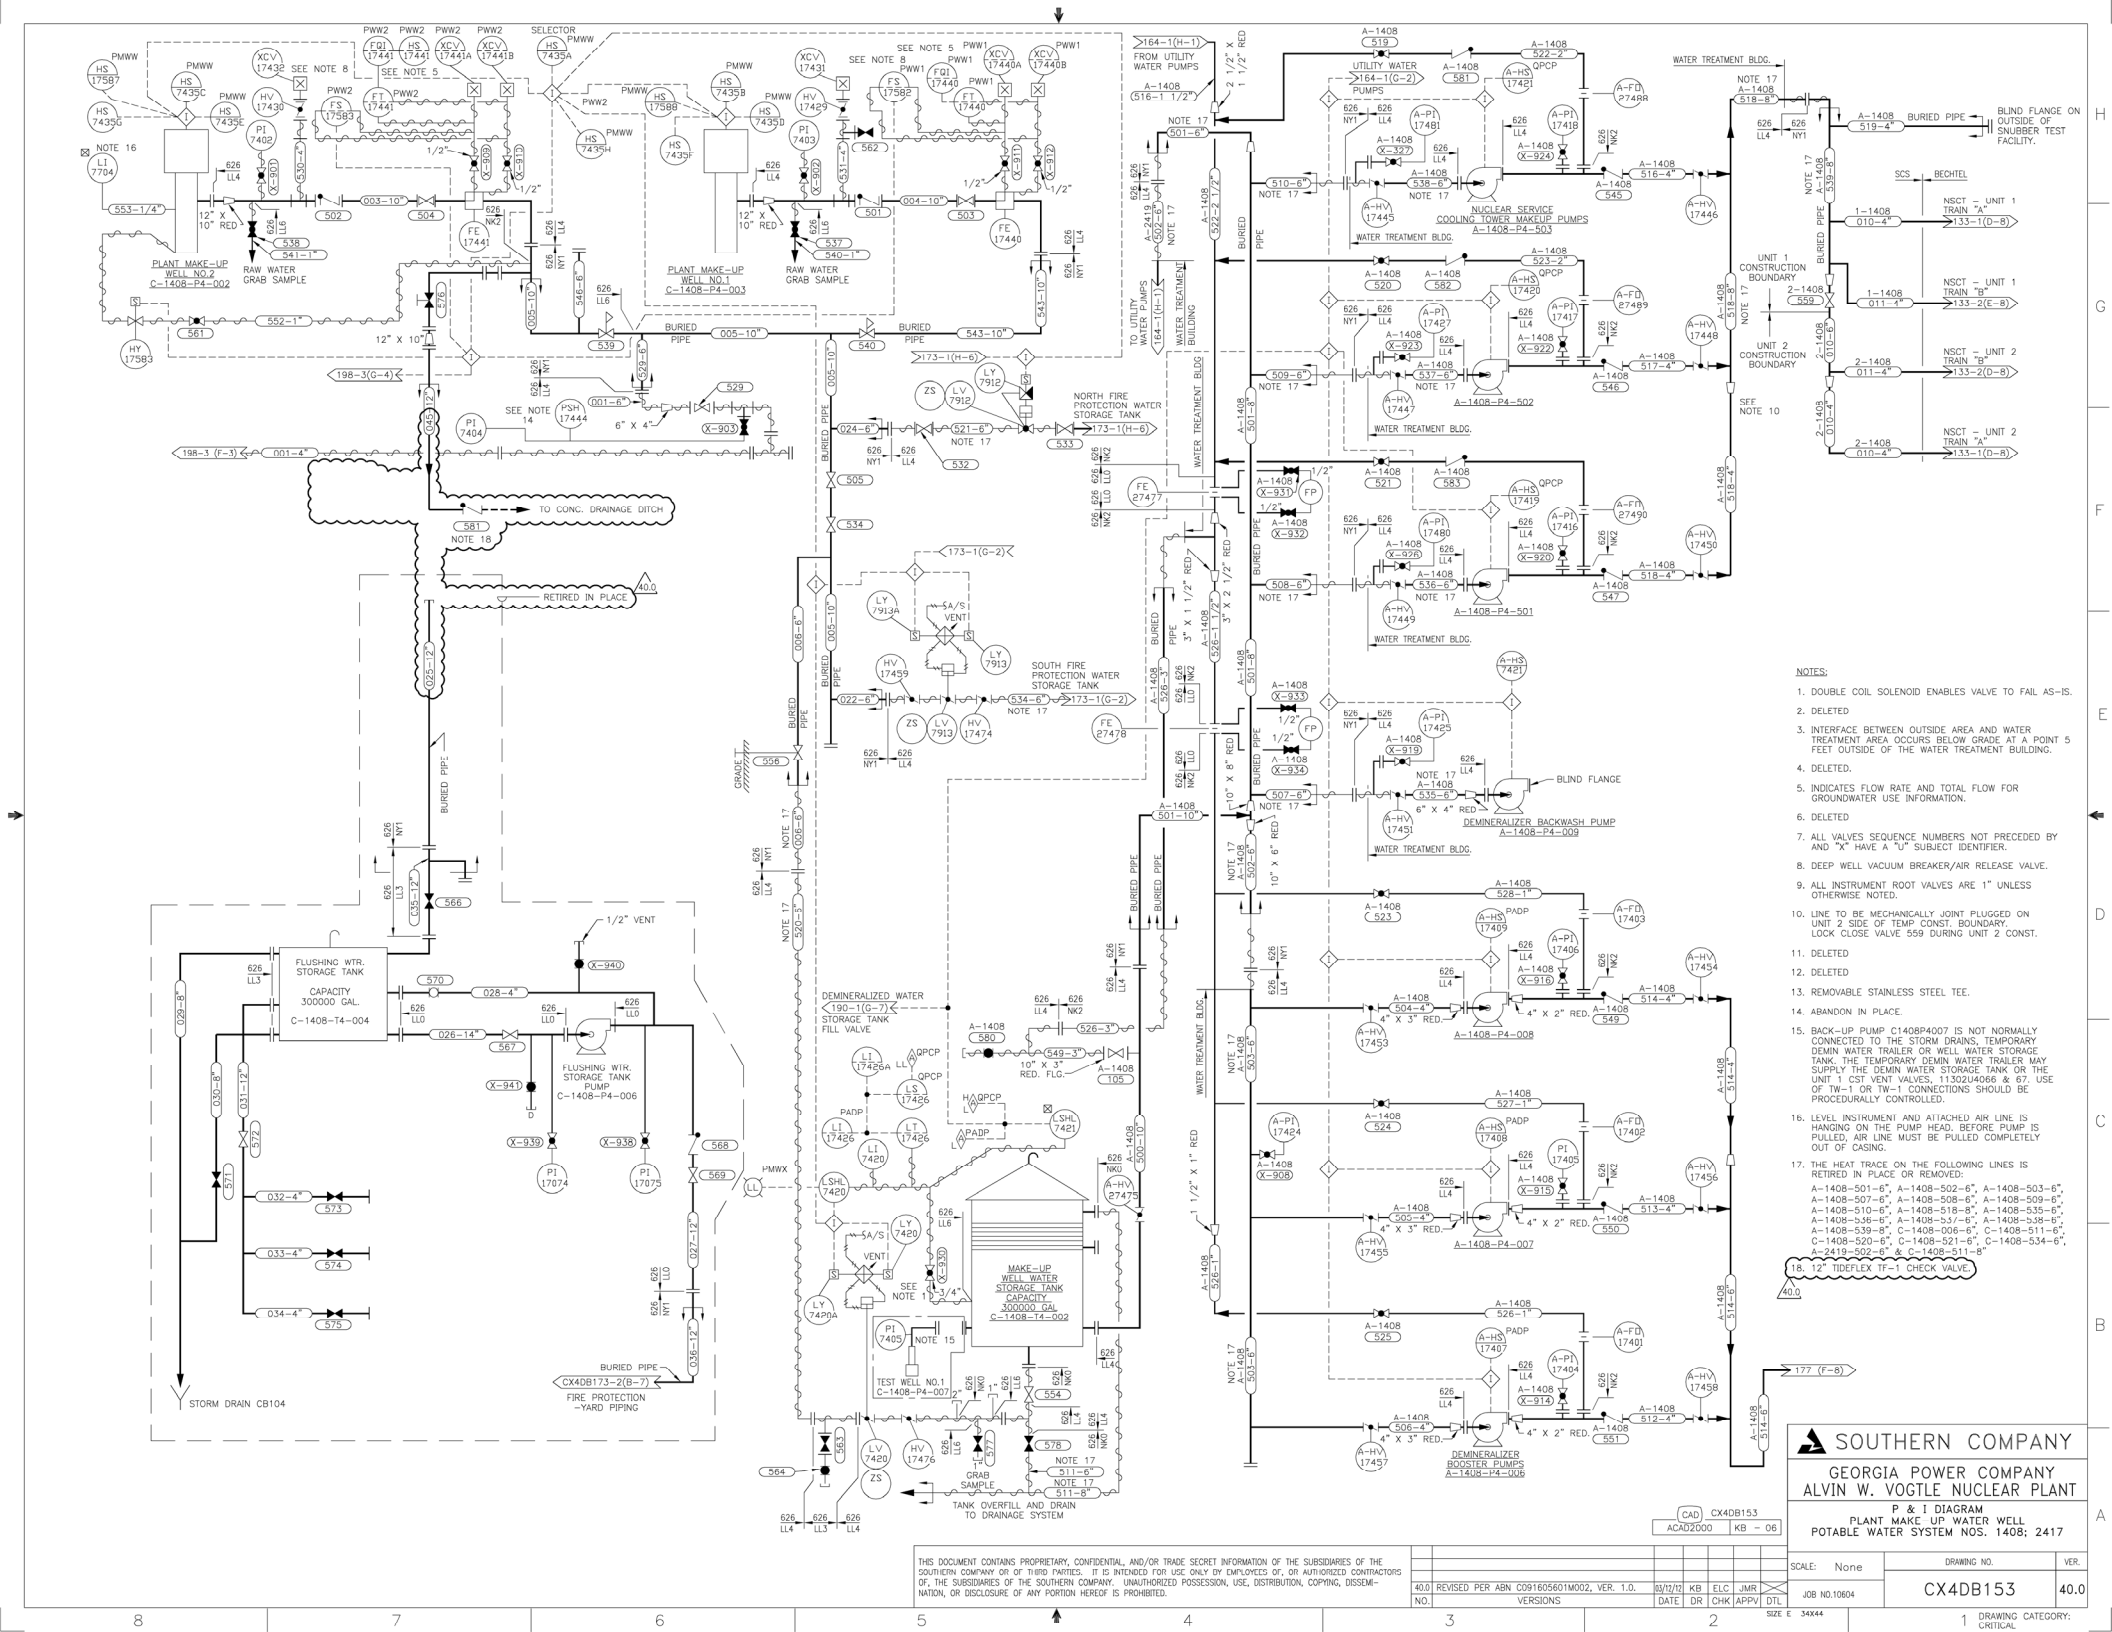

NOTES:

1. DOUBLE COIL SOLENOID ENABLES VALVE TO FAIL AS-IS.
2. DELETED
3. INTERFACE BETWEEN OUTSIDE AREA AND WATER TREATMENT AREA OCCURS BELOW GRADE AT A POINT 5 FEET OUTSIDE OF THE WATER TREATMENT BUILDING.
4. DELETED.
5. INDICATES FLOW RATE AND TOTAL FLOW FOR GROUNDWATER USE INFORMATION.
6. DELETED
7. ALL VALVES SEQUENCE NUMBERS NOT PRECEDED BY AND "X" HAVE A "U" SUBJECT IDENTIFIER.
8. DEEP WELL VACUUM BREAKER/AIR RELEASE VALVE.
9. ALL INSTRUMENT ROOT VALVES ARE 1" UNLESS OTHERWISE NOTED.
10. LINE TO BE MECHANICALLY JOINT PLUGGED ON UNIT 2 SIDE OF TEMP CONST. BOUNDARY. LOCK CLOSE VALVE 559 DURING UNIT 2 CONST.
11. DELETED
12. DELETED
13. REMOVABLE STAINLESS STEEL TEE.
14. ABANDON IN PLACE.
15. BACK-UP PUMP C1408P4007 IS NOT NORMALLY CONNECTED TO THE STORM DRAINS, TEMPORARY DEMIN WATER TRAILER OR WELL WATER STORAGE TANK. THE TEMPORARY DEMIN WATER TRAILER MAY SUPPLY THE DEMIN WATER STORAGE TANK OR THE UNIT 1 CST VENT VALVES, 11302U4066 & 67. USE OF TW-1 OR TW-1 CONNECTIONS SHOULD BE PROCEDURALLY CONTROLLED.
16. LEVEL INSTRUMENT AND ATTACHED AIR LINE IS HANGING ON THE PUMP HEAD. BEFORE PUMP IS PULLED, AIR LINE MUST BE PULLED COMPLETELY OUT OF CASING.
17. THE HEAT TRACE ON THE FOLLOWING LINES IS RETIRED IN PLACE OR REMOVED:
    A-1408-501-6", A-1408-502-6", A-1408-503-6", A-1408-507-6", A-1408-508-6", A-1408-509-6", A-1408-510-6", A-1408-518-8", A-1408-535-6", A-1408-536-6", A-1408-537-6", A-1408-538-8", C-1408-006-6", C-1408-511-6", C-1408-520-6", C-1408-521-6", C-1408-534-6", A-2419-502-6" & C-1408-511-8"
18. 12" TIDEFLEX TF-1 CHECK VALVE.

CAD CX4DB153
ACAD2000 | KB - 06

THIS DOCUMENT CONTAINS PROPRIETARY, CONFIDENTIAL, AND/OR TRADE SECRET INFORMATION OF THE SUBSIDIARIES OF THE SOUTHERN COMPANY OR OF THIRD PARTIES. IT IS INTENDED FOR USE ONLY BY EMPLOYEES OF, OR AUTHORIZED CONTRACTORS OF, THE SUBSIDIARIES OF THE SOUTHERN COMPANY. UNAUTHORIZED POSSESSION, USE, DISTRIBUTION, COPYING, DISSEMINATION, OR DISCLOSURE OF ANY PORTION HEREOF IS PROHIBITED.

NO.	VERSIONS	DATE	DR	CHK	APPV	DTL
40.0	REVISED PER ABN C091605601M002, VER. 1.0.	03/12/12	KB	ELC	JMR	

SOUTHERN COMPANY

GEORGIA POWER COMPANY
ALVIN W. VOGTLE NUCLEAR PLANT

P & I DIAGRAM
PLANT MAKE UP WATER WELL
POTABLE WATER SYSTEM NOS. 1408; 2417

SCALE: None | DRAWING NO. CX4DB153 | VER. 40.0

JOB NO.10604

SIZE E 34X44

DRAWING CATEGORY: CRITICAL

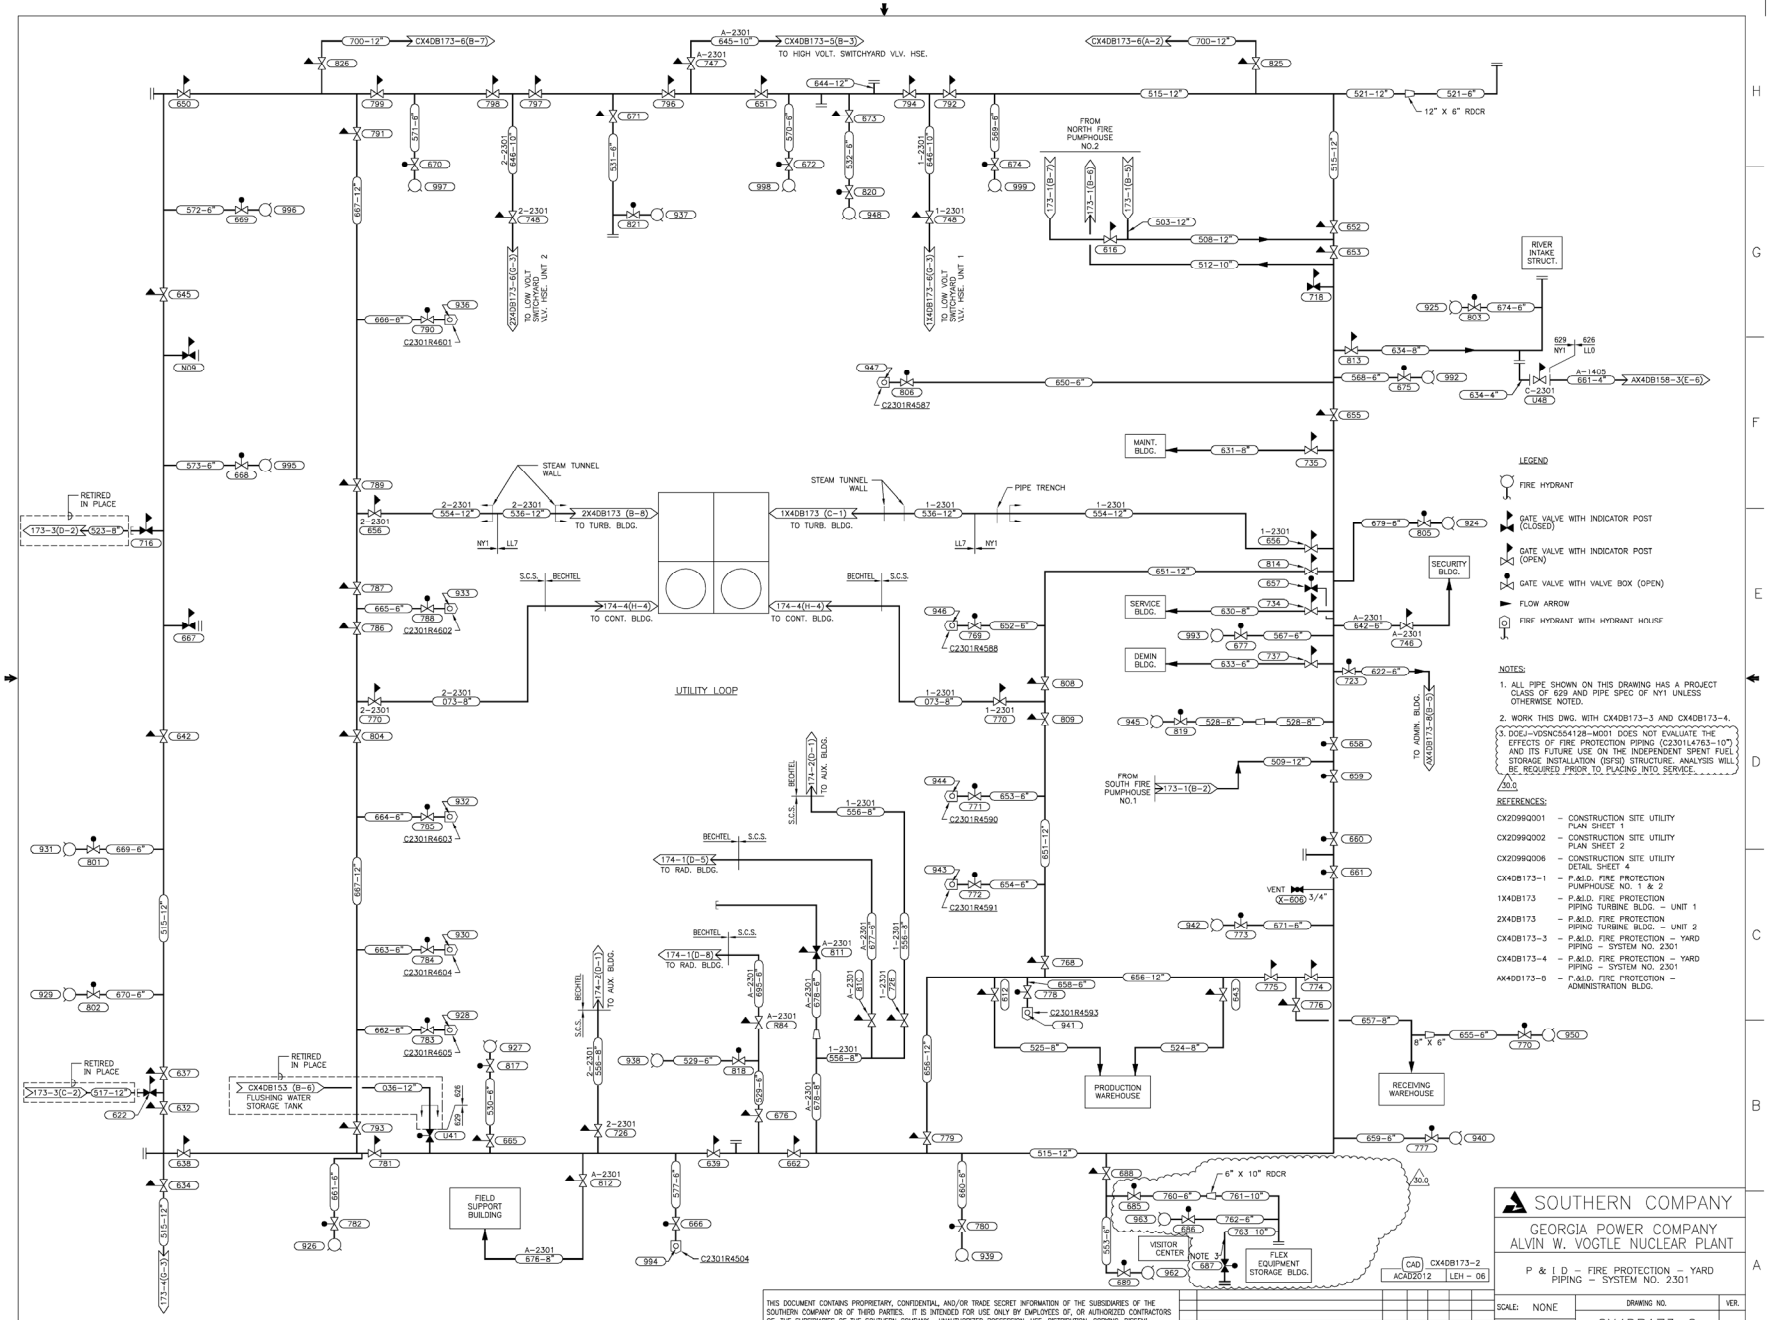

THIS DOCUMENT CONTAINS PROPRIETARY, CONFIDENTIAL, AND/OR TRADE SECRET INFORMATION OF THE SUBSIDIARIES OF THE SOUTHERN COMPANY OR OF THIRD PARTIES. IT IS INTENDED FOR USE ONLY BY EMPLOYEES OF, OR AUTHORIZED CONTRACTORS OF, THE SUBSIDIARIES OF THE SOUTHERN COMPANY. UNAUTHORIZED POSSESSION, USE, DISTRIBUTION, COPYING, DISSEMINATION, OR DISCLOSURE OF ANY PORTION HEREOF IS PROHIBITED.

NO.	VERSIONS	DATE	DR	CHK	APPV	UTL
30.0	REVISED PER ABN SNC554128M002, VER. 2.0	8/15/15	LEH	MWD	WLN	

CAD CX4DB173-2 | ACAD2012 | LEH – 06

SOUTHERN COMPANY
GEORGIA POWER COMPANY
ALVIN W. VOGTLE NUCLEAR PLANT
P & I D – FIRE PROTECTION – YARD PIPING – SYSTEM NO. 2301

SCALE: NONE | DRAWING NO. CX4DB173-2 | VER. 30.0
JOB NO.10604
SIZE E 34X44
DRAWING CATEGORY: CRITICAL

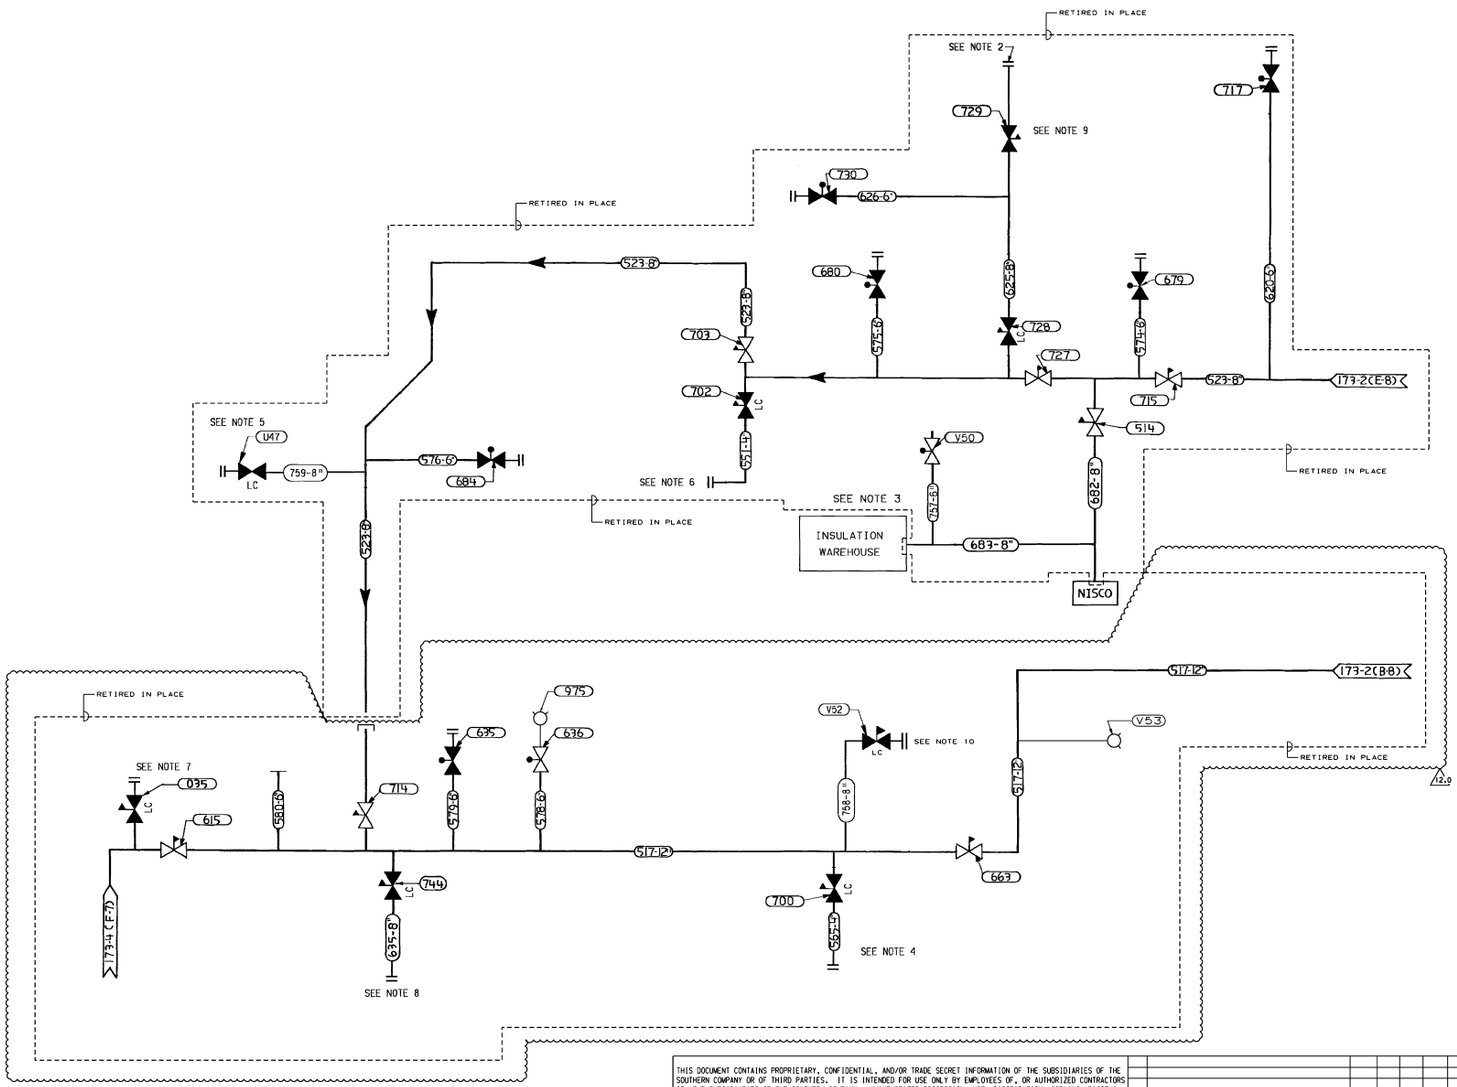

NOTES:
1. FOR LEGEND, NOTES & REFERENCES SEE DWG. NO. CX4DB173-2.
2. FORMERLY THE COATINGS FACILITY AND ASSOCIATED BLDGS.
3. FORMERLY THE NORTH BROS. BLDG.
4. FORMERLY THE PAINT CONTR. BLDG.
5. FORMERLY THE SOIL LAB
6. FORMERLY THE EQUIP. MAINT. SHOP
7. FORMERLY THE PROCUREMENT COMPLEX
8. FORMERLY THE HVAC BLDG.
9. FORMERLY THE CARPENTER SHOP AND STOR. BLDG.
10. FORMERLY THE PAINT WAREHOUSE

THIS DOCUMENT CONTAINS PROPRIETARY, CONFIDENTIAL, AND/OR TRADE SECRET INFORMATION OF THE SUBSIDIARIES OF THE SOUTHERN COMPANY OR OF THIRD PARTIES. IT IS INTENDED FOR USE ONLY BY EMPLOYEES OF, OR AUTHORIZED CONTRACTORS OF, THE SUBSIDIARIES OF THE SOUTHERN COMPANY. UNAUTHORIZED POSSESSION, USE, DISTRIBUTION, COPYING, DISSEMINATION, OR DISCLOSURE OF ANY PORTION HEREOF IS PROHIBITED.

NO.	VERSIONS	DATE	DR	CHK	APPV
12.0	REVISED PER ABN CO81863901M004, VER 1.0	04/28/09	ELC	TSL	JMR

SOUTHERN COMPANY SERVICES, INC.
BIRMINGHAM, ALABAMA

GEORGIA POWER COMPANY
ALVIN W. VOGTLE NUCLEAR PLANT

P & ID - FIRE PROTECTION
YARD PIPING
SYSTEM NO. 2301

SCALE: NONE
JOB NO.10604
DRAWING NO. CX4DB173-3
VER. 12.0
SIZE E 34X44
DWG CATEGORY: CRITICAL

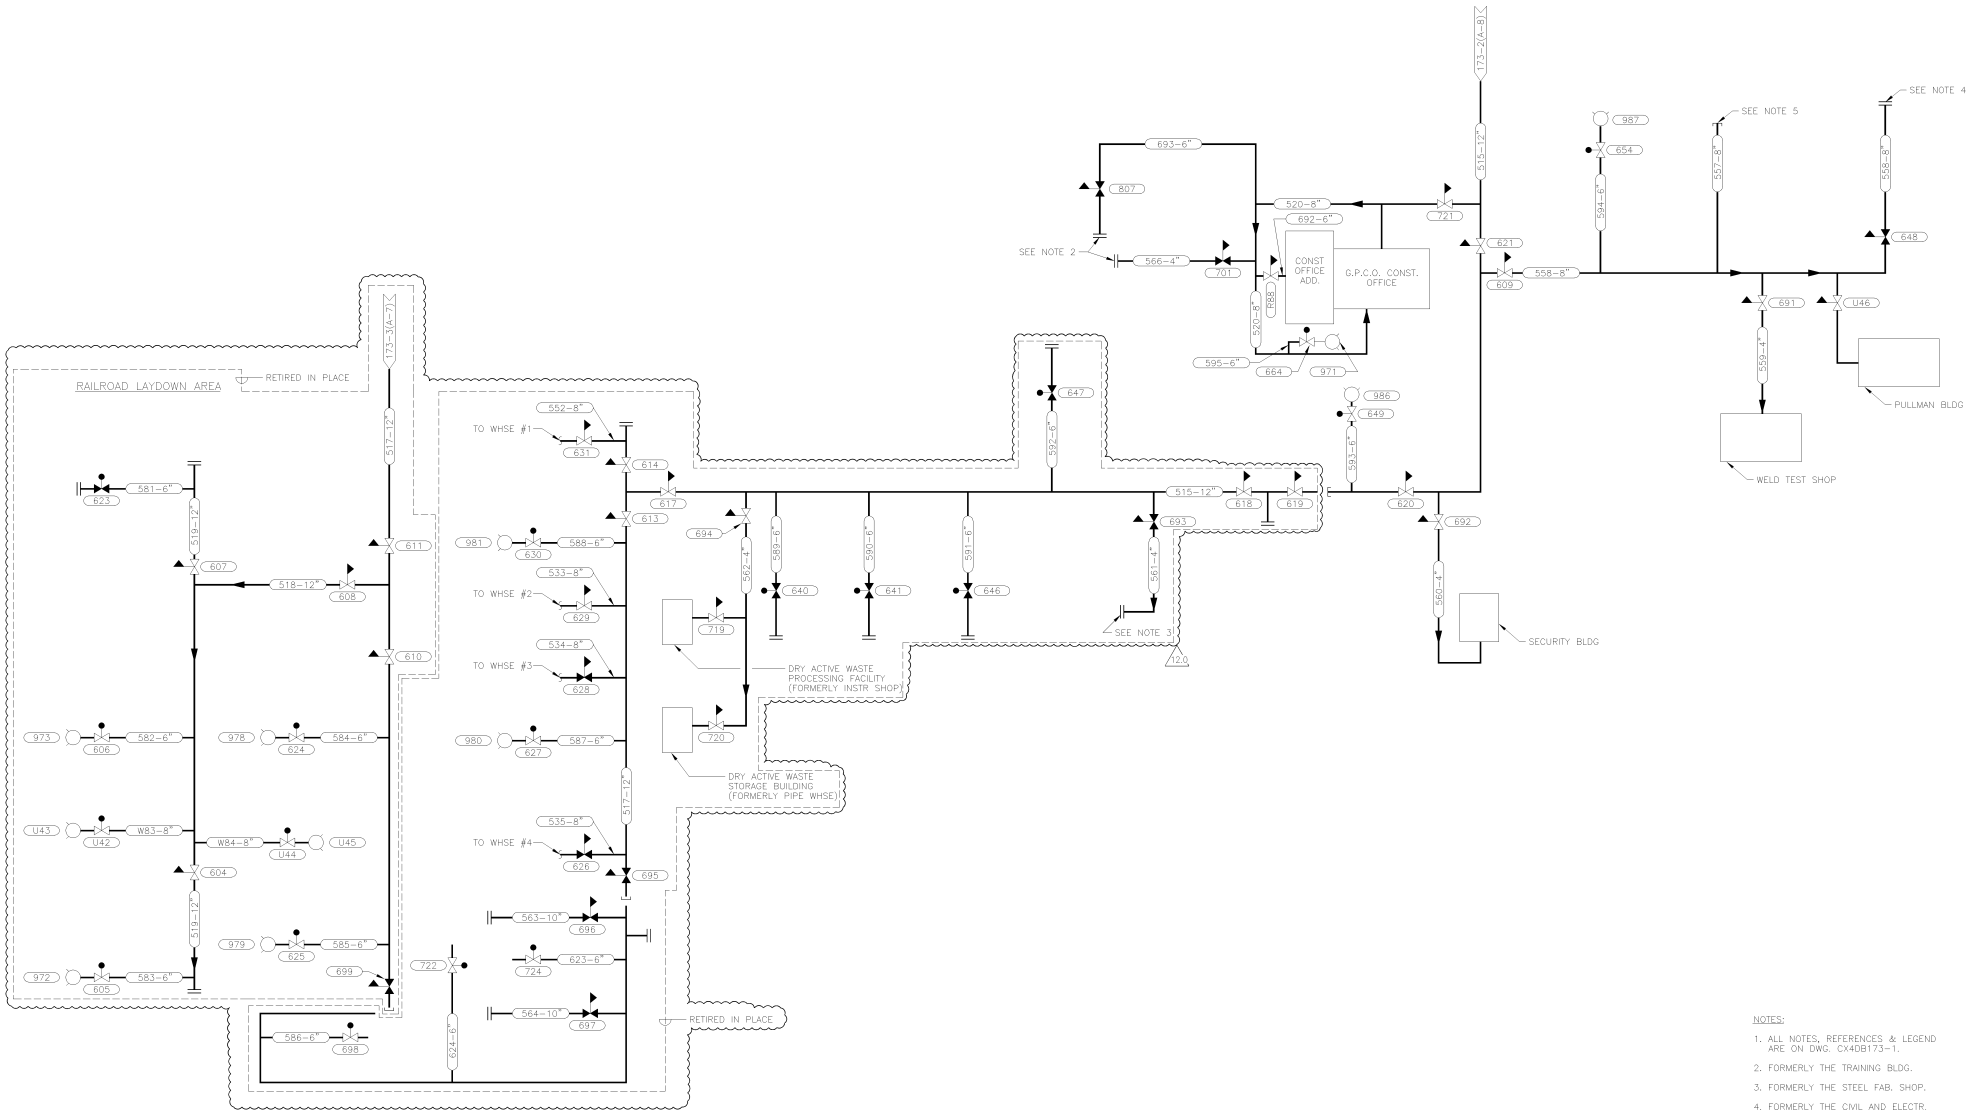

NOTES:

1. ALL NOTES, REFERENCES & LEGEND ARE ON DWG. CX4DB173-1.
2. FORMERLY THE TRAINING BLDG.
3. FORMERLY THE STEEL FAB. SHOP.
4. FORMERLY THE CIVIL AND ELECTR. CONTRACTOR BUILDING.
5. FORMERLY THE MECHANICAL CONTRACTOR BUILDING (LINE CAPPED UNDERGROUND)
6. DELETED.

SOUTHERN COMPANY

GEORGIA POWER COMPANY
ALVIN W. VOGTLE NUCLEAR PLANT

P & I DIAGRAM – FIRE PROTECTION
YARD PIPING
SYSTEM NO. 2301

CAD CX4DB173-4
ACAD2K JLO – 03

THIS DOCUMENT CONTAINS PROPRIETARY, CONFIDENTIAL, AND/OR TRADE SECRET INFORMATION OF THE SUBSIDIARIES OF THE SOUTHERN COMPANY OR OF THIRD PARTIES. IT IS INTENDED FOR USE ONLY BY EMPLOYEES OF, OR AUTHORIZED CONTRACTORS OF, THE SUBSIDIARIES OF THE SOUTHERN COMPANY. UNAUTHORIZED POSSESSION, USE, DISTRIBUTION, COPYING, DISSEMINATION, OR DISCLOSURE OF ANY PORTION HEREOF IS PROHIBITED.

NO.	VERSIONS	DATE	DR	CHK	APPV	DTL
12.0	REVISED PER ABN C081863901M002, VER. 1.0	4-18-09	JLO	RBH	JMR	X

SCALE: NONE
JOB NO.10604
DRAWING NO. CX4DB173-4
VER. 12.0
SIZE E 34x44
DRAWING CATEGORY: CRITICAL

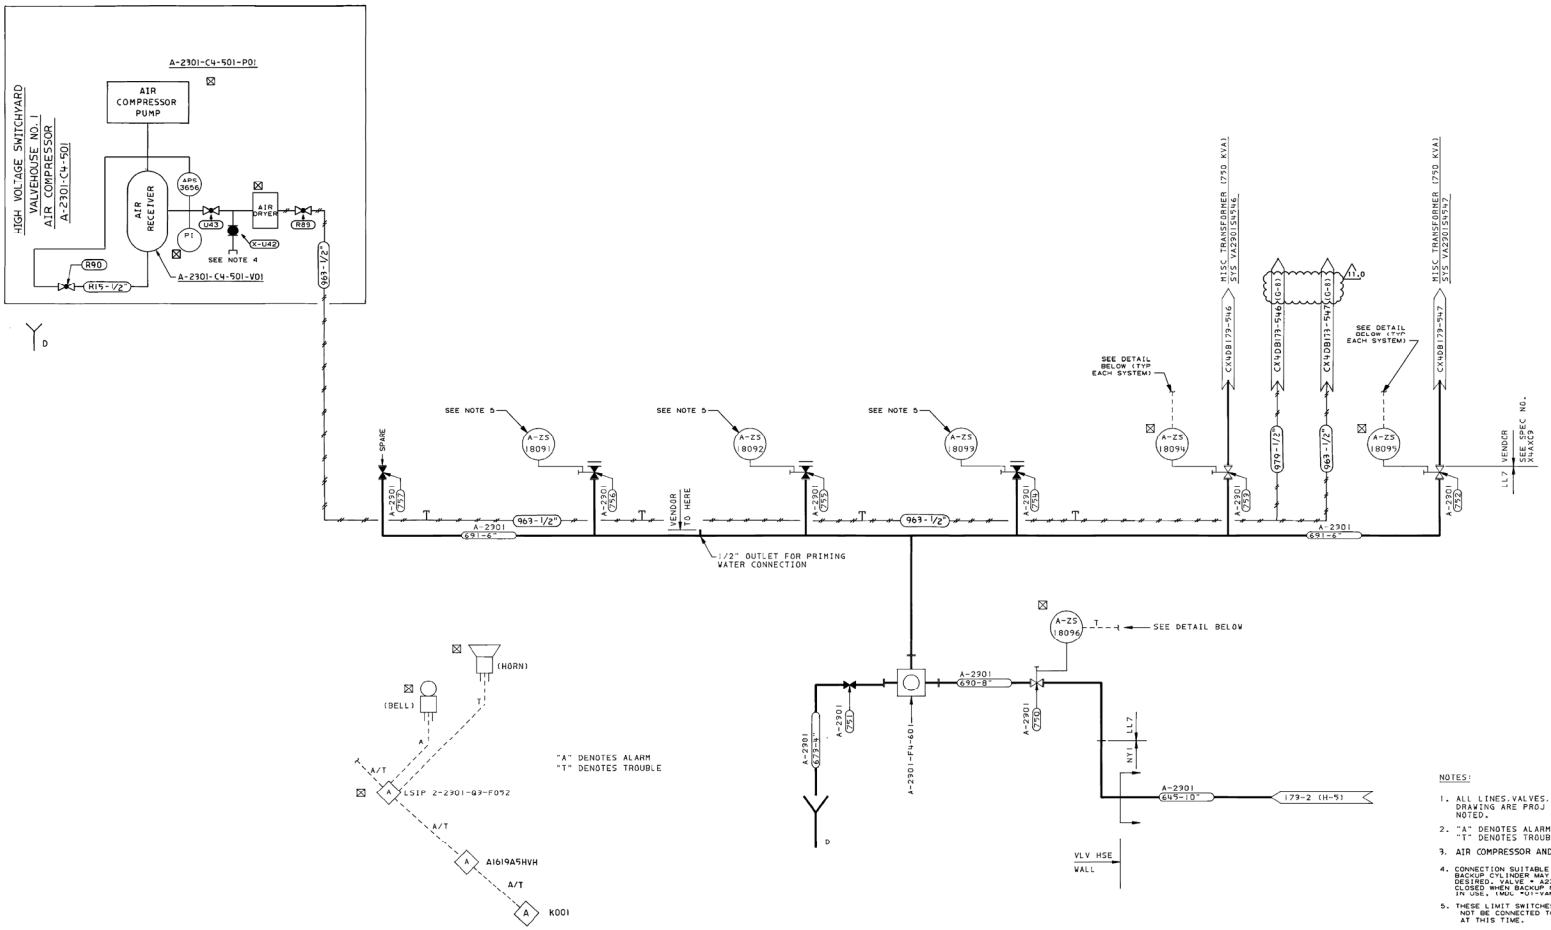

ANNUNCIATION DETAIL
(TYPICAL EACH SYSTEM)

HIGH VOLTAGE SWITCHYARD
VALVEHOUSE NO.1

NOTES:

1. ALL LINES, VALVES, AND EQUIP ON THIS DRAWING ARE PROJ CLASS 629 UNLESS NOTED.
2. "A" DENOTES ALARM
   "T" DENOTES TROUBLE
3. AIR COMPRESSOR AND AIR LINES BY VENDOR.
4. CONNECTION SUITABLE FOR BACKUP AIR SUPPLY. BACKUP CYLINDER MAY REMAIN CONNECTED IF DESIRED. VALVE = A2301X4U42 SHALL REMAIN CLOSED WHEN BACKUP NITROGEN CYLINDER IS NOT IN USE. (WDC *01-YAM05-1)
5. THESE LIMIT SWITCHES ARE "SPARES" AND WILL NOT BE CONNECTED TO ANY ANNUNCIATION AT THIS TIME.

REFERENCES:

SK4-5505 - HIGH VOLTAGE SWITCHYARD - FIRE PROT PIPING - GEN ARRG T - PLAN

AX4DL69402 - HIGH VOLTAGE SWITCHYARD - FIRE PROT VALVE HOUSE - PLAN AND SECTIONS

F G DOAR P.E.
GEORGIA NO.4972

SOUTHERN COMPANY SERVICES, INC.
BIRMINGHAM, ALABAMA

GEORGIA POWER COMPANY
ALVIN W. VOGTLE NUCLEAR PLANT

P & ID - FIRE PROTECTION - PIPING
HIGH VOLTAGE SWITCHYARD
VALVEHOUSE NO.1 - SYSTEM 2301

THIS DOCUMENT CONTAINS PROPRIETARY, CONFIDENTIAL, AND/OR TRADE SECRET INFORMATION OF THE SUBSIDIARIES OF THE SOUTHERN COMPANY OR OF THIRD PARTIES. IT IS INTENDED FOR USE ONLY BY EMPLOYEES OF, OR AUTHORIZED CONTRACTORS OF, THE SUBSIDIARIES OF THE SOUTHERN COMPANY. UNAUTHORIZED POSSESSION, USE, DISTRIBUTION, COPYING, DISSEMINATION, OR DISCLOSURE OF ANY PORTION HEREOF IS PROHIBITED.

NO.	VERSIONS	DATE	DR	CHK	APPV
11.0	REVISED PER ABN 1049000801M073, VER. 1.0	6/12/15	LEH	DCP	MMD

SCALE: NONE
JOB NO. 10604
DRAWING NO. CX4DB173-5
VER. 11.0
SIZE E 34x44
DRAWING CATEGORY: CRITICAL

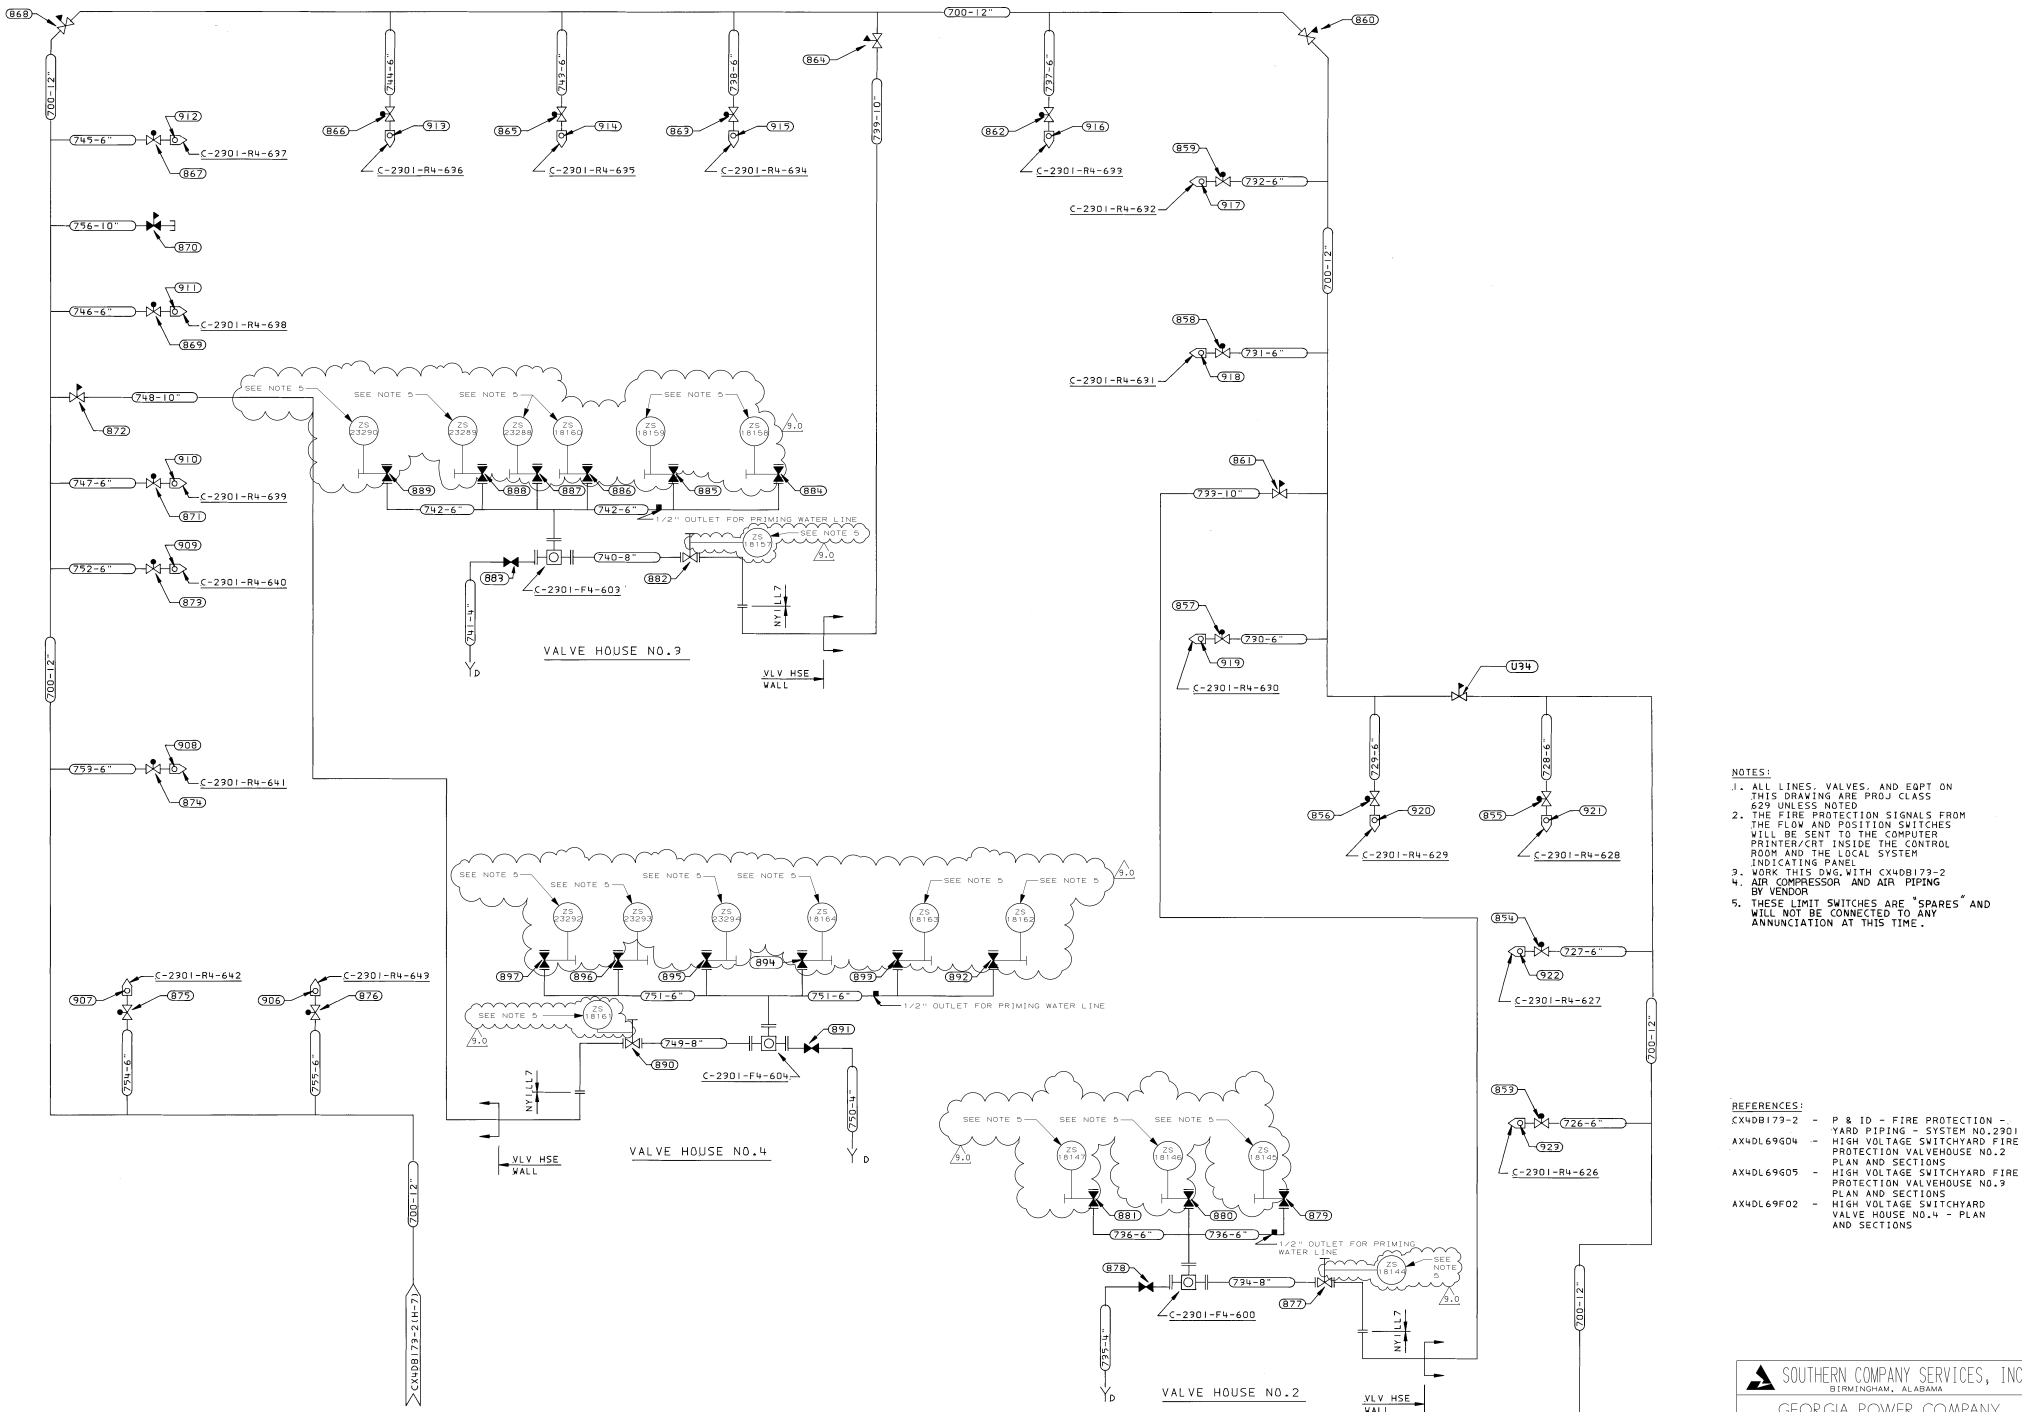

NOTES:
1. ALL LINES, VALVES, AND EQPT ON THIS DRAWING ARE PROJ CLASS 629 UNLESS NOTED
2. THE FIRE PROTECTION SIGNALS FROM THE FLOW AND POSITION SWITCHES WILL BE SENT TO THE COMPUTER PRINTER/CRT INSIDE THE CONTROL ROOM AND THE LOCAL SYSTEM INDICATING PANEL
3. WORK THIS DWG. WITH CX4DB173-2
4. AIR COMPRESSOR AND AIR PIPING BY VENDOR
5. THESE LIMIT SWITCHES ARE "SPARES" AND WILL NOT BE CONNECTED TO ANY ANNUNCIATION AT THIS TIME.

REFERENCES:

CX4DB173-2	-	P & ID - FIRE PROTECTION - YARD PIPING - SYSTEM NO.2901
AX4DL69G04	-	HIGH VOLTAGE SWITCHYARD FIRE PROTECTION VALVEHOUSE NO.2 PLAN AND SECTIONS
AX4DL69G05	-	HIGH VOLTAGE SWITCHYARD FIRE PROTECTION VALVEHOUSE NO.9 PLAN AND SECTIONS
AX4DL69F02	-	HIGH VOLTAGE SWITCHYARD VALVE HOUSE NO.4 - PLAN AND SECTIONS

P.E. GEORGIA NO. 14183

F.G. DOAR P.E. GEORGIA NO. 4372.

THIS DOCUMENT CONTAINS PROPRIETARY, CONFIDENTIAL, AND/OR TRADE SECRET INFORMATION OF THE SUBSIDIARIES OF THE SOUTHERN COMPANY OR OF THIRD PARTIES. IT IS INTENDED FOR USE ONLY BY EMPLOYEES OF, OR AUTHORIZED CONTRACTORS OF, THE SUBSIDIARIES OF THE SOUTHERN COMPANY. UNAUTHORIZED POSSESSION, USE, DISTRIBUTION, COPYING, DISSEMINATION, OR DISCLOSURE OF ANY PORTION HEREOF IS PROHIBITED.

NO.	VERSIONS	DATE	DR	CHK	APPV
9.0	REVISED PER ABN-52238, VER. 1.0	11/2/05	DFV	MWD	ASK

SOUTHERN COMPANY SERVICES, INC.
BIRMINGHAM, ALABAMA

GEORGIA POWER COMPANY
ALVIN W. VOGTLE NUCLEAR PLANT

P&ID - FIRE PROTECTION - PIPING HIGH VOLTAGE SWITCHYARD - UNITS 1 & 2 - SYS. 2301

SCALE: N.T.S.	DRAWING NO.	VER.
JOB NO.10604	CX4DB173-6	9.0

SIZE E 34X44

DRAWING CATEGORY I CRITICAL

14.5x

I CERTIFY THAT THE IMAGE CONTAINED ON THIS FRAME WAS MADE IN THE NORMAL AND REGULAR COURSE OF BUSINESS, ON THE DATE STATED BELOW AND THAT IT IS AN ACCURATE REPRODUCTION OF THE DOCUMENT SUBMITTED TO MICROGRAPHICS.
1-27-87 DATE
CAMERA OPERATOR
SECTION SUPERVISOR

This drawing and the design it covers are the property of BECHTEL. They are merely loaned and on the borrower's express agreement that they will not be reproduced, copied, loaned, exhibited, or used except in the limited way and private use permitted by any written consent given by the lender to the borrower.

TAG NO.	DESCRIPTION	FUNCTION	SETPOINT	REF. DWG.	RESET	REMARKS
1 ATIS-12110	MCR OUTSIDE AIR INTAKE CL2	HI CL2 ALARM AND CONTROL	2 PPM CL2 $^{+0}_{-0.6}$ PPM	FSAR-6.4	FIXED	REF FILE X5BD06-012 REF IOM BB51009 & BB5112 TOL. CALC. X5CP12110 (NOTE 1) TECH. SPEC. SECT. 3.3.3.7
2 ATIS-12110	CL2		4			4
1 ATIS-12111	H2S	HI H2S ALARM AND CONTROL	2 PPM H2S ±5% INCR		(S.P.-2.0%) ±5%	
2 ATIS-12111	H2S					
1 UR-12111	H2S & CL2	HI H2S & CL2 ALARM	2 PPM H2S ±5% INCR 2 PPM CL2 $^{+0}_{-0.6}$ PPM		(S.P.-2.0%) FIXED	
2 UR-12111	H2S & CL2		4			
1 ATIS-12112	CL2	HI CL2 ALARM AND CONTROL	2 PPM CL2 $^{+0}_{-0.6}$ PPM INCR		FIXED	REF IOM BB51009 & BB5112 TOL. CALC. X5CP12110 (NOTE 1) TECH. SPEC. SECT. 3.3.3.7
2 ATIS-12112	CL2					4
1 ATIS-12113	H2S	HI H2S ALARM AND CONTROL	2 PPM H2S ±5% INCR		(S.P.-2.0%) ±5%	
2 ATIS-12113	H2S					
1 UR-12113	H2S & CL2	HI H2S & CL2 ALARM	2 PPM H2S ±5% INCR 2 PPM CL2 $^{+0}_{-0.6}$ PPM		(SP-2.0%) FIXED	
2 UR-12113	H2S & CL2		4		4	
A ATIS-21030	MCR OUTSIDE AIR INTAKE CL2	CONTROL	2 PPM CL2 $^{+0}_{-0.6}$ PPM INCR		FIXED	REF FILE NO. X5BD06-012 REF IOM BB51009 & BB5112 TOL. CALC. X5CP12110 (NOTE 1) TECH. SPEC. SECT. 3.3.3.7
A ATIS-21031	H2S		2 PPM H2S ±5% "		(S.P.-2.0%) ±5%	
A UR-21032	H2S & CL2	HI H2S & CL2 ALARM	2 PPM H2S ±5% " 2 PPM CL2 $^{+0}_{-0.6}$ PPM		(SP-2.0%) FIXED	

NOTE 1. ANY SETPOINT CHANGE FOR THESE INSTRUMENT REQUIRES UPDATE OF THE REFERENCE TOLERANCE CALCULATION. 4

BECHTEL
LOS ANGELES

GEORGIA POWER COMPANY
ALVIN W. VOGTLE NUCLEAR PLANT

INSTRUMENT SET POINT LIST

NO.	REVISIONS	DATE	DR	CHK.	SUPV.	EGS	CHF. E.	P. E.	Q. A. E.
3	ADDED RESET VALUES	7-5-85	ZSD	TAM	RGC				
2	VERIFIED SET POINTS AND ADDED FILE NO. REF.	4/2/85	ZSD	TAM	RGC				
1	INCORP. DCN #1 AND TFCR-X5-7N&608N, YFCRB-427N SUP. BY ISSUE EDITORIAL CHANGE	1-21-87	RSA						
0	ISSUE FOR CONSTRUCTION	1-17-84	RK	[illegible]					

ENG. MGR. | DATE

SCALE: NONE | JOB NO. 9510 | DRAWING NO. CX5DT101-58 | REV. 4 | SPEC. NO. X5AA04

BM 9510

SIZE B 11 x 17

I CERTIFY THAT THE IMAGE CONTAINED ON THIS FRAME WAS MADE IN THE NORMAL AND REGULAR COURSE OF BUSINESS, ON THE DATE STATED BELOW AND THAT IT IS AN ACCURATE REPRODUCTION OF THE DOCUMENT SUBMITTED TO MICROGRAPHICS.
1-27-87 DATE
CAMERA OPERATOR
SECTION SUPERVISOR